


REVISIONS

AS-INSTALLED	12-21-95	DSD
GAW/RAH	SN 08385	
PER 4880.1	SEP 3793	
BY 4880.1	SEP 3793	
DES: PER 4880.1	SEP 3793	
IN 4880.1	SEP 3793	
DES: PER 4880.1	SEP 3793	
IN 4880.1	SEP 3793	
DES: PER 4880.1	SEP 3793	

PLAN MUST NOT BE MODIFIED WITHOUT APPROVAL OF SIGNAL ENGINEERING

COPYRIGHT 2012 BNSF RAILWAY COMPANY. ALL RIGHTS RESERVED.

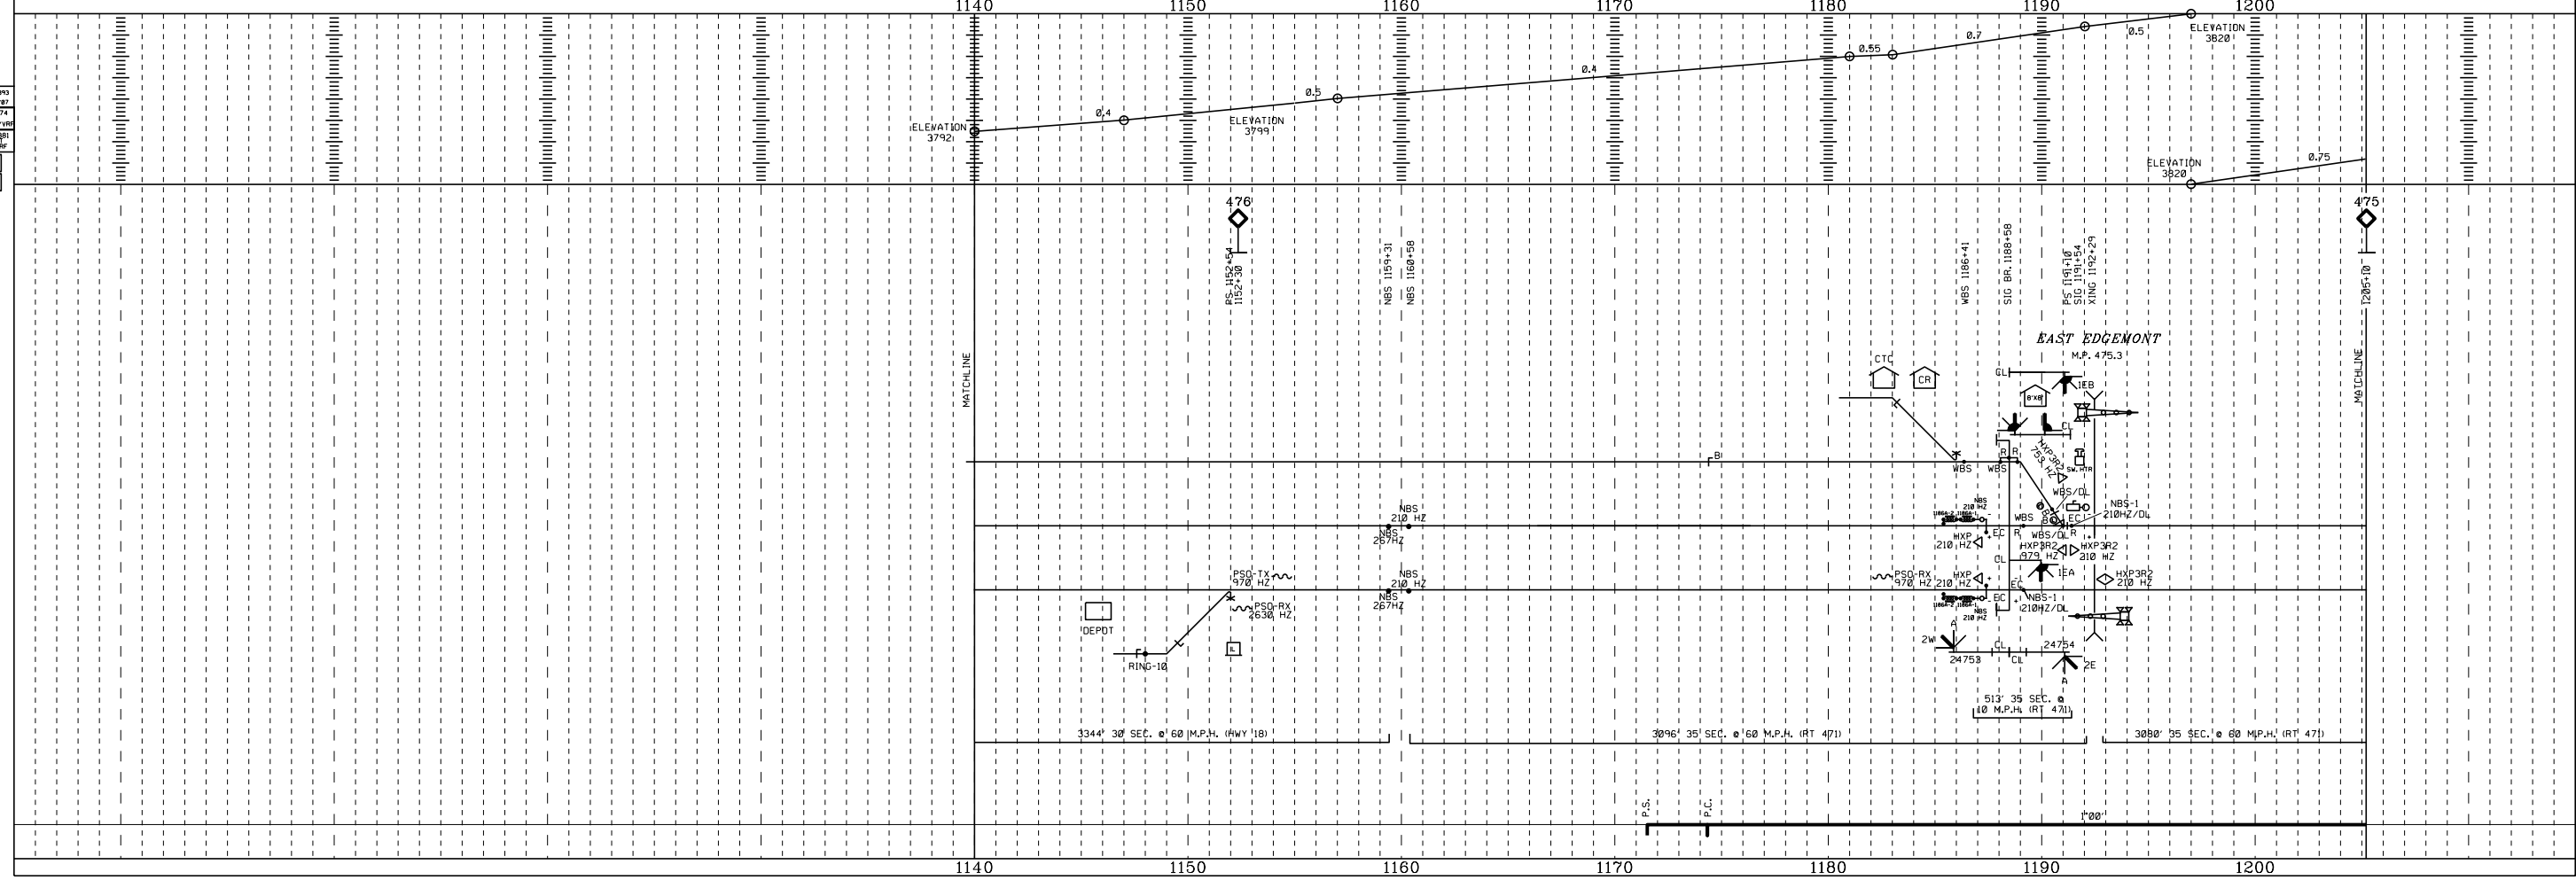

GRADE

BURLINGTON NORTHERN SANTA FE RAILWAY
 TRACK PROFILE AND LOCATION PLAN
 EAST ALLIANCE TO EDMONTON
 LS. 0004 MP. 0475 TO MP. 0476

11" X 33"
 SCALE:
 VERT 1"=20'
 HOR 1"=400'
 CURVES
 5 1/2" X 16 1/2"
 SCALE:
 VERT 1"=40'
 HOR 1"=800'