


REVISIONS

AS-INSTALLED	12-21-09	DSB
BY	12-21-09	DSB
IN	12-21-09	DSB
BY	12-21-09	DSB
IN	12-21-09	DSB
BY	12-21-09	DSB
IN	12-21-09	DSB
BY	12-21-09	DSB

PLAN MUST NOT BE MODIFIED WITHOUT APPROVAL OF SIGNAL ENGINEERING

COPYRIGHT 2012 BNSF RAILWAY COMPANY. ALL RIGHTS RESERVED.

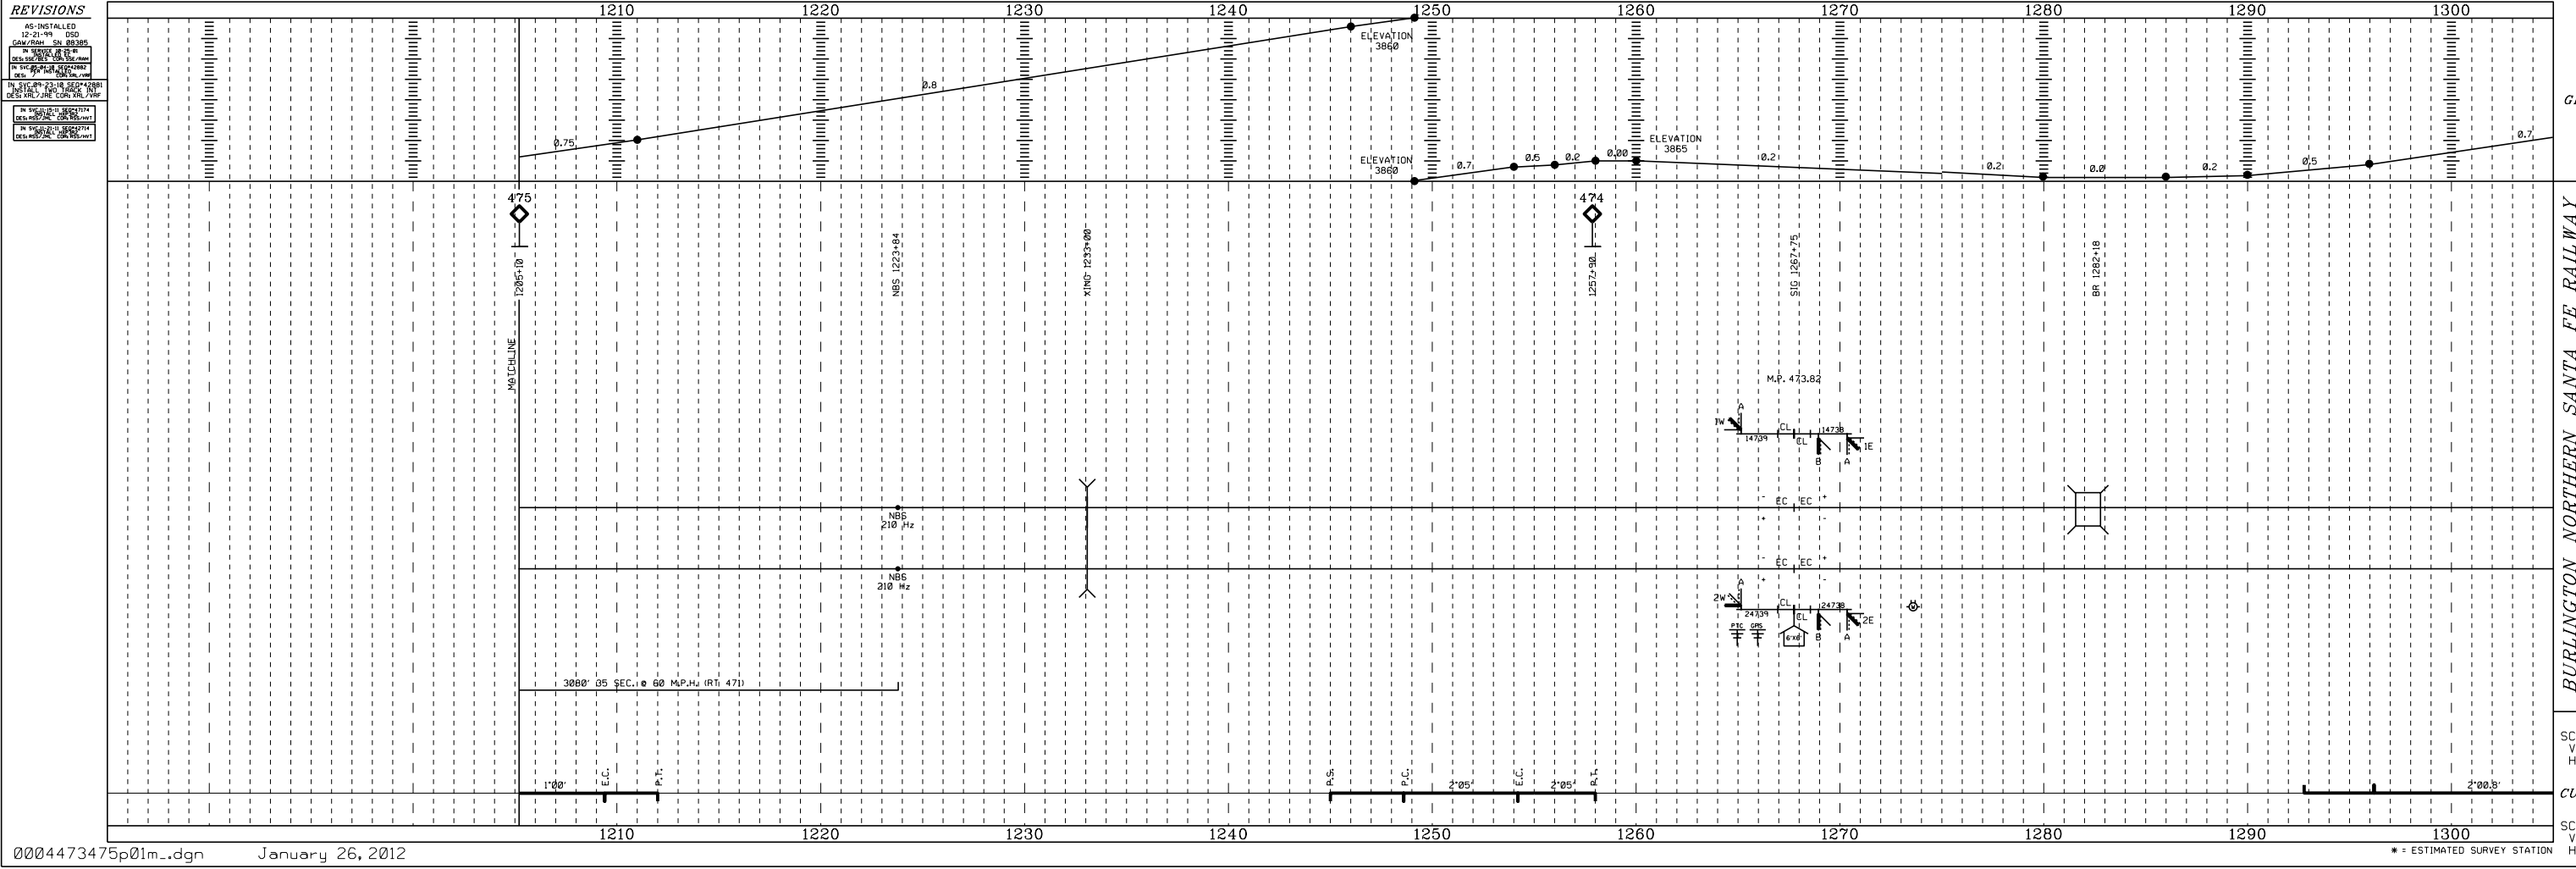

0004473475p01m.dgn January 26, 2012

BURLINGTON NORTHERN SANTA FE RAILWAY
TRACK PROFILE AND LOCATION PLAN
EAST ALLIANCE TO EDMONT

LS 0004 MP 0473 TO MP 0475

11" X 33"
SCALE:
VERT 1"=20'
HOR 1"=400'

CURVES
5 1/2" X 16 1/2"
SCALE:
VERT 1"=40'
HOR 1"=800'

* - ESTIMATED SURVEY STATION