


REVISIONS

AS-INSTALLED 12-21-99 DSD GAW/RAH SN 08385
IN SYNC WITH 100001 DES: J. H. ...
IN SYNC WITH 100001 DES: J. H. ...
IN SYNC WITH 100001 DES: J. H. ...

PLAN MUST NOT BE MODIFIED WITHOUT APPROVAL OF SIGNAL ENGINEERING

COPYRIGHT 2014 BNSF RAILWAY COMPANY. ALL RIGHTS RESERVED.

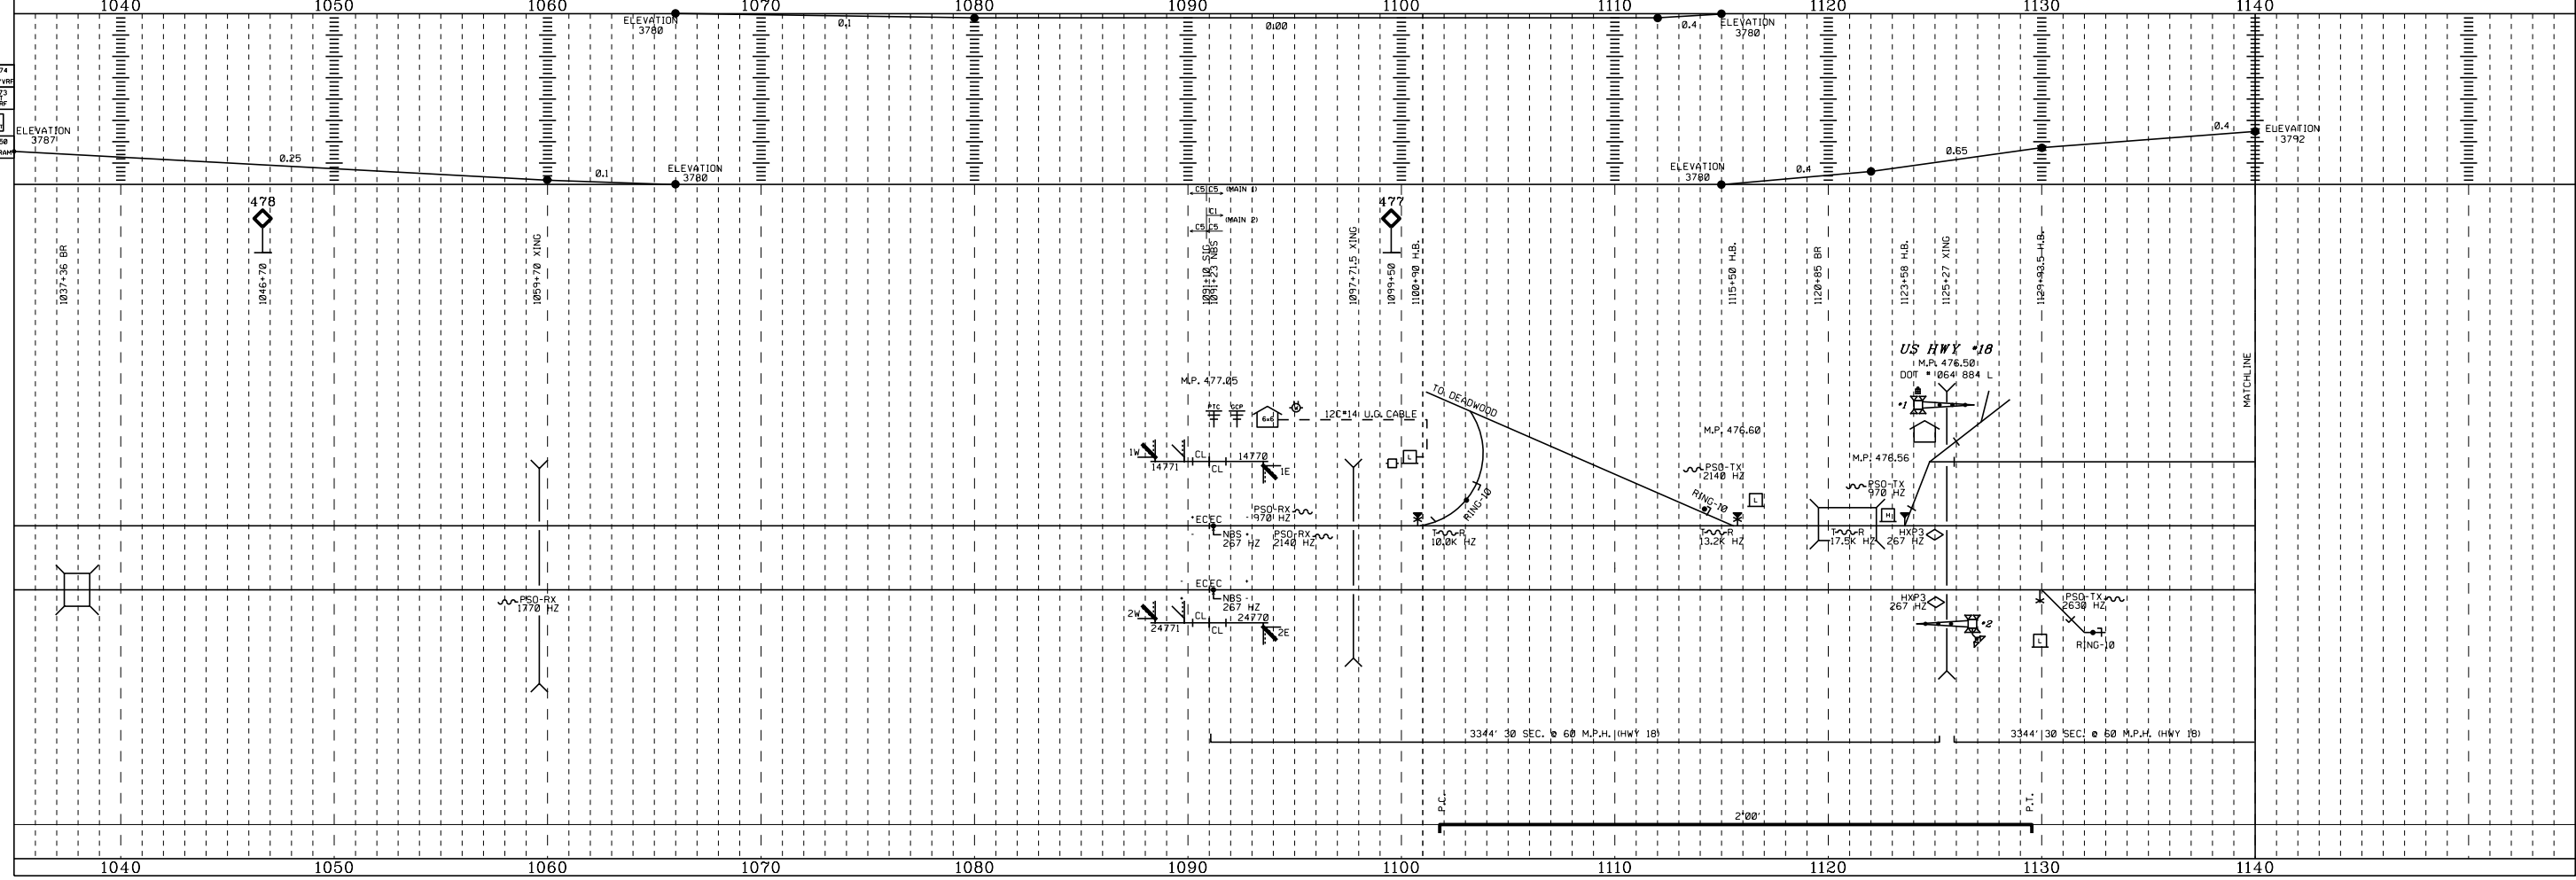

BURLINGTON NORTHERN SANTA FE RAILWAY
 TRACK PROFILE AND LOCATION PLAN
 EDGEMONT TO WEST GILLETTE
 LS 0004 MP 476 TO MP 478

11" X 33"
 SCALE:
 VERT 1"=20'
 HOR 1"=400'

CURVES
 5 1/2' X 16 1/2"
 SCALE:
 VERT 1"=40'
 HOR 1"=800'