

DAVE LINAS 7-25-2017

Final

COPY

Filing 2

COPY


1499 West 120th Ave., Ste. 200
 Denver, CO 80234-2728
 (303) 452-6611
 Fax: (303) 452-2159
 Website: www.appligate.com

**GASLINE RELOCATION
 AS-BUILT
 PLAN**

**ST - FIRESTONE, LLC.
 OAK MEADOWS P.U.D.**

REVISIONS	
NO.	DESCRIPTION
1	05/08/98 TRM WOL
2	06/04/98 TRM WOL
3	07/10/98 TRM WOL
4	08/28/98 LTD PNS

72
 72
 OF

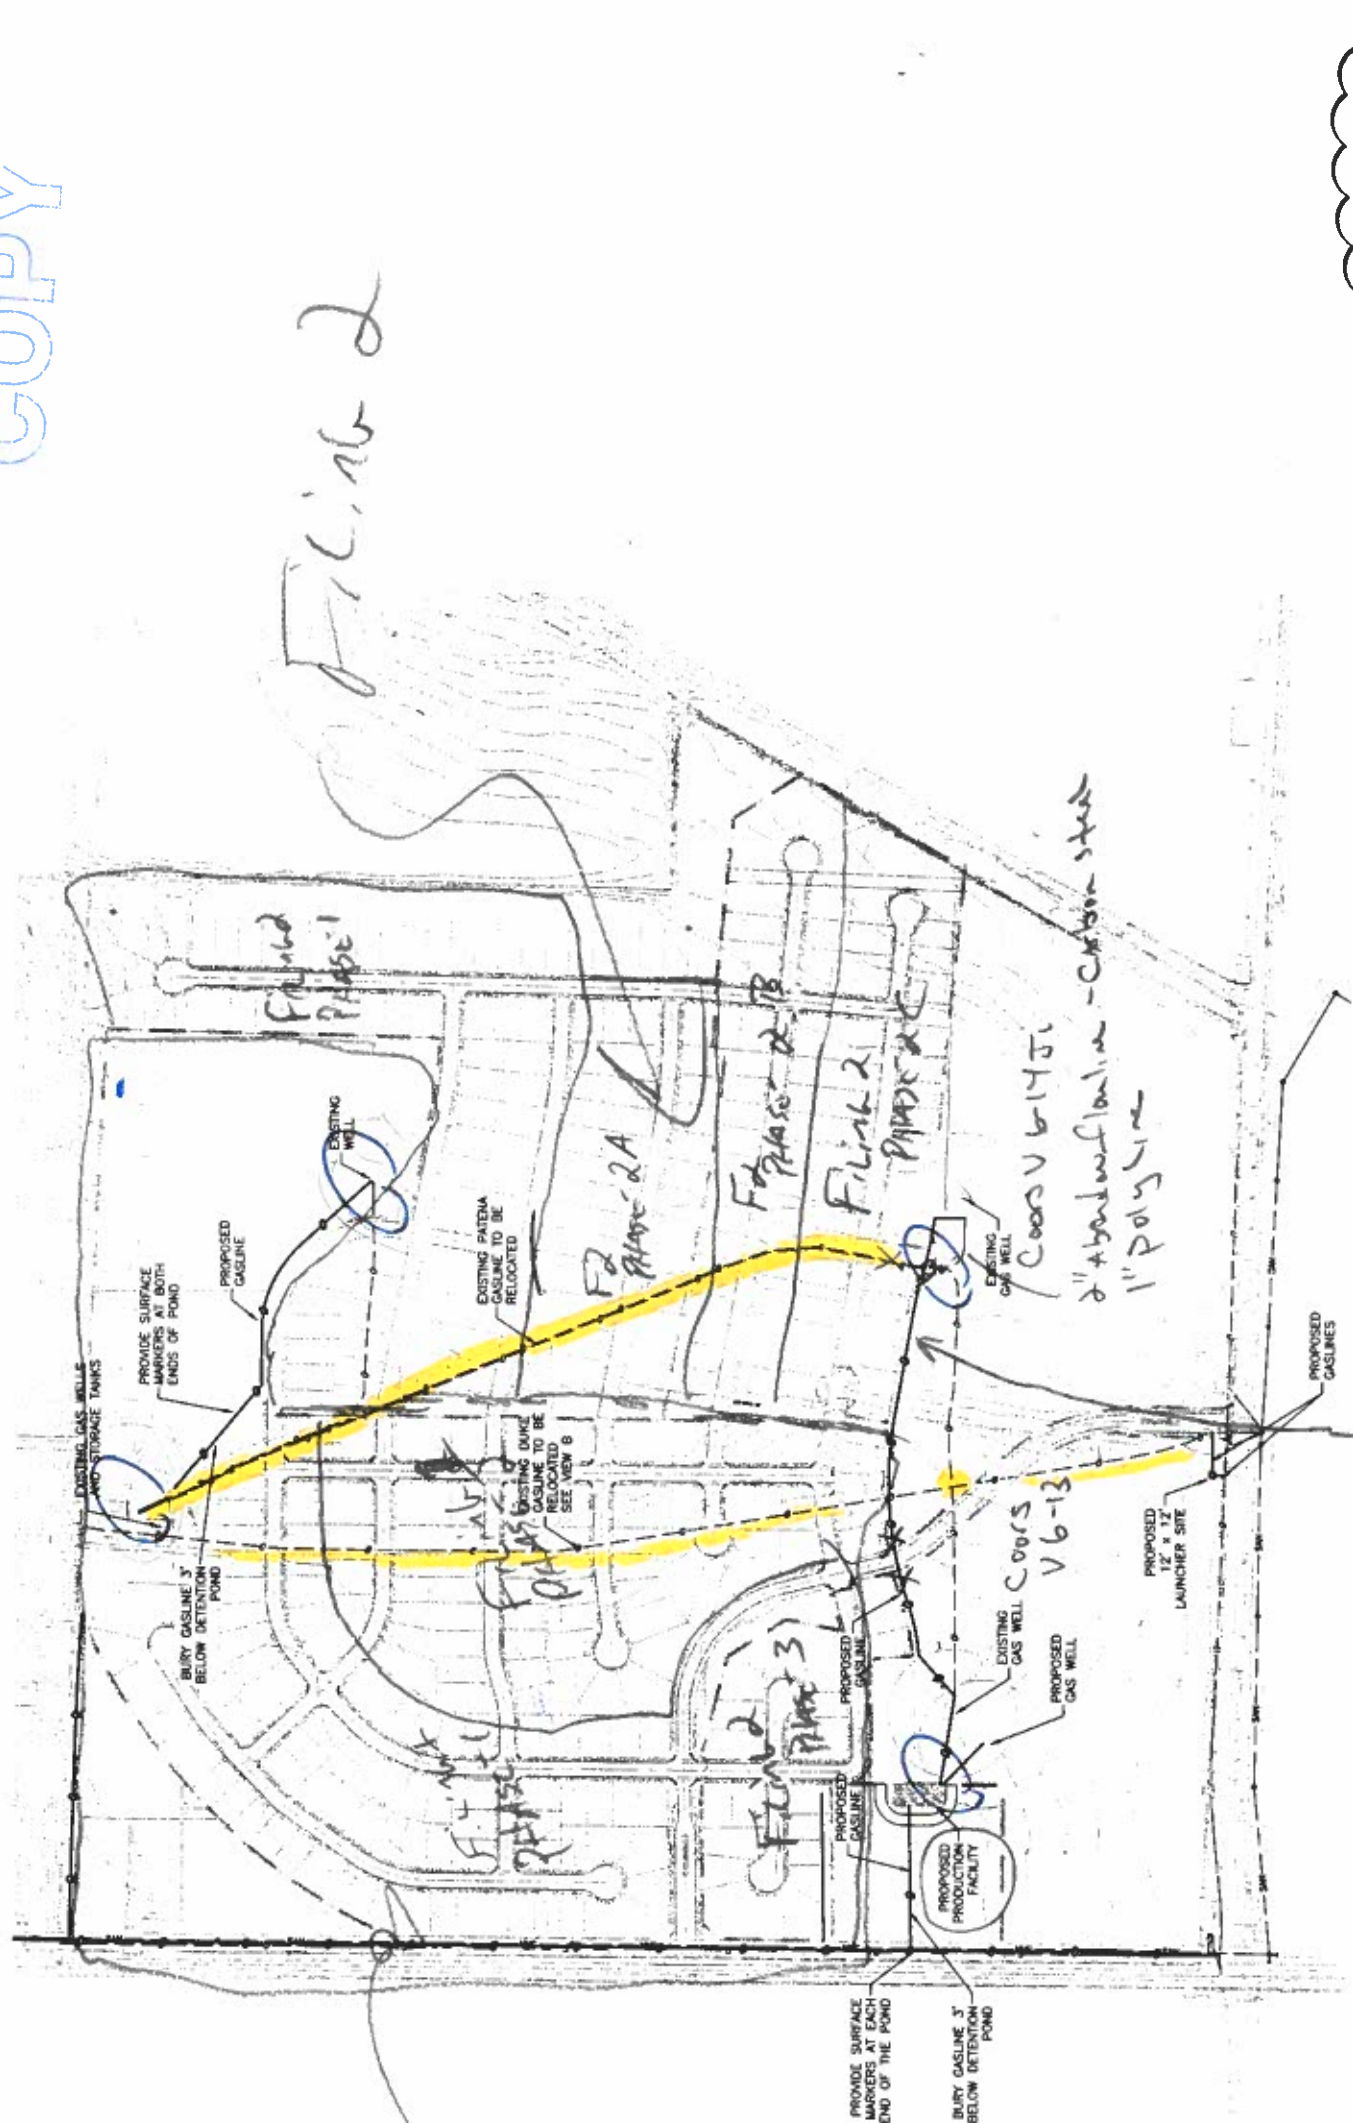

ASBUILT
 PHASE I - MODIFIED 01/15/98
 PHASE II - MODIFIED 07/01/03



LEGEND

- PROPERTY BOUNDARY
- SECTION LINES
- EXISTING ROADS
- EXISTING RIGHT-OF-WAY
- EXISTING CONTOURS
- PROPOSED STREET CENTERLINES
- PROPOSED RIGHT-OF-WAY
- FILING ONE BOUNDARY
- PHASE BOUNDARY
- PROPOSED GAS LINE

- 1) TOPOGRAPHY BY TMI PHOTOGRAMMETRIC SERVICES INC., DATED 5/7/97.
- 2) PROPERTY BOUNDARY FROM GEOSURV, DATED 02/98.
- 3) PROJECT BENCHMARK: SOUTH QUARTER CORNER OF SECTION 6, TOP OF MONUMENT CAP ON THE SOUTH SIDE OF ROAD 24, 150' EAST OF ABANDONED RAILROAD CENTERLINE (EDGE OF PAVEMENT), ELEVATION = 4860.99 BY ROCKY MOUNTAIN CONSULTANTS.
- 4) MINIMUM DEPTH OF GASLINE TO BE 36" BELOW FINAL GRADE OF ALL PROPOSED IMPROVEMENT AREAS AND TO BE LOCATED A MINIMUM OF 45' OUTSIDE SUBDIVISION BOUNDARY OR AS OTHERWISE NOTED.
- 5) GASLINE SIZES AND MATERIALS AS PER OIL AND GAS COMPANIES DESIGN REGULATIONS.