

# Attachment 5

## Major Repairs and Alterations



U.S. Department of  
Transportation  
Federal Aviation  
Administration

## MAJOR REPAIR AND ALTERATION (Airframe, Powerplant, Propeller, or Appliance)

Form Approved  
OMB No. 2120-0020

For FAA Use Only

Office Identification

INSTRUCTIONS: Print or type all entries. See FAR 43.9, FAR 43 Appendix B, and AC 43.9-1 (or subsequent revision thereof) for instructions and disposition of this form. This report is required by law (49 U.S.C. 1421). Failure to report can result in a civil penalty not to exceed \$1,000 for each such violation (Section 901 Federal Aviation Act 1958)

<b>1. Aircraft</b>	Make Grumman	Model G73T
	Serial No. J27	Nationality and Registration Mark N2969
<b>2. Owner</b>	Name (As shown on registration certificate) SeaPlane Leasing III, LLC	Address (As shown on registration certificate) 3240 Bird Ave. Ft. Lauderdale, Florida 33131

**3. For FAA Use Only**

4. Unit Identification				5. Type	
Unit	Make	Model	Serial No.	Repair	Alteration
AIRFRAME	----- (As described in item 1 above) -----				X
POWERPLANT					
PROPELLER					
APPLIANCE	Type				
	Manufacturer				

**6. Conformity Statement**

<b>A. Agency's Name and Address</b> Juan Heredia [Redacted] Miami, Florida 33147	<b>B. Kind of Agency</b> <input checked="" type="checkbox"/> U.S. Certified Mechanic <input type="checkbox"/> Foreign Certified Mechanic <input type="checkbox"/> Certified Repair Station <input type="checkbox"/> Manufacturer	<b>C. Certificate No.</b> [Redacted]
---	--	---

D. I certify that the repair and/or alteration made to the unit(s) identified in item 4 above and described on the reverse or attachments hereto have been made in accordance with the requirements of Part 43 of the U.S. Federal Aviation Regulations and that the information furnished herein is true and correct to the best of my knowledge.

Date July 6, 2000	Signature of Authorized Individual [Redacted Signature]
----------------------	--

**7. Approval for Return to Service**

Pursuant to the authority given persons specified below, the unit identified in item 4 was inspected in the manner prescribed by the Administrator of the Federal Aviation Administration and is  APPROVED  REJECTED

<b>BY</b>	FAA Fit Standards Inspector	Manufacturer	Inspection Authorization	Other (Specify) FVYA015T
	FAA Designee	Repair Station	Person Approved by Transport Canada Airworthiness Group	
Date of Approval or Rejection July 6, 2000		Certificate or Designation No. FVYA015T	Signature of Authorized Individual James Kitti, Chief Inspector [Redacted Signature]	

**NOTICE**

*Weight and balance or operating limitation changes shall be entered in the appropriate aircraft record. An alteration must be compatible with all previous alterations to assure continued conformity with the applicable airworthiness requirements.*

**8. Description of Work Accomplished**

*(If more space is required, attach additional sheets. Identify with aircraft nationality and registration mark and date work completed.)*

July 6, 2000

N2969

Stringer repaired in Right Hand wing at Sta. 50.5, third stringer from aft. See attached Drawing and 8110 #RT-G7355720.6290. Wing fuel tank resealed and leak check carried out in accordance with Frakes Service Manual. Aircraft was reweighed prior to return to service.

END



Additional Sheets Are Attached

DEPARTMENT OF TRANSPORTATION  
FEDERAL AVIATION ADMINISTRATION  
STATEMENT OF COMPLIANCE WITH THE FEDERAL AVIATION REGULATIONS

DATE  
6-30-00

AIRCRAFT OR AIRCRAFT COMPONENT IDENTIFICATION			
MAKE GRUMMAN	MODEL NO. G73T N2969	TYPE (Airplane, Radio, Helicopter, etc.) AIRPLANE	NAME OF APPLICANT CONSULTANT

IDENTIFICATION	LIST OF DATA
	TITLE
RT-G735720.6290 DTD 6/29/00 NO CHANGE	DRAWING "STRINGER CRACK REPAIR, WING BOX LOWER SKIN WS 50.5 G73T N2969."
-----END-----	-----END-----

PURPOSE OF DATA TO SHOW COMPLIANCE OF THE DATA LISTED ABOVE TO THE FAR'S LISTED BELOW


APPLICABLE REQUIREMENTS (List specific sections)

25.301	25.601	25.607
	25.603	25.609
	25.613	


CERTIFICATION - Under authority vested by direction of the Administrator and in accordance with conditions and limitations of applicable regulations, Part 183 of the Federal Aviation Regulations, data listed above and on attached sheets numbered AS ABOVE have been examined in accordance with established procedures and found to comply with applicable requirements of the Federal Aviation Regulations.

I (we) therefore  Recommend approval of these data  
 Approve these data


SIGNATURE(S) OF DESIGNATED ENGINEERING REPRESENTATIVE(S) R. L. TORRES	DESIGNATION NUMBER(S) DERY-510397-CE	CLASSIFICATION(S) STRUCTURES

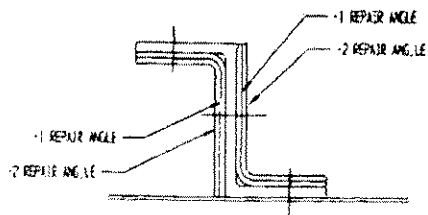

SECTION A-A

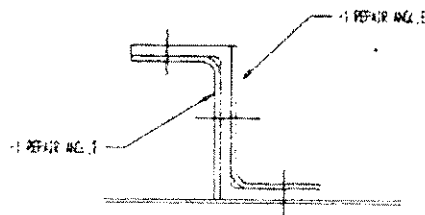

SECTION B-B

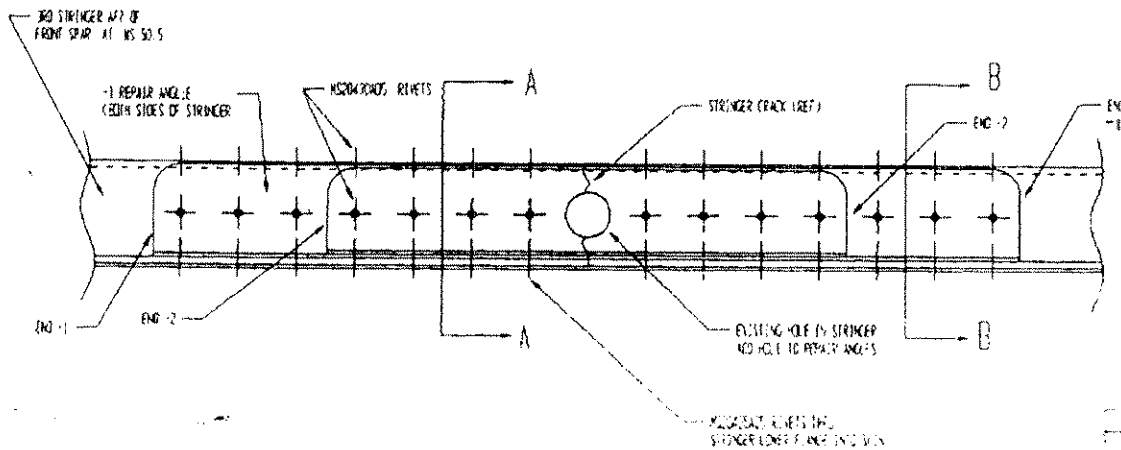

STRINGER CRACK REPAIR, WING BOX LOWER SKIN AT WS 50.5 G73T N2989

GENERAL NOTES

1. THIS DRAWING PROVIDES DETAILS FOR REPAIR OF THE CENTER WING BOX LOWER SKIN STRINGER ON GRUMMAN MALLARD G73T N2989. THE CRACK IS LOCATED ON THE 3<sup>RD</sup> STRINGER AFT FROM THE WING FRONT SPAR AT WS 50.5. THE CRACK COMPLETELY SEVERS THE STRINGER AT AN EXISTING HOLE LOCATION.
2. INSTALL NESTED ANGLE REPAIR AS SHOWN HEREIN. PICK UP EXISTING FUEL PASSAGE HOLE IN REPAIR ANGLES.
3. BREAK ALL SHARP EDGES 0.070/0.030 R.
4. FINISH ALUMINUM PARTS AND REWORKED AREAS USING ALODINE 12015 AND 2 COATS EPOXY PRIMER. REFER TO G71 SRM CHAPTER 51 FOR ADDITIONAL FINISH REQUIREMENTS.
5. DELETED
6. MAINTAIN MINIMUM 2D + 1/16 EDGE DISTANCE ON ALL FASTENERS UNLESS OTHERWISE SPECIFIED.
7. SHIM/TAPER SHIM AS REQUIRED
8. ALL FASTENERS ARE TO BE INSTALLED IN NET FIT HOLES. HOLE TOLERANCE PER NAS618.
9. ALL FASTENER LENGTHS TO BE DETERMINED ON INSTALLATION.
10. INSTALL ALL REPAIR PARTS WET USING PR14360 TYPE III FAYING SURFACE SEAL (OR EQUIVALENT)
11. RELOCATE FASTENERS AS REQUIRED TO MAINTAIN MINIMUM 3D SPACING BETWEEN ADDED FASTENERS AND EXISTING HOLES IN FRAME WEB.
12. RE-SEAL FUEL TANK AREAS PER MAINTENANCE MANUAL INSTRUCTIONS.
13. REVISE AIRCRAFT WEIGHT AND BALANCE AS APPLICABLE.

PART NAME		REV	DATE
REPAIR ANGLE		1	08/22/89
QTY	REVISION	PART NO.	SPECIFICATION
1	1		
DRAWN BY		CHECKED BY	
CHALKS		AEROSPACER	
INTERNATIONAL		STRINGER CRACK REPAIR	
		WING BOX LOWER SKIN WS 50.5	
		G73T N2989	
UNLESS OTHERWISE SPECIFIED	DIMENSIONS ARE IN INCHES	SCALE	
UNSPECIFIED TOLERANCE		1/16"	
FRACTION	ANGLES	DECIMAL	
1/16"	1.5 PACK	1.1	
	1.2 FOR 10	1.0	
		DATE	01/10/90
		BY	RI-073572-5390

**MAJOR REPAIR AND ALTERATION**  
**(Airframe, Powerplant, Propeller, or Appliance)**

FOR FAA USE ONLY

OFFICE IDENTIFICATION

INSTRUCTIONS: Print or type all entries. See FAR 43.9, FAR 43 Appendix B, and AC 43.9-1 (or subsequent revision thereof) for instructions and disposition of this form.

1. AIRCRAFT	MAKE GRUMMAN	MODEL G-73
	SERIAL NO. J-27	NATIONALITY AND REGISTRATION MARK N-2969
2. OWNER	NAME (As shown on registration certificate) FLYING BOAT, INC.	ADDRESS (As shown on registration certificate) 1100 LEE WAGENER BLVD. FT. LAUDERDALE, FL 33315

3. FOR FAA USE ONLY

4. UNIT IDENTIFICATION

UNIT	MAKE	MODEL	SERIAL NO.	5. TYPE	
				REPAIR	ALTERATION
AIRFRAME	***** (As described in item 1 above) *****			X	
POWERPLANT					
PROPELLER					
APPLIANCE	TYPE				
	MANUFACTURER				

6. CONFORMITY STATEMENT

A. AGENCY'S NAME AND ADDRESS PATRICK L. FLYNN [REDACTED] FT. LAUDERDALE, FL 33314	B. KIND OF AGENCY <input checked="" type="checkbox"/> U.S. CERTIFICATED MECHANIC <input type="checkbox"/> FOREIGN CERTIFICATED MECHANIC <input type="checkbox"/> CERTIFICATED REPAIR STATION <input type="checkbox"/> MANUFACTURER	C. CERTIFICATE NO. AIRFRAME CERT. # [REDACTED]
--	--	--

D. I certify that the repair and/or alteration made to the unit(s) identified in item 4 above and described on the reverse or attachments hereto have been made in accordance with the requirements of Part 43 of the U.S. Federal Aviation Regulations and that the information furnished herein is true and correct to the best of my knowledge.

DATE 5-6-92	SIGNATURE OF AUTHORIZED INDIVIDUAL [Signature] PATRICK L. FLYNN
----------------	---

7. APPROVAL FOR RETURN TO SERVICE

Pursuant to the authority given persons specified below, the unit identified in item 4 was inspected in the manner prescribed by the Administrator of the Federal Aviation Administration and is  APPROVED  REJECTED

BY	FAA FLT. STANDARDS INSPECTOR	MANUFACTURER	INSPECTION AUTHORIZATION	OTHER (Specify) 135 AIR CARRIER #FVYA015T
	FAA DESIGNEE	REPAIR STATION	CANADIAN DEPARTMENT OF TRANSPORT INSPECTOR OF AIRCRAFT	
DATE OF APPROVAL OR REJECTION 5-6-92	CERTIFICATE OR DESIGNATION NO. [REDACTED]	SIGNATURE OF AUTHORIZED INDIVIDUAL [Signature] PETER R. BARRY		

## NOTICE

Weight and balance or operating limitation changes shall be entered in the appropriate aircraft record. An alteration must be compatible with all previous alterations to assure continued conformity with the applicable airworthiness requirements.

8. DESCRIPTION OF WORK ACCOMPLISHED (If more space is required, attach additional sheets. Identify with aircraft nationality and registration mark and date work completed.)

PERFORMED REPAIR TO LEFT LOWER WING SKIN ON AIRCRAFT N2969 S/N J-27. REPAIR WAS DONE IN ACCORDANCE WITH AIRCRAFT ENGINEERING AND MODIFICATION SERVICES DRAWING 9212221-01 REV IR. ALL WORK WAS DONE AT THE INTERSECTION OF WING AND FUSELAGE. DAMAGE WAS DONE BY CORROSION. SEE ATTACHED AEMS DRAWING FOR A DETAILED REPAIR. NEGLIABLE CHANGE TO WEIGHT AND BALANCE.

END

---

ADDITIONAL SHEETS ARE ATTACHED

U.S. DEPARTMENT OF TRANSPORTATION  
 FEDERAL AVIATION ADMINISTRATION  
**STATEMENT OF COMPLIANCE WITH THE FEDERAL AVIATION REGULATIONS**

DATE  
 MAY 05, 1992

**AIRCRAFT OR AIRCRAFT COMPONENT IDENTIFICATION**

MAKE <b>GRUMMAN</b>	MODEL NO. <b>G-73T</b>	TYPE (Airplane, Radio, Helicopter, etc.) <b>AIRPLANE</b>	NAME OF APPLICANT <b>CONSULTANT</b>
------------------------	---------------------------	---	--

**LIST OF DATA**

IDENTIFICATION	TITLE
9212221-01 REV IR DATED 05 MAY 92	<u>A.E.M.SERVICES DRAWING, G-73T WING LOWER SKIN REPAIR AT FUSELAGE INTERSECTION</u>
END    END    END	END    END    END    END    END    END    END    END


PURPOSE OF DATA                      **TO APPROVE AND PROVIDE A RECORD OF THE ABOVE REPAIR.**

APPLICABLE REQUIREMENTS (List specific sections)

FAR 25.307(a), 25.601, 25.603, 25.605, 25.609, 25.613(a),  
 25.613(b), 25.625(a)

**CERTIFICATION** - Under authority vested by direction of the Administrator and in accordance with conditions and limitations of appointment under Part 183 of the Federal Aviation Regulations, data listed above ~~and on attached sheets numbered~~ have been examined in accordance with established procedures and found to comply with applicable requirements of the Federal Aviation Regulations.

I  Therefore  Recommend approval of these data  
 Approve these data

SIGNATURE(S) OF DESIGNATED ENGINEERING REPRESENTATIVE(S)	DESIGNATION NUMBER(S)	CLASSIFICATION(S)
	S0-745	STRUCTURES
ROBERT M. HALVORSON		



9212221-12621

Mr. Donald T. Buckley  
Manager, Airframe Branch ACE-120A  
Atlanta Aircraft Certification Office  
Federal Aviation Administration  
1669 Phoenix Parkway, Suite 210C  
Atlanta, Georgia 30349

5 May, 1992

Enclosures: (1) 8110-3 Form dated 05 May 1992, Approval of Repair  
Drawing 9212221-01 rev IR, Grumman G-73T

Dear Mr. Buckley:

Enclosed please find the original of an 8110-3 form approving a repair procedure for the left wing lower skin at the intersection with the fuselage of a Frakes/Grumman G-73T aircraft, S/N J-27, N2969. The damage was due to corrosion. The repair will be accomplished by Chalks' International Airlines under their repair station operation.

The original of this drawing is on file at A.E.M. Services. Copies of the 8110-3 form and repair drawing have been provided to Chalks'.

Please include a copy of the attached form in my DER activity file.

Very truly yours,



Robert M. Halvorson, P.E.

FAA-DER SO-745

REVISIONS			
LTR	DESCRIPTION (INCORPORATED DCN' s)	DATE	APPROVED
1R	INITIAL RELEASE	5/5/92	<i>[Signature]</i>

APPROVALS	
SIGNATURES BELOW CONVEY APPROVAL OF DRAWING INITIAL RELEASE ONLY	
DRAWN <input checked="" type="checkbox"/> <i>[Signature]</i>	DATE 5/5/92
CHECKED <input checked="" type="checkbox"/> <i>[Signature]</i>	DATE 5/5/92
PROJECT <input type="checkbox"/>	DATE
ELECTRICAL <input type="checkbox"/>	DATE
SYSTEMS <input type="checkbox"/>	DATE
STRESS <input checked="" type="checkbox"/> <i>[Signature]</i>	DATE 5/5/92
PRODUCTION <input type="checkbox"/>	DATE
QA <input type="checkbox"/>	DATE
DESIGN <input type="checkbox"/>	DATE
CUSTOMER <input checked="" type="checkbox"/> <i>[Signature]</i>	DATE 5/5/92

DRAWING TITLE  
**G-73T WING LOWER SKIN REPAIR  
 AT FUSELAGE INTERSECTION**

UNLESS SPECIFIED OTHERWISE  
 ALL DIMENSIONS ARE IN INCHES  
 TOLERANCES: ANGLES ± 0°-30'  
                   .XXX ± .015  
                   .X ± .06    .XX ± .03

SIZE <b>A</b>	DRAWING NUMBER <b>9212221-01</b>
SCALE: AS NOTED	SHEET 1 OF 9

003L REV 07JUL89

THIS DRAWING AND/OR DATA IS THE EXCLUSIVE PROPERTY OF AIRCRAFT ENGINEERING AND MODIFICATION SERVICES, INCORPORATED, OR CONTAINS THE PROPRIETARY RIGHTS OF OTHERS, AND IS RESTRICTED FOR USE BY DESIGNATED PERSONS, FIRMS, OR CORPORATIONS WITH WHOM CONTRACTS HAVE BEEN ENTERED INTO. IT SHALL NOT BE USED, REPRODUCED, OR DISCLOSED, IN WHOLE OR IN PART, OR USED FOR ANY DESIGN OR MANUFACTURE, EXCEPT WHEN SUCH USER POSSESSES DIRECT, WRITTEN AUTHORIZATION FROM A.E.M. SERVICES.



QUANTITY REQUIRED						LIST OF MATERIALS						
						PART NUMBER	DESCRIPTION	MATERIAL	SPEC/VEND	HT	FIN	SHT
				-3	-1	-1	SKIN REPAIR					
				-	-	-3	VERTICAL WEB REPAIR					
				1		-5	ANGLE	.050 2024-T3	QR-A-250/5		▷	
				-1		-9	CLIP	.050 2024-T3	QR-A-250/5		▷	
					1	-11	DOUBLER	.090 2024-T3	QR-A-250/5		▷	
					1	-13	BACKING PLATE	.050 2024-T3	QR-A-250/5		▷	
					1	-15	FILLER	.050 2024-T3	QR-A-250/5		▷	
						A/R NAS1103-( )	BOLT					
						AN960KD10	WASHER					
						NAS679A30	NUT					
				A/R		MS20470AD5	RIVET					
				A/R		MS20470A04	RIVET					

DRAWN  
 DATE 5/5/92  
 CHECKED  
 DATE  
 APPROVED  
 DATE 5/5/92

TITLE G-73T WING LOWER SKIN REPAIR AT FUSELAGE INTERSECTION  
 NUMBER 921221-01  
 REV 1R  
 DATA FILE NAME(S)  
 SHEET 3

**A.E.M. SERVICES**

Aircraft Engineering & Modification Services, Incorporated • Miami, Florida



THIS DRAWING AND/OR DATA IS THE EXCLUSIVE PROPERTY OF AIRCRAFT ENGINEERING AND MODIFICATION SERVICES, INCORPORATED, OR CONTAINS THE PROPRIETARY RIGHTS OF OTHERS, AND IS RESTRICTED FOR USE BY DESIGNATED PERSONS, FIRMS, OR CORPORATION, WITH WHOM CONTRACTS HAVE BEEN ENTERED INTO. IT SHALL NOT BE USED, REPRODUCED, OR DISCLOSED, IN WHOLE OR IN PART, OR USED FOR ANY DESIGN OR MANUFACTURE, EXCEPT WHEN SUCH USER POSSESSES DIRECT, WRITTEN AUTHORIZATION FROM A.E.M. SERVICES.

## APPLICATION DATA

PART NUMBER	QTY	NEXT ASSEMBLY	PART NUMBER	QTY	NEXT ASSEMBLY
-1	1	6-73T S/N	J-27		
-3	1	6-73T S/N	J-27		

**NOTES:**


1. ALL WORK PERFORMED I.A.W. SRM PRACTICES.
2. **FINISH:** WASH PRIME, ZINC CHROMATE PRIME OR MIL-P-23377, 2 COATS.
3. INSTALL ALL PARTS WET W/ PR1422 0 1/2 SEALANT, FAYING SURFACES AND FASTENERS.
4. BOLTS INSTALL W/ CLOSE TOLERANCE FIT.
5. PRIOR TO INSTALLATION OF REPAIR PARTS, REMOVE ALL CORROSION, SMOOTH AND PRIME ALL EXPOSED METAL.
6. -11 DOUBLER REPLACES EXISTING SHIM AND DRAIN PLUG DOUBLER.

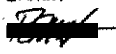DRAWN 	DATE 5/5/92	CHECKED 	DATE 	PROJECT 	DATE 5/5/92
TITLE 6-73T WING LOWER SKIN REPAIR AT FUSELAGE INTERSECTION				DWG NBR 9212221-01	REV 
				SHEET 4	

003L REV 07 JUL 89

THIS DRAWING AND/OR DATA IS THE EXCLUSIVE PROPERTY OF AIRCRAFT ENGINEERING AND MODIFICATION SERVICES, INCORPORATED, OR CONTAINS THE PROPRIETARY RIGHTS OF OTHERS AND IS RESTRICTED FOR USE BY DESIGNATED PERSONS, FIRMS OR CORPORATIONS WITH WHOM CONTRACTS HAVE BEEN ENTERED INTO. IT SHALL NOT BE USED, REPRODUCED, OR DISCLOSED, IN WHOLE OR IN PART, OR USED FOR ANY DESIGN OR MANUFACTURE, EXCEPT WHEN SUCH USER POSSESSES DIRECT, WRITTEN AUTHORIZATION FROM A.E.M. SERVICES.


DRAWN <i>[Signature]</i>	DATE 5/5/92	CHECKED	DATE	APPROVED <i>[Signature]</i>	DATE 5/5/92
-----------------------------	----------------	---------	------	--------------------------------	----------------

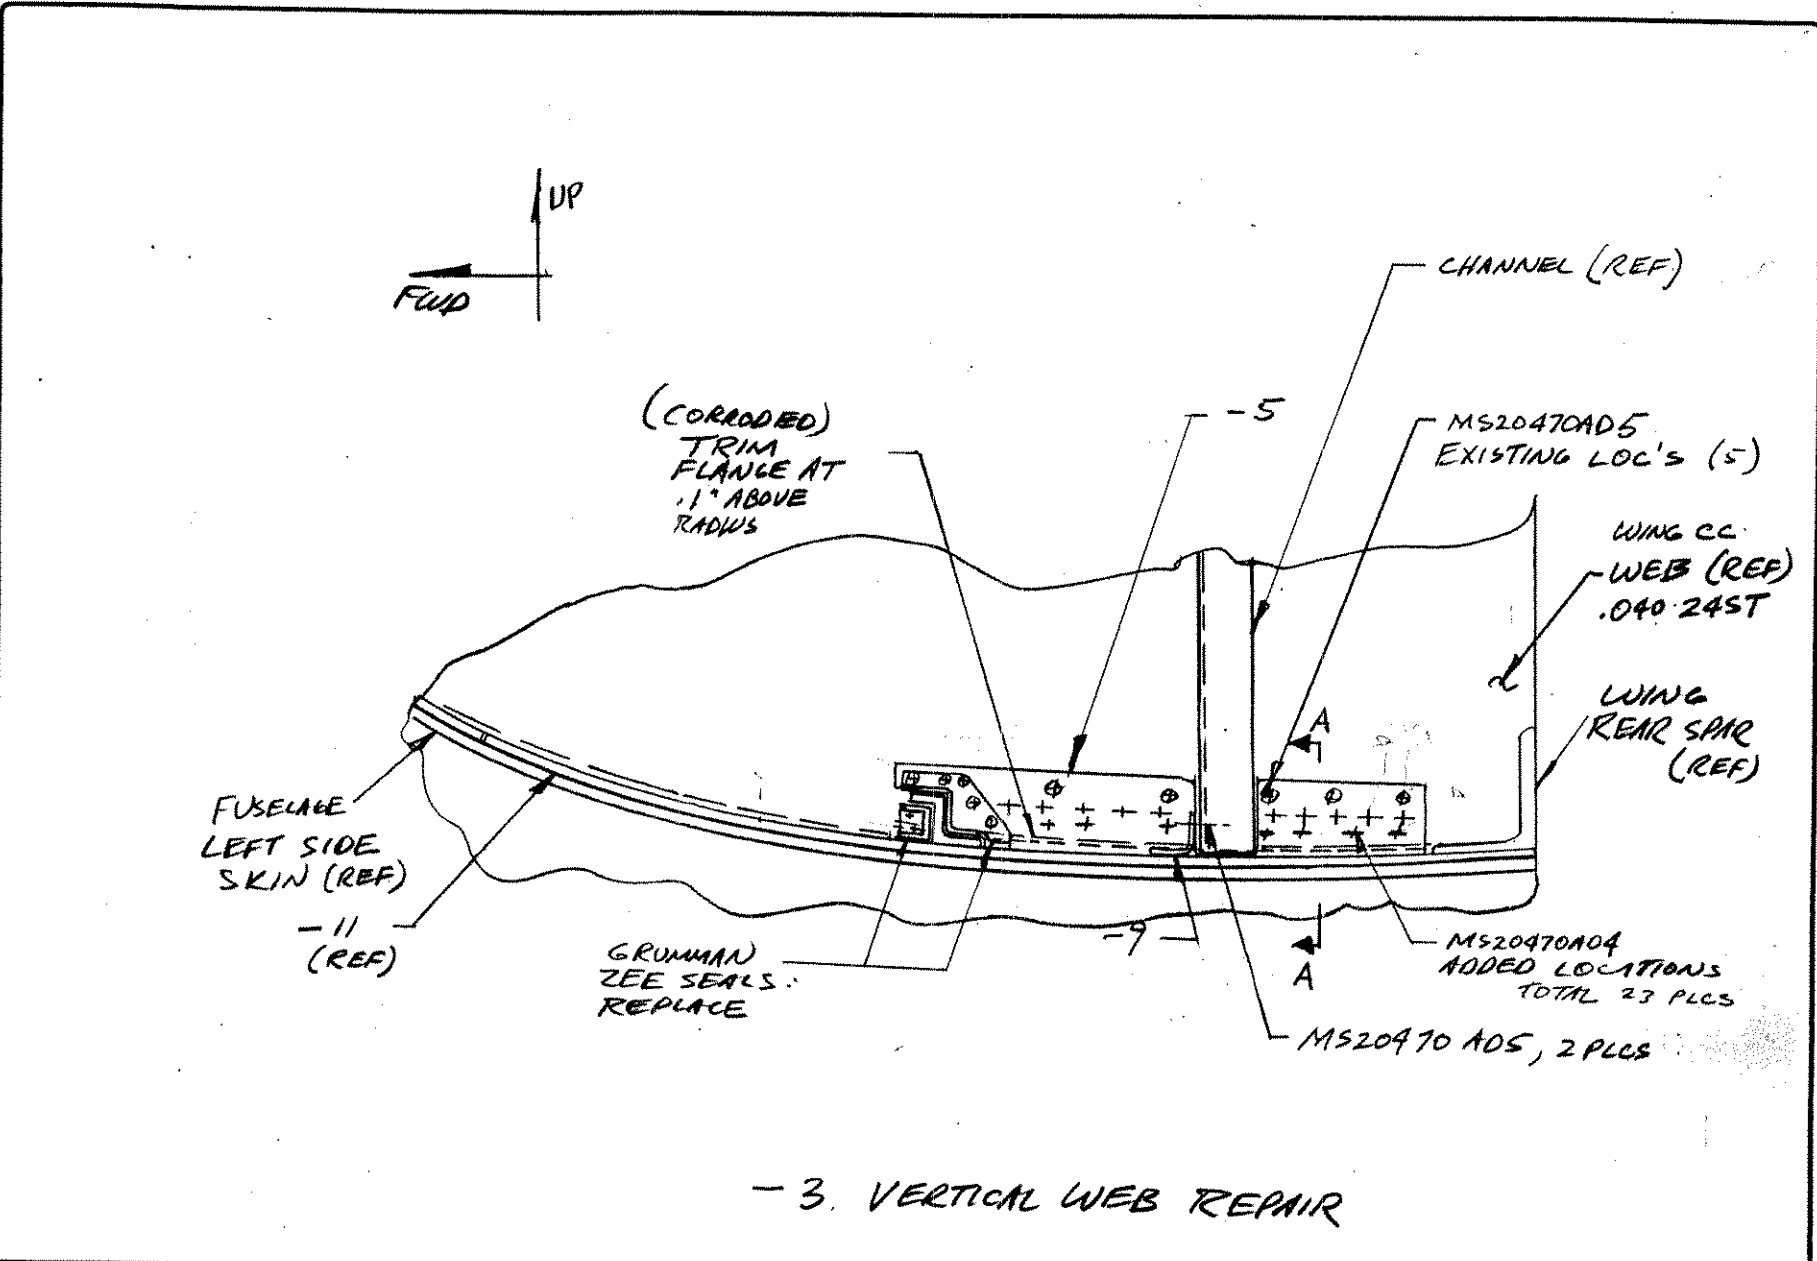

- 3. VERTICAL WEB REPAIR

TITLE C-737 WING LOWER SKIN REPAIR AT FUSELAGE INTERSECTION	NUMBER 9212221-01	DIM SCL FACTOR	SCALE NONE	REV IR	SHEET 5
---	----------------------	----------------	---------------	-----------	---------

DRAWN  
 DATE 5/5/92  
 CHECKED  
 DATE  
 APPROVED  
 DATE 5/5/92

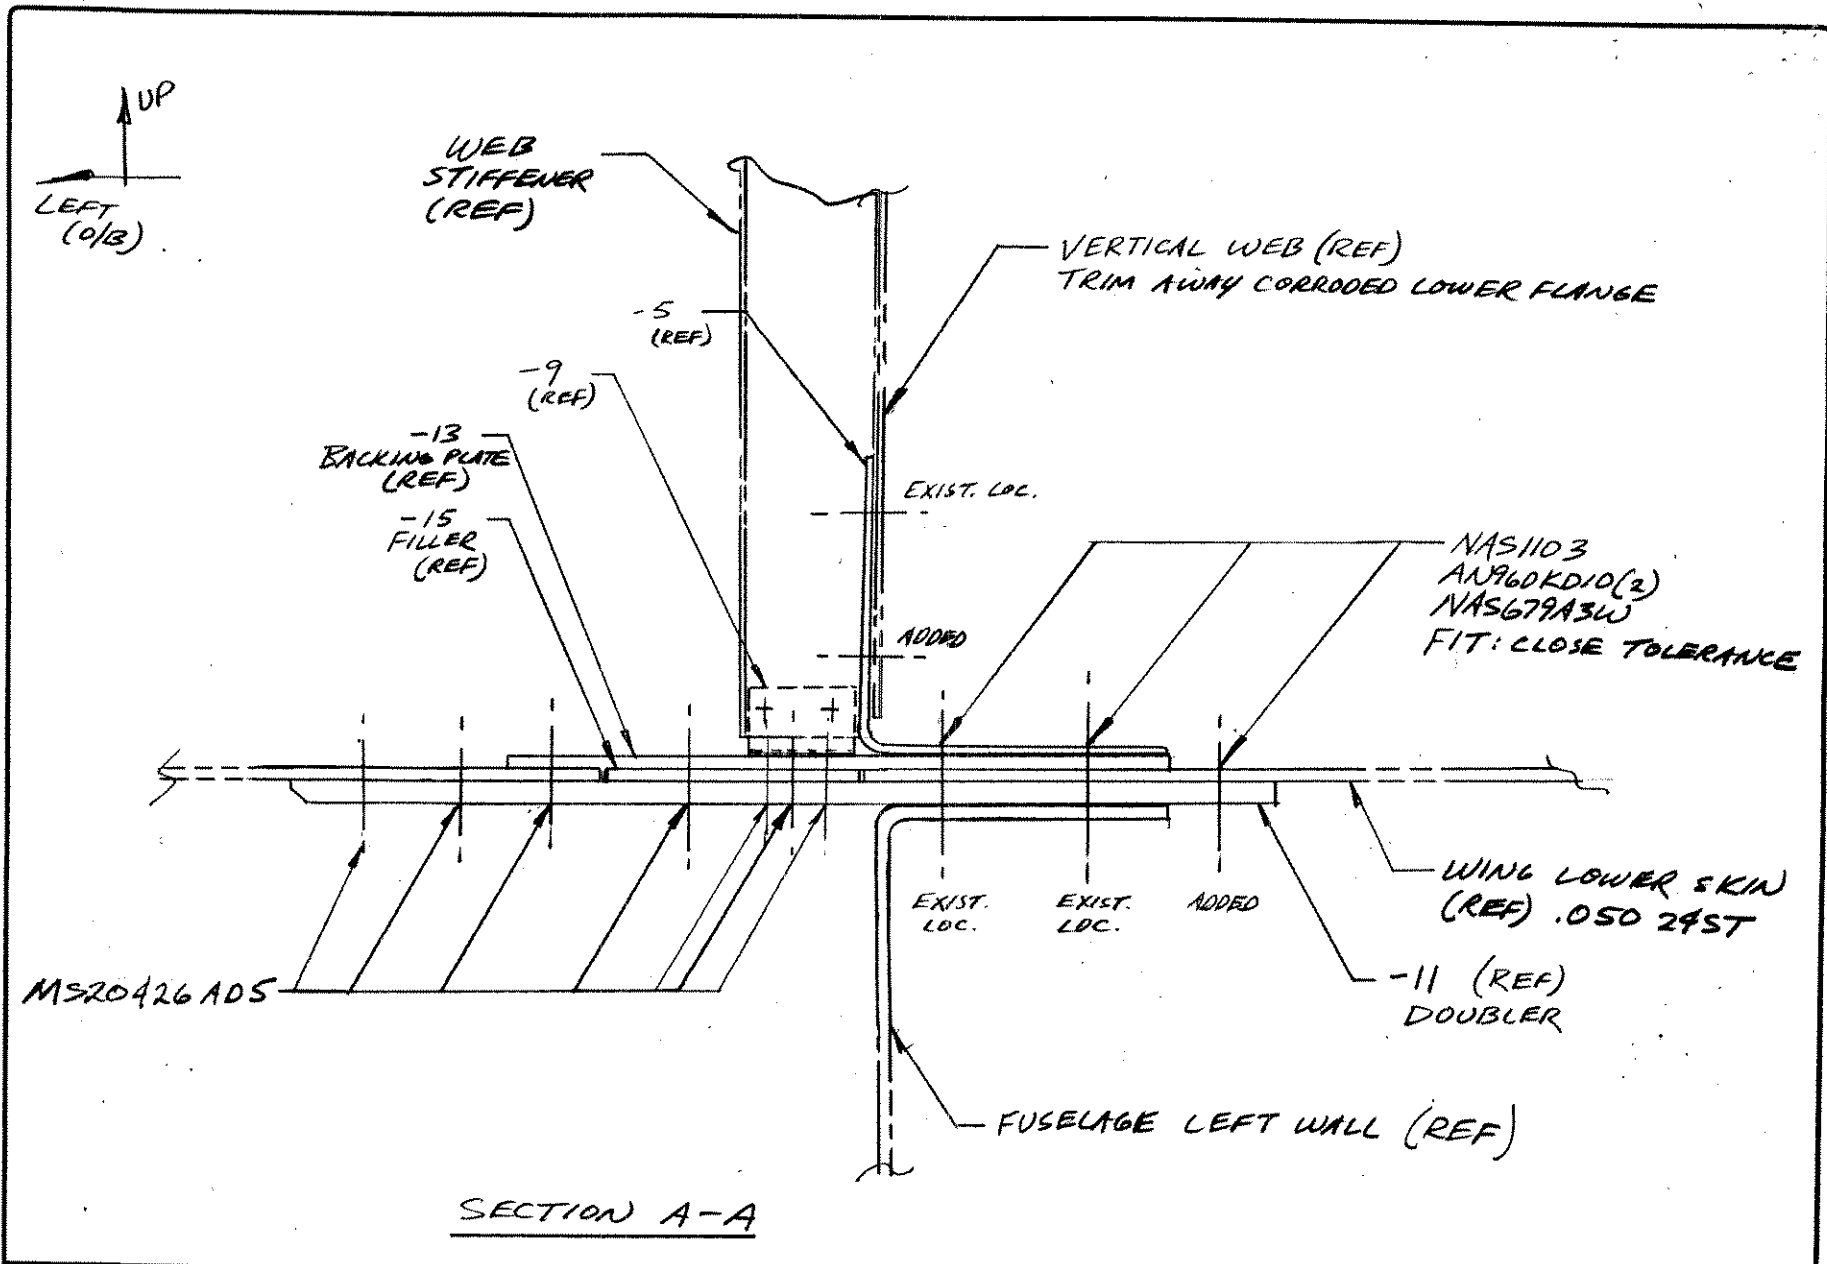


TITLE 6-73T WING LOWER SKIN REPAIR AT FUSELAGE INTERSECTION	NUMBER 921221-01	DIM SCL FACTOR	SCALE NONE	REV 1R	SHEET 6
---	------------------	----------------	------------	--------	---------

**A.E.M. SERVICES**

Aircraft Engineering & Modification Services, Incorporated • Miami, Florida

THIS DRAWING AND/OR DATA IS THE EXCLUSIVE PROPERTY OF AIRCRAFT ENGINEERING AND MODIFICATION SERVICES, INCORPORATED, OR CONTAINS THE PROPRIETARY RIGHTS OF OTHERS, AND IS RESTRICTED FOR USE BY DESIGNATED PERSONS, FIRMS, OR CORPORATIONS WITH WHOM CONTRACTS HAVE BEEN ENTERED INTO. IT SHALL NOT BE USED, REPRODUCED, OR DISCLOSED, IN WHOLE OR IN PART, OR USED FOR ANY DESIGN OR MANUFACTURE, EXCEPT WHEN SUCH USER POSSESSES DIRECT, WRITTEN AUTHORIZATION FROM A.E.M. SERVICES

DRAWN <i>[Signature]</i>	DATE 5/5/82	CHECKED	DATE	APPROVED <i>[Signature]</i>	DATE 5/5/82
-----------------------------	----------------	---------	------	--------------------------------	----------------

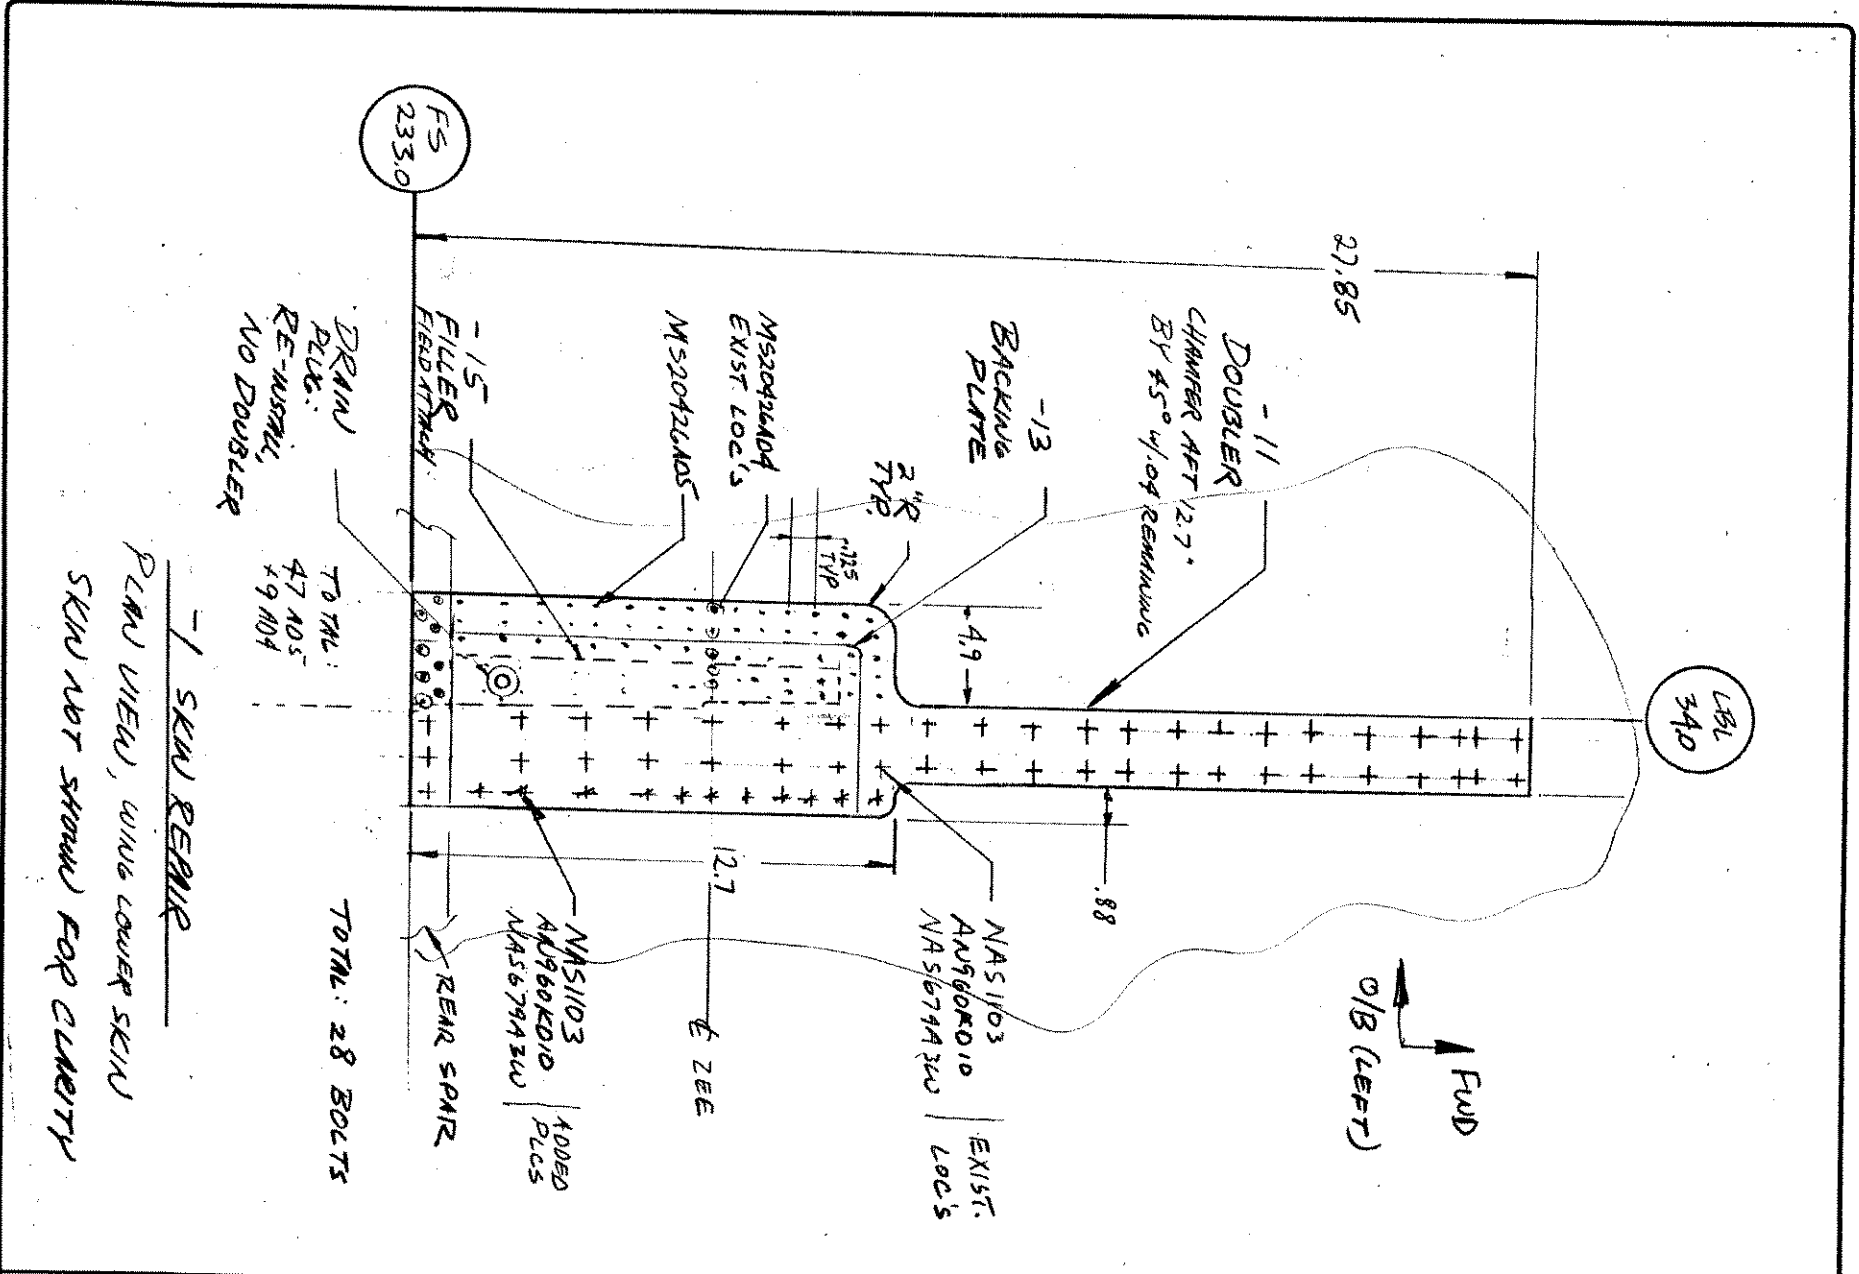


-1 SKIN REPAIR  
 PLAN VIEW, WING LOWER SKIN  
 SKIN NOT SHOWN FOR CLARITY

TITLE G-73T WING LOWER SKIN REPAIR AT FUSELAGE INTERSECTION	NUMBER 9212221-01	DIM SCL FACTOR -	SCALE NONE	REV 1R	SHEET 7
--	----------------------	---------------------	---------------	-----------	---------



	DRAWN
5/5/82	DATE
	CHECKED
	DATE
	APPROVED
5/5/82	DATE

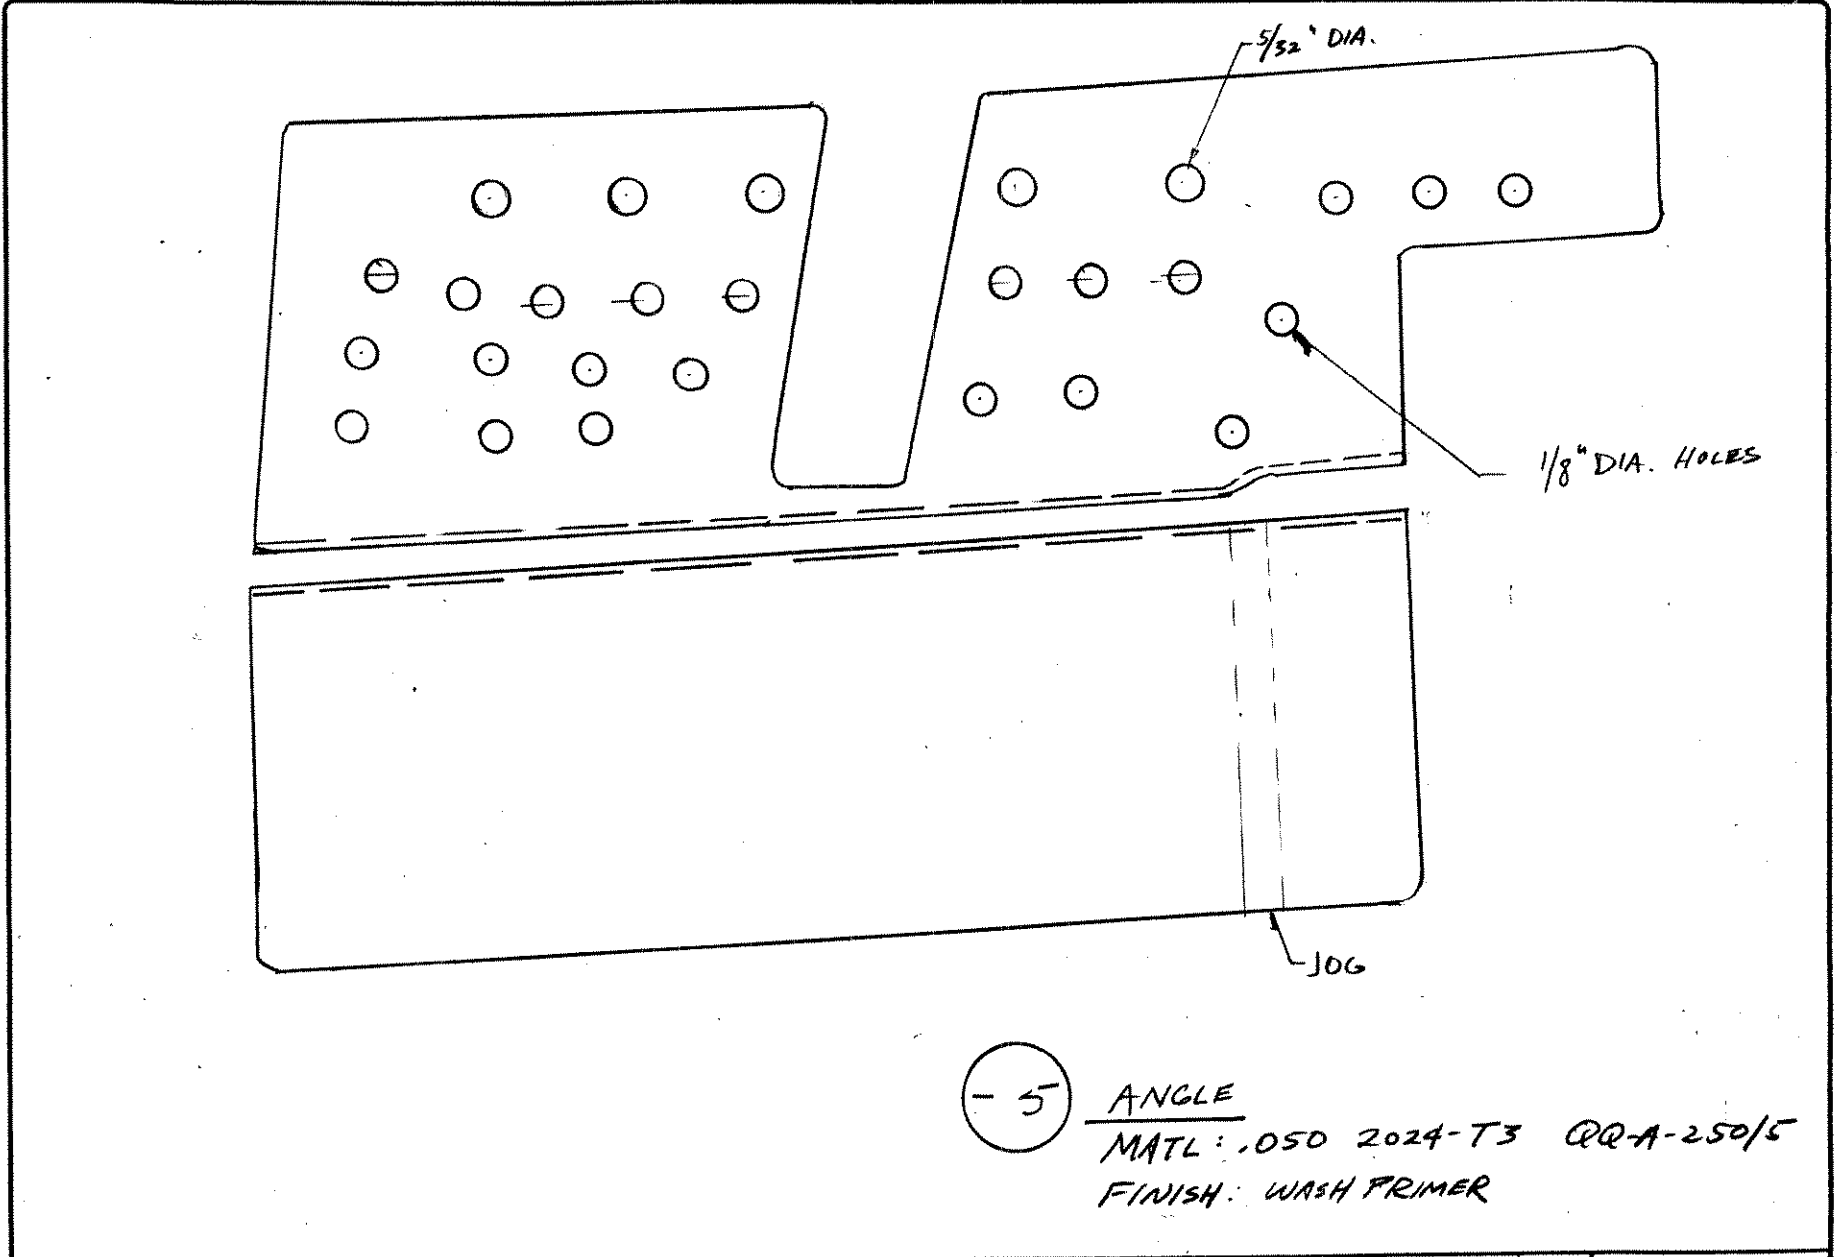

(-5) ANGLE  
 MATL: .050 2024-T3 QQ-A-250/5  
 FINISH: WASH PRIMER

TITLE	G-73T WING LOWER SKIN REPAIR AT FUSELAGE INTERSECTION	NUMBER	9212221-01	DIM SCL FACTOR	SCALE	REV	SHEET
					FULL	1R	8

**REPAIR, G-73T MALLARD WING LOWER SKIN AT DRY BAY AREA**

Damage was caused by corrosion of a clip attaching a vertical web stiffener to the wing lower skin. Clip is replaced with -9 clip. Corroded wing skin and vertical web lower flange were removed, along with corroded shim strap and zee seal clips. Replacement strap was fabricated and widened to serve as a doubler; zee seals were replaced. Skin was repaired with this doubler and backing plate; vertical web was repaired with angle -5.

Skin strength out:  $[10.2" - (8 \times .190") - (2 \times .125")] \times .050" \times 64 \text{ ksi } [F_{tu}, \text{ ref. MIL HDBK 5F, 3.2.3.0 (b}_1)] = 26,976 \text{ lb.}$

Skin strength returned =  $[12.7 - (13 \times .190")] \times .090" \times 64 \text{ ksi} = 58,924 \text{ lb. M.S.} = 58.9/27 - 1 = \underline{+1.18.}$

**Transfer:**

O/B Side: MS20426AD5 Rivet strength, shear =  $596 \text{ lb} \times .995 = 593 \text{ lb}$  [ref. MIL HDBK 5F, 8.1.2(b), 8.1.2.1(b)];  
 AD4 =  $388 \text{ lb} \times 1.000 = 388 \text{ lb.}$   
 Bearing:  $121 \text{ ksi } [F_{bru}, \text{ ref. MIL HDBK 5F, 3.2.3.0 (b}_1)] \times 5/32" \times .050" = 945 \text{ lb.} \Rightarrow \text{crit.in shear.}$

Using min. 47 rivets, MS20426AD5, and 9 rivets, MS20426AD4,  
 M.S. =  $[(593 \times 47) + (388 \times 9)] / (26976 \times 1.15) - 1 = \underline{+0.011.}$

I/B Side: Bolt strength, shear =  $2694 \text{ lb}$  [ref. MIL HDBK 5F, 8.1.5(a)]  
 Bearing:  $121 \text{ ksi} \times .190" \times .050" = 1149.5 \text{ lb.} \Rightarrow \text{crit.in bearing.}$

Using min. 28 bolts, NAS1103,  
 M.S. =  $(1149.5 \times 28) / (26976 \times 1.15) - 1 = \underline{+0.044.}$

Web repair: Corrosion damage requires replacement of flange. Capacity of flange in shear is  $39 \text{ ksi } [F_{su}, \text{ ref. MIL HDBK 5F, 3.2.3.0 (b}_1)] \times .040" \times 5.5" = 8,580 \text{ lb. Doubler is .050 2024-T3 clad.}$

Transfer: MS20470AD5 Rivet strength, shear =  $596 \text{ lb} \times .964 = 574 \text{ lb}$  [ref. MIL HDBK 5F, 8.1.2(b), 8.1.2.1(b)].  
 AD4 strength =  $388 \text{ lb} \times .995 = 386 \text{ lb.}$   
 Bearing:  $121 \text{ ksi } [F_{bru}, \text{ ref. MIL HDBK 5F, 3.2.3.0 (b}_1)] \times 5/32" \times .040" = 756 \text{ lb.} \Rightarrow \text{crit.in shear.}$

Using min. 5 rivets, MS20470AD5, and 23 rivets, MS20470AD4,  
 M.S. =  $[(574 \times 5) + (386 \times 23)] / (8580 \times 1.15) - 1 = \underline{+0.191.}$

SHEET A-1  
 REV IR  
 SCALE N/A  
 DIM SCL FACTOR  
 NUMBER 92/2221-01  
 TITLE G-73T WING LOWER SKIN REPAIR AT FUSELAGE INTERSECTION

Aircraft Engineering & Modification Services, Incorporated • Miami, Florida  
 THIS DRAWING AND/OR DATA IS THE EXCLUSIVE PROPERTY OF AIRCRAFT ENGINEERING AND MODIFICATION SERVICES, INCORPORATED, OR CONTAINS THE PROPRIETARY RIGHTS OF OTHERS, AND IS RESTRICTED FOR USE BY DESIGNATED PERSONS, FIRMS, OR CORPORATIONS. WITH WHOM CONTRACTS HAVE BEEN ENTERED INTO IT SHALL NOT BE USED, REPRODUCED, OR DISCLOSED, IN WHOLE OR IN PART, OR USED FOR ANY DESIGN OR MANUFACTURE, EXCEPT WHEN SUCH USER POSSESSES DIRECT, WRITTEN AUTHORIZATION FROM A.E.M. SERVICES.

0088 REV 13 OCT 88

DRAWN	DATE	CHECKED	DATE	APPROVED	DATE
<i>[Signature]</i>	5/5/92			<i>[Signature]</i>	5/5/92

**A.E.M. SERVICES**

FLYING

BOAT

INCORPORATED

PAGE: 55016

DATE: 6/15/90

REVISION: ORIGINAL

REPAIR REPORT PAGE 3 OF 3  
 REPAIR NUMBER 40292  
 DATE 4-13-92  
 AIRCRAFT N 2969 SERIAL # J-27

6. CONFORMITY STATEMENT

A. AGENCY'S NAME AND ADDRESS	B. KIND OF AGENCY	C. CERTIFICATE NO.
PATRICK L. FLYNN [REDACTED] FT. LAUDERDALE, FL 33314	<input checked="" type="checkbox"/> U.S. CERTIFICATED MECHANIC	AIRFRAME CERT. # [REDACTED]
	<input type="checkbox"/> FOREIGN CERTIFICATED MECHANIC	
	<input type="checkbox"/> CERTIFICATED REPAIR STATION	
	<input type="checkbox"/> MANUFACTURER	

D. I certify that the repair and/or alteration made to the unit(s) identified in item 4 above and described on the reverse of attachments hereto have been made in accordance with the requirements of Part 43 of the U.S. Federal Aviation Regulations and that the information furnished herein is true and correct to the best of my knowledge.

DATE: 4-13-92 SIGNATURE OF AUTHORIZED INDIVIDUAL: [REDACTED]  
 PATRICK L. FLYNN

7. APPROVAL FOR RETURN TO SERVICE

Pursuant to the authority given persons specified below, the unit identified in Item 4 was inspected in the manner prescribed by the Administrator of the Federal Aviation Administration and is  APPROVED  REJECTED

BY	FAA FLT. STANDARDS INSPECTOR	MANUFACTURER	INSPECTION AUTHORIZATION	OTHER (SPECIFY)
	FAA DESIGNEE	REPAIR STATION	DEPARTMENT OF TRANSPORT INSPECTOR OF AIRCRAFT	135 AIR CARRIER #FVYA015T
DATE OF APPROVAL OR REJECTION	CERTIFICATE OR DESIGNATION NO	SIGNATURE OF AUTHORIZED INDIVIDUAL		
<u>4-13-92</u>	[REDACTED]	[REDACTED] PETER R. BARRY		

7  
FLYING

BOAT

INCORPORATED

PAGE: 55015

DATE: 6/15/90

REVISION: ORIGINAL


REPAIR REPORT PAGE 2 OF 3

REPAIR NUMBER 40292


DATE 4-13-92

WORK ORDER NUMBER \_\_\_\_\_

PERFORMED REPAIR TO RIGHT HAND WING REAR SPAR CAP ON AIRCRAFT N2969, S/N J-27. REPAIR WAS DONE IN ACCORDANCE WITH REPORT # 40292 AND A.T.E., INC. DRAWING NO. 40292. ALL WORK DONE AT STATION 34. SEE ATTACHED A.T.E., INC. DRAWING FOR A DETAILED REPAIR. NEGLIABLE CHANGE TO WEIGHT AND BALANCE.

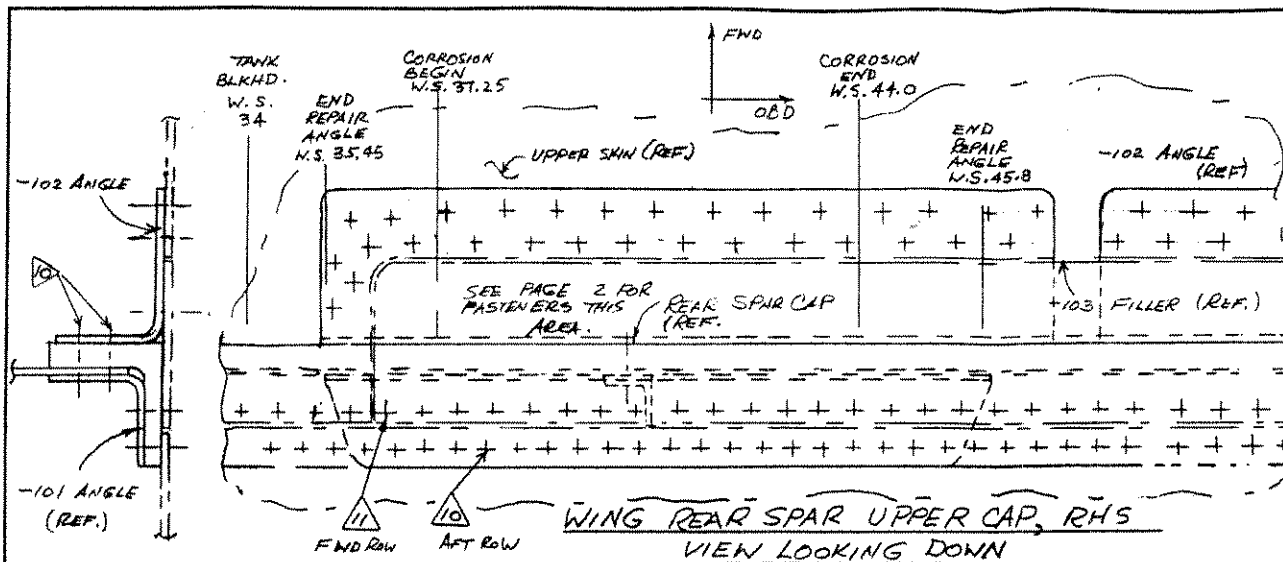

WING REAR SPAR UPPER CAP, R.H.S  
VIEW LOOKING DOWN

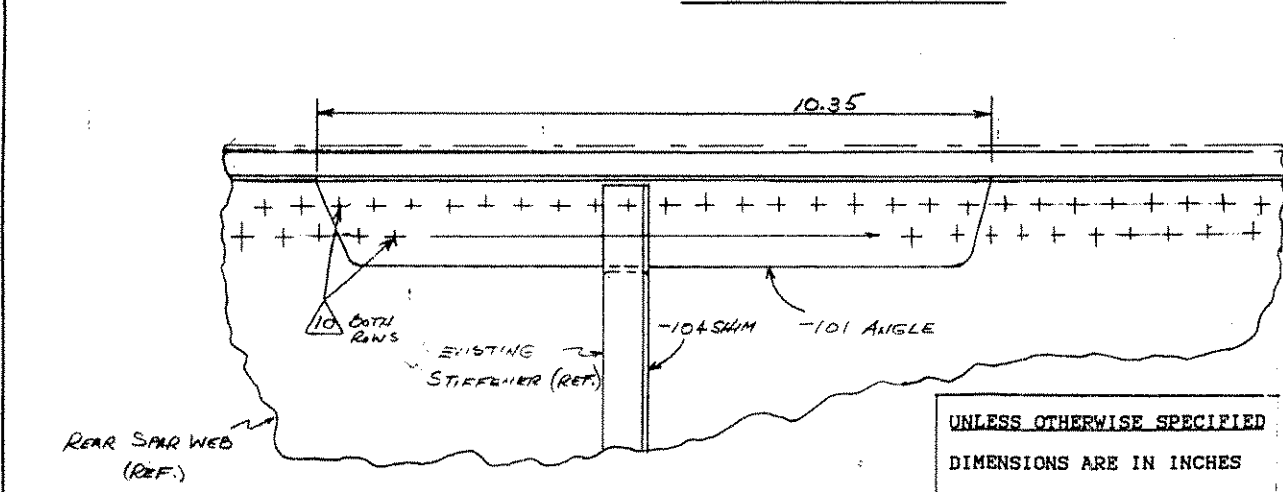

UNLESS OTHERWISE SPECIFIED  
DIMENSIONS ARE IN INCHES  
DIMENSIONAL TOLERANCES  
3 PLACE DECIMAL +/- .010  
2 PLACE DECIMAL +/- .03  
ANGULAR +/- 0° 30'


15. SEAL INSIDE TANK WITH TANK SEALANT.
14. SEAL REPAIRS WITH PROSEAL OR EQUIVALENT.
13. APPLY TWO COATS EPOXY PRIMER THROUGHOUT REPAIR AREA.
12. SHIM AS REQUIRED TO AVOID PRELOADING REPAIR MEMBERS.
11. HL19PB-5 IN EXISTING FASTENER LOCATIONS
10. HL18PB-5 IN EXISTING FASTENER LOCATIONS.
9. MIN. 9 HI-LOKS OUTSIDE CORROSION AREA, EACH END OF -101 ANGLE
8. FASTENER HOLES TO BE REAMED SMOOTH IN EXISTING AND REPAIR MEMBERS, NO NICKS OR SHARP EDGES.
7. PREPARE FASTENER HOLES IN ACCORDANCE WITH NAS618. MAXIMUM CLEARANCE .0015 ON DIA.
6. REMOVE ALL SHARP EDGES TO MIN. 0.2 RADIUS, SMOOTH.
5. MIN. EDGE DISTANCE OF REPAIR MEMBERS 2X FASTEN. DIA.
4. FORM -101 & -102 ANGLES FROM 7075-0 AND HEAT TREAT TO 7075-T6.
3. FILL CORROSION REMOVAL AREAS WITH HYSOL EA9309.3NA.
2. REMOVE ALL CORROSION IN AREA. INSPECT FOR CRACKS IN AREA USING DYE PENETRANT & BOLT HOLE EDDY CURRENT.
1. ALL DIMENSIONS SHOWN ARE APPROXIMATE. FINAL DIMENSIONS TO BE DETERMINED ON INSTALLATION.

NOTES:

1	-105	ANGLE	QQ-A-250/13	.071/7075-T6
1	-104	SHIM	QQ-A-250/13	.071/7075-T6
1	-103	FILLER	QQ-A-250/13	.071/7075-T6
1	-102	ANGLE	QQ-A-250/13	.071/7075-T6
1	-101	ANGLE	QQ-A-250/13	.071/7075-T6
QTY.	DASH NO.	DESCRIPTION	SPECIFICATION	MATERIAL

AEROSPACE TESTING AND ENGINEERING, INC.  
259 WOODLANDS ROAD PALM SPRINGS, FLORIDA 33461  
(407) 642-9297

DRAWING NUMBER: 40292 SHEET 1 OF 3  
DRAWING TITLE: GRUMMAN MALLARD J27  
R.H. WING REAR SPAR UPPER CAP CORROSION REPAIR  
SCALE: 20 APPROVED BY: DRAWN BY: JMB  
DATE: 4-2-92 REVISION:

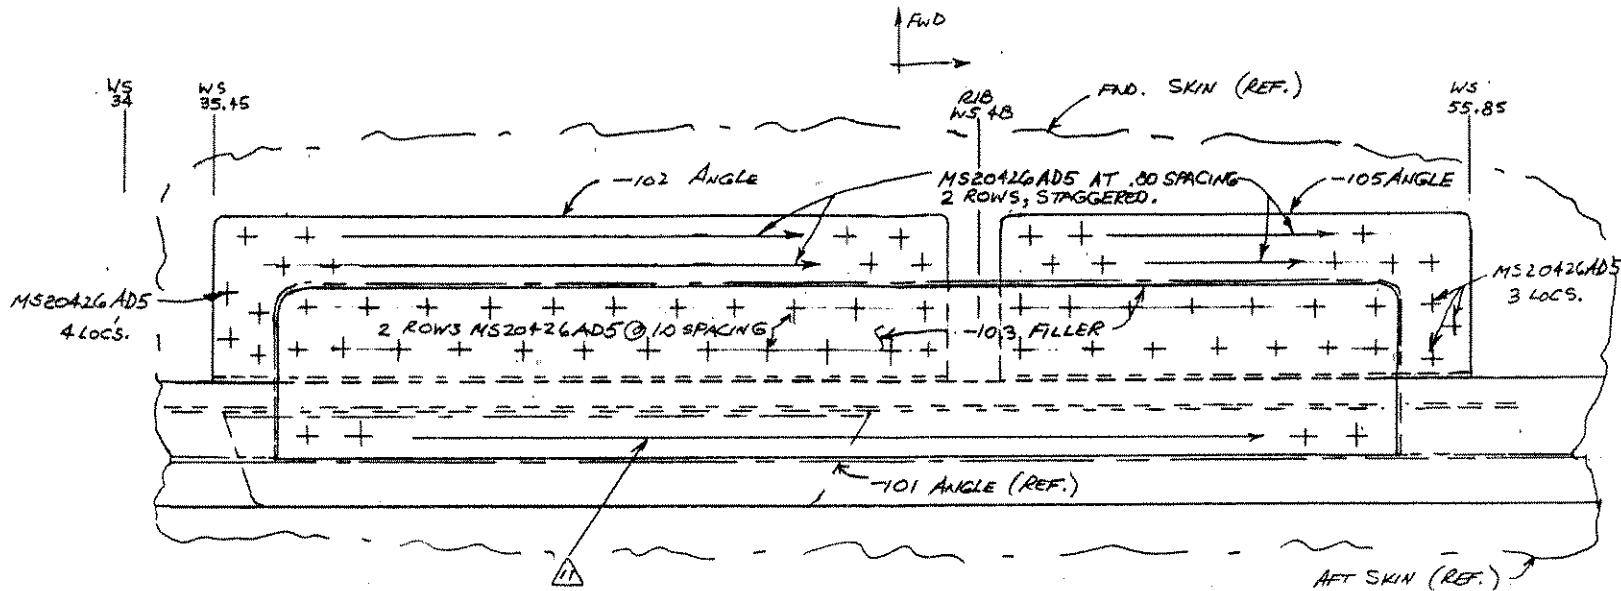


WING REAR SPAR UPPER CAP, R.H.S.  
VIEW LOOKING DOWN

UNLESS OTHERWISE SPECIFIED  
DIMENSIONS ARE IN INCHES  
DIMENSIONAL TOLERANCES  
3 PLACE DECIMAL +/- .010  
2 PLACE DECIMAL +/- .03  
ANGULAR +/- 0° 30'

QTY.	DASH NO.	DESCRIPTION	SPECIFICATION	MATERIAL
AEROSPACE TESTING AND ENGINEERING, INC. 259 WOODLANDS ROAD PALM SPRINGS, FLORIDA 33461 (407) 642-9297				
DRAWING NUMBER: 40292 <span style="float: right;">SHEET 2 OF 3</span>				
DRAWING TITLE: GRUMMAN MALLARD J27 R.H. WING REAR SPAR UPPER CAP CORROSION REPAIR				
SCALE: 20		APPROVED BY:		DRAWN BY:
DATE: 4-2-92		REVISION:		<i>Handwritten signature</i>




-101 ANGLE

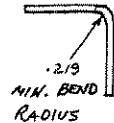


.219  
MIN. BEND  
RADIUS


REAR SPAR  
WEB (REF.)

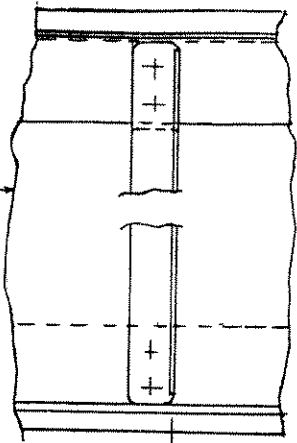


4.541

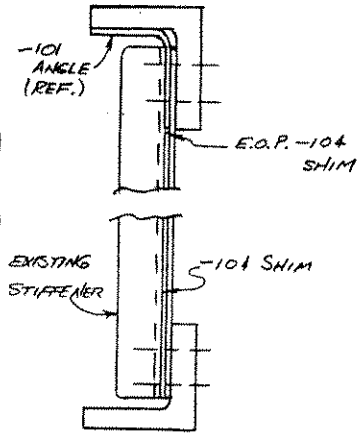


-104 SHIM INSTALL

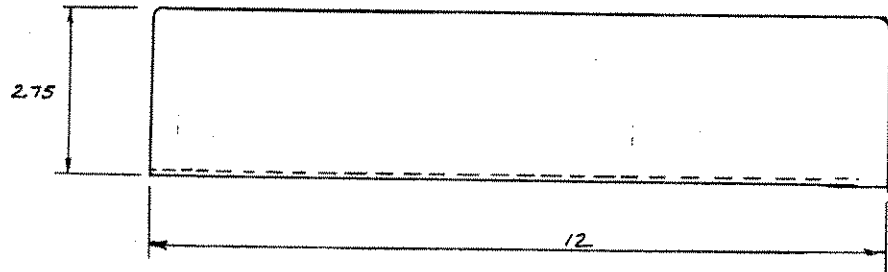

-102 ANGLE

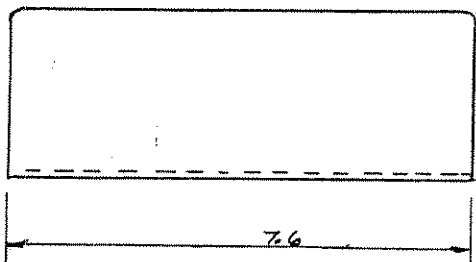

-105 ANGLE

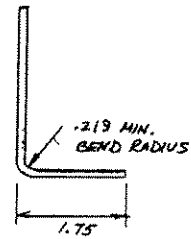

1.75

QTY.	DASH NO.	DESCRIPTION	SPECIFICATION	MATERIAL
<b>UNLESS OTHERWISE SPECIFIED</b> DIMENSIONS ARE IN INCHES <b>DIMENSIONAL TOLERANCES</b> 3 PLACE DECIMAL +/- .010 2 PLACE DECIMAL +/- .03 ANGULAR +/- 0° 30'				
<b>AEROSPACE TESTING AND ENGINEERING, INC.</b> 259 WOODLANDS ROAD PALM SPRINGS, FLORIDA 33461 (407) 642-9297				
DRAWING NUMBER: 40292			SH3 OF 3	
DRAWING TITLE: GRUMMAN MALLARD J27				
R.H. WING REAR SPAR UPPER CAP CORROSION REPAIR				
SCALE: 20		APPROVED BY:		DRAWN BY:
DATE: 4-1-92		REVISION:		<i>[Signature]</i>

Title: GRUMMAN MALLARD J27  
R.H. WING REAR SPAR UPPER CAP CORROSION REPAIR

Prepared by: ~~W. J. ...~~

Date: 4-1-92

Checked by:

P. 2 / 4

TO MINIMIZE FIRST FASTENER EFFECT :

SINCE CORROSION DAMAGE IS SPREAD OVER ABOUT 7.0 INCHES , WITH 4 ROWS AND 9 FASTENERS PER ROW EACH SIDE OF CORROSION CENTER, A STEPPED REPAIR ANGLE WILL NOT BE USED. SINCE THE CORROSION DEPTH IS SMALL, 2 REPAIR ANGLES WILL BE USED, EACH OF WHICH WILL DEVELOP MORE THAN THE CAPABILITY LOST BY CORROSION (REF. PAGE 1, THIS REPORT). EACH REPAIR ANGLE BEGINS AND ENDS AT A DIFFERENT FASTENER LINE.

INSTEAD OF CUTTING AWAY THE ENTIRE CAP SEGMENT CONTAINING CORROSION, THE CORROSION AREA IS ENTIRELY REMOVED AND POLISHED SMOOTH. THIS AREA OF THE CAP IS CHECKED FOR CRACKS. THE CAPABILITY LOST BY CORROSION IS THEN REPLACED 2 TIMES CAPABILITY LOST. THIS MINIMIZES THE LIKELIHOOD OF CRACKS DEVELOPING AT ANY "FIRST FASTENER", IN SERVICE, BECAUSE THE REPAIR ANGLES PICK UP LESS LOAD THAN IF THE REPAIR ANGLES WERE DESIGNED TO DEVELOP THE ENTIRE ORIGINAL CAP LOAD CAPABILITY.

THIS REPAIR WILL BE USED ONLY IF THE REPAIR AREA, INCLUDING FASTENER HOLES, IS INSPECTED AND NO CRACKS FOUND.



Title: GRUMMAN MALLARD J27  
R.H. WING REAR SPAR UPPER CAP CORROSION REPAIR


Prepared by: ~~████████~~

Date: 4-1-92

Checked by:

P. 1/4

REF.: 1. A.T.E. INC. DRAWING NO. 40292.  
2. SIKORSKY STRUCTURES MANUAL, GREEN.

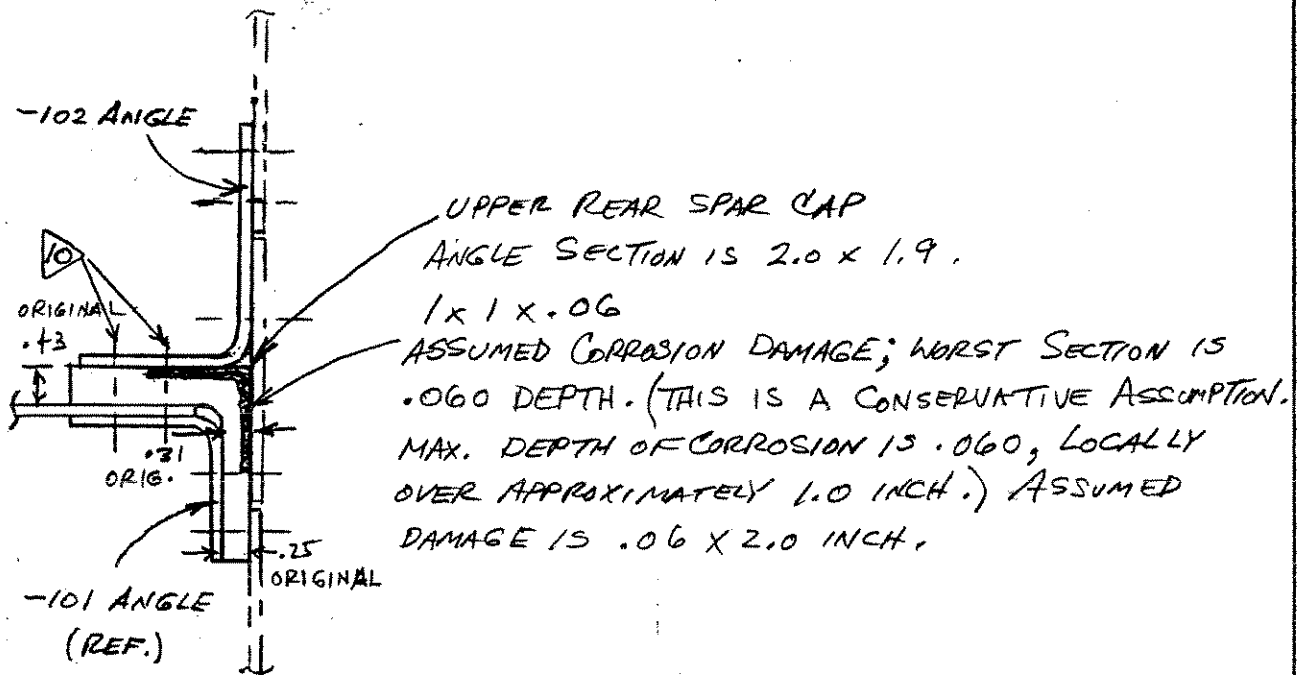

MATERIAL: T075-T6 EXT.  
 $F_{tu} = 81,000$   
 $F_{cy} = 72,000$   
"A" VALUES

CAPABILITY LOST BY CORROSION

$$P_L = (2.0)(.06)(72,000) = A F_{cy}$$

$$P_L = \underline{\underline{8640 \text{ LB.}}}$$

ORIGINAL CAP CAPABILITY

$$A_{cap} = 2.0 \left( \frac{.312 + .25}{2} \right) + 1.6(.43) = 1.25 \text{ in}^2$$

$$P_o = 1.25(72,000) = 90,000 \text{ LB. (COMP.)}$$

DEPARTMENT OF TRANSPORTATION  
FEDERAL AVIATION ADMINISTRATION

**STATEMENT OF COMPLIANCE WITH THE FEDERAL AVIATION REGULATIONS**

DATE  
April 13, 1992

AIRCRAFT OR AIRCRAFT COMPONENT IDENTIFICATION			
MAKE Grumman	MODEL NO. Mallard	TYPE (Airplane, Radio, Helicopter, etc.) Airplane	NAME OF APPLICANT Chalk's Airlines

IDENTIFICATION	LIST OF DATA TITLE
A.T.E. Inc. Dwg No. 40292	Grumman Mallard J27, R.H. Wing Rear Spar Upper Cap Corrosion Repair; Sh 1-3 Rev (-).
A.T.E. Inc. Structural Report No. 40292	Grumman Mallard J27, R.H. Wing Rear Spar Upper Cap Corrosion Repair.
<p>These data apply only to Grumman Mallard Serial No. J27</p>	

**PURPOSE OF DATA**  
To approve data for A/C Grumman Mallard Serial No. J27

**APPLICABLE REQUIREMENTS (List specific sections)**  
CAR 4a (Structural Aspects)

**CERTIFICATION** - Under authority vested by direction of the Administrator and in accordance with conditions and limitations of appointment under Part 183 of the Federal Aviation Regulations, data listed above and on attached sheets numbered \_\_\_\_\_ have been examined in accordance with established procedures and found to comply with applicable requirements of the Federal Aviation Regulations.

I (We) Therefore  Recommend approval of these data  
 Approve these data

SIGNATURE(S) OF DESIGNATED ENGINEERING REPRESENTATIVE(S)	DESIGNATION NUMBER(S)	CLASSIFICATION(S)
H. Roberts	S0-724	Structural