



REVISIONS			
REV	DESCRIPTION	DATE	APPROVED
A	REVISED TO REFLECT AS BUILT AS PER MARCH 26, 1990	3/26/90	
B	REVISED AS PER OWNERS REQUEST	4/23/90	

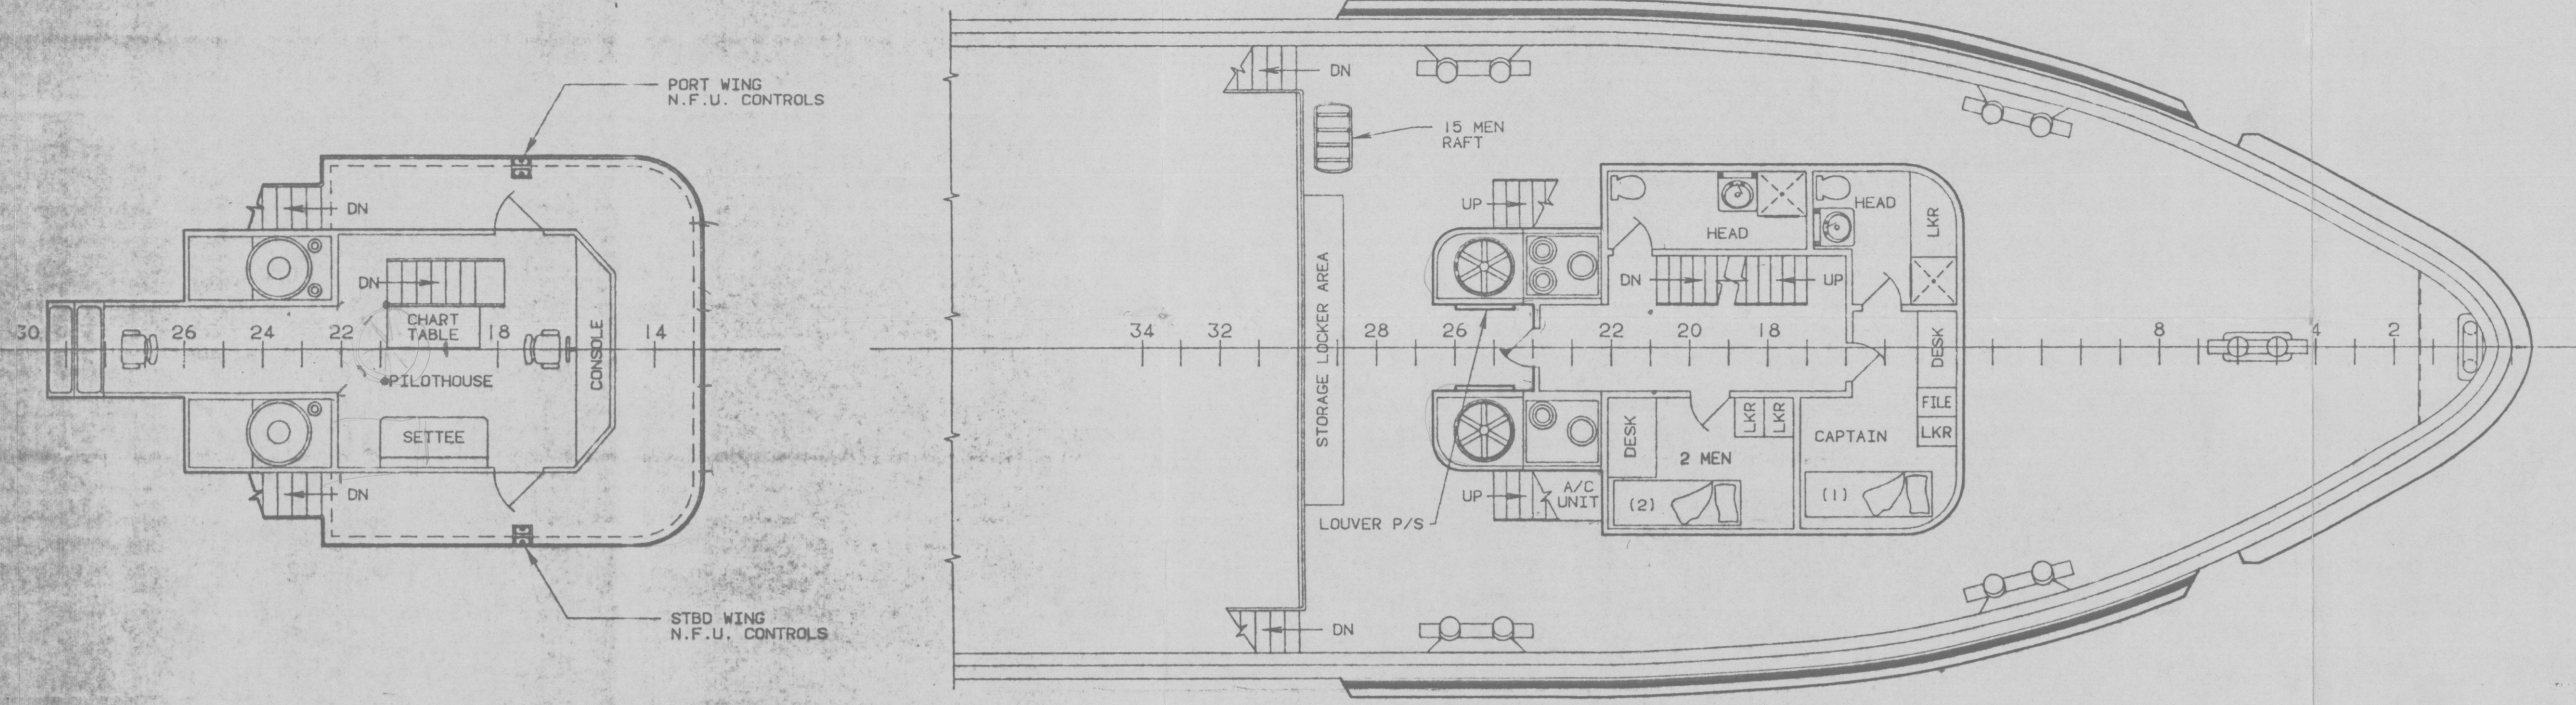

PILOTHOUSE

FOSCLE DECK

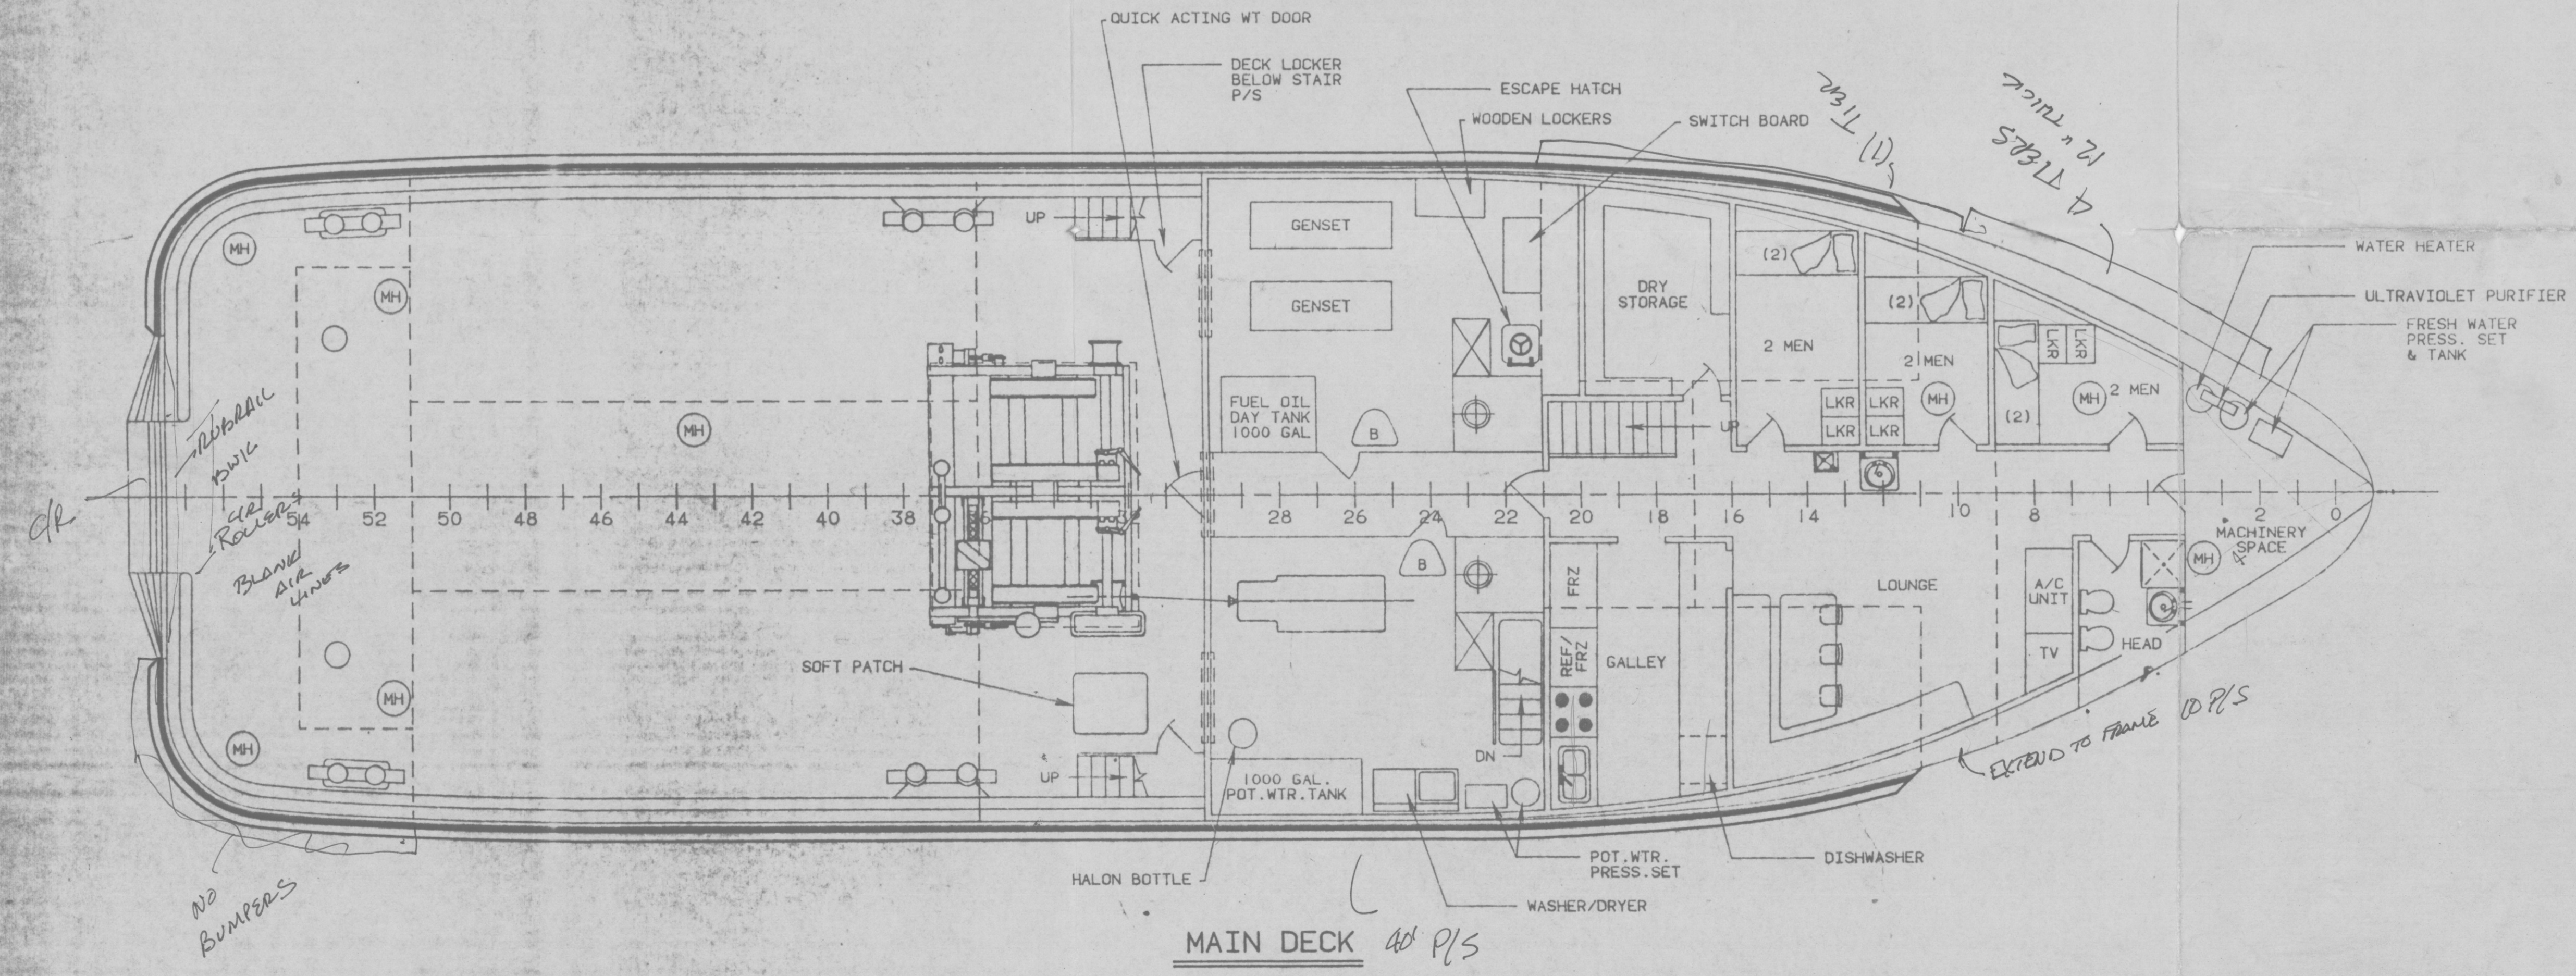

MAIN DECK w/ P/S

THIS DRAWING CONTAINS PROPRIETARY AND CONFIDENTIAL INFORMATION OF BOLLINGER MACHINE SHOP & SHIPYARD, INC., AND IS LOANED IN CONFIDENCE WITH THE UNDERSTANDING THAT IT WILL NOT BE REPRODUCED NOR USED IN ANY MANNER WHATSOEVER DETRIMENTAL TO THE BEST INTEREST OF BOLLINGER MACHINE SHOP & SHIPYARD, INC., AND THAT IT SHALL BE RETURNED ON DEMAND.

**BOLLINGER MACHINE SHOP & SHIPYARD**  
P.O. BOX 250, LOCKPORT, LA, 70374  
PHONE: (504) 532-0504 TELEX: 98-4127

**117' X 34' X 17' FOSCLE TUG**

**GENERAL ARRANGEMENT**

DRAWN BY: WAYNE H. DATE: 01/31/90  
CHKD. BY: DATE: \_\_\_\_\_  
APPD. BY: DATE: \_\_\_\_\_ SCALE: 3/16\"/>

CRITICAL  
OWG 01

2