



GENERAL NOTES:
 1. PEOPLE TOWBOAT SALVAGE IS THE OWNER OF THIS DRAWING.

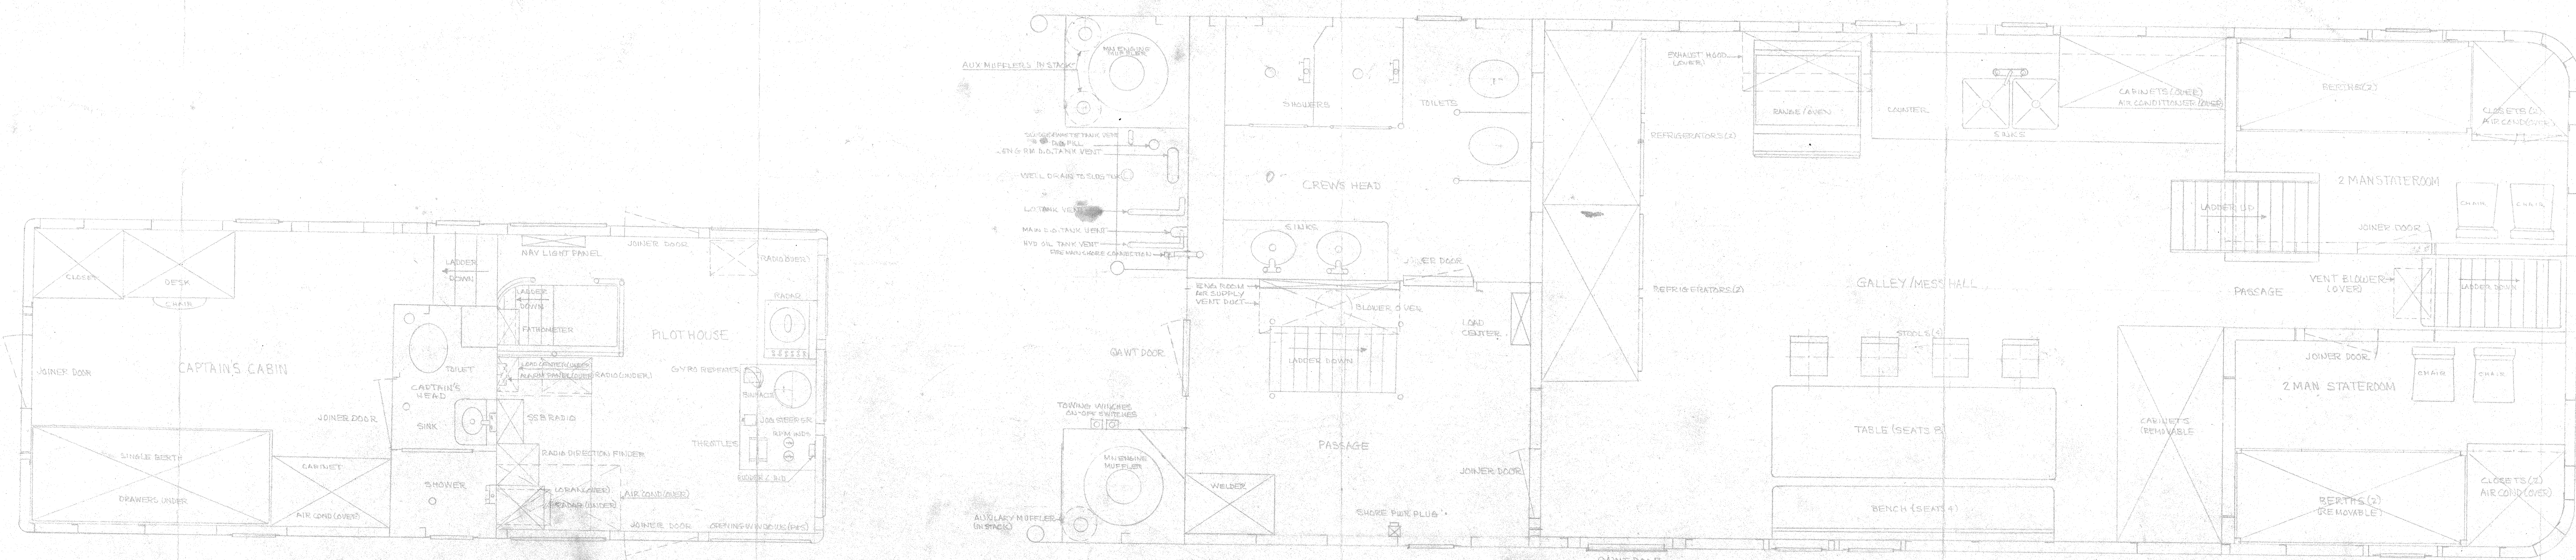

GENERAL ARRANGEMENTS MAIN DECK HOUSE

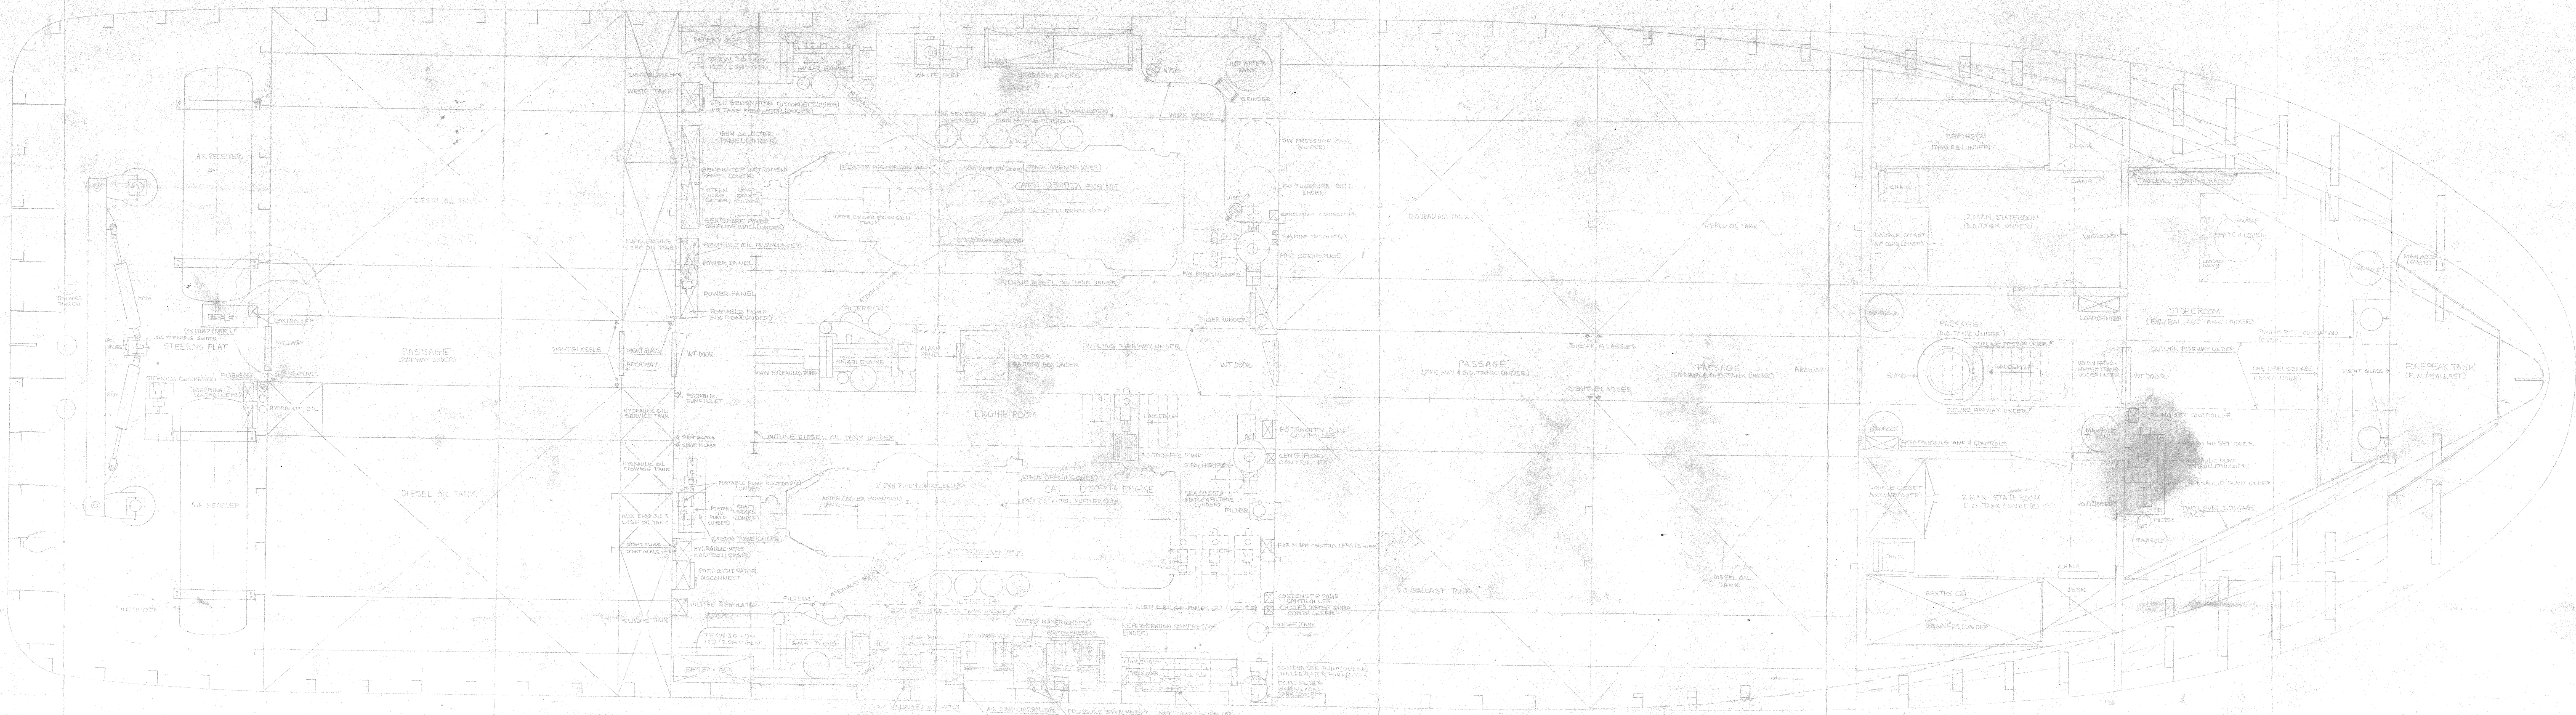

GENERAL ARRANGEMENT FLAT LEVEL

A CORRECTED TO REFLECT AS BUILT STRUCTURE AND ASSET ADDITIONAL DETAILS
 Revision Description

THOMAS B. WILSON
 NAVAL ARCHITECT & MARINE ENGINEER
 4821 VIA COLONIA, RANCHO PALM GARDENS, CA 90274 TELEPHONE (310) 463-4445
 FAX (310) 463-4446

PACIFIC MAPNER
 GENERAL ARRANGEMENTS

NOTICE THIS DRAWING IS TO BE USED ONLY FOR THE PURPOSES WHICH IT IS EXPRESSLY AUTHORIZED BY THOMAS B. WILSON. NAVAL ARCHITECT AND MARINE ENGINEER AND IS NOT TO BE USED FOR ANY OTHER PURPOSE WITHOUT HIS WRITTEN AUTHORITY.	SCALE AS SHOWN	DATE 12/11/01
DRAWN BY T.B.W.	APPROVED BY T.B.W.	DATE 12/11/01
DRAWING NUMBER 101	REVISION NUMBER 1	REV 1