



Laurence and Associates, LLC
918 Government Street
Mobile, AL 36604

February 7th, 2024

SOUTH CAROLINA PORTS AUTHORITY
200 Ports Authority Dr
Mt Pleasant, SC 29464

Attention: Eric J. Scanlon
Mechanical Technical Specialist, Crane and Equipment Maintenance

Subject: SCPA ZPMC Crane H-39-037 (#37) Vessel Impact Damage Assessment
LA, LLC Project Number 2405

Mr. Scanlon,

We have inspected the damage due to vessel impact with the boom of ZPMC Crane #37 at the North Charleston Terminal (NCT) in North Charleston, SC. The initial inspection was carried out between January 5th and January 8th, 2024 immediately after the vessel impact event. Additional inspection work was carried out on January 11th, 2024 and on February 5th, 2024. The inspection included a visual inspection of the point of impact, some of the critical structural joints, obvious points of distress, and key components where alignment is critical (boom hinge, boom-girder trolley rail, and main equalizer beams). The inspection work was completed around activities to stabilize the crane.

The visible damage noted included a nearly complete wrecking of the gantry assemblies at each corner (compromising the cranes stability), minor damage to the checkers cabin, damage to the platforms and appurtenances at the boom tip (point of impact), dislodging of the crane from the pier's gantry rail system, and surface damage to the pier structure.

A visual survey of the boom hinge areas and the trolley rail along the length of the boom and girder indicates that the boom alignment is acceptable. Additionally, the boom has been raised and the trolley driven from about the middle of the boom to the extreme backreach position without issue, both providing further evidence that the boom alignment is acceptable.

The following reports on the emergency stabilization steps taken, recommendations for permanent stabilization and storage efforts, the recommendations for repair, and other work to be considered.

Emergency Stabilization:

The gantry assemblies provide the vertical and lateral support for the crane structure. The event caused significant damage to the gantry assembly such that their ability to support the crane dead weight or the lateral forces (from wind and operating inertia forces) has been compromised.

The pier structure is composed of pile supported reinforced concrete crane rail beams and interior reinforced concrete deck slabs. The crane rail beams are designed to support the operating load cases (wheel loads) of the crane (such as dead loads, lifted loads, wind loads, inertia loads, etc). The deck slabs are designed to carry the lighter loads imposed by terminal traffic (such as cargo laden trucks). During the event the crane was dislodged off of the crane rail beams and onto the deck slabs in several locations. Therefore, immediately after the event certain

components of the pier structure were loaded in a manner that would not have been considered in their design.

The weather forecast immediately after the event called for poor conditions including rain and high wind. There was no confidence that the wrecked state of the gantry system would be adequate to support the dead load of the crane with additional lateral loads due to wind. The crane was in danger of collapse and that emergency stabilization efforts were required to eliminate the potential for additional damage to the crane, loss of the crane entirely, or additional damage to the pier structure.

Immediate steps were taken to enhance the stability of the crane structure as follows:

1. Wide flange columns/braces were welded to the sill beam at all four corners of the crane. The columns/braces were angled down from the sill beam to the top of the pier's concrete deck. In some cases, the bottom of the columns/braces were secured with water laden containers.
2. At least four of the eight main equalizer beam connections to the intermediate beams were in a visible state of failure. At these locations, the bolts securing the connections failed allowing the components to separate. Plate materials were field cut and welded between the separated components in an effort to preserve the post event condition of the connection.
3. In a clear weather window, the crane was further stabilized by removal of the compromised gantry assembly components below the main equalizer beam and placing the remaining crane structure on cribbing as follows:
 - a. Utilizing ZPMC NA's crane transporter beam (Big Bird) and Berard's Self Propelled Modular Transporters (SPMT's), the crane structure was lifted and relocated to the north end of the pier. During the relocation work the damaged 8x intermediate gantry assemblies (below the main equalizer), the 2x stowage pin brackets, the 4x tie down devices, portions of 2x landside stairways, and the checkers cabin were removed and placed in the yard.
 - b. The crane was placed on crib stacks of various materials provided by ZPMC NA and Berard in a strategic location of the pier which was suitable to support the crane dead weight with limited points of support.
 - c. Utilizing ZPMC NA's cribbing materials and their climbing jacks the crane was further and systematically lowered in elevation by about 4.5 ft until it rested firmly on 8x high capacity stands provided by ZPMC NA and Berard.

Recommendations for Permanent Stabilization and Storage:

Although the emergency stabilization effort was completed, we are recommending additional stabilization efforts to secure and store the crane for a period of 6 months or more while replacement parts are procured and final repairs can be implemented.

1. As we expect that the procurement and installation of the needed replacement parts will take over 180 days, the current and governing building code stipulates that the means to secure the crane must be suitable for full hurricane winds. Therefore, we recommend that the crane, pier and support stands are analyzed for stowed load combinations including hurricane winds. If required by analysis, additional stands and tie down devices should be

-
- added. This analysis is currently in the works and we have confirmed that at a minimum tie downs must be installed between the crane structure and the pier to prevent toppling in hurricane winds. We are still working toward verification of the pier and stands.
2. The gantry level crane-to-crane collision absorption system (bumpers) were removed with the damaged gantry assemblies leaving the crane vulnerable to gantry collisions. We recommend that temporary gantry end stops be fabricated and secured to the concrete gantry rail beams between Crane #37 and the adjacent operating crane. The intent of these end stops would be to prevent the adjacent ship to shore crane from inadvertently colliding with the subject crane.

Recommendations for Repair:

The following outlines our recommendations for repair and returning the crane to service.

1. In order to eliminate doubt, replace all main equalizer beam to sill beam connection bolts. All of the collision forces flowed through these connections/bolts. The connection/bolts in question are not designed for such a load case.
2. During our inspection work on February 5th, we noted that although the distance between the main equalizer pins at corners 1/4 and corners 2/3 measured within 1/4" of each other, the straight-line measurements between the ends of the main equalizer beams at corners 1/4 and corners 2/3 varied by as much as 2 11/16" from the least to the greatest. This is an indication that some or all of the main equalizer beams may have rotated at their connection to the sill beam and/or that there could be damage to the main equalizer beam that has permanently changed their shape. We recommend that a licensed land surveyor be engaged to complete a thorough survey of the main equalizer beams relative to the sill beams. The survey information should then be evaluated to see if additional repairs are required at the main equalizer beams. While the surveyor is on site, it might be convenient to complete a survey of points of the boom relative to the sill beams for final verification that the boom-girder are correctly aligned.
3. Although a brief visual inspection of the crane has been completed, it focused on the point of impact, alignment of the boom-girder, and the gantry assemblies. We recommend that a more thorough point to point visual structural inspection is completed on the remaining crane structure.
4. All damaged platforms at the boom tip should be repaired. In addition to the platforms the walkway lighting system and lighting grounding system will need to be repaired. In order to complete this work, the crane will need to be boomed down and the trolley used to transmit materials to the boom tip. The current support system for the crane as well as the pier structure will need to be checked for this load combination. Booming down and moving the trolley toward the water will result in increased loads on the waterside supports (stands) and the pier.
5. We recommend that all of the components below the main equalizer beam be replaced with the exception of a few items which can easily be relocated. We make this recommendation for the following reasons:
 - a. The loads imposed during the event are not considered in the international design codes that would have been followed in the design of the crane. Therefore, we believe that through an analysis of the gantry componentry it would be determined that some to many of the components have been overloaded. Although

-
- the components are robust, overload conditions may result in a reduced expected useful life.
- b. The gantry assemblies are manufactured using designs, tolerances, and processes suitable for high grade machinery. This is required for the long term performance of the crane. The precession that was involved in the manufacture of the crane may have been offset by the slightest damage to an individual part.
 - i. It is possible that this damage would become evident through testing, but it may not become evident for years resulting in deteriorated crane performance and additional repair cost to SCPA at a later date.
 - ii. In the case that the damage becomes evident in testing, the process of repairing and returning the crane to service will be further delayed to the burden of SCPA.
 - c. There is obvious physical damage to many components of the assemblies. However, most of the componentry is not visible and must be disassembled entirely to physically inspect and test in order to rule out any damage.
 - i. This work would need to be completed by personnel skilled in the manufacture, maintenance and repair of high grade machinery. It would be time consuming and expensive.
 - ii. We would expect that some or many of the components that did survive the event and might be reuseable in the future may be damaged in the work of salvaging from the other wrecked components.
 - d. We understand that the original crane manufacture (ZPMC) has been engaged to provide the replacement components. They have the expertise to manufacture, assemble, outfit, and ship in significant sub-assemblies at very reasonable cost compared to what could be obtained in the US. Although we have not analyzed the potential cost differences, we would expect that receiving the sub-assemblies from ZPMC for installation by a US contractor would be more cost-effective than salvaging undamaged parts from the damaged assemblies, integrating them with the new components supplied by ZPMC and then installing them on the crane.
 - e. The method of jacking the crane for the installation of the new components may be different than that used for removal. The method for jacking and installation should be planned/engineered prior to arrival of the new components in case additional jacking equipment is required to complete the work.
 - f. After all repairs are completed above, the crane should be re-commissioned, tested (including overload testing), and recertified by OSHA.
 - g. After the testing, the crane will need to be relocated to its proper position on the pier with the ZPMC NA crane transport system (Big Bird) and SPMT's.
 - h. The temporary crane rail beam end stops will need to be removed.
 - i. Once all of the above are completed the crane can be returned to service.

Other Work to Consider:

1. We recommend that the underside of the pier in the area of the event is inspected.

If you have any questions concerning this letter, please feel free to call or email.

Sincerely,

[Redacted signature]

William H. Laurence, PE




Mobile: [Redacted]

E-Mail: [Redacted]

Attachments:

ZPMC gantry drawings with requested new parts indicated.

ZPMC crane general arrangement drawing.

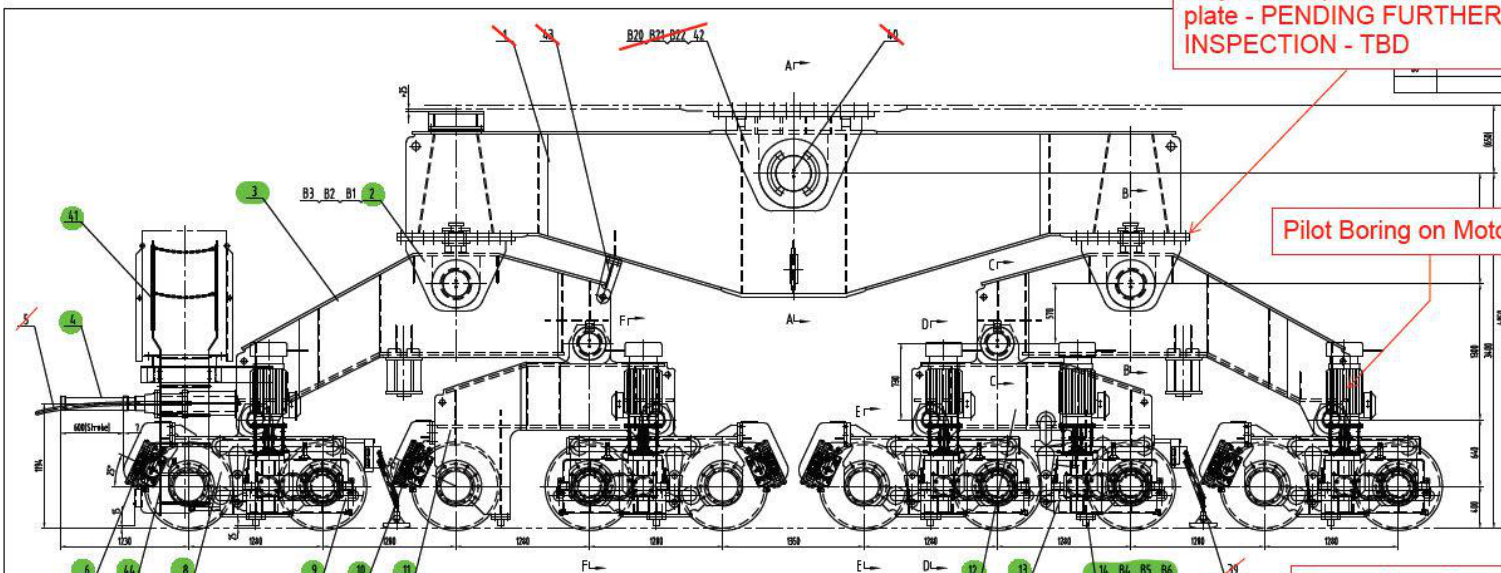


May need top connection plate - PENDING FURTHER INSPECTION - TBD

Pilot Boring on Motor Side

See note on drawing J227A0402

description	date	slip
type, packing beam/lighting conductor ass.	2006.7.29	gushenghan
	2006.8.24	gushenghan
	2006.9.9	gushenghan
As-built drawing	June, 2007	

MAIN DATA 主要参数	
CAPACITY 额定起重	60t/15t
SAFETY HAZEL QUANTITY 安全系数	Φ800mm
MOTOR	TYPE: YSBP 160 L B4 IP55 POWER: 24 KW SPEED: 1750r/min
电机编码器 (Pintsch Bomag)	TYPE: KFB-40/33 RESOLUTION: 3300#
COUPLING 联轴器 (SBR6)	TYPE: ZN-V15B TORQUE: 8500#
REDUCER 减速机 (ZPMK)	TYPE: TMF55.73.D18-00 RATIO: 72.717
WHEEL BRAKE 制动器 (SBR6)	TYPE: R81 104 BRAKING CAPACITY: 74.20KN
BUFFER 缓冲器 (KLECI)	TYPE: 70MPK100-417 STROKE: 600mm DYNAMIC CAPACITY: 336KJ MAX IMPACT FORCE: 7000N
OPERATING WHEEL LOAD 工作轮载荷	-61t
MAXIMUM WHEEL LOAD 最大轮载荷	-80t
WHL TYPE 轮型	135 LBS 13T



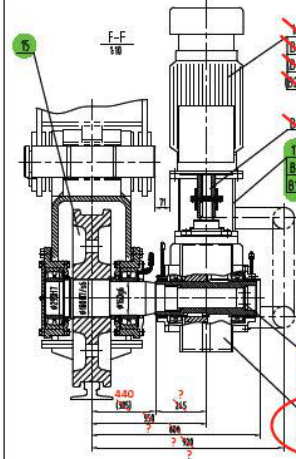


Change to new TNR500.B2.D2A00

To be checked

1. 检查所有标注的尺寸, 确保所有尺寸符合设计要求和标准。
2. 检查所有标注的尺寸, 确保所有尺寸符合设计要求和标准。
3. 检查所有标注的尺寸, 确保所有尺寸符合设计要求和标准。
4. 检查所有标注的尺寸, 确保所有尺寸符合设计要求和标准。
5. 检查所有标注的尺寸, 确保所有尺寸符合设计要求和标准。
6. 检查所有标注的尺寸, 确保所有尺寸符合设计要求和标准。
7. 检查所有标注的尺寸, 确保所有尺寸符合设计要求和标准。
8. 检查所有标注的尺寸, 确保所有尺寸符合设计要求和标准。

1. Four sets of leveling nuts/shims drawing in detail and specify material on the crane.
2. Verify the accuracy of the wheel base center height to center rail track and centerline of the rail should be not exceed 1mm.
3. Verify accuracy of leveling and leveling pin joints in order that will appropriate clearance when wheel running to avoid the wear.
4. When fitted on rails, the angle can be 1 to 2 mm class 1/2" total clearance from bottom, and from top less than 1mm.
5. Short and pin space should be installed after you start placed installation.
6. Lubricating grease should be correct amount application of accurate quantity will assemble on the upper rail and the motor shaft. The original position of grease should be just under the center of shaft hub, the grease is valid after the action reach the end and the leveling requirement is immediately the wheel run in accordance to be added to the next height by them.
7. The adjusting bolts are marked within before the wheel tracking in order to prevent the bumping bolts should be tight after the action run on the top.
8. The lighting power of light-roughly hole (MINIMUM) is 100W and (MAXIMUM) is 150W.

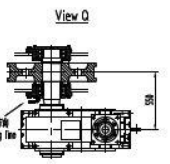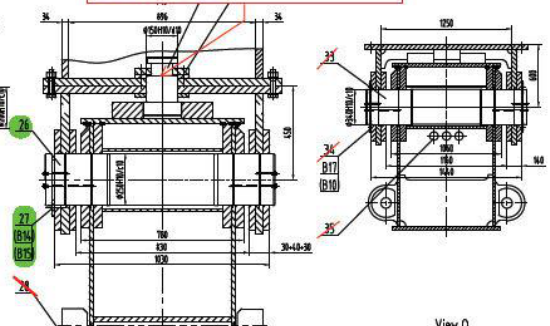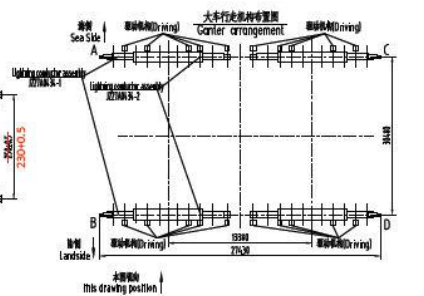

PROJECT: South Carolina GOLI (various Cranes, USA)	DESIGN STAGE:	SCALE: 1:20
ITEM NAME: GANTRY 大车行走机构	DRAW NO: J227A04.00	PROJ:
ZPMC	DESIGN: []	APP: []
	DRWN: []	ASS: []
	CHK: []	SEI/CRME: []
	VER: []	WEIGHT: 4x375#

*Note - ZPMC Engineering to verify dimensions, component updates, and comments in this drawing.

Revised
01/19/2024 11:42:06 AM

SUBSIDIARY LIST

* The quantity and weight of this list is to one set
 4 set/crane, 37500 kg/set, 150000 kg/crane

PAGE: 1/4

PROJECT NAME or CODE: South Carolina 65LT Container Cranes,USA		SUB-PART NAME: Gantry 大车行走机构		SUB DRAW NO: J227A0400		
NO.	SUB-NO. or STDD	NAME & SIZE	MTRL or STYLE	QTY/SET	PIECE WGT	TOTAL WGT
1	1 J227A0401	Upper beam 大平衡梁	Welded 焊接件	1		8850
2	2 J227A0402 ✓	Support 连接支架	Welded 焊接件	2	690	1380
3	3 J227A0403 ✓	Middle beam 中平衡梁	Welded 焊接件	2	2500	5000
4	4 J227A0404 ✓	Buffer device 缓冲器装配	Assembly 组件	1		237
5	5 J227A0405	Buffer safety device 缓冲器安全装置	Assembly 组件	1		20
6	6 J227A0406b ✓	Wheel brake Ass.1 轮边制动器装配1	Assembly 组件	4	275	1100
7	7					
8	8 J227A0407 ✓	Bogie 台车	Welded 焊接件	4	670	2680
9	J227A0408-1 J227A0408-2	Enclosure 1 护栏1	Assembly 组件	4	85	340
10	10 J227A0409b ✓	Wheel brake Ass.2 轮边制动器装配2	Assembly 组件	1		275
11	11 J227A0410 ✓	Lower beam 1 小平衡梁1	Welded 焊接件	1		1210
12	12 J227A0411 ✓	Lower beam 2 小平衡梁2	Welded 焊接件	1		1280
13	13 J227A0412 ✓	Enclosure 2 护栏2	Assembly 组件	1		91
14	14 GTC01 ✓	Anti-break block 断轴保护块	Welded 焊接件	6	22.2	133.2
15	15 J227A0413 ✓	Driving shaft assembly 主动车轴轴装配	Assembly 组件	5	735	3675
16	16 J227A0414	cover 电动机罩壳	Assembly 组件	5	5	25
17	17 J227A0415 ✓	Flange 联接法兰	Welded 焊接件	5	35	175
18	18 J227A0416	plate 压板	Q235	5	1	5
19	19 J227A0417	Washer 垫片	Q235	5	0.03	0.15
20	20 J227A0418 ✓	Driven shaft assembly 从动车轴轴装配	Assembly 组件	5	700	3500
21	21 J227A0419 ✓	Shaft 轴φ150	35CrMo	4	85	340
22	22 J227A0420 ✓	Shaft end plate 卡轴板	Q235	4	1.1	2.2
ZPMC		DSGN	TECH	MTRL		
		CHCK	STDD	CHCK		

*Note - ZPMC Engineering to verify for accuracy

SUBSIDIARY LIST

* The quantity and weight of this list is to one set
 4 set/crane, 37500 kg/set, 150000 kg/crane

PAGE: 2/4

PROJECT NAME or CODE: South Carolina 65LT Container Cranes,USA		SUB-PART NAME: Gantry 大车行走机构		SUB DRAW NO: J227A0400		
NO.	SUB-NO. or STDD	NAME & SIZE	MTRL or STYLE	QTY/SET	PIECE WGT	TOTAL WGT
1	23 J227A0421 ✓	Shaft 轴φ200	35CrMo	2	200	400
2	24 J227A0422 ✓	Shaft end plate 卡轴板	Q235	2	1.6	3.2
3	25					
4	26 J227A0424 ✓	Shaft 轴φ250	35CrMo	2	415	830
5	27 J227A0425 ✓	Shaft end plate 卡轴板	Q235	2	2.3	4.6
6	28 J227A0426	Jacking pedestal 顶升梁	Welded 焊接件	1/2 台 1/2 cranes	280	
7	29 GTA01a(36)	Pin shaft 销轴	45	2	42	84
8	30 GTA02	Shaft end plate 卡轴板	Q235	4	3.8	15.2
9	31					
10	32					
11	33 J227A0428	Shaft 轴φ340	35CrMo	1		1126
12	34 J227A0429	Shaft end plate 卡轴板	Q235	4	6.6	26.4
13	35 J227A0430	Gannulation drawing 电气布管图	Assembly 组件	1		
14	36 J227A0431 ✓	Pin shaft 销轴	45	10	1.1	11
15	37 J227A0432 ✓	Link plate 连板	Welded 焊接件	10	4.1	41
16	38 J227A0433 ✓	Sleeve 轴套	Q235	10	0.2	2
17	J227A0434-1 J227A0434-2	接地线装配 Lightning conductor assembly	Assembly 组件	2 2		
18	40 J227A0435	Lubrication device 润滑装置	Assembly 组件	1		25
19	41 J227A0436 ✓	Pump support 泵站支架	Welded 焊接件	1		240
20	42 J227A0437	Support 连接支架	Welded 焊接件	1		2050
21	43 J227A0438	Support 支架	Welded 焊接件	1/2 台 1/2 cranes		83.6
22	44 J227A0439 ✓	Wheel cover 车轮罩壳	Assembly 组件	1		22
ZPMC		DSGN	TECH	MTRL		
		CHCK	STDD	CHCK		

Revised

01/19/2024 11:42:18 AM

SUBSIDIARY LIST

* The quantity and weight of this list is to one set
 4 set/crane, 37500 kg/set, 150000 kg/crane

PAGE: 3/4

PROJECT NAME or CODE: South Carolina 65LT Container Cranes,USA		SUB-PART NAME: Gantry 大车行走机构		SUB DRAW NO: J227A0400		
NO.	SUB-NO. or STDD	NAME & SIZE	MTRL or STYLE	QTY/SET	PIECE WGT	TOTAL WGT
1	B1	GB/T1228-91 ✓ Bolt 螺栓M24x120	10.9S Dacro 达克罗	58		
2	B2	GB/T1229-91 ✓ Nut 螺母M24	10H Dacro 达克罗	58		
3	B3	GB/T1230-91 ✓ Washer 垫圈24	Dacro 达克罗	116		
4	B4	GB5782-86 ✓ Bolt 螺栓M16x75	8.8S Dacro 达克罗	44	ZPMC to verify correct qty	
5	B5	GB889-86 ✓ Nut 螺母M16	8S Dacro 达克罗	24		
6	B6	GB95-85 ✓ Washer 垫圈16	Dacro 达克罗	24		
7	B7	M3BP-180LB4 (IP55) Motor 电动机	ABB	5	185	925
8	B8	ZIN-V1.5B Coupling 联轴器	SIBRE	5		
9	B9	GB5783-86 ✓ Bolt 螺栓M24x50	8.8S Dacro 达克罗	20	ZPMC to verify correct qty	
10	B10	GB855-88 ✓ Washer 垫圈24	Dacro 达克罗	36	ZPMC to verify correct qty	
11	B11	GB5783-86 ✓ Bolt 螺栓M16x40	8.8S Dacro 达克罗	10		
12	B12	TNH515.73.D1B-00 Reducer 减速机	ZPMC	5	620	3100
13	B13	✓ Nipple 油嘴NPT1/4"	Sta.Ste. 不锈钢	46		
14	B14	GB5783-86 ✓ Bolt 螺栓M20x40	8.8S Dacro 达克罗	16		
15	B15	GB855-88 ✓ Washer 垫圈20	Dacro 达克罗	16		
16	B16	GB5782-86 ✓ Bolt 螺栓M24x80	8.8S Dacro 达克罗	8		
17	B17	GB5783-86 ✓ Bolt 螺栓M24x45	8.8S Dacro 达克罗	8		
18	B18	GB95-85 ✓ Washer 垫圈30	Dacro 达克罗	10		
19	B19	GB91-86 ✓ Pin 开口销6.3x50	Sta.Ste. 不锈钢	10		
20	B20	GB/T1228-91 Bolt 螺栓M30x155	10.9S Dacro 达克罗	24		
21	B21	GB/T1229-91 Nut 螺母M30	10H Dacro 达克罗	24		
22	B22	GB/T1230-91 Washer 垫圈30	Dacro 达克罗	48		
ZPMC		DSGN	TECH	MTRL		
CHK		STDD	CHK			

Change to new - TNR500.82.D2A00 ✓

*Note - ZPMC Engineering to verify for accuracy

SUBSIDIARY LIST

* The quantity and weight of this list is to one set
 4 set/crane, 37500 kg/set, 150000 kg/crane

PAGE: 4/4



PROJECT NAME or CODE: South Carolina 65LT Container Cranes,USA		SUB-PART NAME: Gantry 大车行走机构		SUB DRAW NO: J227A0400		
NO.	SUB-NO. or STDD	NAME & SIZE	MTRL or STYLE	QTY/SET	PIECE WGT	TOTAL WGT
1	B23	SPL-CO-2000 ✓ Nut 螺母 M16	8S Dacro 达克罗	20		
2						
3						
ZPMC		DSGN	TECH	MTRL		
CHK		STDD	CHK			

SCPA to purchase these bolts in US


Revised

01/19/2024 11:42:18 AM

**DO NOT DRILL
BOLT HOLES - TBD**

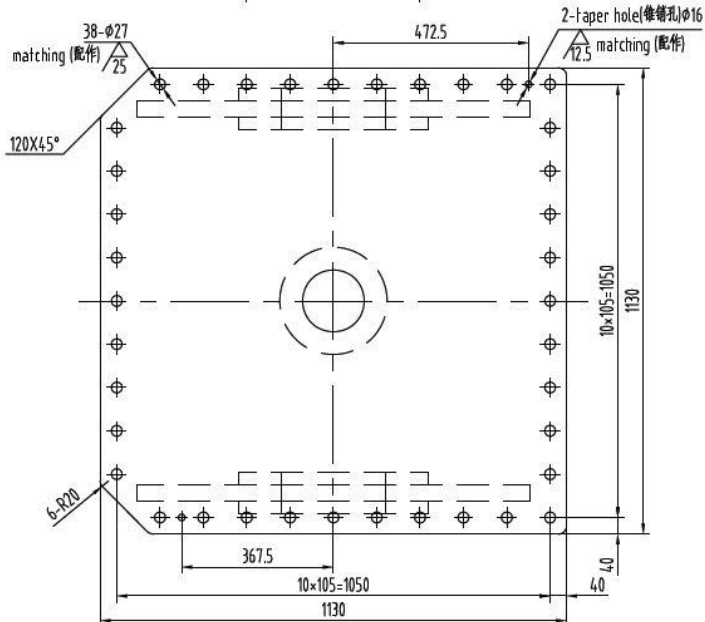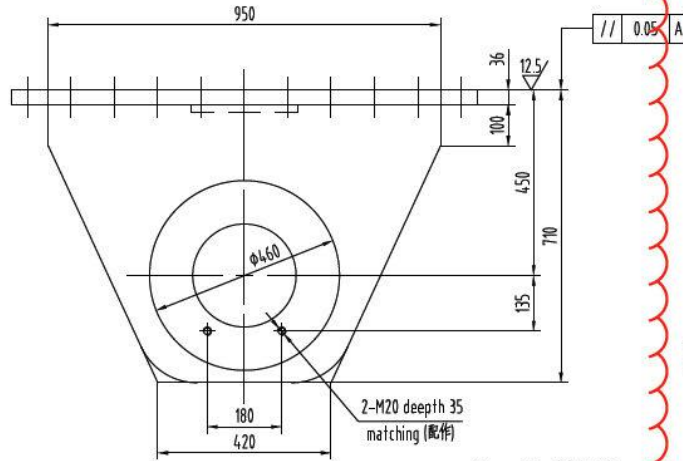

Rev. No.	description	date	sign
03		2006.03.25	gushengqian
	As-built drawing	07.2007	

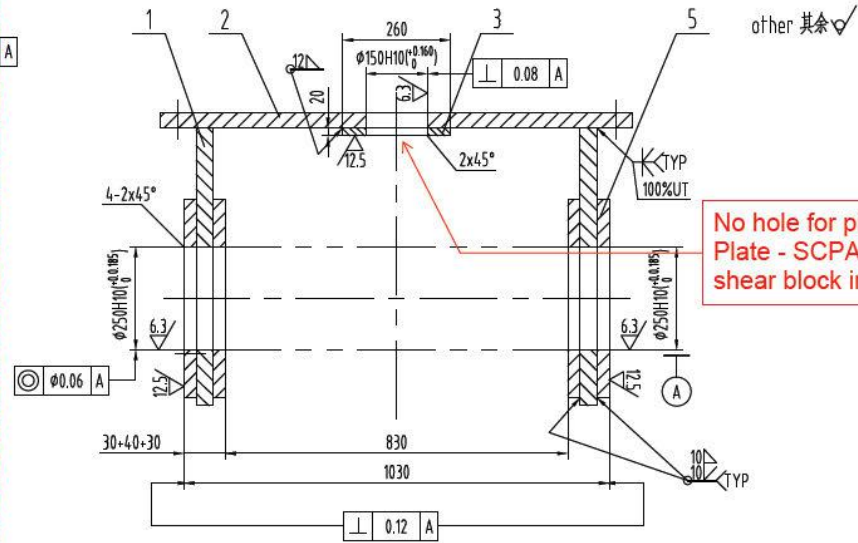

No hole for pin - Solid Plate - SCPA will add shear block in US

技术要求

1. 焊缝应符合AWS D1.1-2002, Section 9 焊接规范
2. 切割面要求平整, 特别是外露和隔板内孔
3. 焊条采用E5015.
4. 本件与大平衡梁连接时, 两侧角120x45°位于大平衡梁内档

Technical Requirement







1. Weld shall be in accordance with AWS D1.1-2002, Section 9.
2. Cutting surface should be smooth, which is especially needed for outside.
3. Welding rods should be E5015.
4. The side of both chamfer 120x45°, should be set inside of upper beam.

5		(-20)×φ460/φ250	A709-50-2	4	18.4	36.8	
4							
3		(-20)×φ260/φ150	A709-50-2	1		2.8	
2		(-36)×1130×1130	A709-50-2	1		346	
1		-40×674×950	A709-50-2	2	136	272	
NO.	SUB-NO. or STDD	NAME & SIZE	MTRL or STYLE	Q'TY/SET	SET*WEIGHT	SCALE	
	J227A0402	Support 连接支架	Welded 焊接件	8	8×690	1:15	
ZPMC	DRAW		TECH.		TRACE		
	CHCK		STDD		CHCK		

Revised








01/19/2024 11:42:18 AM

Rev. No.	description	date	sign
01		2005.12.14	gushenqian
02		2006.1.19	gushenqian
03		2006.4.3	gushenqian
As-built drawing			07.2007

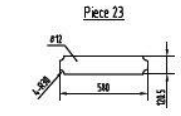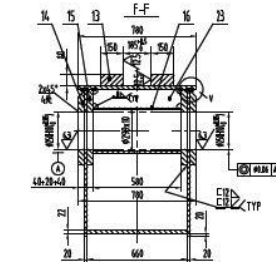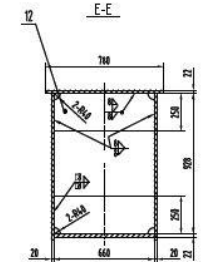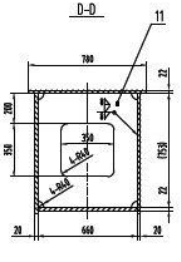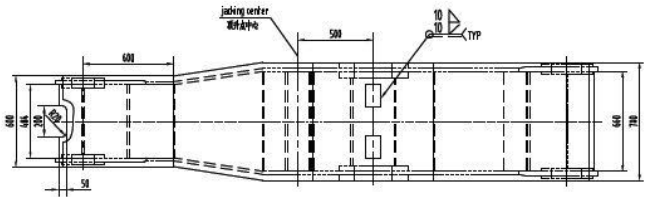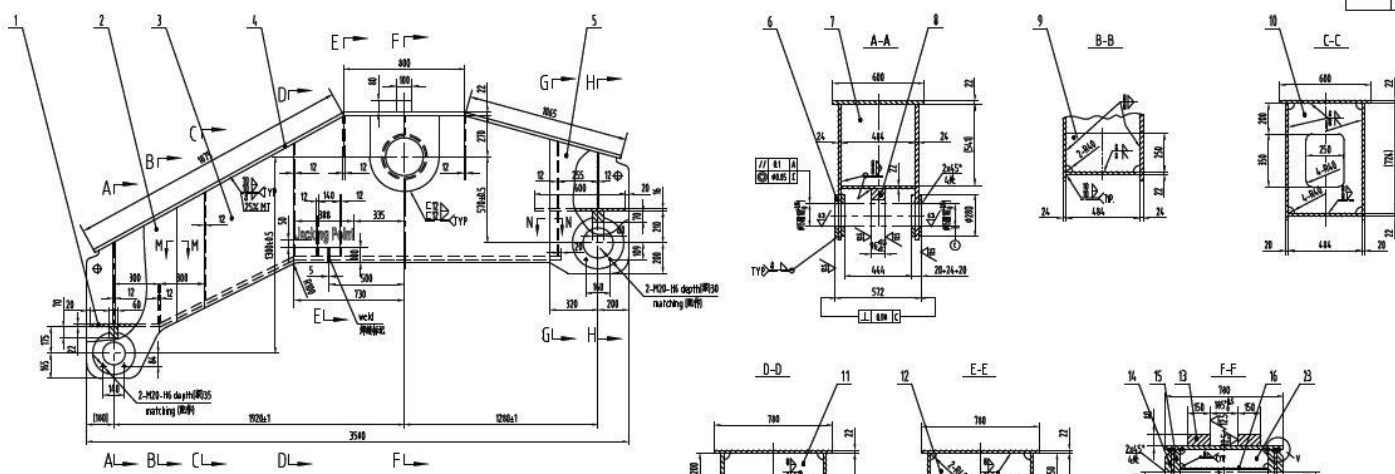

Technical Requirement


1. Weld shall be in accordance with AWS D11.1-2002 Section 9.
 2. It's necessary to make 100% ultrasonic flow detection and 100% X-ray selective examination for butt groove weld.
 3. For abrupt slope built of thin plate and thick plate, the latter's abrupt slope should be machined, and cutting is not permitted. all machining will be carried out after completion of welding.
 4. 15 psig experiment should be done in the hermetic place.
 5. Weld rods should be E5015.
 6. all plates over 40mm thickness will be preheated before welding.
 7. The size in the subsidiary list is for reference of preparing the feed only, the accurate size should be determined when lifting.
- 技术要求
1. 焊接应符合AWS D11.1-2002 Section 9焊接规范。
 2. 所有对接焊缝, 均须做100%UT探伤检查, 并作100%射线无损检测。
 3. 薄板与厚板的斜接过渡, 前者应加工成圆滑过渡, 不得有切口, 并须做去毛刺。
 4. 所有焊缝应做15psig的密封大气试验且保压5分钟。
 5. 焊条应采用E5015, 大于40mm的板须预热。
 6. 钢板中板尺寸仅供参考, 以最终为准。

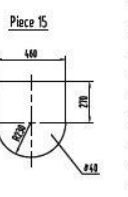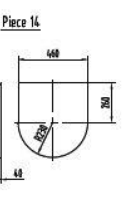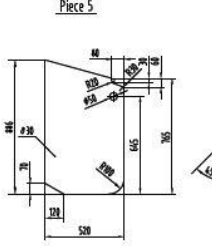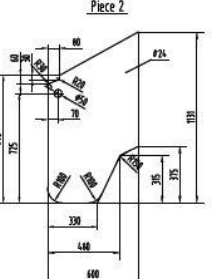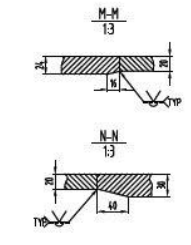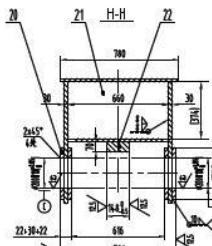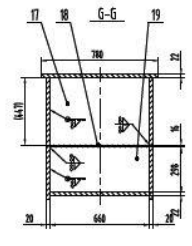

23	-12x105x500	A709-58-2	1	65
22	-70x80x14.8	A709-58-2	1	65
21	-12x370x660	A709-58-2	1	28.8
20	-122x934x10200	A709-58-2	4	10.3
19	-12x298x660	A709-58-2	1	18.5
18	-16x600x660	A709-58-2	1	58
17	-12x471x660	A709-58-2	1	27.8
16	0299x10-500	20	1	41.4
15	-4.0x460/0250	A709-58-2	2	50
14	-4.0x460/0250	A709-58-2	2	48
13	-80x100x150	A709-58-2	2	9.6
12	-12x250x660	A709-58-2	4	15.5
11	-12x660x753	A709-58-2	1	35
10	-12x460x776	A709-58-2	1	34
9	-12x250x484	A709-58-2	1	11.4
8	-60x70x96	A709-58-2	1	4.8
7	-12x440x514	A709-58-2	1	24.7
6	-120x280x1950	A709-58-2	4	6.9
5	-30x520x886	A709-58-2	2	97
4	-22x700x3740	A709-58-2	1	436
3	-20x350x2467	A709-58-2	2	354
2	-24x600x1131	A709-58-2	2	97
1	-22x660x3724	A709-58-2	1	335

NO.	SUB-NO. or STD	NAME & SIZE	MTRL or STYLE	QTY/SET	SET WEIGHT	SC
	2271A043	Welded beam 平字钢	Welded 焊接件	8	2500	1
ZPMC	DRAW	TECH		TRAC		
	CHK	STD		CHK		




Revised
01/19/2024 11:42:18 AM

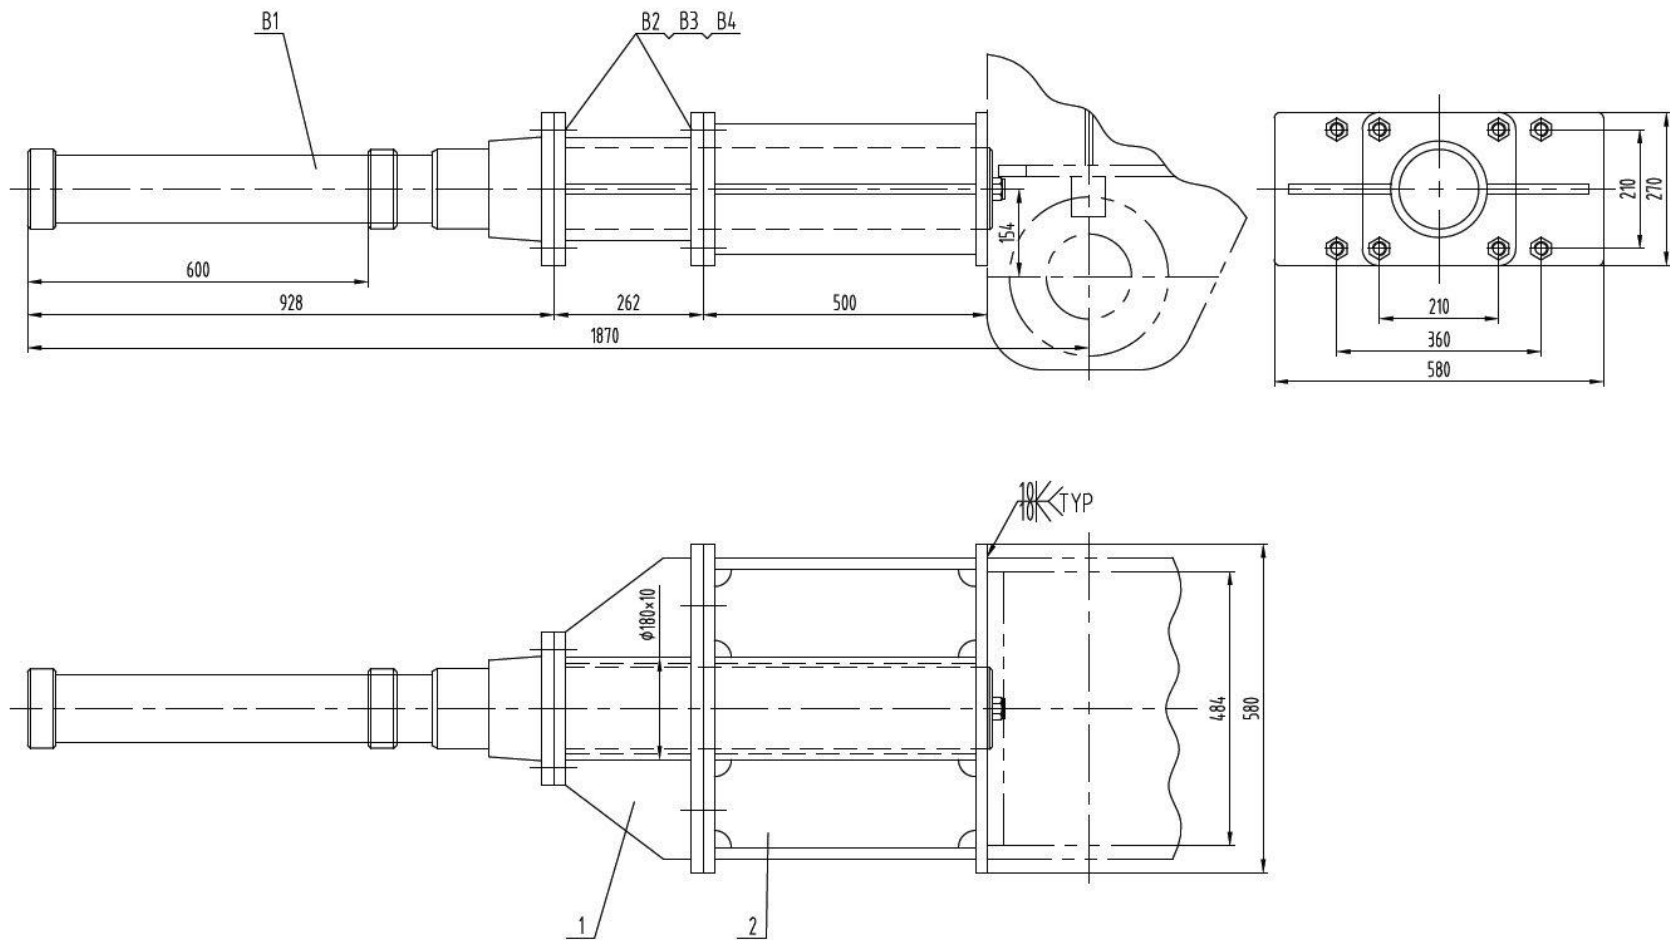

NO.	SUB-NO. or STDD	NAME & SIZE	MTRL or STYLE	Q'TY/SET	SET*WEIGHT	SCALE
2	J227A040402	Support 2 支架2	Weled 焊接件	1	115	
1	J227A040401	Support 1 支架1	Weled 焊接件	1	43	
B4	GB95-85	Washer 垫圈 24	Dacro.达克罗	8		
B3	GB889-86	Nut 螺母 M24	8S Dacro.达克罗	8		
B2	GB5782-86	Bolt 螺栓 M24x80	8.8S Dacro.达克罗	8		
B1	76MFK140-617	BUFFER 缓冲器	OLEO	1	79	
ZPMC		DRAW	TECH.	TRACE		
		CHCK	STDD	CHCK		
Buffer device 缓冲器装置				4	4x237	1:8

Revised

01/19/2024 11:42:18 AM

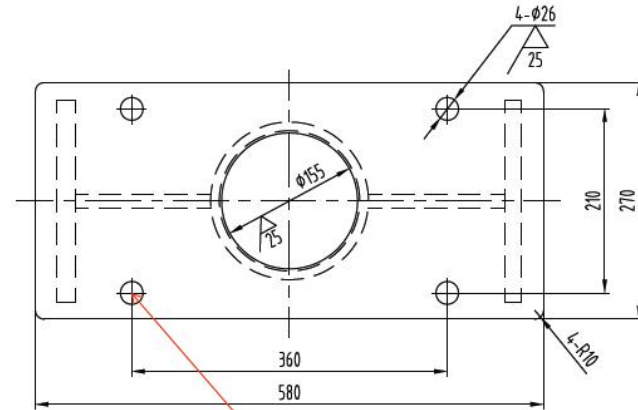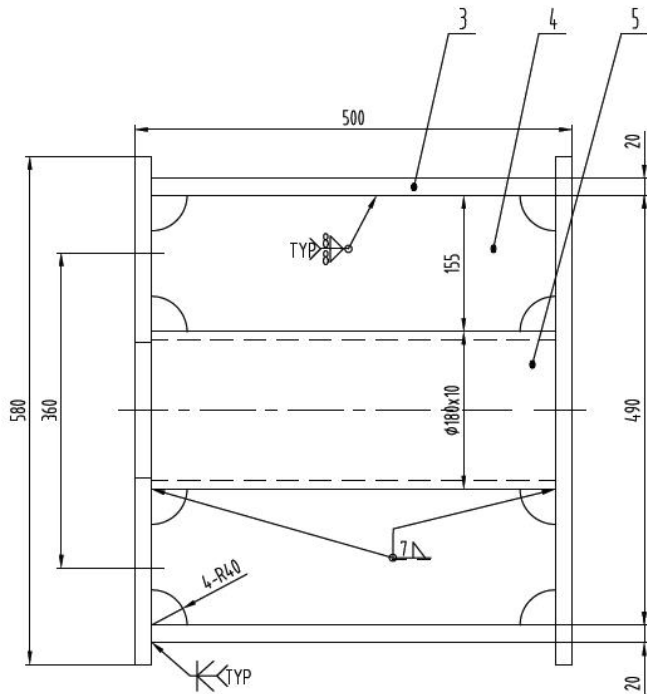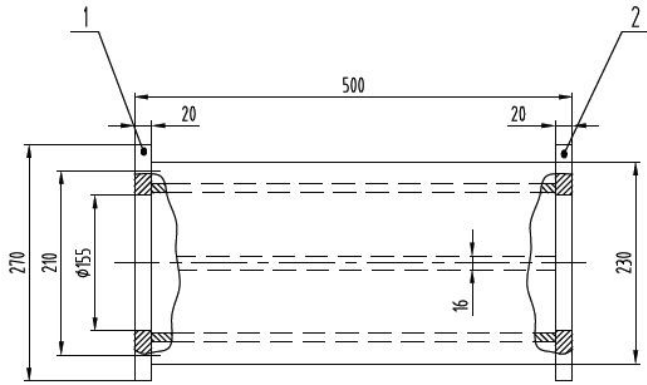


DON'T DRILL BOLT HOLES

5		φ180x10-460	20	1	20	20	
4		-16x155x460	A709-50-2	2	9	18	
3		-20x230x460	A709-50-2	2	16.6	33.2	
2		-20x270x580	A709-50-2	1	21	21	
1		-20x270x580	A709-50-2	1	21	21	
NO.	SUB-NO. or STDD	NAME & SIZE	MTRL or STYLE	Q'TY/SET	SET*WEIGHT	SCALE	
	J227A04.04.02	Support 2 支架2	Welded 焊接件	4	4x115	1:5	
ZPMC	DRAW		TECH.		TRACE		
	CHCK		STDD		CHCK		


Revised

01/19/2024 11:42:18 AM

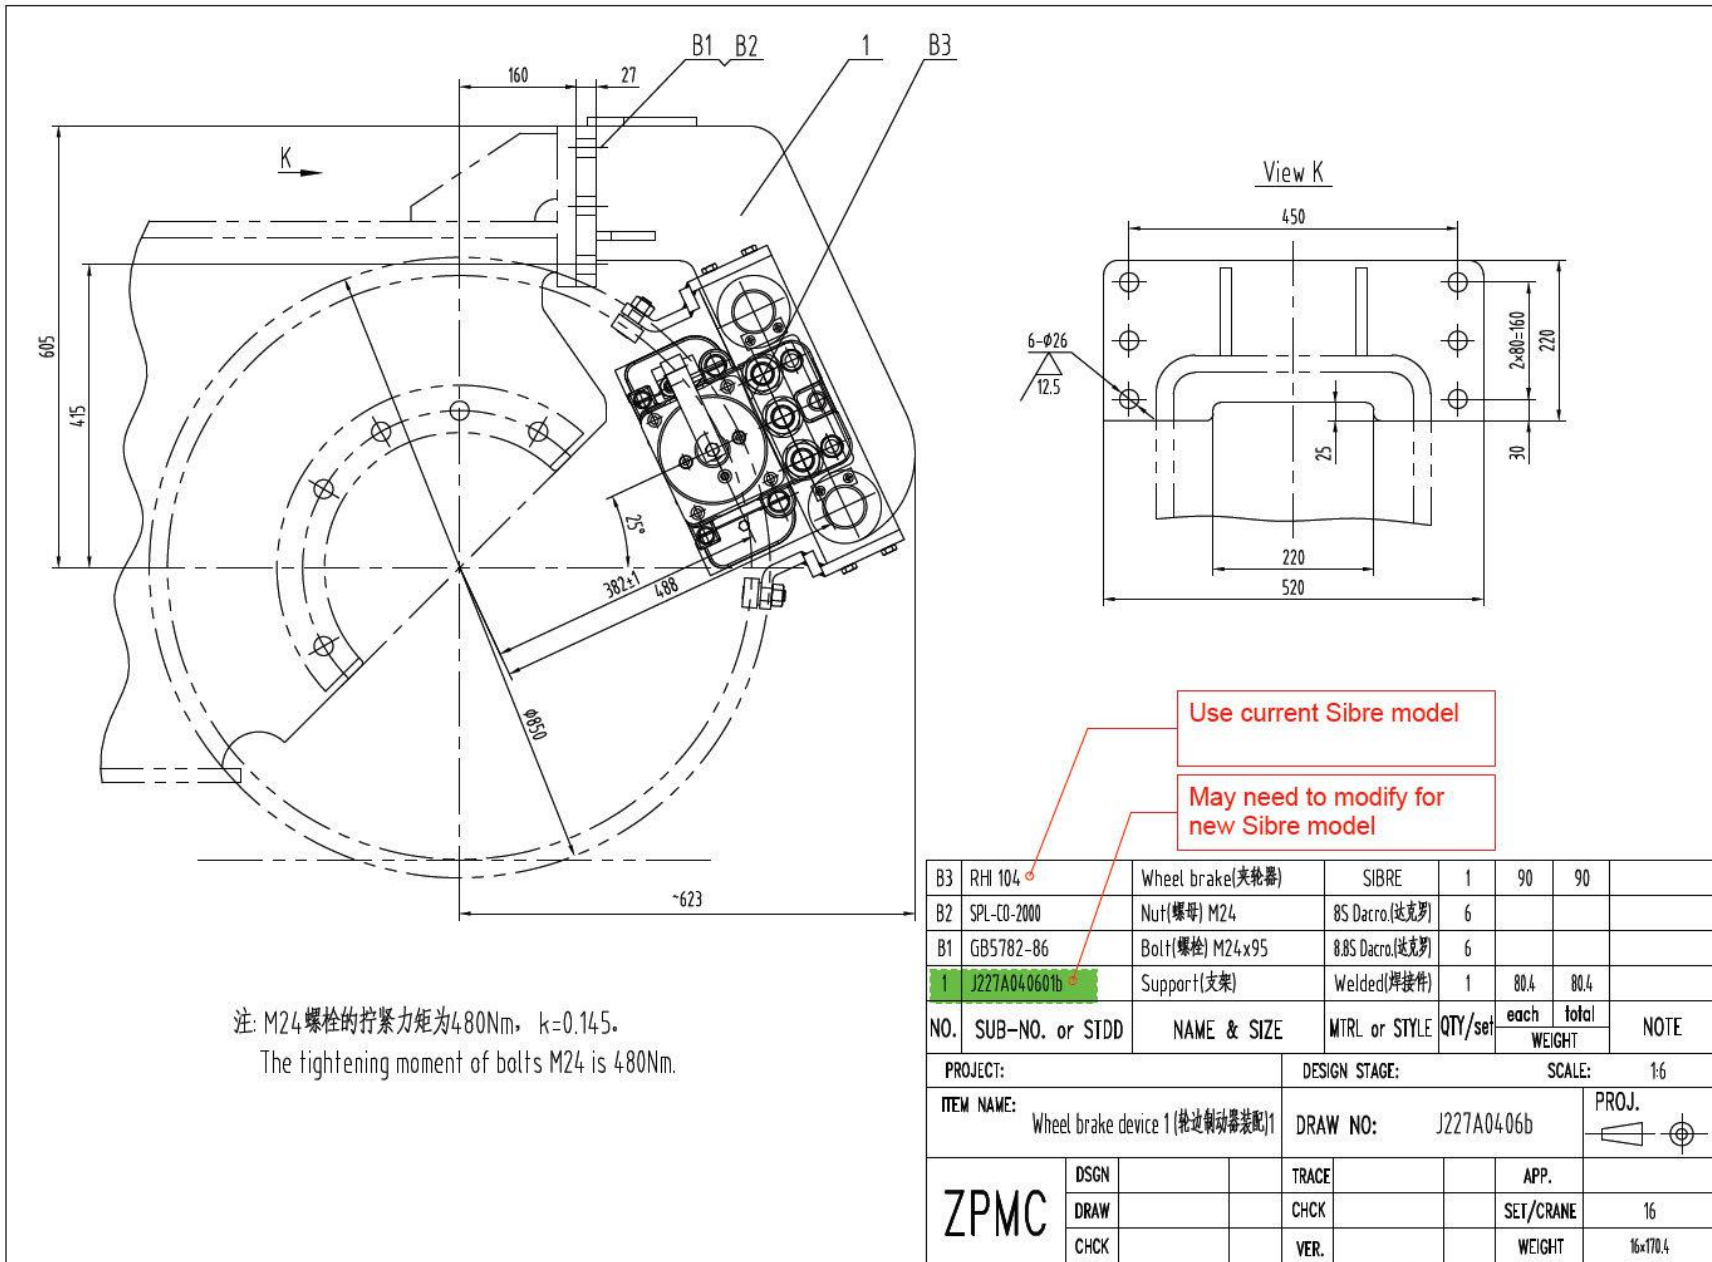

*Note - ZPMC Engineering to verify dimensions, component updates, and comments in red.

Revised
01/19/2024 11:42:18 AM














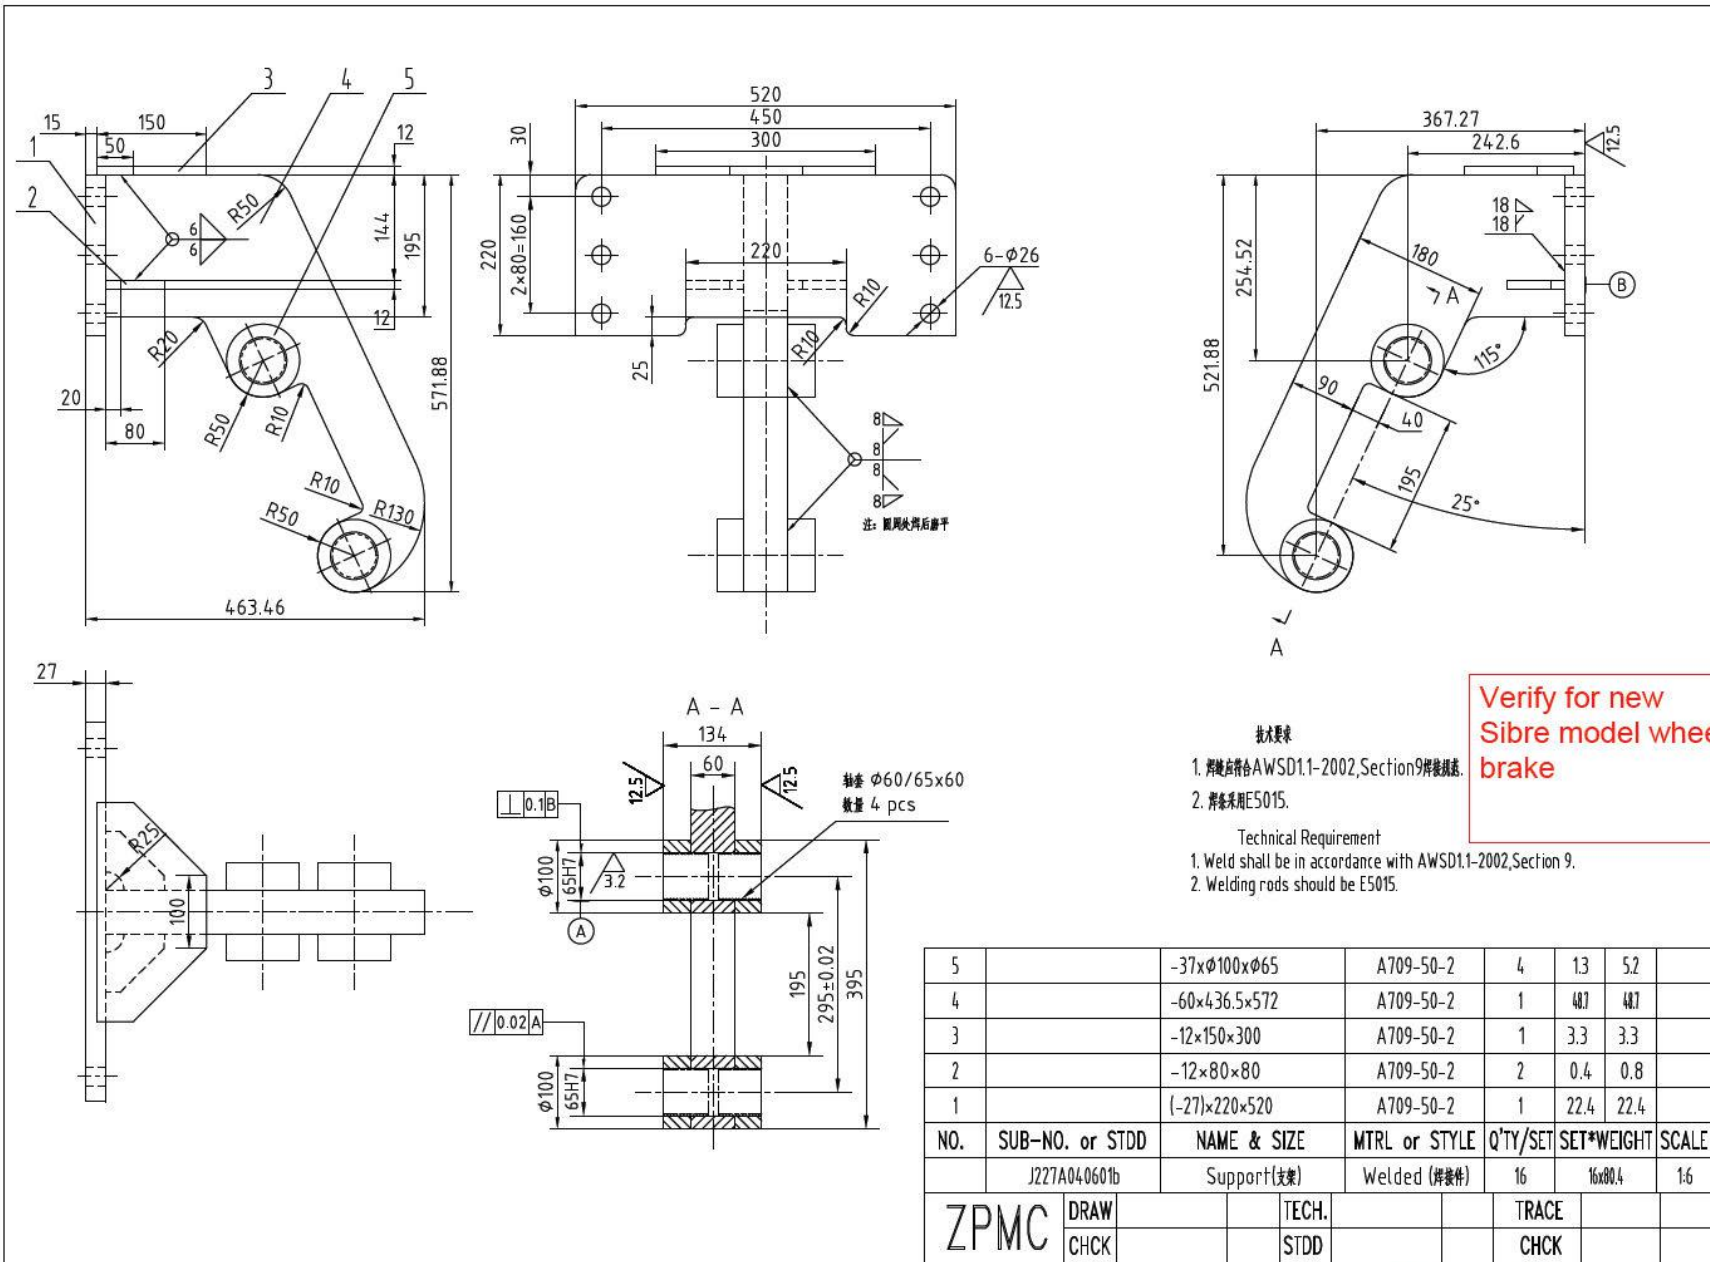


*Note - ZPMC Engineering to verify dimensions, component updates, and comments in red.

Revised

01/19/2024 11:42:18 AM

Rev. No.	Description	Date	Sign
01		2005.12.14	yuqian
02		2006.1.13	yuqian
03		2006.4.3	yuqian
04		2006.5.7	Mao
As-built drawing			07.2007

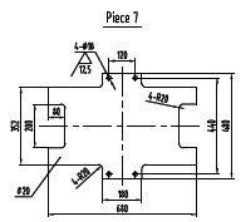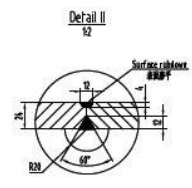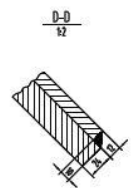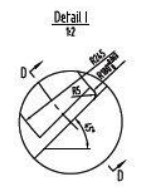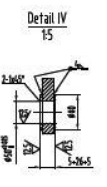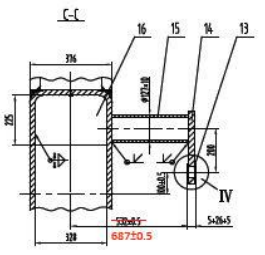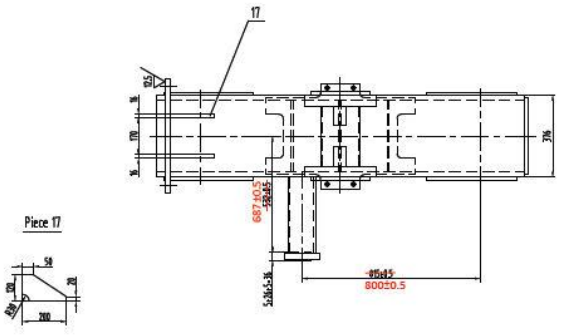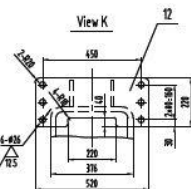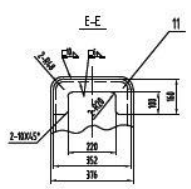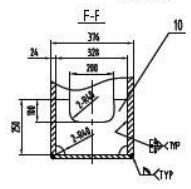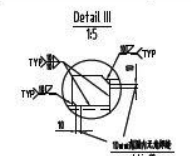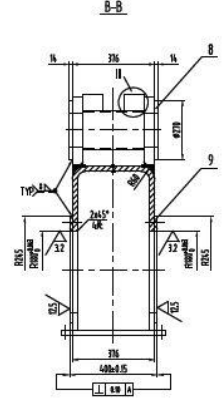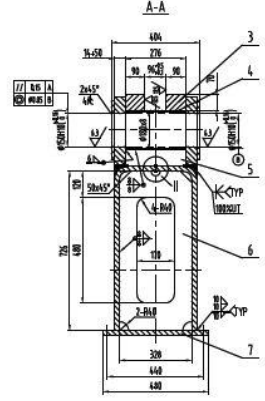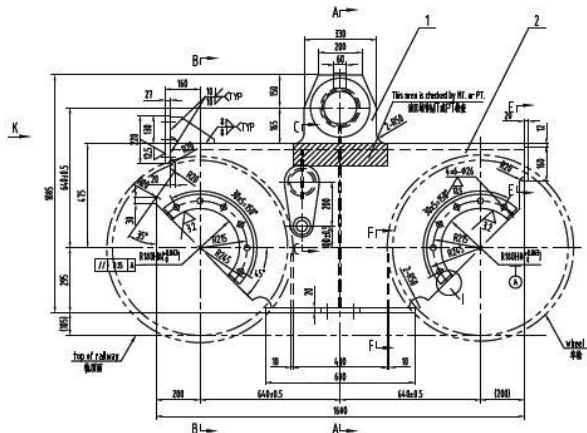

- 技术要求
1. 焊缝应符合 AWS D11.1:2002, Section 5 的要求
 2. 所有焊缝应进行 RT 检测, 检测标准按 JB/T 4730.3-2005
 3. 所有焊缝应进行 PT 检测, 检测标准按 JB/T 4730.5-2005
 4. 所有焊缝应进行 45° 倒角
 5. 所有焊缝应进行 45° 倒角
 6. 所有焊缝应进行 45° 倒角
 7. 所有焊缝应进行 45° 倒角
 8. 所有焊缝应进行 45° 倒角



- Technical Requirement
1. Weld shall be in accordance with AWS D11.1:2002, Section 5.
 2. All welded joints shall be RT inspected and welding flaw shall be in accordance with JB/T 4730.3-2005. Welding records shall be ECRS.
 3. Welding records shall be ECRS.
 4. All plates over 10mm thickness will be preheated before welding.
 5. Corrosion surface should be smooth, which is especially needed for outside. All machining will be carried out after completion of welding.
 6. Unworked chamfer 3x45°.
 7. Unworked welding height is 0.7 times the thickness of the thin plate.
 8. The size in the subsidiary list is for reference of preparing the feed only, the accurate size should be determined when lifting.
 9. The current piece should be symmetricity made.

17	-16x120x200	A709-50-2	2	2	4
16	-16x225x320	A709-50-2	1	1	5.8
15	Ø127x10-34.0	20	1	1	10
14	-26x160x330	A709-50-2	1	1	8.6
13	L-50x90x950	A709-50-2	2	0.2	8.6
12	L-271x220x520	A709-50-2	1	1	21.6
11	-26x160x352	A709-50-2	1	1	5.2
10	-16x250x320	A709-50-2	2	4.7	9.4
9	L-120x102x5/1000	A709-50-2	4	4	16
8	-11xØ70/Ø150	A709-50-2	2	3.5	7
7	-26x180x480	A709-50-2	1	1	3.6
6	-16x200x276	A709-50-2	1	1	12
5	-16x75x276	A709-50-2	1	1	1.6
4	Ø160x-276	20	1	1	9.4
3	-50x70x90	A709-50-2	2	3	6
2	-24x91x1600	A709-50-2	2	225	6.6
1	-56x315x430	A709-50-2	2	36.5	41




NO.	SUB-NO. or STD	NAME & SIZE	MTRL. or STYLE	QTY	SET	WEIGHT	SCALE
		2271A04-07	Bag 0#	welded	16	16x70	1:10
ZPMC	DRAW	TECH.					
	CHK	STD					

*Note - ZPMC Engineering to verify dimensions, component updates, and comments in red.

Revised
01/19/2024 11:42:18 AM

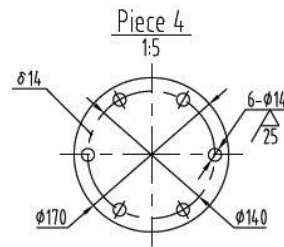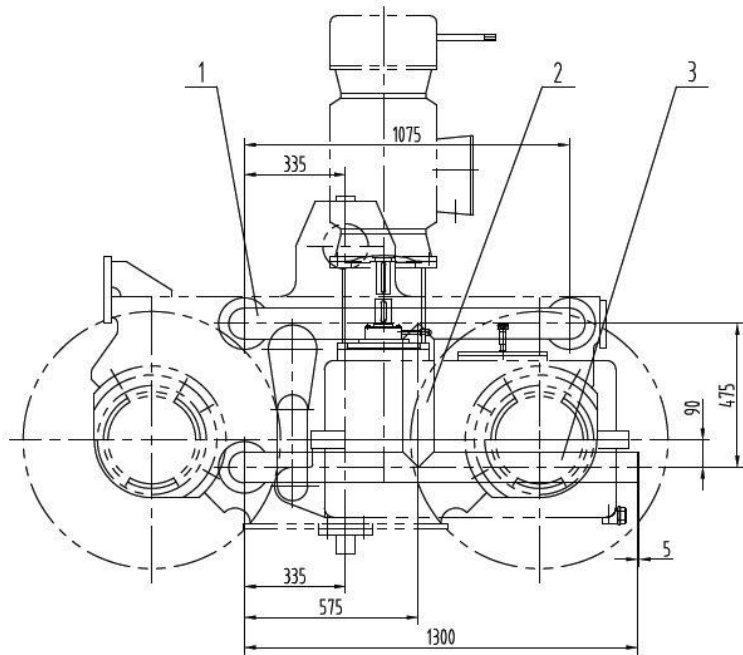



注: 对称制作共14件.
Note: The current piece should be symmetrically made.

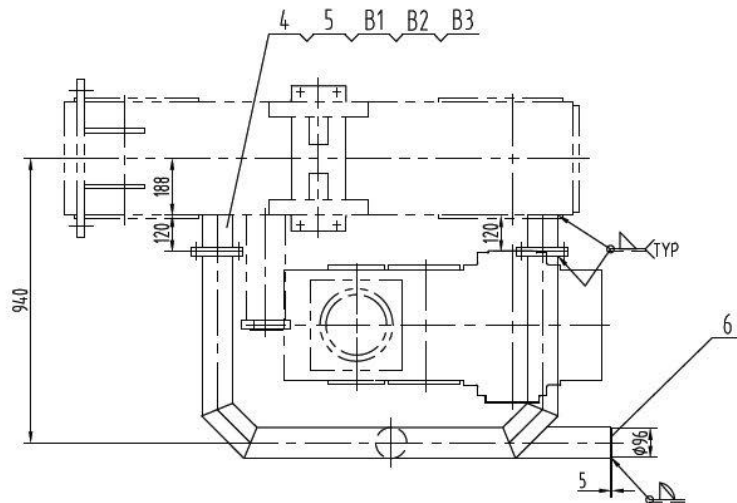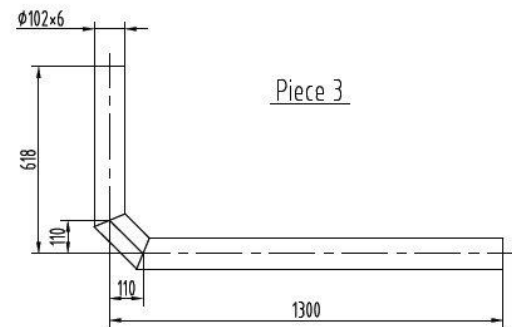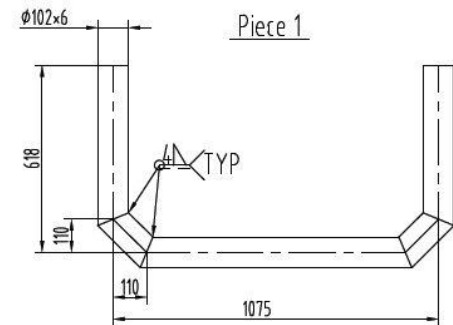




B3	GB95-85	Washer 垫圈12	Sta. Ste. 不锈钢	18			
B2	GB889-86	Nut 螺母M12	Sta. Ste. 不锈钢	18			
B1	GB5783-86	Bolt 螺栓M12x45	Sta. Ste. 不锈钢	18			
6		-5xφ96	A709-50-2	1		0.3	
5	J227A04-0801	Support 支座	Welded 焊接件	3	3.5	10.5	
4		-14xφ170	A709-50-2	3	2	6	
3		φ102x6-1936	20	1		28	
2		φ102x6-475	20	1		6.8	
1		φ102x6-2347	20	1		33.4	
NO.	SUB-NO. or STDD	NAME & SIZE	MTRL or STYLE	Q'TY/SET	SET*WEIGHT	SCALE	
	J227A04-08-1	Enclosure 1 护栏1	Assembly 组件	14	14x85	1:15	
ZPMC	DRAW		TECH.		TRACE		
	CHCK		STDD		CHCK		

Revised

01/19/2024 11:42:18 AM

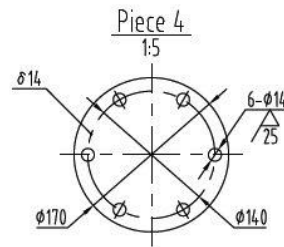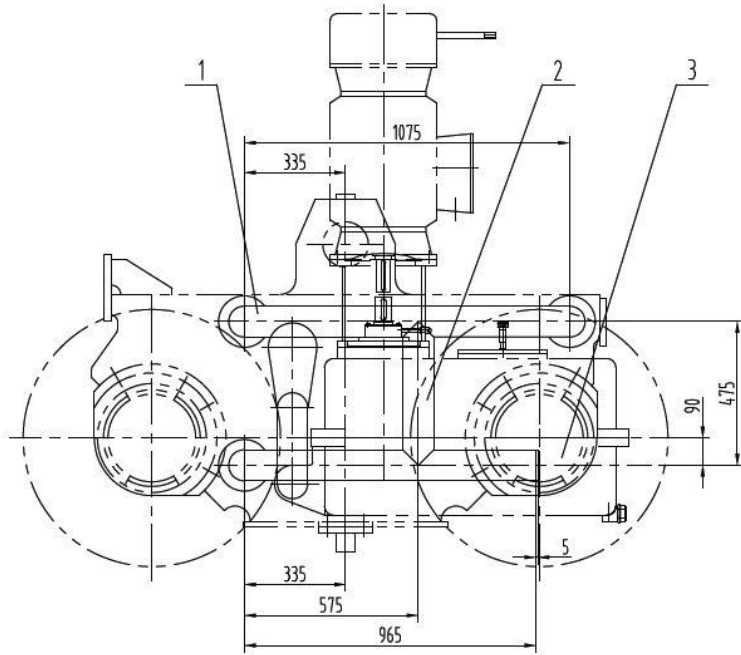


注: 对称制作共2件, 安装于陆侧理货室两侧
 Note: The current piece should be symmetrically made.
 Installed besides the check's cab.

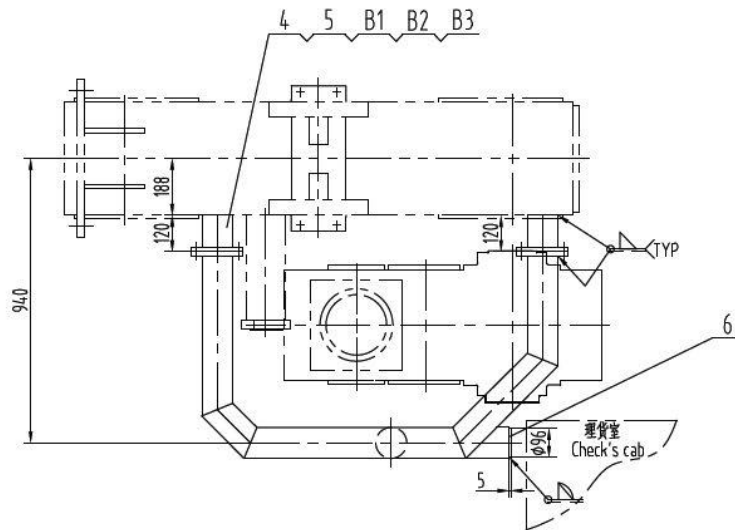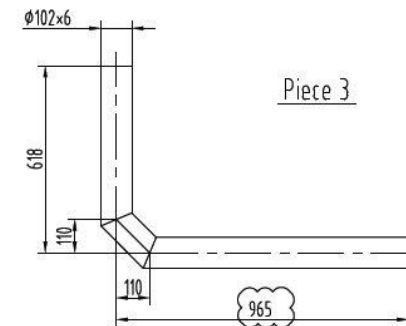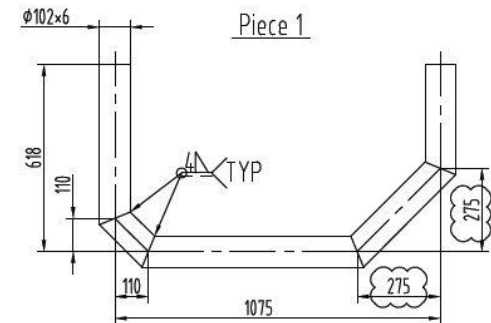

B3	GB95-85	Washer 垫圈12	Sta. Ste. 不锈钢	18			
B2	GB889-86	Nut 螺母M12	Sta. Ste. 不锈钢	18			
B1	GB5783-86	Bolt 螺栓M12x45	Sta. Ste. 不锈钢	18			
6		-5xφ96	A709-50-2	1		0.3	
5	J227A04-0801	Support 支座	Welded 焊接件	3	3.5	10.5	
4		-14xφ170	A709-50-2	3	2	6	
3		φ102x6-1601	20	1		23	
2		φ102x6-475	20	1		6.8	
1		φ102x6-2255	20	1		32	
NO.	SUB-NO. or STDD	NAME & SIZE	MTRL or STYLE	Q'TY/SET	SET*WEIGHT	SCALE	
	J227A04-08-2	Enclosure 1 护栏1	Assembly 组件	2	2x78.6	1:15	
ZPMC	DRAW		TECH.		TRACE		
	CHCK		STDD		CHCK		


Revised

01/19/2024 11:42:18 AM

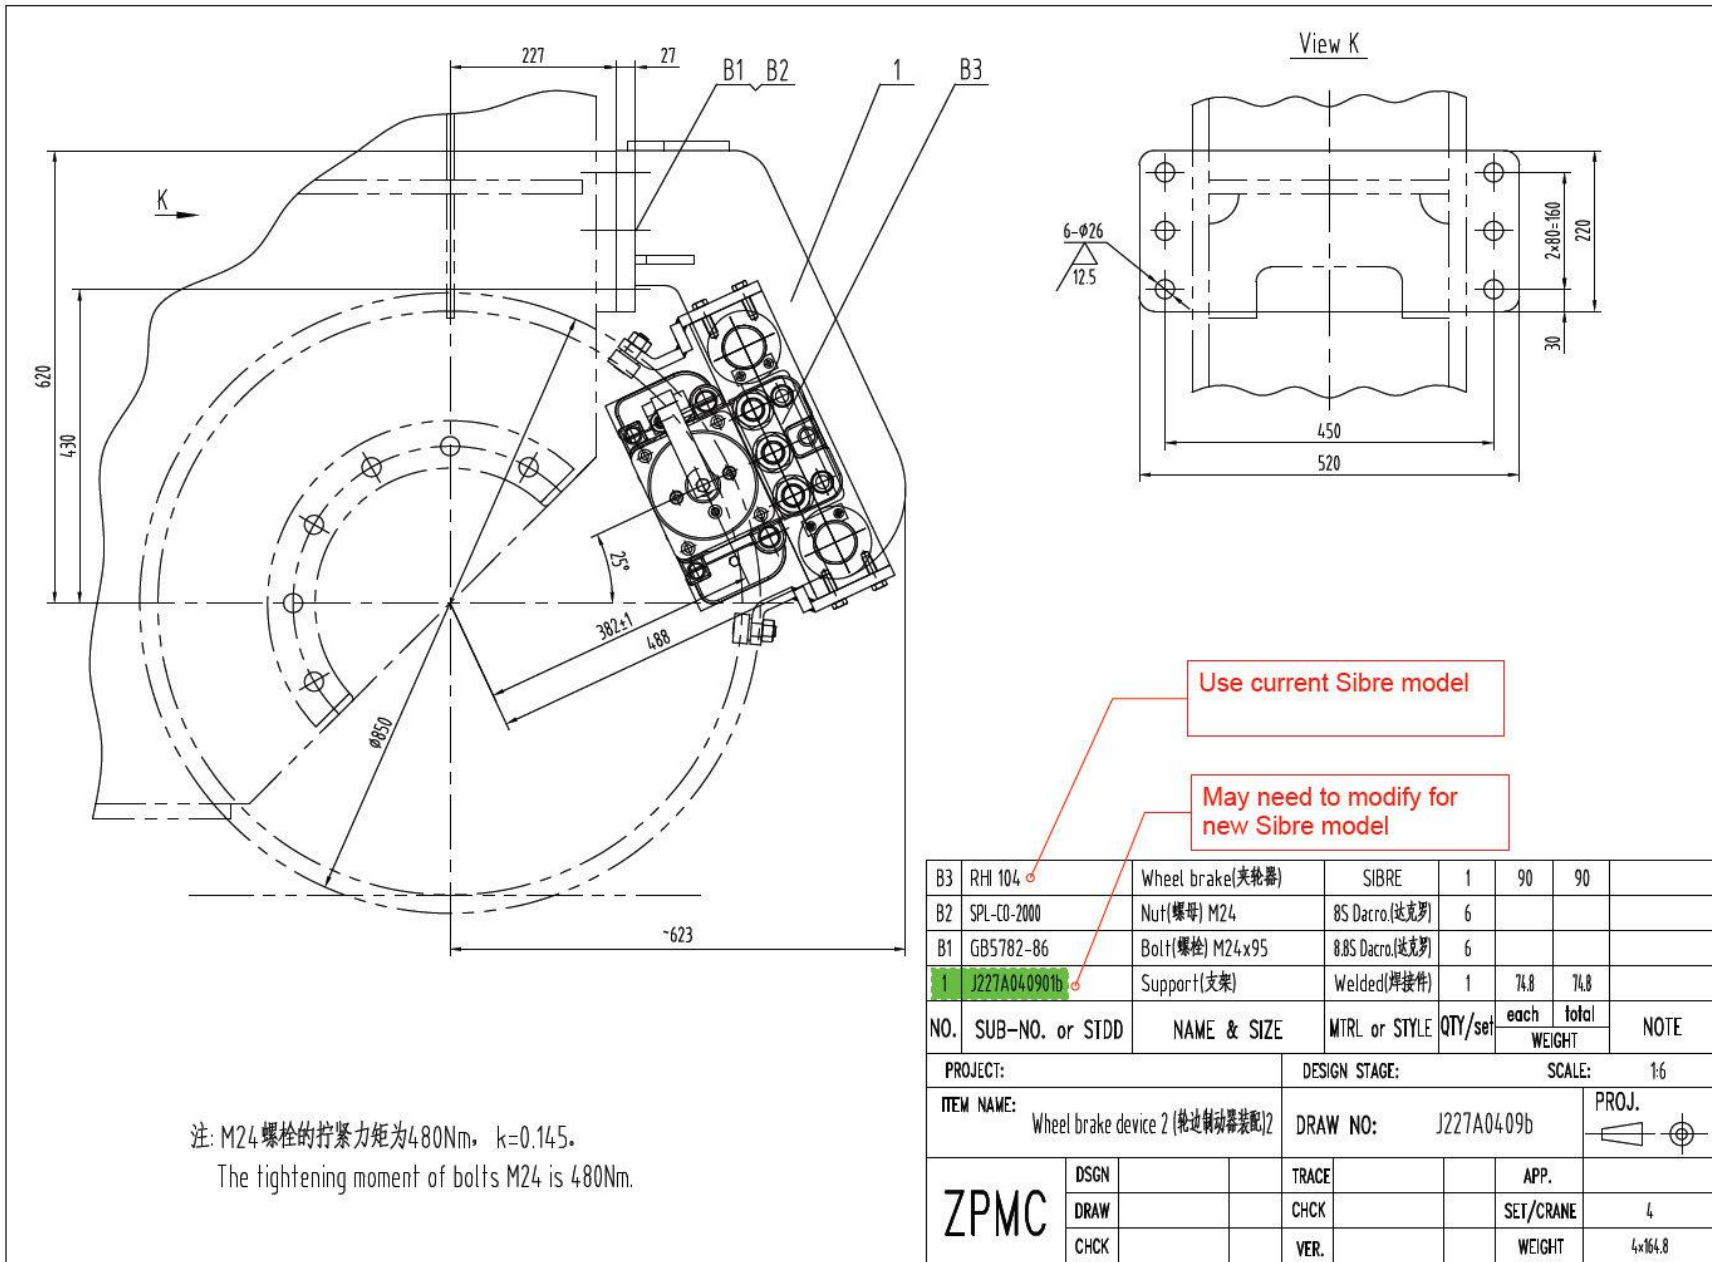

*Note - ZPMC Engineering to verify dimensions, component updates, and comments in red.

Revised
01/19/2024 11:42:18 AM

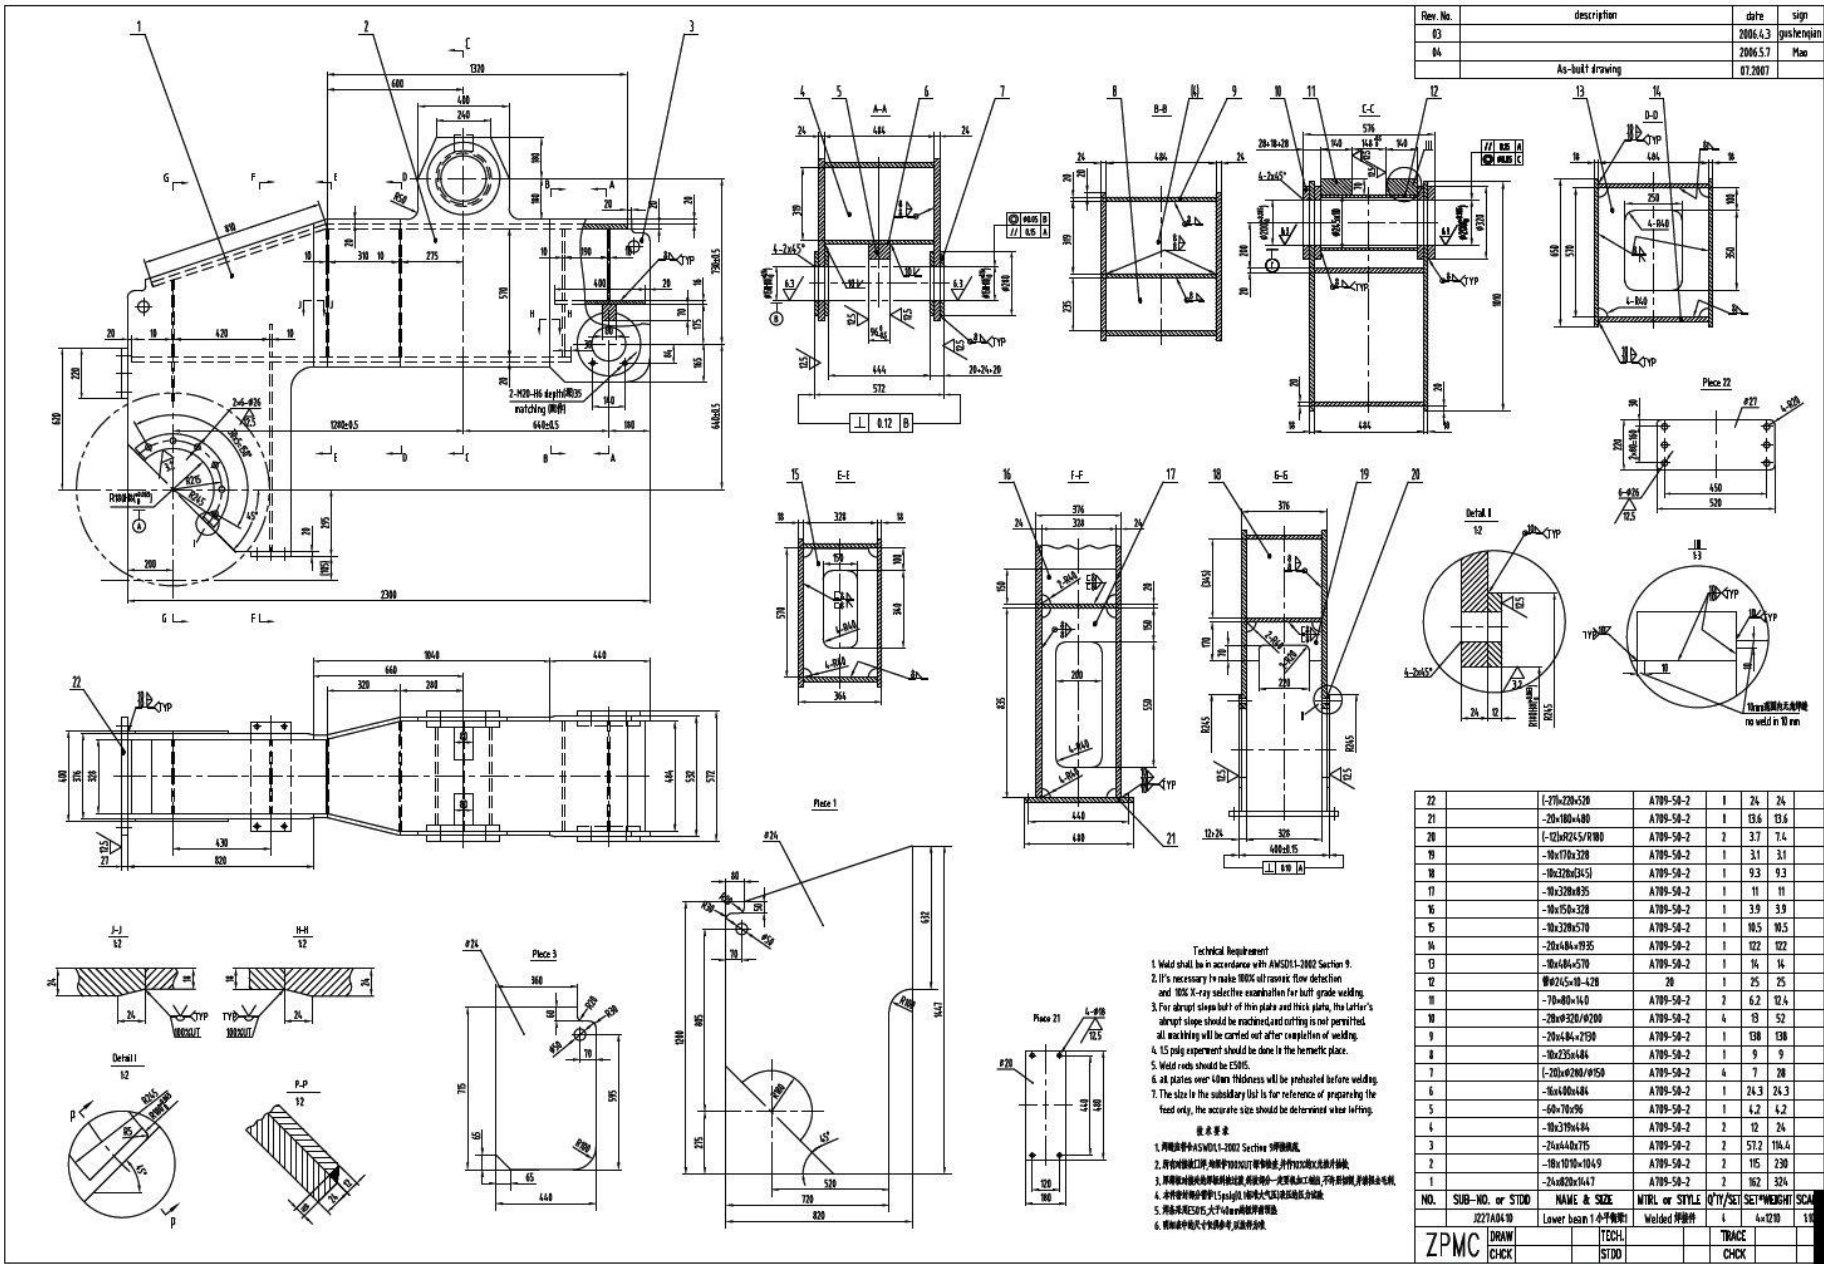

Rev. No.	description	date	sign
03		2006.4.3	gushenjian
04		2006.5.7	Ma
	As-built drawing	07.2007	

22	-77x220x520	A709-S8-2	1	24	24	
21	-20x100x480	A709-S8-2	1	13.6	13.6	
20	-102x124.5x190	A709-S8-2	2	3.7	7.4	
19	-18x178x238	A709-S8-2	1	3.1	3.1	
18	-18x278x345	A709-S8-2	1	9.3	9.3	
17	-18x288x325	A709-S8-2	1	11	11	
16	-18x150x328	A709-S8-2	1	3.9	3.9	
15	-18x278x570	A709-S8-2	1	10.5	10.5	
14	-20x484x1935	A709-S8-2	1	122	122	
13	-18x484x570	A709-S8-2	1	14	14	
12	Ø245x10-428	20	1	25	25	
11	-78x80x114	A709-S8-2	2	6.2	12.4	
10	-28x220x1200	A709-S8-2	4	13	52	
9	-20x484x259	A709-S8-2	1	138	138	
8	-18x235x484	A709-S8-2	1	9	9	
7	-20x484x1950	A709-S8-2	4	7	28	
6	-18x484x484	A709-S8-2	1	24.3	24.3	
5	-60x170x96	A709-S8-2	1	4.2	4.2	
4	-18x278x484	A709-S8-2	2	12	24	
3	-24x484x775	A709-S8-2	2	57.2	114.4	
2	-18x170x1049	A709-S8-2	2	115	230	
1	-24x828x1447	A709-S8-2	2	162	324	
NO.	SUB-NO. or STD	NAME & SIZE	MTRL or STYLE	QTY/SET	SETWEIGHT	SCALE
	Z277A04-10	Lever beam 1个半轴臂	Welded 焊接件	1	4x1210	1:1
ZPMC	DRAW	TECH		TRAC		
	CHK	STD	CHK			


Technical Requirement

- Weld shall be in accordance with AWS D11.1:2002 Section 9.
- It's necessary to make 100% ultrasonic flaw detection and 100% X-ray selective examination for butt grade welding.
- For abrupt slope butt of thin plate and thick plate, the latter's abrupt slope should be machined and cutting in not permitted. All welding will be carried out after completion of welding.
- 15 pulg experiment should be done in the hemic place.
- Weld rebs should be ESIS.
- All plates over 4mm thickness will be preheated before welding.
- The size in the subsidiary list is for reference of preparing the fixed only, the accurate size should be determined when lifting.

技术要求





- 焊缝应符合AWS D11.1:2002 Section 9的要求。
- 焊缝应进行100%超声波探伤和100%射线选择性检测。
- 对于薄板厚板的陡坡对接，厚板的陡坡应机加工，不允许开坡口。所有焊接应在焊接完成后进行。
- 应在半球位置进行15 pulg试验。
- 焊缝应进行ESIS。
- 所有厚度大于4mm的板材应在焊接前预热。
- 附表中的尺寸仅供参考，实际尺寸应在吊装前确定。

Revised
01/19/2024 11:42:18 AM

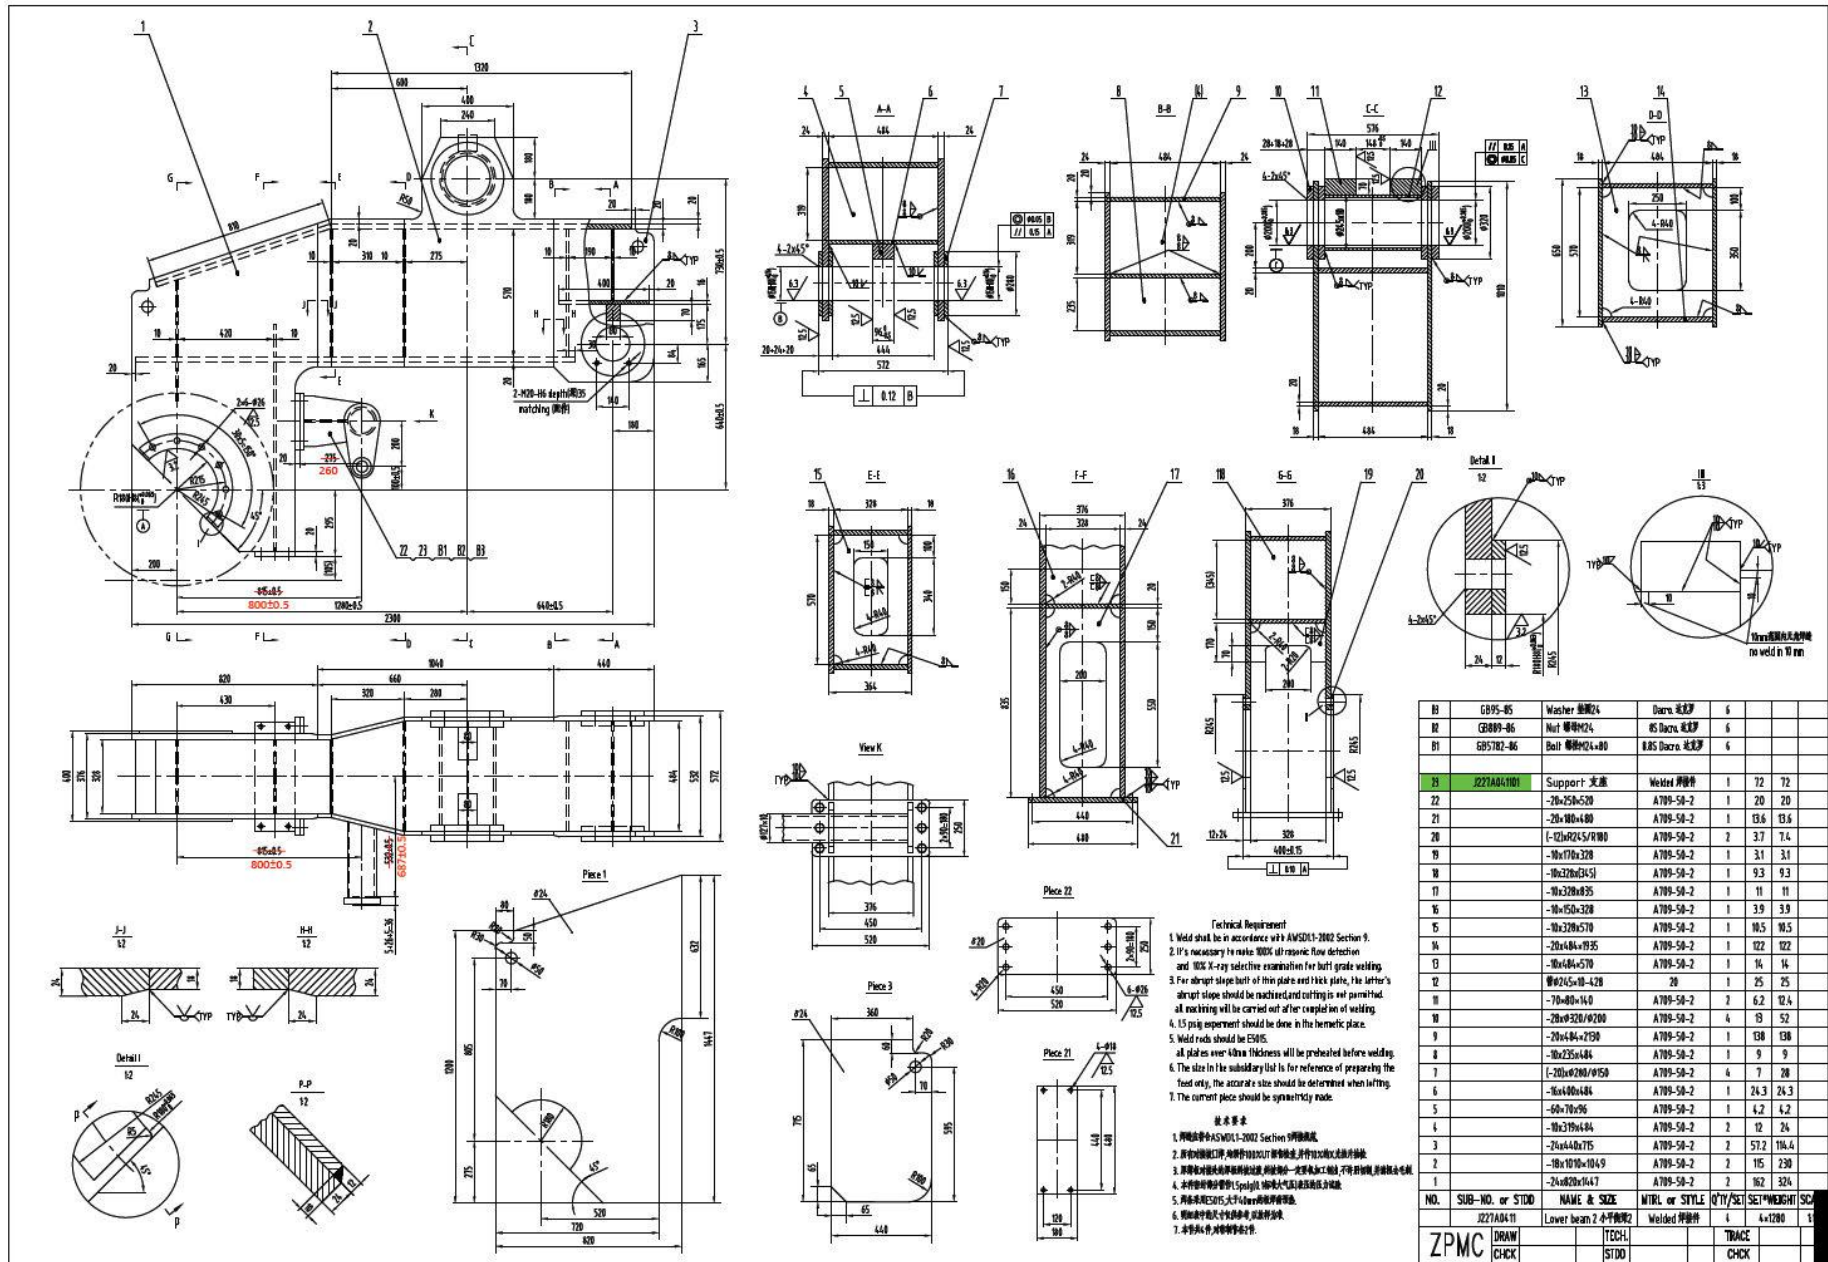

*Note - ZPMC Engineering to verify dimensions, component updates, and comments in red.





Revised
01/19/2024 11:42:19 AM

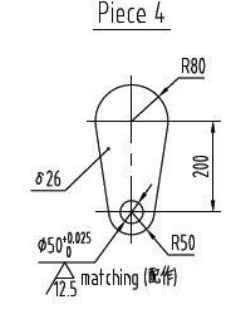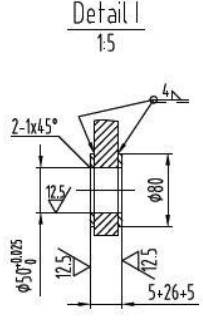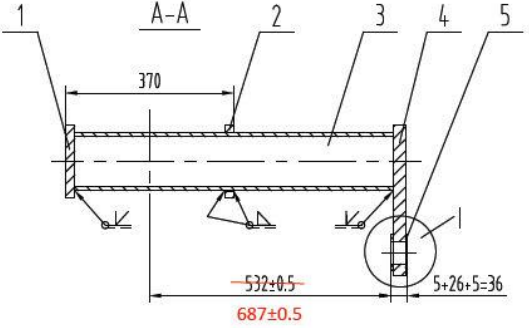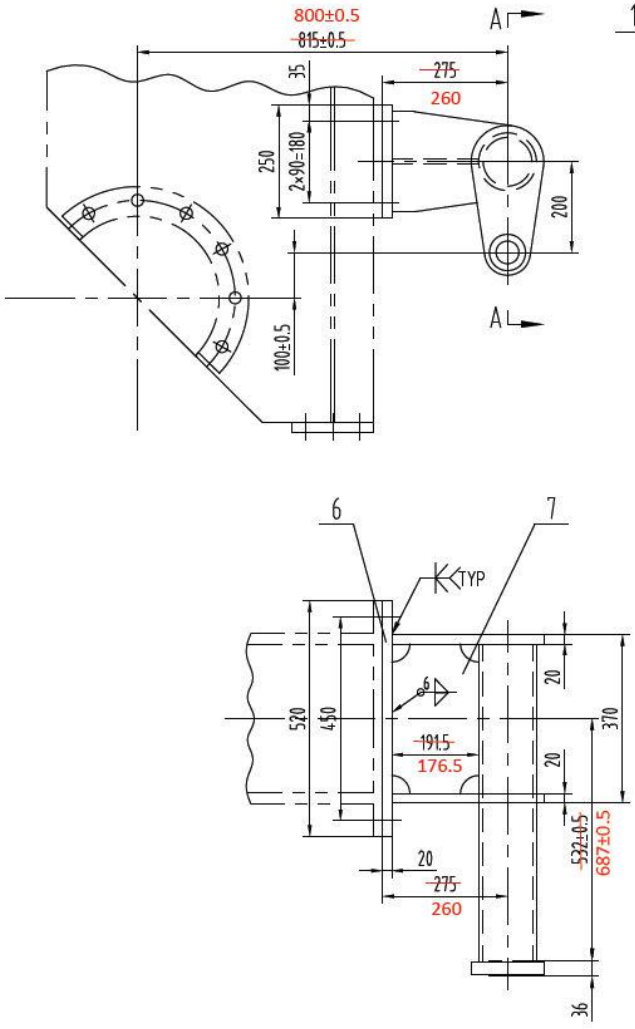

Piece 1

Piece 2






Piece 6

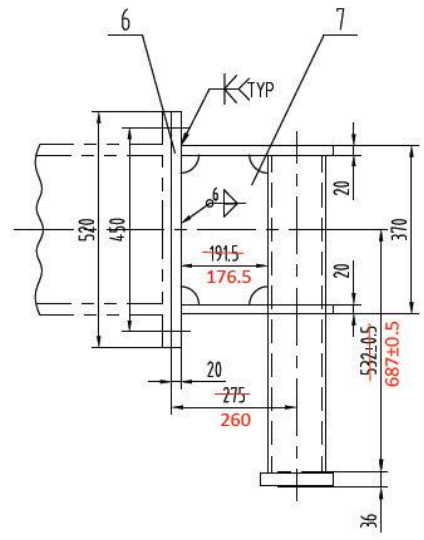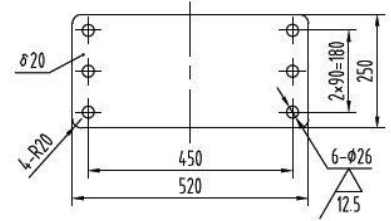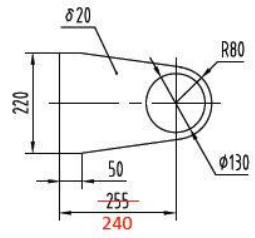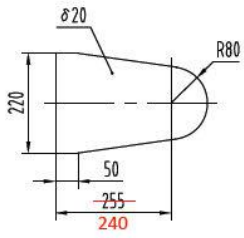

对称制作
The current piece should be symmetrically made.

7		-12×191.5×330	A709-50-2	1	6	
6		-20×250×520	A709-50-2	1	20	
5		(-5)×Ø80/Ø50	A709-50-2	2	0.2	0.4
4		-26×160×330	A709-50-2	1	8.4	
3		Ø127×10-702	20	1	20.3	
2		-20×220×335	A709-50-2	1	7.4	
1		-20×220×335	A709-50-2	1	9.5	
NO.	SUB-NO. or STDD	NAME & SIZE	MTRL or STYLE	Q'TY/SET	SET*WEIGHT	SCALE
	J227A041101	Support 支座	Welded 焊接件	4	4×72	1:10
ZPMC	DRAW		TECH.		TRACE	
	CHCK		STDD		CHCK	

*Note - ZPMC Engineering to verify dimensions, component updates, and comments in red.

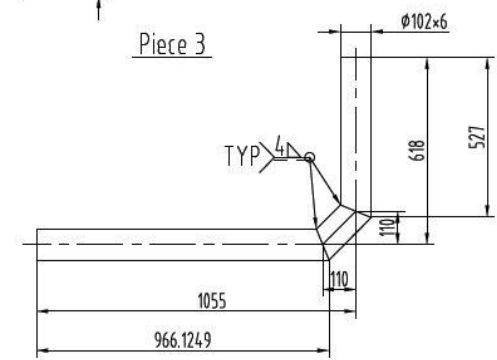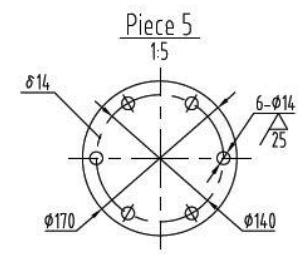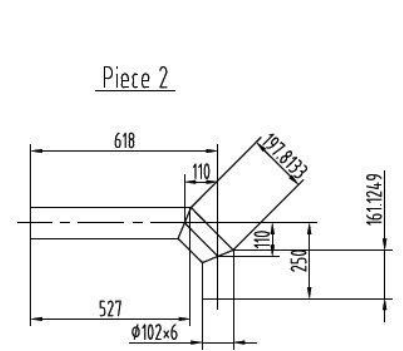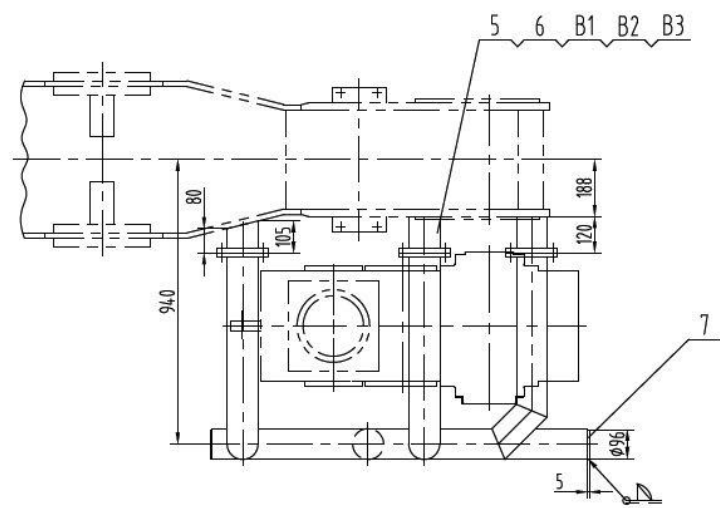
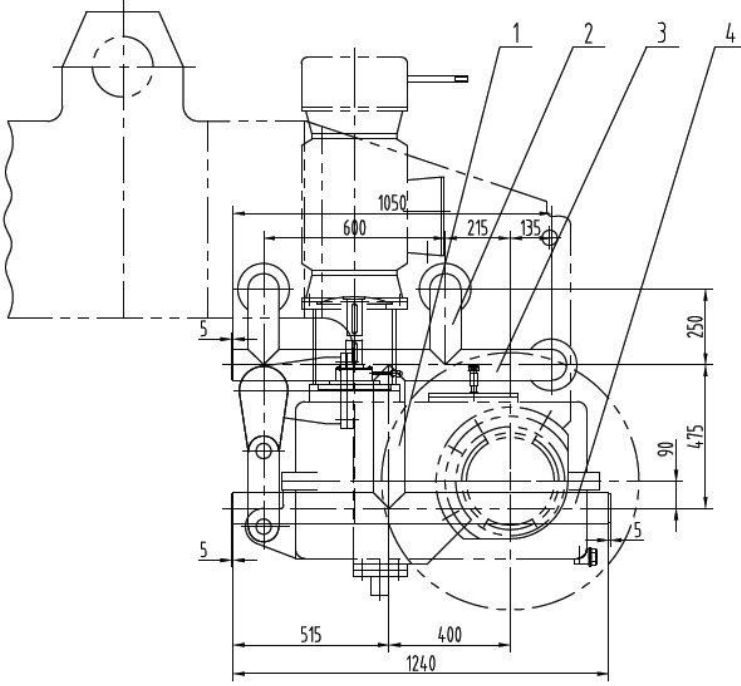


注: 对称制作共4件.
Note: The current piece should be symmetrically made.

B3	GB95-85	Washer 垫圈12	Sta. Ste. 不锈钢	18			
B2	GB889-86	Nut 螺母M12	Sta. Ste. 不锈钢	18			
B1	GB5783-86	Bolt 螺栓M12x50	Sta. Ste. 不锈钢	18			
7		-5x $\phi 96$	A709-50-2	3	0.3	0.9	
6	J227A04.0801	Support 支座	Welded 焊接件	3	3.5	10.5	借用
5		-14x $\phi 170$	A709-50-2	3	2	6	
4		$\phi 102 \times 6-1240$	20	1		17.8	
3		$\phi 102 \times 6-1691$	20	1		24.2	
2		$\phi 102 \times 6-886$	20	2	12.5	25	
1		$\phi 102 \times 6-475$	20	1		6.8	
NO.	SUB-NO. or STDD	NAME & SIZE	MTRL or STYLE	Q'TY/SET	SET*WEIGHT	SCALE	
	J227A04.12	Enclosure 2 护栏2	Assembly 组件	4	4x91	1:15	
ZPMC	DRAW		TECH.		TRACE		
	CHCK		STDD		CHCK		


Revised
01/19/2024 11:42:19 AM

Rev. No.	description	date	sign
01		2005.12.14	gushengqian
02		2006.1.13	gushengqian
03		2006.4.3	gushengqian
As-built drawing		07.2007	

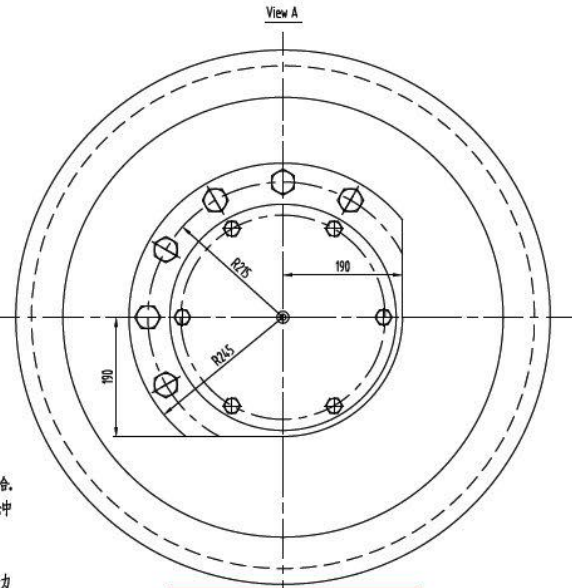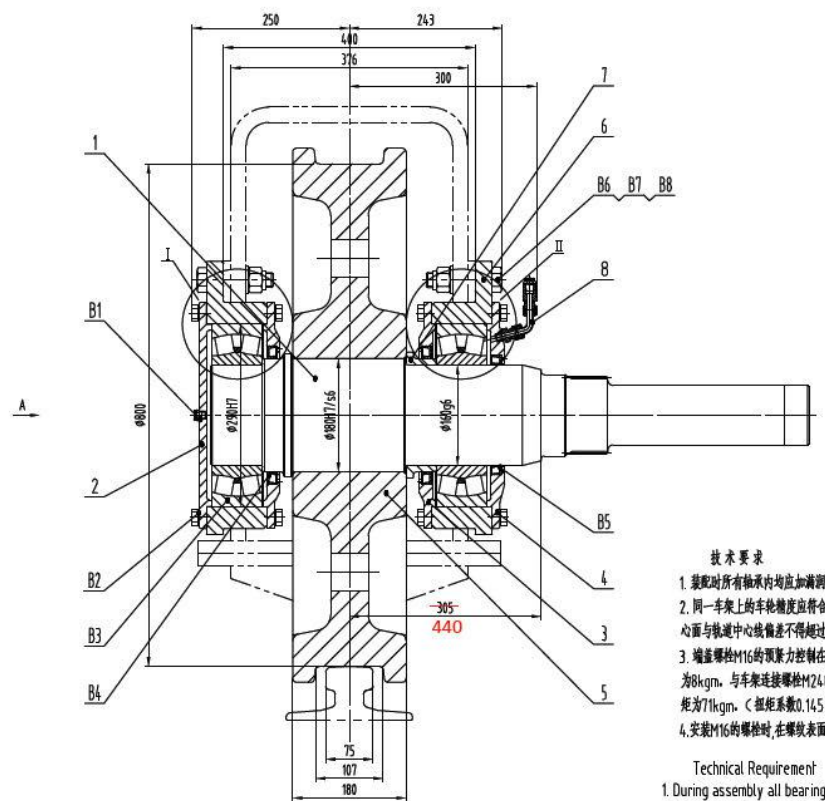

- 技术要求
1. 装配时所有轴承内均应加满润滑脂，装配完半走轮必须跑合。
 2. 同一车架上的车轮精度应符合FEM规范，同一轨道的车轮中心面与轨道中心线偏差不得超过±1mm。
 3. 端盖螺栓M16的预紧力控制在3500kg以内，预紧力矩为8kgm，与车架连接螺栓M24的预紧力为15500kg，预紧力矩为71kgm。（扭矩系数0.145）
 4. 安装M16的螺栓时，在螺纹表面涂防锈膜。

- Technical Requirement
1. During assembly all bearing should be filled with appropriate grease, wheel running should be done.
 2. Installing accuracy of the wheels on the same bogie is to conform to FEM Specification. Misalignment between wheel centers plane rolling on the same rail track and centreline of the rail should be not exceed ±1mm.
 3. The M16 bolt pre-tension force is 3500kg, the torque is 8kgm. The M24 bolt pre-tension force is 15500kg, the torque is 71kgm.
 4. It shall be sprayed anti seize compound on the surface of bolt M16.

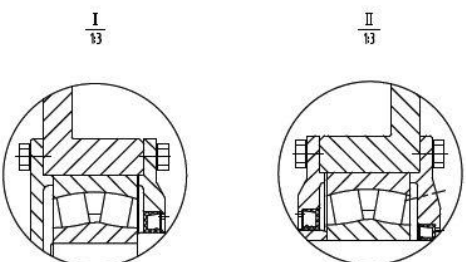

Modify per drawing
J227A041301 &
D21-114A-060401

B8	GB889-86	Nut(螺母)M24	8S Dacro 达克罗	12					
B7	GB5782-86	Bolt(螺栓)M24x110	8.8S Dacro 达克罗	12					
B6	GB95-85	Washer(垫圈)24	Dacro 达克罗	12					
B5	HG64-692-67	Seal(旋转轴唇形密封圈)	PD160x190x16	1				橡胶(rubber)	
B4	HG64-692-67	Seal(旋转轴唇形密封圈)	PD180x220x16	2				橡胶(rubber)	
B3	SKF	Bearing 轴承Z2232CC/W33	φ160xφ290x80	2	23.5	47			
B2	GB5783-86	Bolt(螺栓)M16x40	8.8S Dacro 达克罗	24					
B1		Grease fitting(油嘴) NPT1/4"	Sta.Ste. 不锈钢	2					

8	GTD01-9	Connect grease(接长油嘴)	assembly(附件)	1	2	2	Standard
7	GTD01-8	Steel(轴套)	Q235	1		2.5	Standard
6	GTD01-7A	Bearing pedestal(轴承座)	ZG35	2	39	78	Standard
5	J227A041302	Wheel(车轮)φ800	42CrMo	1		445	
4	GTD01-4	Through-hole cover 2(通盖2)	Q235	1		9.8	Standard
3	GTD01-3	Through-hole cover 1(通盖1)	Q235	2	7.8	15.6	Standard
2	GTD01-2	Blind-hole cover(盲盖)	Q235	1		10.9	Standard
1	J227A041301	Driving shaft(主动轴)	45	1		120	


NO.	SUB-NO. or STDD	NAME & SIZE	MTRL or STYLE	QTY/each	total	WEIGHT	NOTE
PROJECT:		DESIGN STAGE:		SCALE:		1:6	
ITEM NAME:		DRAW NO:		PROJ.			
Driving shaft assembly 主动轴轴装装配		J227A0413		Assembly(附件)			
ZPMC	DSGN	TRAC	APP.	SET/CRANE	20x735		
	DRAW	CHK	VER.	WEIGHT			

*Note - ZPMC Engineering to verify dimensions, component updates, and comments in red.

Revised

01/19/2024 11:42:19 AM


Rev. No.	description	date	sign
01		2006.1.13	gushenqian
	As-built drawing	07.2007	

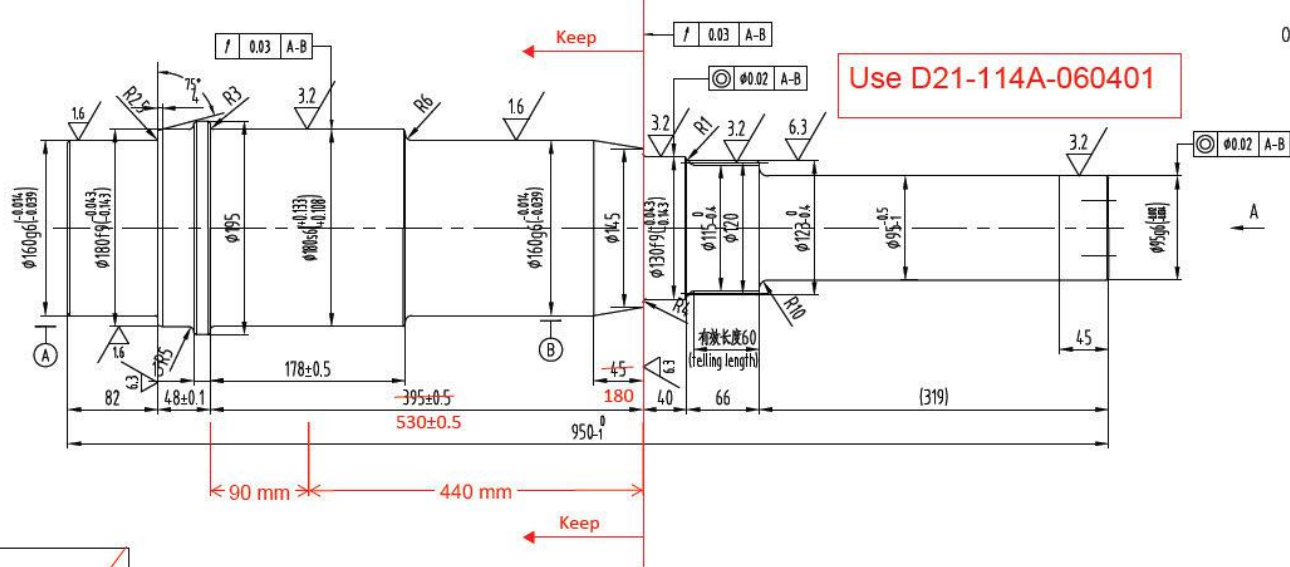

Others(其余) 12.5

Use D21-114A-060401

外花键参数 Spline main data		
Metric Module 模数	m	3
Teeth number 齿数	Z	40
Pressure Angel 分度圆压力角	α	30°
Accuracy Grade 精度等级	6h (GB3478.1-83)	
Test Item 检验项目	Tolerance Value 公差值	
Total Accumulated Pitch Variation 周节累积误差	Fp	0.081
Tooth Profile Tolerance 齿形公差	Ff	0.043
Tooth Alignment Tolerance 齿向公差	F β	0.017
Maximum of Tooth Thickness 作用齿厚最大值	Svmax	4.712
Minimum of acture Tooth Thickness 实际齿厚最小值	Smin	4.578
Minimum of Tooth Thickness 作用齿厚最小值	Svmin	4.634
Maximum of acture Tooth Thickness 实际齿厚最大值	Smax	4.656

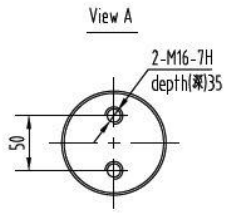

- Technical Requirement
1. Original material to be checked physically and chemically.
 2. Quenching and tempering: HB280-320.
 3. Unmarked chamfer 2x45°.

- 技术要求
1. 原材料需作物理和化学检查,并报告。
 2. 调质处理: HB280-320。
 3. 未注倒角均为2x45°。



NO.	SUB-NO. or STDD	NAME & SIZE	MTRL or STYLE	Q'TY/SET	SET*WEIGHT	SCALE
	J227A04.1301	Driving shaft(主动轴)	35CrMo	20	20x120	1:4
ZPMC	DRAW		TECH.		TRACE	
	CHCK		STDD		CHCK	

*Note - ZPMC Engineering to verify dimensions, component updates, and comments in red.

Revised
01/19/2024 11:42:19 AM

表序号
S/N

Rev. No.	Description	Date	Sign
1		1.30.2019	Xu Biao
2		04.23.2019	Xu Biao

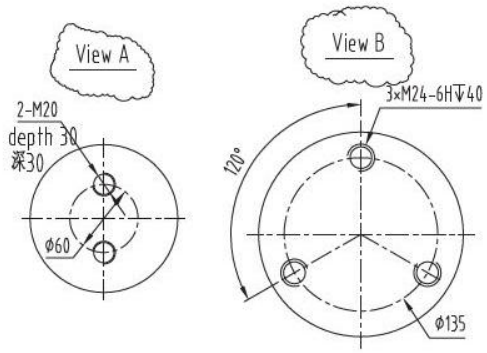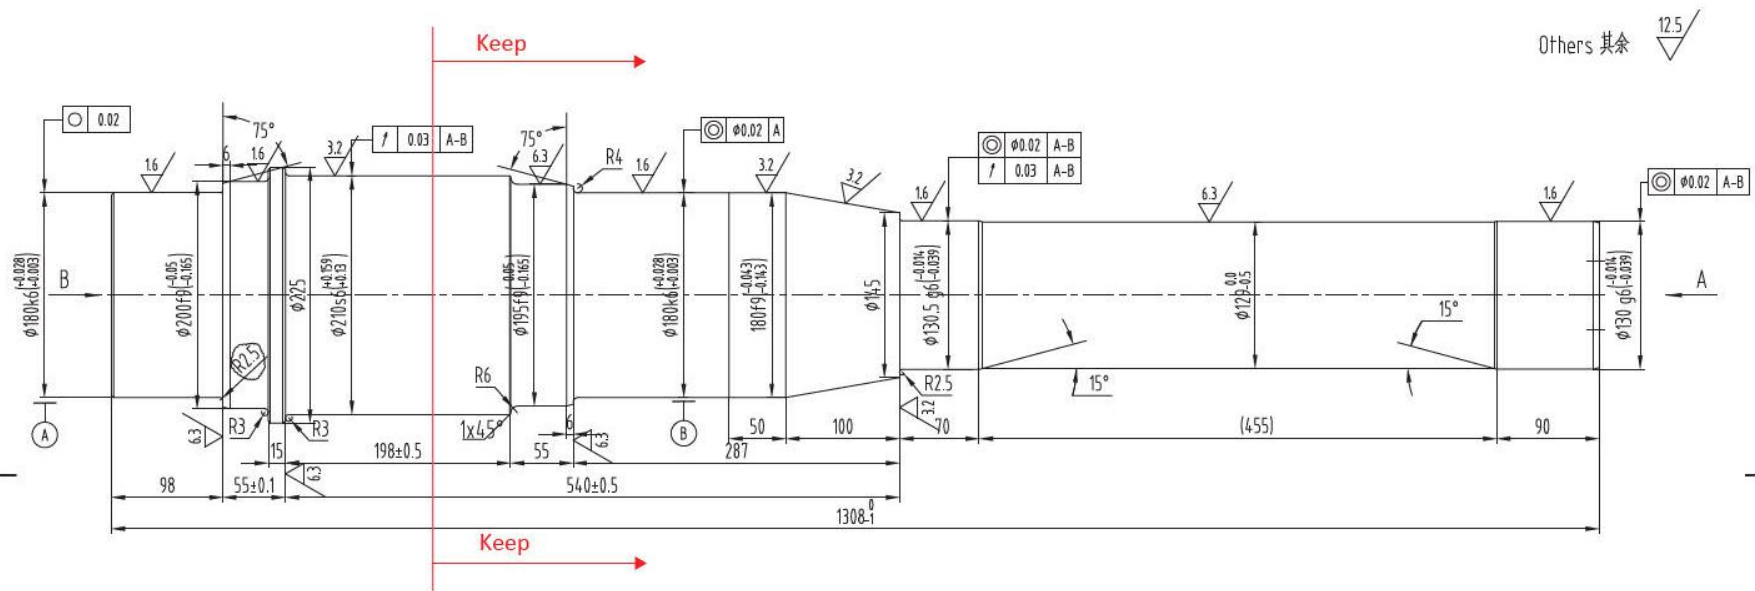








***Note - ZPMC Engineering to verify dimensions, component updates, and comments in red.**

- Technical Requirement
- 1.The material should be UT tested.
 - 2.Hardening and tempering: HB 280~320
 - 3.Unmarked chamfer 2x45°.

- 技术条件
- 1.原材料需作UT探伤检查.
 - 2.调质处理: HB 280~320
 - 3.未注倒角均为2x45°.

Revised
01/19/2024 11:42:19 AM

序号 NO.	图号或标准 SUB NO. OR STDD	版本 REV	名称&规格 NAME&SIZE	材质 MTRL	数量 QTY	单重 UNIT WT	199.2	199.2	备注 NOTE
1			轴件 φ225 l=1308 Forging	35CrMo	1	199.20	199.2		'' Δ
设计/DSGN			日期/DATE			校核/CHK			
材料/MTRL			重量/DRAWING NAME			比例/SCALE			
35CrMo			主动轴 driving shaft			1:4			
重量/WT(kg)			图号/DRAWING NO.			版本/REV			
199.2			D21-114A-060401			图幅/SIZE			
修改/Sup			ZPMC 上海振华重工			页号/PAGE			
						A3			
						1/1			

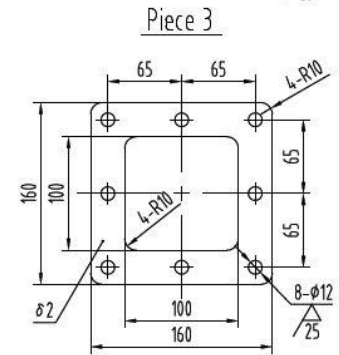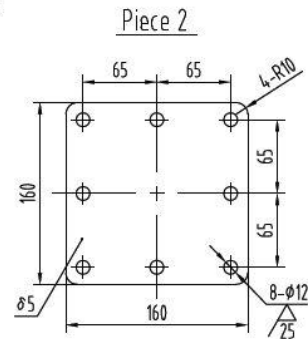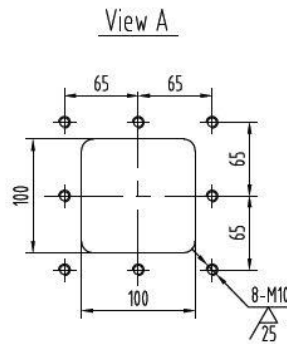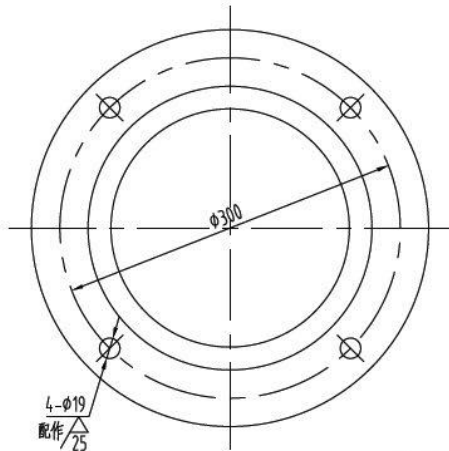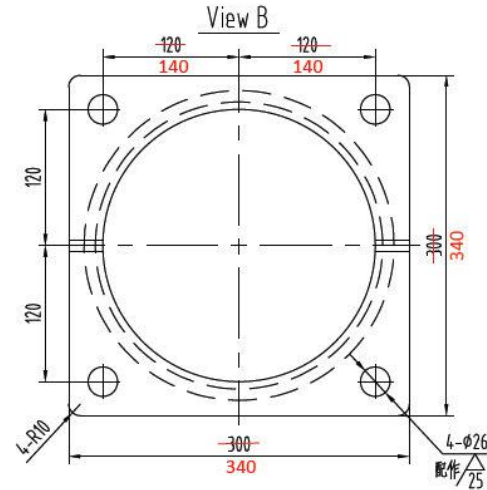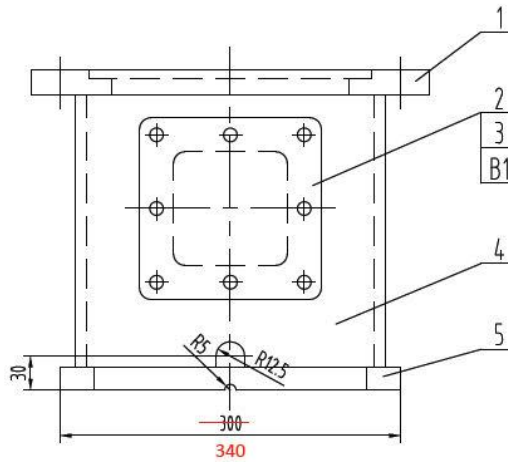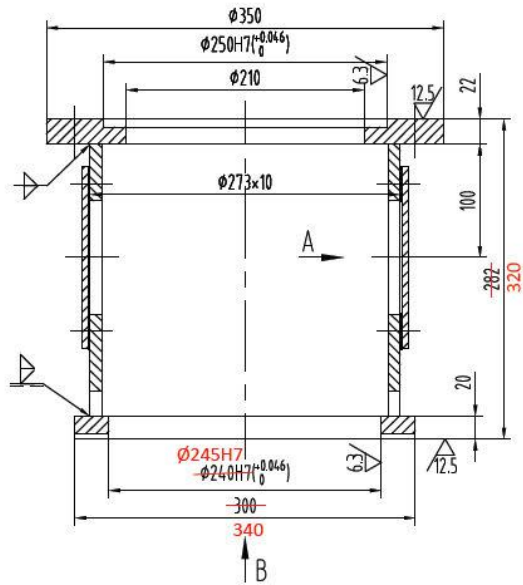



B1	GB5783-86	Bolt 螺栓M10×20	Sta. Ste. 不锈钢	16		
5		(-20)×300×300	A709-50-2	1	6.7	
4		φ273×10-240	20	1	16	
3		-2×160×160	Rubber 橡胶	2		
2		-5×160×160	Q235	2	1	2
1		(-22)×φ350/φ210	A709-50-2	1		9.8
NO.	SUB-NO. or STDD	NAME & SIZE	MTRL or STYLE	Q'TY/SET	SET*WEIGHT	SCALE
	J227A0415	Flange 联接法兰	welded 焊接件	20	20×35	1:4
ZPMC	DRAW		TECH.		TRACE	
	CHCK		STDD		CHCK	

注: 安装M10的螺栓时, 在螺纹表面涂乐泰胶防松。
It shall be sprayed anti seize compound on the surface of bolt M10.

*Note - ZPMC Engineering to verify dimensions, component updates, and comments in red.

Revised

01/19/2024 11:42:19 AM

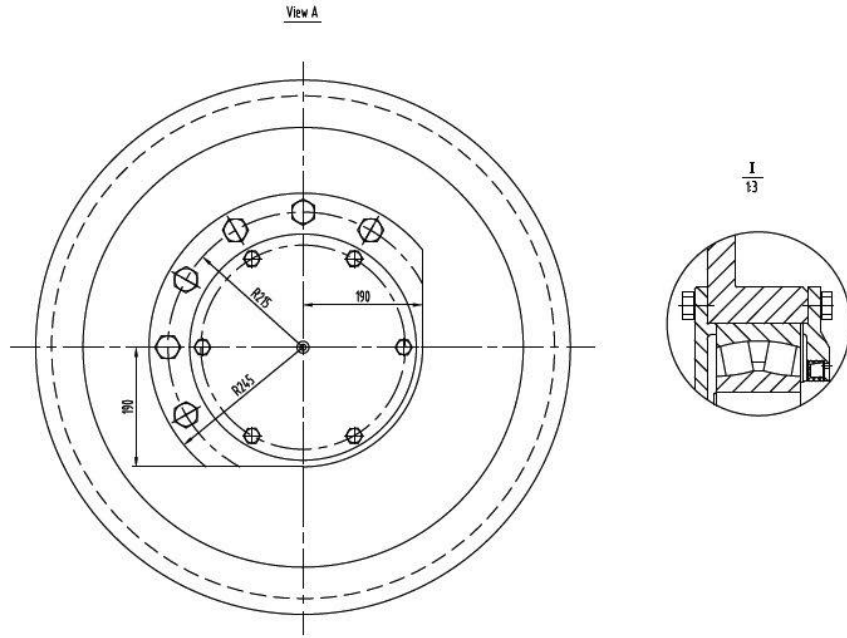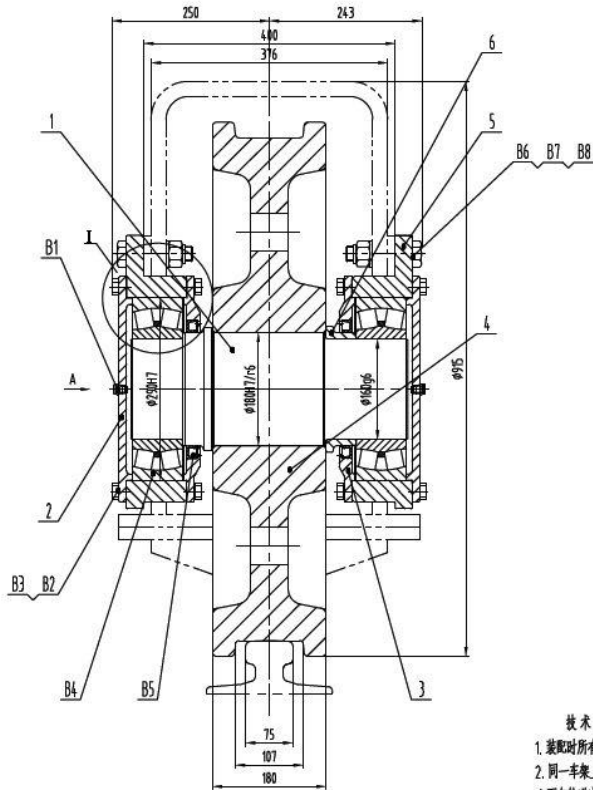

技术要求

1. 装配时所有轴承内均应加满润滑脂, 装配完毕走轮必须跑合。
2. 同一车架上的车轮精度应符合FEM规范, 同一轨道的车轮中心面与轨道中心线偏差不得超过±1mm。
3. 端盖螺栓M16的预紧力控制在3500kg以内, 预紧力矩为8kgm, 与车架连接螺栓M24的预紧力为15500kg, 预紧力矩为71kgm。(扭矩系数0.145)
4. 安装M16的螺栓时, 在螺纹表面涂防锈胶。

Technical Requirement

1. During assembly all bearing should be filled with appropriate grease, wheel running should be done.
2. Installing accuracy of the wheels on the same bogie is to conform to FEM Specification. Misalignment between wheel centers plane rolling on the same rail track and centreline of the rail should be not exceed ±1mm.
3. The M16 bolt pre-tension force is 3500kg, the torque is 8kgm. The M24 bolt pre-tension force is 15500kg, the torque is 71kgm.
4. It shall be sprayed anti seize compound on the surface of bolt M16.





B7	GB889-86	Nut(螺母)M24	8S Dacro 达克罗	12				
B6	GB5782-86	Bolt(螺栓)M24x110	8.8S Dacro 达克罗	12				
B5	GB95-85	Washer(双耳止动垫圈) 24	Dacro 达克罗	12				
B4	HG64-692-67	Seal(旋转轴唇形密封圈)	PD180x220x16	2				
B3	SKF	Bearing(轴承)22232 CC/W33	φ160xφ290x80	2	23.5	47		
B2	GB5783-86	Bolt(螺栓)M16x40	8.8S Dacro 达克罗	24				
B1		Grease fitting(油嘴) NPT1/4"	She.S1a 不锈钢	2				
6	GTD01-8	Sleeve(轴套)	Q235	1	2.5	2.5	Standard	
5	GTD01-7A	Bearing pedestal(轴承盖)	ZG35	2	39	78	Standard	
4	J227A041302	Wheel(车轮)φ800	42CrMo	1	445	445	Borrow	
3	GTD01-3	Through-cover(遮盖1)	Q235	2	7.8	15.6	Standard	
2	GTD01-2	Blind-cover(网盖)	Q235	2	10.9	21.8	Standard	
1	GTD01-6	Driven shaft(从动轴)	45	1	85	85	Standard	
NO.	SUB-NO. or STDD	NAME & SIZE	MTRL or STYLE	QTY/each	each	total	NOTE	
PROJECT:			DESIGN STAGE:	SCALE:		1:5		
ITEM NAME: Driven shaft assembly(从动车轴装配)			DRAW NO:	J227A0418			PROJ.	
ZPMC	DSGN		TRACE		APP.	Assembly(集料)		
	DRAW		CHK		SET/CRANE	20		
	CHK		VER.		WEIGHT	20~700		

Revised

01/19/2024 11:42:19 AM

Rev. No.	description	date	sign
01		2005.12.14	gushenqian
	As-built drawing	07.2007	

Others(其余) $\sqrt{12.5}$

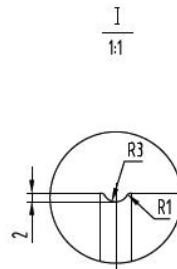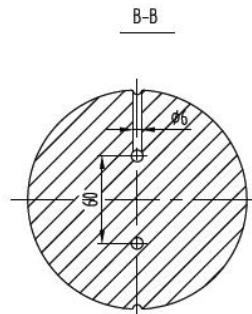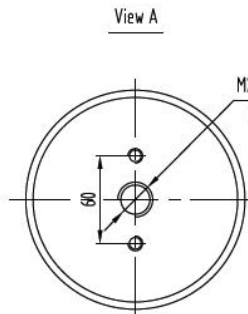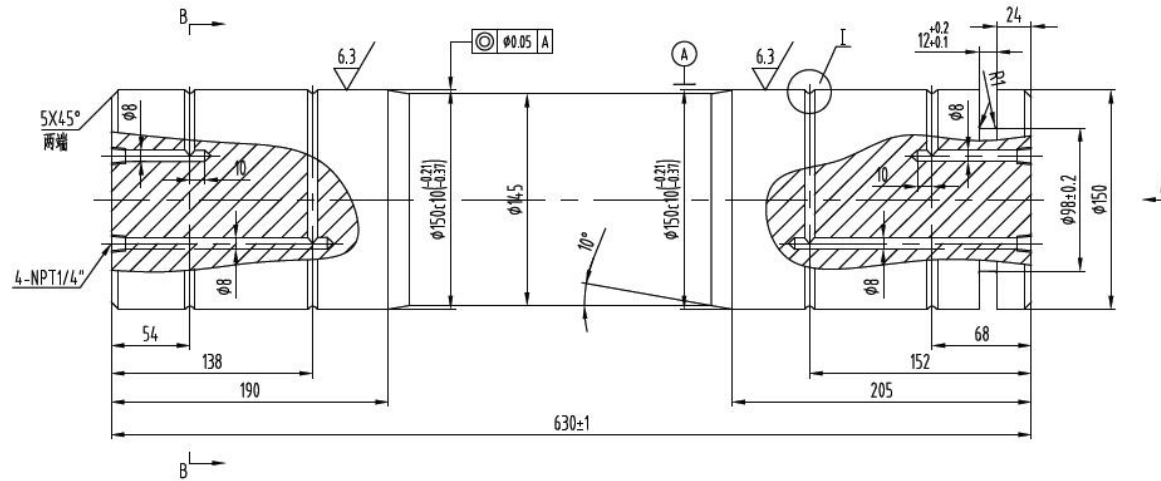


- Technical Requirement
1. Quenching and tempering: HB280~320.
 2. Original material to be checked physically and chemically.

- 技术要求
1. 调质: HB280~320.
 2. 原材料需作物理和化学检查,并报告.

NO.	SUB-NO. or STDD	NAME & SIZE	MTRL or STYLE	Q'TY/SET	SET*WEIGHT	SCALE
	J227A0419	Shaft(轴) $\phi 150$	35CrMo	16	16x85	1:3
ZPMC	DRAW		TECH.		TRACE	
	CHCK		STDD		CHCK	

Revised
01/19/2024 11:42:19 AM

All(全部) $\frac{25}{\surd}$

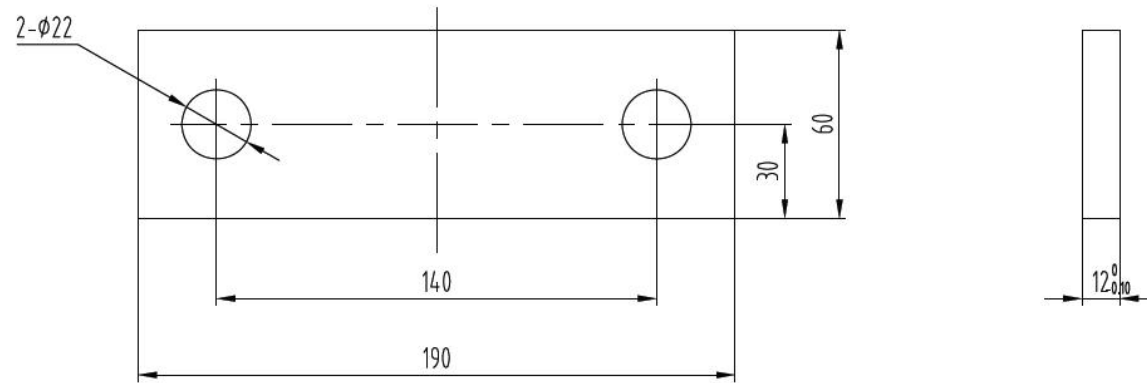


Breaking sharp corner
注: 棱边倒角1X45°.

NO.	SUB-NO. or STDD	NAME & SIZE	MTRL or STYLE	Q'TY/SET	SET*WEIGHT	SCALE
	J227A0420	Shaft end plate(卡轴板)	Q235	16	16x1.1	1:2
ZPMC	DRAW		TECH.		TRACE	
	CHCK		STDD		CHCK	

Revised

01/19/2024 11:42:19 AM



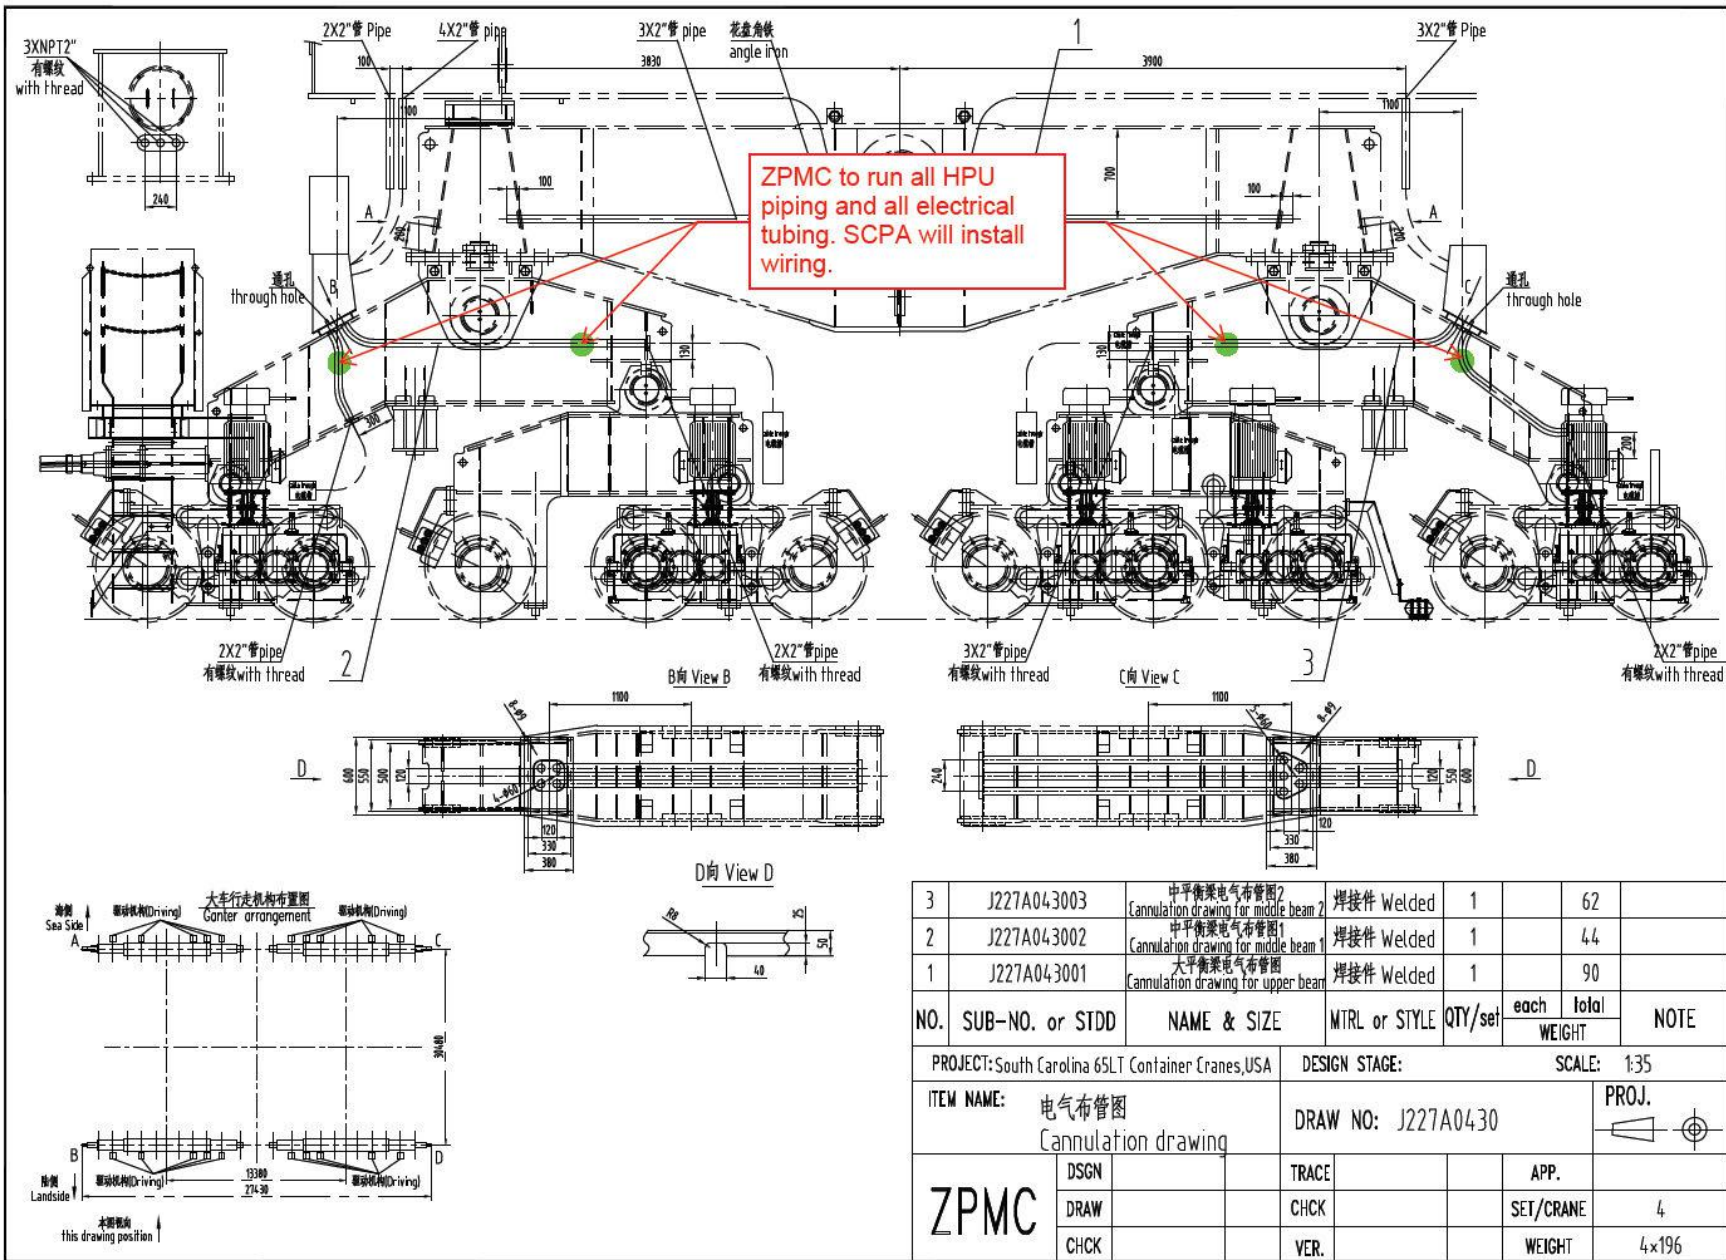










3	J227A043003	中平衡梁电气布管图2 Cancellation drawing for middle beam 2	焊接件 Welded	1		62	
2	J227A043002	中平衡梁电气布管图1 Cancellation drawing for middle beam 1	焊接件 Welded	1		44	
1	J227A043001	大平平衡梁电气布管图 Cancellation drawing for upper beam	焊接件 Welded	1		90	
NO.	SUB-NO. or STDD	NAME & SIZE	MTRL or STYLE	QTY/set	each	total	NOTE
					WEIGHT		
PROJECT: South Carolina 65LT Container Cranes, USA			DESIGN STAGE:		SCALE: 1:35		
ITEM NAME: 电气布管图 Cancellation drawing			DRAW NO: J227A0430		PROJ.		
ZPMC	DSGN		TRACE		APP.		
	DRAW		CHCK		SET/CRANE	4	
	CHK		VER.		WEIGHT	4x196	

Revised

01/19/2024 11:42:19 AM

Rev. No.	description	date	sign
02		12.15.2005	Mao
03		01.15.2006	Mao

Rated Load under Spreader		Twin Twenty		65LT			
Single Container				50LT			
Rated Load under Hook		80LT					
Speeds	Main Hoist	Lifted Load(LT)	65	50	40	25	with empty spreader
		Speed(m/min)	60	70	85	115	170
Main Trolley		240m/min					
Gantry		60m/min					
Boom Hoisting Time		≤5 min					
Motors	Main Hoist	2x373 Kw	635/1800 rpm	IP55			
	Main Trolley	400 Kw	1750 rpm	IP55			
	Gantry	20x24 Kw	1750 rpm	IP55			
	Boom Hoist	300 Kw	1750 rpm	IP55			
Rail Gage	30.48m	Trim	±3.5'				
Out reach	60m	List	±5'				
Back reach	22.86m	Skew	±3'				
Height of lift	Above rail	35.05m					
	Total	50.25m					
Power	4.16kV, 3ø, 60Hz	Electical Capacity					

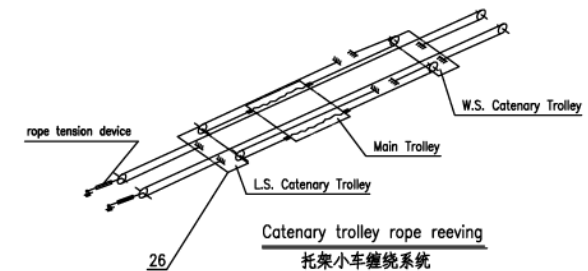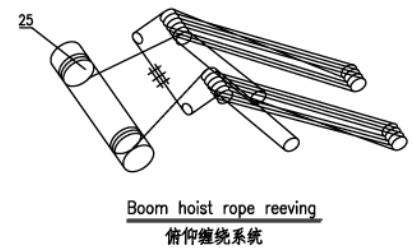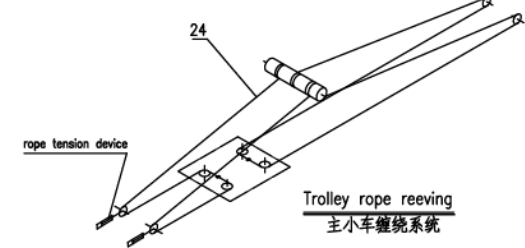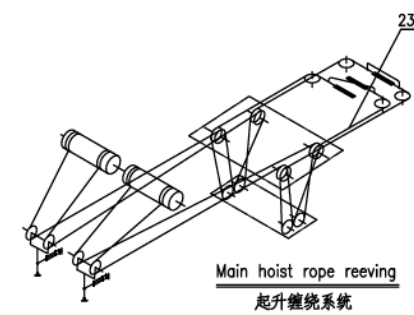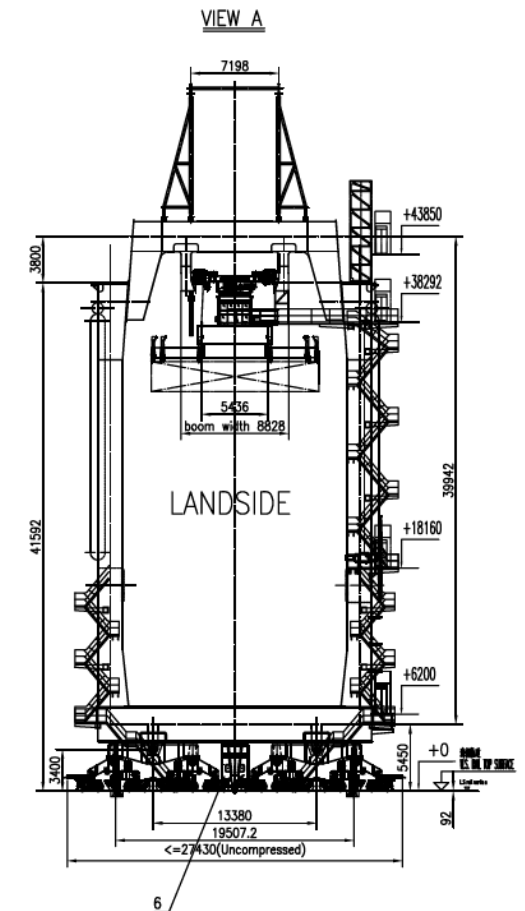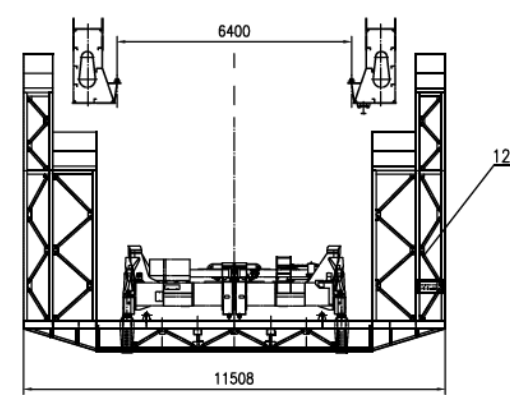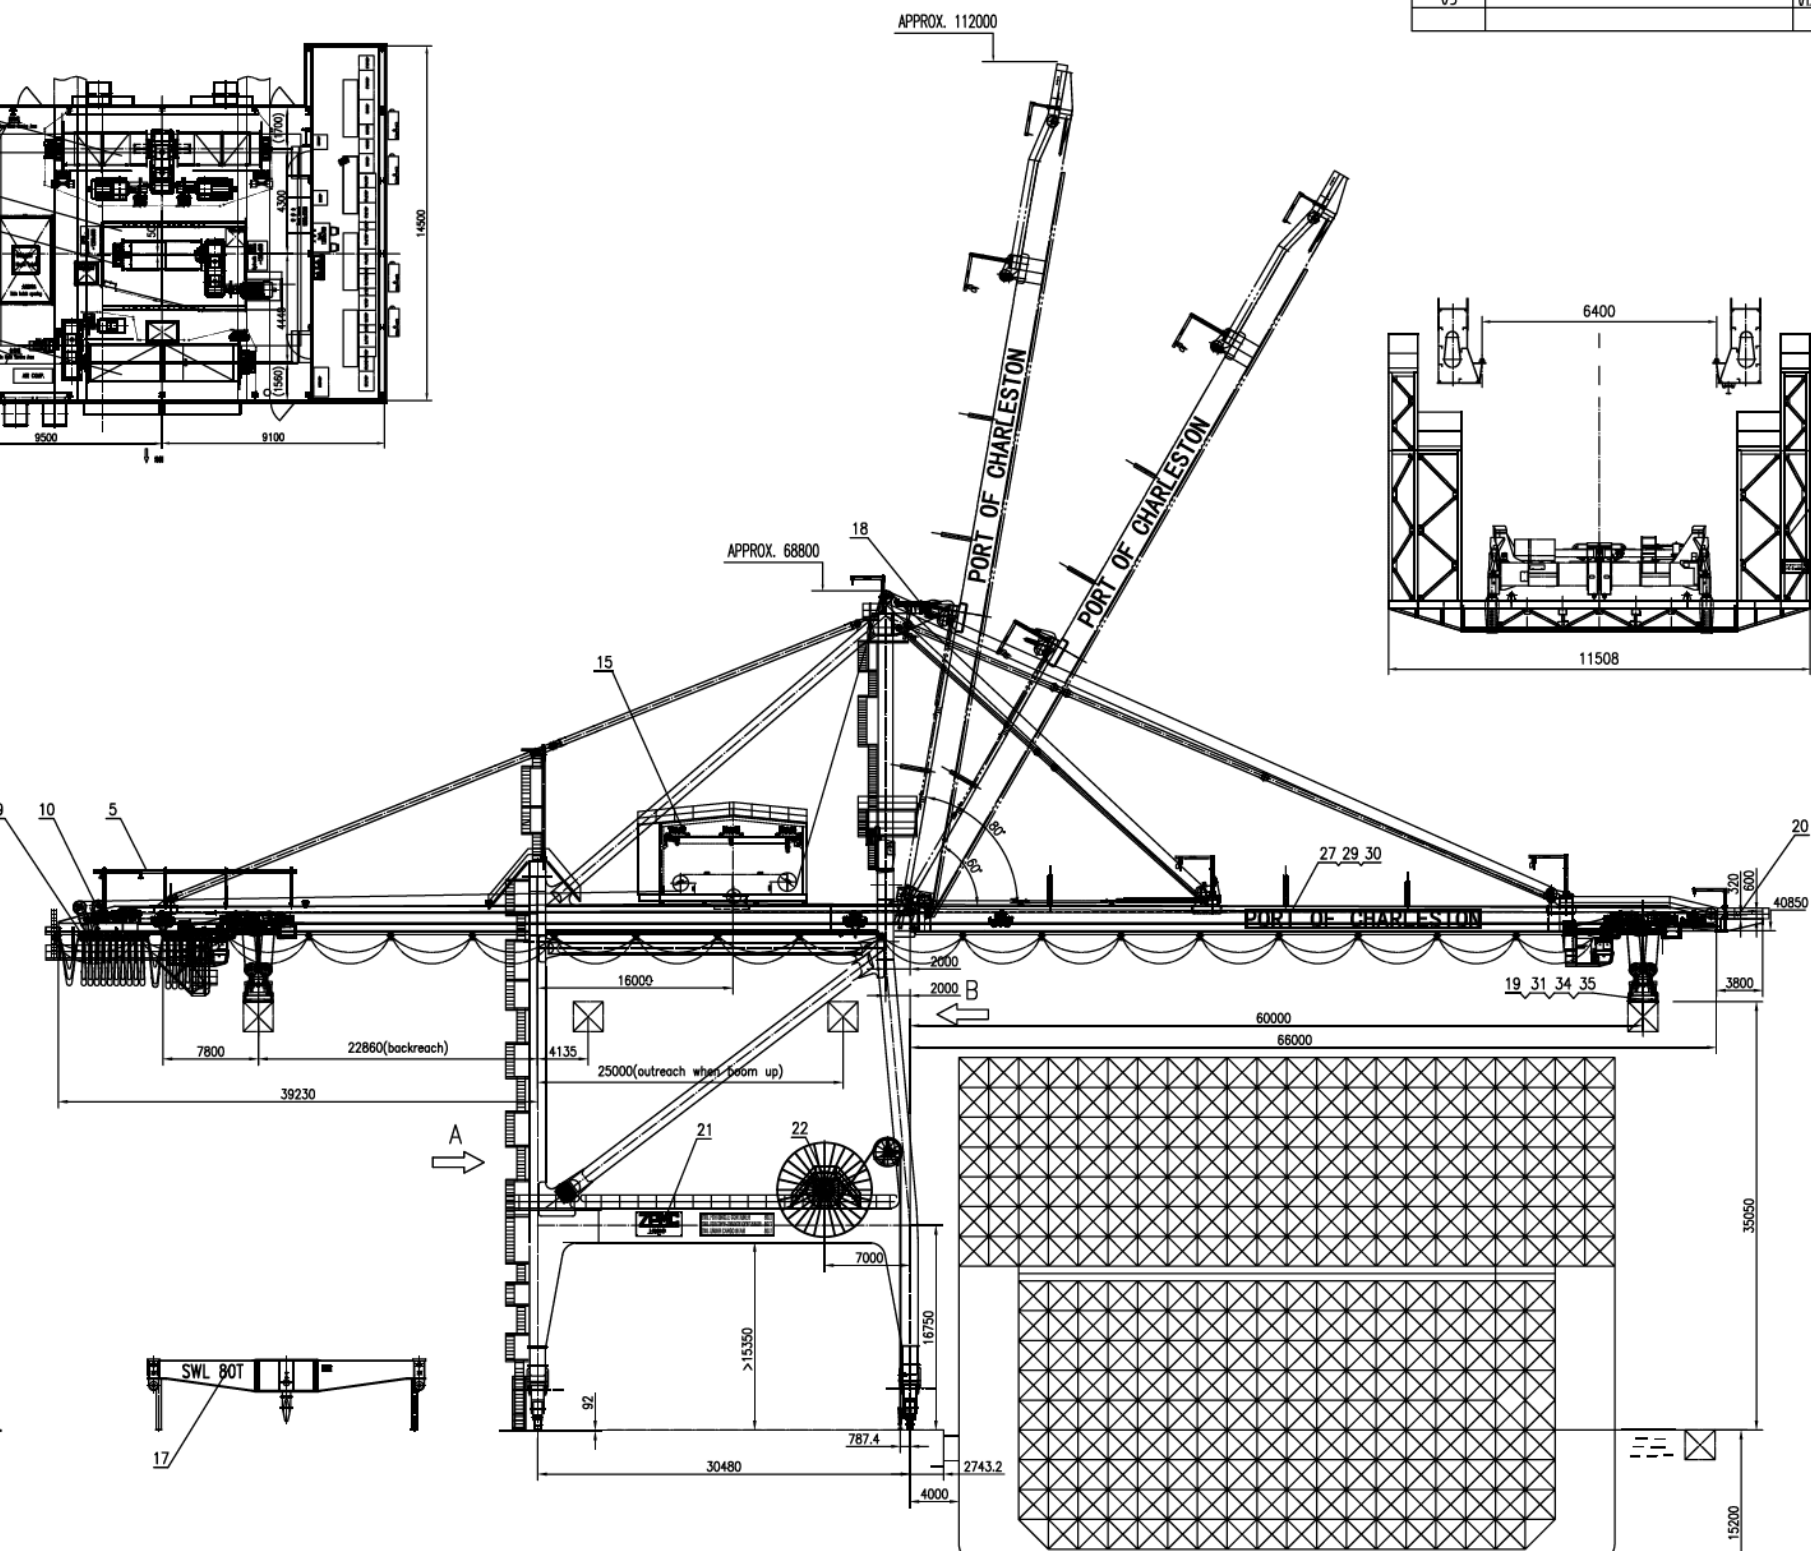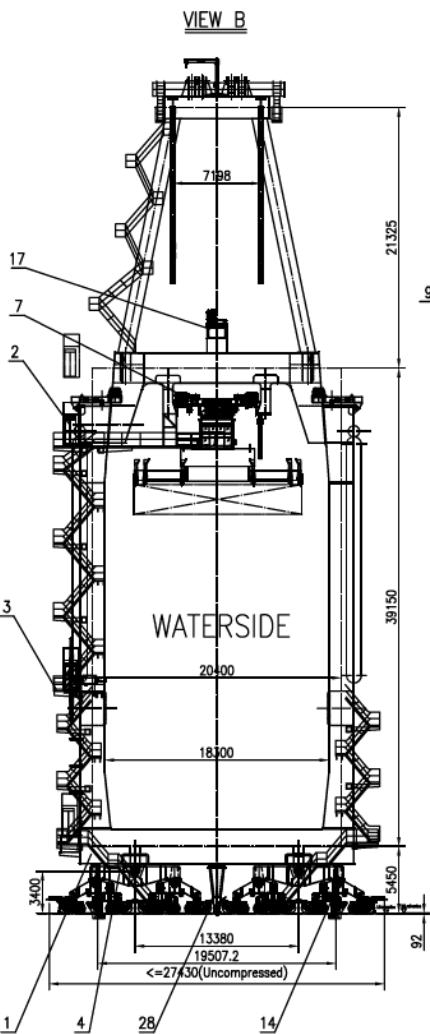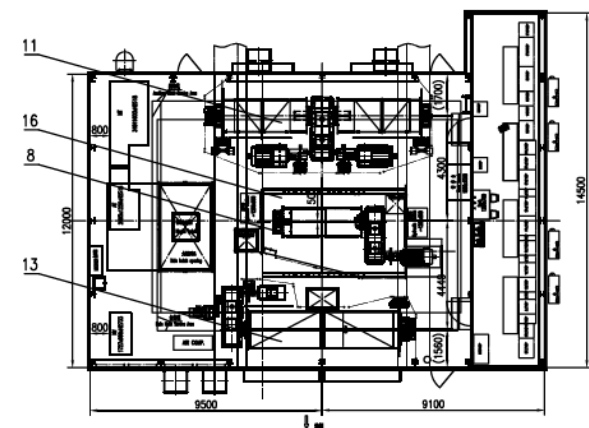

NO.	SUB-NO. or STDD	NAME & SIZE	MTRL or STYLE	QTY/set	each total WEIGHT	NOTE
PROJECT: North Charleston 65LT Container Cranes, SC, USA		DESIGN STAGE:		SCALE: 1:250		
ITEM NAME: 总布置图		DRAW NO: J227A00		PROJ.		
GENERAL ARRANGEMENT						
ZPMC	DSGN		TRACE		APP.	
	DRAW		CHK		Q'TY/SET	
	CHK		VER.		SET/CRANE	

SUBSIDIARY LIST

* The quantity and weight of this list is to one set

1 set/crane, _____ kg/set, _____ kg/crane PAGE: 1/2

PROJECT NAME or CODE: North Charleston 65LT Container Cranes		SUB-PART NAME: 总布置图 GENERAL ARRANGEMENT		SUB DRAW NO: J227A00			
NO.	SUB-NO. or STDD	NAME & SIZE	MTRL or STYLE	QTY/SET	PIECE WGHT	TOTAL WGHT	
1	J227A0100	钢结构	Structure	1			1
2	J227A0200	电梯	Manlift arrangement	1			2
3	J227A0300	梯子,走道,平台	Stairs, Platforms & walkways	1			3
4	J227A0400	大车行走机构	Gantry	4			4
5	J227A0500	室外维修行车	Outdoors maintenance lift	1			5
6	J227A0600	陆侧锚定及理货室	Landside anchor-checker's cab	1			6
7	J227A0700	主小车总成	Trolley arrangement	1			7
8	J227A0800	主小车驱动机构	Trolley Drive	1			8
9	J227A0900	电缆托令系统	Festoon System	1			9
10	J227A1000	防挂舱装置	Snag	1			10
11	J227A1100	主起升机构	Main Hoist Drive	1			11
12	J227A1200	大梁维修平台	Service Platform	1			12
13	J227A1300	俯仰机构	Boom hoist drive	1			13
14	J227A1400	防风拉索装置	Tie down system	1			14
15	J227A1500	机器房	Machinery house	1			15
16	J227A1502	换绳装置	Rereeving system	1			16
17	J227A1600	80LT吊钩横梁	Cargo Beam	2/4			17
18	J227A1700	安全钩	Boom Latch	1			18
19	J227A1800	吊具上架	Headblock	1			19
20	J227A1900	头部倾转装置	Trim.list &skew device	1			20
21	J227A2000	铭牌布置	Nameplate arrangement	1			21
22	J227A2100	大车电缆卷筒	HV cable reel device	1			22
ZPMC		DSGN	TECH	MTRL			
		CHCK	STDD	CHCK			

SUBSIDIARY LIST

* The quantity and weight of this list is to one set

1 set/crane, _____ kg/set, _____ kg/crane PAGE: 2/2

PROJECT NAME or CODE: North Charleston 65LT Container Cranes		SUB-PART NAME: 总布置图 GENERAL ARRANGEMENT		SUB DRAW NO: J227A00			
NO.	SUB-NO. or STDD	NAME & SIZE	MTRL or STYLE	QTY/SET	PIECE WGHT	TOTAL WGHT	
1	J227A2200	主起升缠绕系统	Main hoist Rope Reeving	1			1
2	J227A2300	主小车缠绕系统	Main trolley rope reeving	1			2
3	J227A2400	俯仰缠绕系统	Boom hoist rope reeving	1			3
4	J227A2500	托架小车缠绕系统	Catenary trolley rope reeving	1			4
5	J227A2600	整机限位布置	Limit switch	1			5
6	J227A2700	海侧锚定	Seaside Anchor	1			6
7	J227A2800	润滑系统	Lubrication system	1			7
8	J227A2900	空压机系统	Air compressor system	1			8
9	J227A3000	试重水箱	Test Tank	2/4			9
10	J227A3100	俯仰室	Boom operate station	1			10
11	J227AH	液压系统	Hydraulic system	1			11
12	J227AE	电气系统	Electrical system	1			12
13	35	RAM 吊具	RAM Spreader	1			13
14	36	RAM 超高架	Overheight Spreader	1/4			14
15							15
16							16
17							17
18							18
19							19
20							20
21							21
22							22
ZPMC		DSGN	TECH	MTRL			
		CHCK	STDD	CHCK			