



BRIDGE PROTECTION SYSTEMS ATTACHMENT

MDTA 2021 Underwater Inspection Report

Baltimore, MD

DCA24MM031

(106 pages)



MARYLAND TRANSPORTATION AUTHORITY

BIN: BCZ472001

Date: 3/29/2021

MD 695

OVER PATAPSCO RIVER

MARYLAND TRANSPORTATION AUTHORITY

FSK-Francis Scott Key Bridge

2021 Biennial Underwater Inspection Report

FOR

STRUCTURE No. BCZ472001

MD 695

OVER PATAPSCO RIVER



Firm Performing the inspection:	Marine Solutions, Inc.		
Inspection Team Leader	Matt Owings (TL)	ASIR E-Signature	49365
QC Engineer:	Amanda Schindhelm (QC)	ASIR E-Signature	27713
	Name	Signature	PE Number

Reports denoted with an "ASIR E-Signature" in the signature column have been reviewed and approved by the Inspection Team Leader and QC Engineer denoted in the name column.

LOCATION MAP
STRUCTURE No. BCZ472001
LOCATION: IS 695 OVER PATAPSCO RIVER

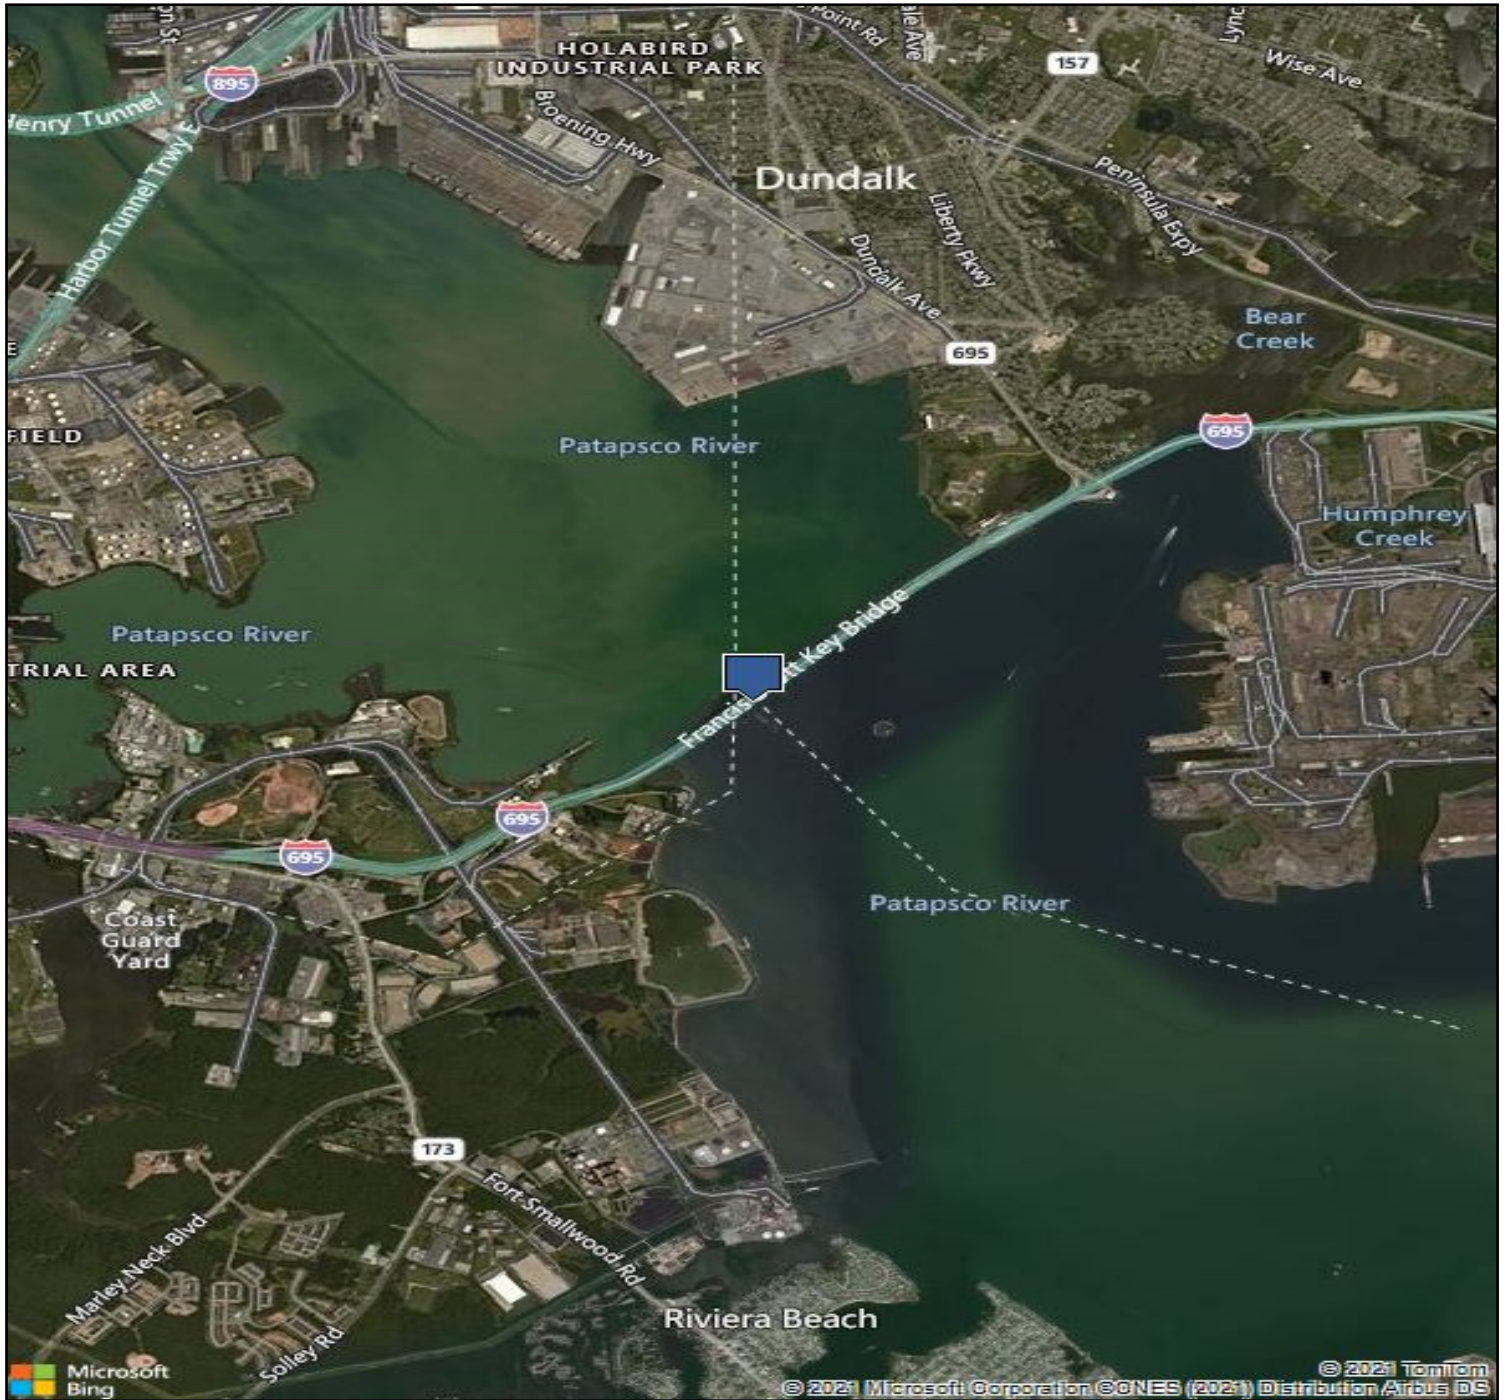




TABLE OF CONTENTS

2021 BRIDGE - UNDERWATER INSPECTION REPORT STRUCTURE No. BCZ472001 FOR MD 695 OVER PATAPSCO RIVER

1. Cover Sheet
2. Location Map
3. General Information
 - a. General Notes
 - b. Executive Summary
 - c. Bridge Description
 - d. Inventory
 - e. Studies and Recommendations
 - f. General Plan and Elevation
 - g. Identification of Fracture Critical Members and Fatigue Sensitive Details
 - h. General Photos
4. Letters of Concern
5. Inspection Findings
 - a. MDTA Repair Category Summary
 - b. Load Rating Summary and Requirement
 - c. Major Rehabilitation/ System Preservation Recommendation Summary
 - d. Inspection Dates and Access
 - e. Inaccessible Locations and Recommendations
 - f. Condition Rating Summary
 - g. Element Data
 - h. Condition Description Notes and Repair Recommendations
 - i. Photo Sheets
6. Inspection Documents
 - a. Vertical Clearance Measurements
 - b. Sounding Current Data (if applicable)
 - c. Sounding Base-year Data
 - d. Channel Profiles (if applicable)
 - e. NDT Schedules
 - f. Monitoring Data
 - g. Test Results
 - h. Miscellaneous Sketches
 - i. Other
7. Inventory
 - a. SIA Forms



GENERAL INFORMATION



MARYLAND TRANSPORTATION AUTHORITY

BIN: **BCZ472001**

Date: **03/29/2021**

MD 695

OVER PATAPSCO RIVER

3. General Information

- a. General Notes
- b. Executive Summary
- c. Bridge Description
- d. Inventory
- e. Studies and Recommendations
- f. General Plan and Elevation
- g. Underwater As-Built plans
- h. General Photos



MARYLAND TRANSPORTATION AUTHORITY

BIN: **BCZ472001**

Date: **03/29/2021**

MD 695

OVER PATAPSCO RIVER

GENERAL NOTES

MDTA Priority Repair Codes:

E - Emergency: Items in this category represent conditions that affect either the integrity of the structure or public safety. MDTA is to be notified immediately upon finding the defect. Follow-up is required immediately after notification by the inspection team to determine course of action. Items of this category will be addressed immediately. Subsequently, they will be reclassified to another repair code prior to report completion.

1 - First Priority: Items in this category are structural deficiencies on primary, load carrying members and safety deficiencies on other members that are not emergencies but require prompt attention. These defects should be among the first items to receive follow-up. First Priority items typically receive engineering evaluation with consideration for repairs within one year of reporting.

2 - High Priority: Items in this category are moderate deficiencies that do not pose any immediate concerns. These are nonstructural deficiencies on primary, load carrying members or structural deficiencies on secondary members and that do not present safety concerns. Typically, these deficiencies are repaired by system preservation contracts to avoid worsening to First Priority or the development of other First Priority deficiencies but may be deferred depending on available funding. Defects should be monitored and verified for condition during future inspections.

3 - Medium Priority: Items in this category are not serious deficiencies. These defects are primarily serviceability-related issues that are less likely to worsen significantly during the next several inspection cycles. Typically, these deficiencies are repaired by system preservation contracts, but may be deferred depending on available funding. Follow-up should be made after the high priority items and should be monitored in future inspections.

Condition Rating Definitions:

The following is the NBI general condition rating scale for Items 58, 59, and 60. This scale shall be used as a guide in conjunction with direction included in Chapter 4.1 of the MDTA Facilities Inspection Manual:

N - Not Applicable

9 - Excellent Condition

8 - Very Good Condition - no problems noted.

7 - Good Condition - some minor problems.

6 - Satisfactory Condition - structural elements show some minor deterioration.

5 - Fair Condition - all primary structural elements are sound but may have minor section loss, cracking, spalling, or scour.

4 - Poor Condition - advanced section loss, deterioration, spalling, or scour.

3 - Serious Condition - loss of section, deterioration, spalling, or scour have seriously affected primary structural components. Local failures are possible. Fatigue cracks in steel or shear cracks in concrete may be present.

2 - Critical Condition - advanced deterioration of primary structural elements. Fatigue cracks in steel or shear cracks in concrete may be present or scour may have removed substructure support. Unless closely monitored it may be necessary to close the bridge until corrective action is taken.

1 - "Imminent" Failure Condition - major deterioration or section loss present in critical structural components, or obvious vertical or horizontal movement affecting structure stability. Bridge is closed to traffic but corrective action may put bridge back in light service.

0 - Failed Condition - out of service; beyond corrective action.



MARYLAND TRANSPORTATION AUTHORITY

BIN: **BCZ472001**

Date: **03/29/2021**

MD 695

OVER PATAPSCO RIVER

EXECUTIVE SUMMARY

A routine underwater inspection of Bridge BCZ472001 (Francis Scott Key Bridge) was performed by Marine Solutions, Inc. and completed between March 29 to April 8, 2021. The underwater inspection included a Level I (visual, tactile) inspection on all exposed portions of the submerged elements at each substructure unit, and a Level II (detailed inspection with partial cleaning) on approximately 25% of all exposed portions of the submerged elements. The underwater visibility during the inspection ranged from one to two feet. The dive team consisted of a 3-person OSHA-compliant certified dive crew experienced in underwater inspection and included a Maryland registered Professional Engineer. Diving operations were conducted from OLD BAY, a 28' work/dive vessel, using a Surface Supplied Air Two-Diver Station, providing constant communication with the diver for accurate recording of the inspection findings. Diving operations were in strict accordance with the United States Navy Dive Manual, Revision 7 (2016), OSHA, and the Association of Diving Contractors (ADC) Dive Safety Regulations. The inspection was performed in compliance with National Bridge Inspection Standards (NBIS) and Maryland Transportation Authority (MDTA) standards. Subsequent routine underwater bridge inspections should be performed every forty-eight months or at the discretion of the MDTA.

Overall, the submerged elements of Bridge BCZ472001 are in satisfactory condition (SI&A Condition Rating = 6).

The submerged portions of Piers 14 through 24 are in overall good condition. The steel protection plates at all the piers exhibit heavy to severe corrosion with up to 3/8" deep pitting and section loss near the waterline. The submerged concrete surfaces of all piers have moderate marine growth 1" to 2" thick, and minor honeycombing up to 1/8" deep. The concrete footings (exposed at all piers) exhibit random areas of shallow spalls and honeycombing along the edges. The sub-footings are partially exposed at Piers 17, 19, and 20 and exhibit honeycombing and minor spalling 3/4" to 1 1/2" deep on the vertical faces. A few of the piers have minor spalls and voids on the columns, footings, and sub-footings. The piers have numerous areas of epoxy coating failure throughout the concrete columns, diaphragm walls, and footings. Since the previous underwater inspection, epoxy-filled fiberglass jackets have been installed at Pier 24 at the waterline. It appears that epoxy paint has been applied to Piers 14, 15, 23, and 24 from the top of the steel protection plates to the top of the footing, however, the coating is failing above the waterline.

The fender system at Piers 17 and 18 and adjacent channel dolphins are in fair condition overall. The timber fender system has had numerous repairs since the previous inspection including new steel plates and vertical timber members. There are areas of minor impact damage to timber members at various locations around each of the piers. The dolphins typically exhibit severe scaling on the lower portions of the concrete caps with exposed and heavily corroded reinforcement. The steel sheeting below the caps has heavy to severe corrosion with areas of 100% section loss within the top 3'. There are voids in the exposed concrete within the perforations, most notably at Dolphins 3 and 4. Several of the rubber cylindrical fenders have been replaced since the previous inspection.

Overall, the channel is in good condition (SI&A Condition Rating = 7). The channel bottom consists of loose sand and mud, with penetrations typically ranging from 6" to 18" deep. The vertical exposure of the submerged substructure units has varied minimally since the previous underwater inspection. There has been less than 2'-0" of scour and/or aggradation when the current channel bottom is compared to the previous 2017 Underwater Inspection. A hydrographic survey was performed by Precision Measurements Inc. in March 2019. The results of the survey indicate the channel has not changed significantly since the previous survey in May 2015. There is general scour of approximately 1 foot in the vicinity of the piers as compared to the 2009 baseline. The drawings provided from the survey also indicate a migration of 2-4 feet of material from the upstream side of the piers to the downstream side. The minor changes within the channel bottom do not indicate a potential scour problem.

There are no elements with Condition Ratings of 4 or less.

There are no Priority 1 repair items.



MARYLAND TRANSPORTATION AUTHORITY

BIN: **BCZ472001**

Date: **03/29/2021**

MD 695

OVER PATAPSCO RIVER

BRIDGE DESCRIPTION

Bridge BCZ472001 (Francis Scott Key Bridge) is a thirty-seven (37) span structure that carries Interstate 695 over the Patapsco River. The bridge has an overall length of approximately 9,087'-0" between centerlines of bearings of the East and West Abutments and has an out-to-out width of 61'-2". The bridge is 56'-0" wide from curb-to-curb and carries four lanes of traffic. The East Approach consists of eighteen multi-beam plate girder spans, with twelve shorter/shallower spans over land and six longer/deeper spans over water. The West Approach consists of sixteen multi-beam plate girder spans, with thirteen shorter/shallower spans over land and three longer/deeper spans over water. Spans 17-19 comprise the three main through-truss spans that cross the primary navigation channel of the Patapsco River. The two side spans (Spans 17 and 19) are 720' long through-truss spans measured between centerlines of bearings, while the main span (Span 18 over the navigation channel) consists of a 1,200' long suspended deck arch truss span measured between centerlines of bearings.

The top surface of the reinforced concrete bridge deck has a raked finish. Stay-in-place metal forms are present in all spans.

The substructure consists of thirty-six reinforced concrete piers and two reinforced concrete abutments. The East Approach consists of three solid wall piers and fifteen two column rigid frame piers, while the West Approach is comprised of sixteen two-column rigid frame piers. Piers 17 and 18, which support the main span, are "Potomac" type rigid frame piers. All piers have reinforced solid concrete caps with up to two intermediate concrete struts depending on the height of the pier.

The bridge is not posted for any special load restrictions.



MARYLAND TRANSPORTATION AUTHORITY

BIN: **BCZ472001**

Date: **03/29/2021**

MD 695

OVER PATAPSCO RIVER

INVENTORY

To facilitate orientation, the bridge is assumed to travel on an east and west alignment and Patapsco River is assumed to flow from north to south. This orientation follows that of previous underwater inspection reports for this structure. The bridge substructure elements are inventoried from west to east and from left to right when looking east. Above water inspections for this structure assume the roadway is on a north and south alignment. Refer to the MDTA General Plan and Elevation and Pile Layout Plans for more detailed information regarding the layout.



MARYLAND TRANSPORTATION AUTHORITY

BIN: **BCZ472001**

Date: **03/29/2021**

MD 695






OVER PATAPSCO RIVER

STUDIES AND RECOMMENDATIONS

Underwater Inspection Summary: The submerged portions of Piers 14 through 24 are in overall good condition. The condition of the submerged elements has not changed significantly since the previous 2017 Underwater Inspection. Several elements of the fender system at Piers 17 and 18 have been replaced since the previous underwater inspection. In addition, jackets have been installed at Pier 24, and epoxy paint has been applied to Piers 14, 15, 23, and 24. The steel sheeting at the dolphins continues to degrade, with widespread severe corrosion at the waterline and areas of 100% section loss.

At this time, it is recommended to repair the minor spalls and voids on the columns, footings, and sub-footings. The steel plates at the piers should be replaced or repaired with protective jackets to prolong the life of the columns in the tidal zone. The open cracks on the concrete surfaces of the substructure should be repaired with epoxy. The previously noted voids along the subfooting of Pier 19 were not found, and presumably buried. These specific areas should be checked thoroughly during future inspections for changes in the channel bottom.

Channel: Overall, the channel is in good condition. A hydrographic survey was performed by Precision Measurements Inc. in March 2019. The results of the survey indicate the channel has not changed significantly since the previous survey in May 2015. There is general scour of approximately 1 foot in the vicinity of the piers as compared to the 2009 baseline. The drawings provided from the survey also indicate a migration of 2-4 feet of material from the upstream side of the piers to the downstream side. The minor changes within the channel bottom do not indicate a potential scour problem.

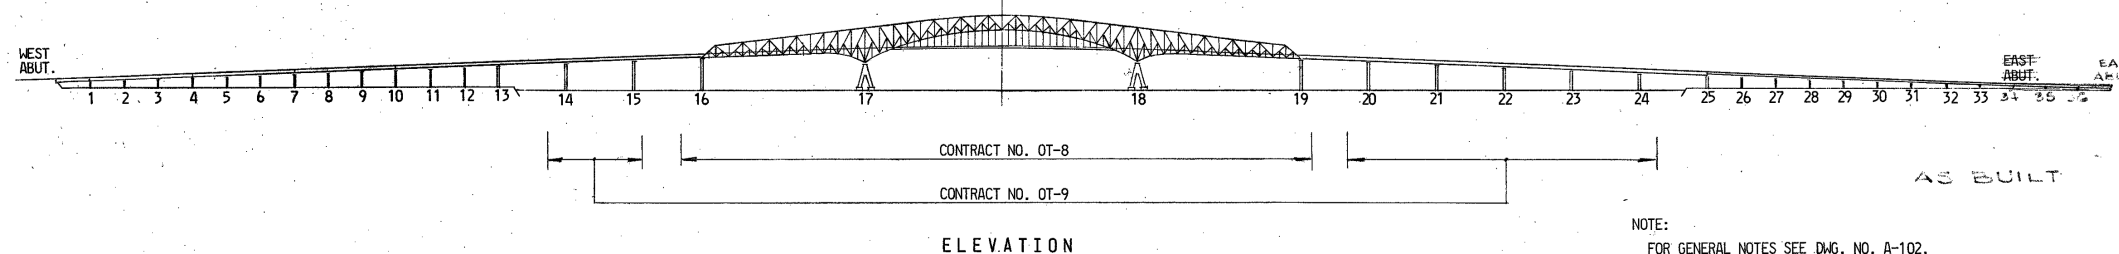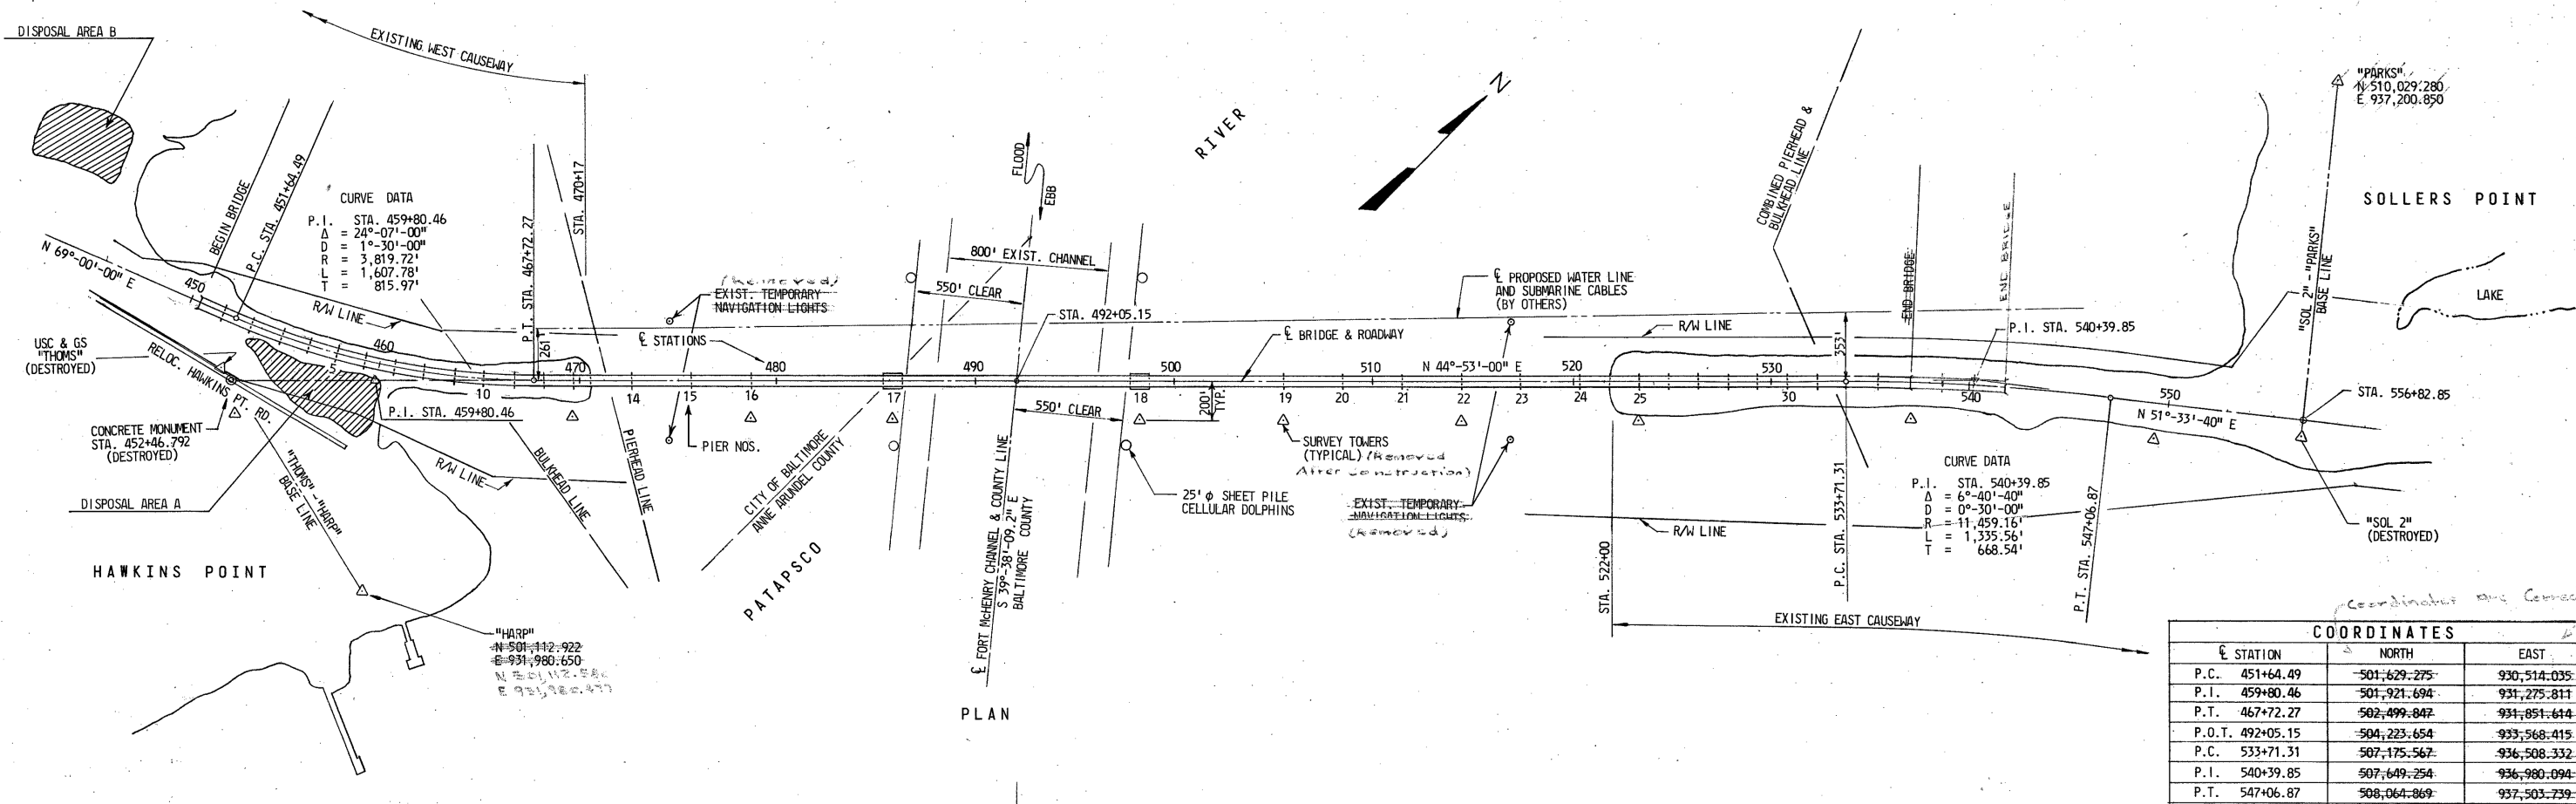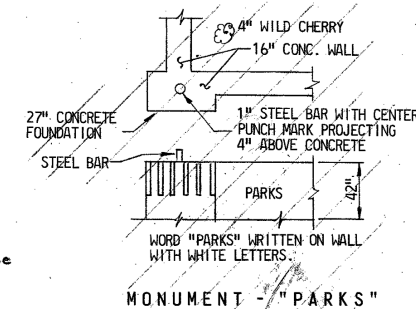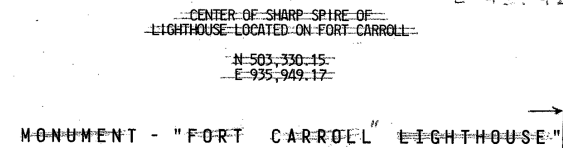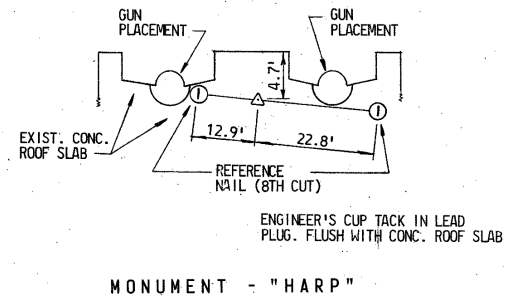


NOTE:
FOR GENERAL NOTES SEE DWG. NO. A-102.
Δ DENOTES SURVEY TOWERS. FINAL LOCATION WILL BE DETERMINED BY THE ENGINEER.


REVISIONS	STATE OF MARYLAND DEPARTMENT OF TRANSPORTATION STATE HIGHWAY ADMINISTRATION BALTIMORE, MD. BALTIMORE HARBOR OUTER CROSSING PATAPSCO RIVER BRIDGE GENERAL PROJECT PLAN		
	SCALE 1" = 400'	DATE JAN., 1972	CONTRACT OT-8 & OT-9
	MADE BY E.R.A.	J. E. GREINER COMPANY, INC. CONSULTING ENGINEERS BALTIMORE, MARYLAND	
	TRACED BY E.R.A. CHECKED BY S.J.S.		
DRAWING NO. A-103 SHEET NO. 3 OF 24 INDEXED			

STATION EQUALITY
449+87.67 BK. =
450+33.817 AH.

CURVE DATA
P.I. 459+80.460
Δ = 24°-07'-00"
D = 1°-30'-00"
R = 3819.719'
L = 1607.778'
T = 815.972'
E = 86.182'

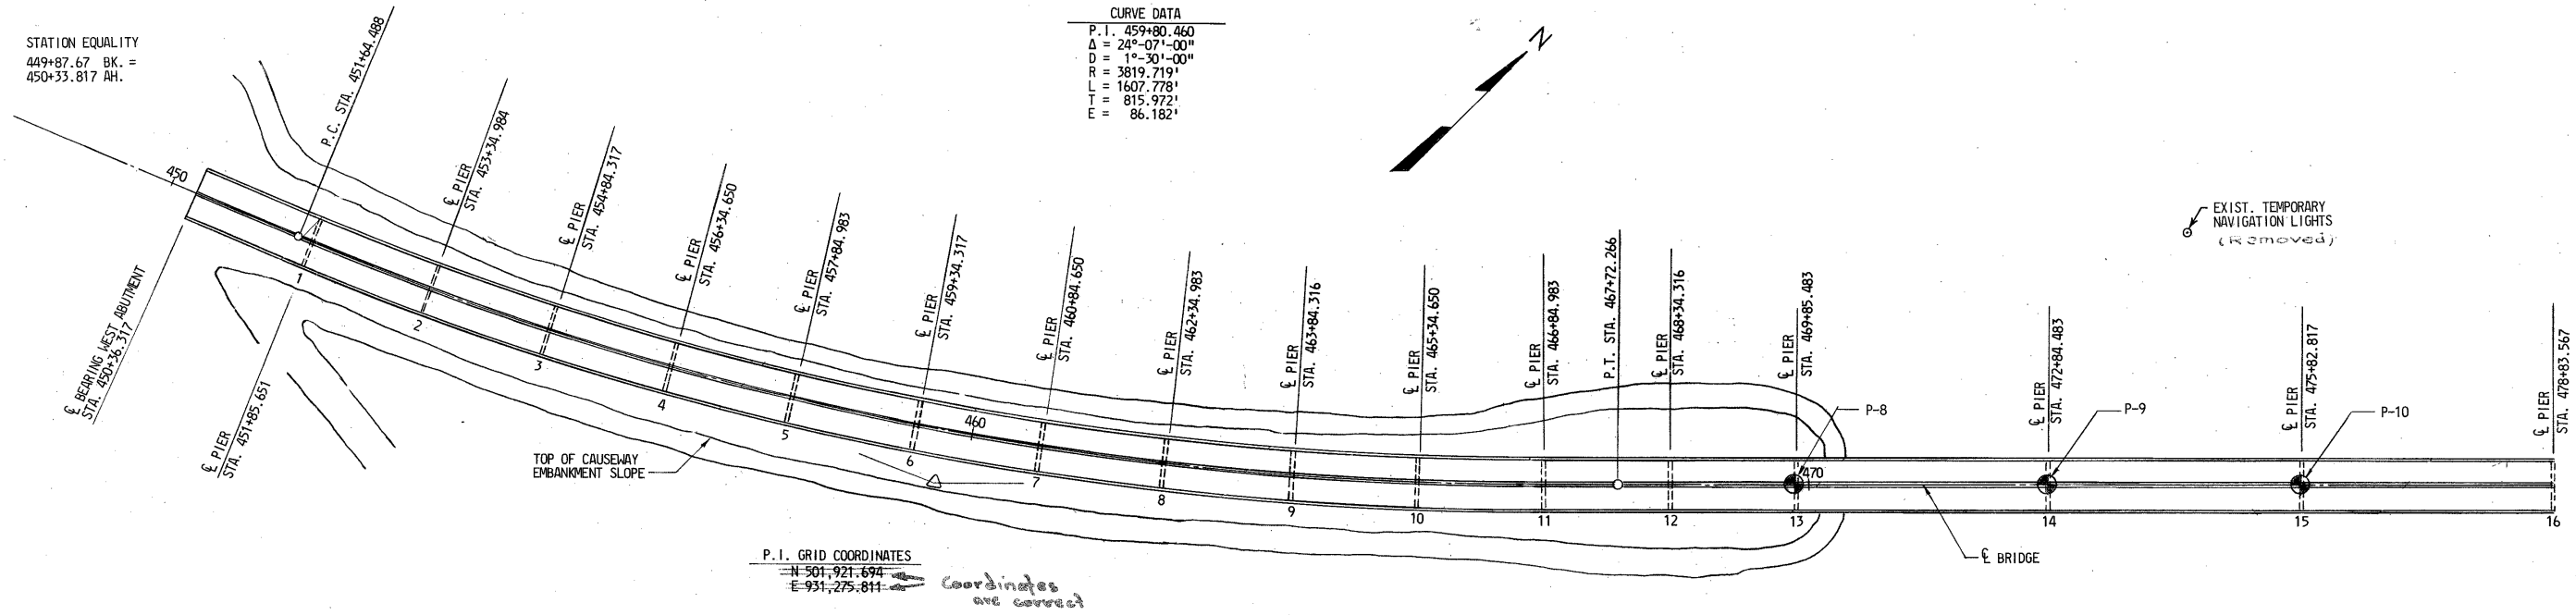

PLAN

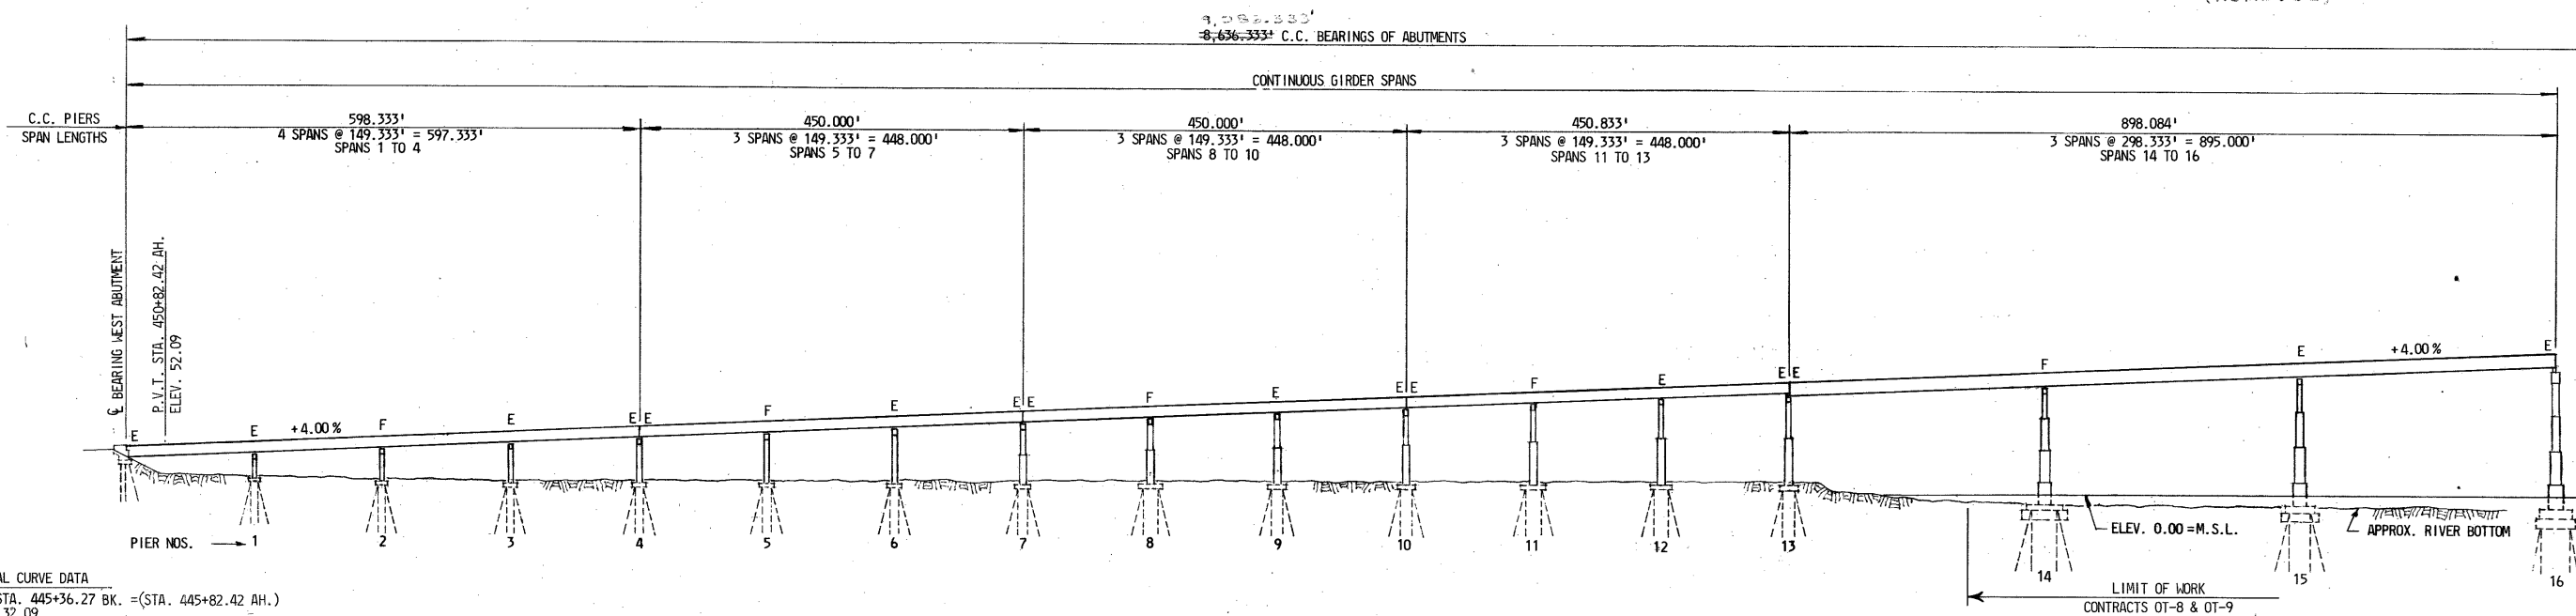

ELEVATION


VERTICAL CURVE DATA
P.V.I. STA. 445+36.27 BK. = (STA. 445+82.42 AH.)
ELEV. = 32.09
V.C. = 1000'
CORR. = +6.825'
GRADES = -1.46%
 +4.00%

All elevations this sheet subject to
note 12 Div 9 A-102 Contract OT-8 & OT-9


NOTES:
ALL DIMENSIONS & SPAN LENGTHS
SHOWN ARE HORIZONTAL.
FOR GENERAL NOTES SEE DWG. NO. A-102.
⊙ DENOTES BORING LOCATION.
FOR LOCATION OF SURVEY TOWERS SEE DWG. NO. A-103.

AS BUILT

REVISIONS	STATE OF MARYLAND DEPARTMENT OF TRANSPORTATION STATE HIGHWAY ADMINISTRATION BALTIMORE, MD.		
	BALTIMORE HARBOR OUTER CROSSING PATAPSCO RIVER BRIDGE		
	GENERAL PLAN AND ELEVATION - I		
	SCALE 1"=100'	DATE JAN., 1972	CONTRACT OT-8 & OT-9
MADE BY	E.R.A.	J. E. GREINER COMPANY, INC. CONSULTING ENGINEERS BALTIMORE, MARYLAND	
TRACED BY	C.E.S.		
CHECKED BY	S.J.S. & J.W.H.		
DRAWING NO. A-104			
SHEET NO. 4 OF 24			
INDEXED			

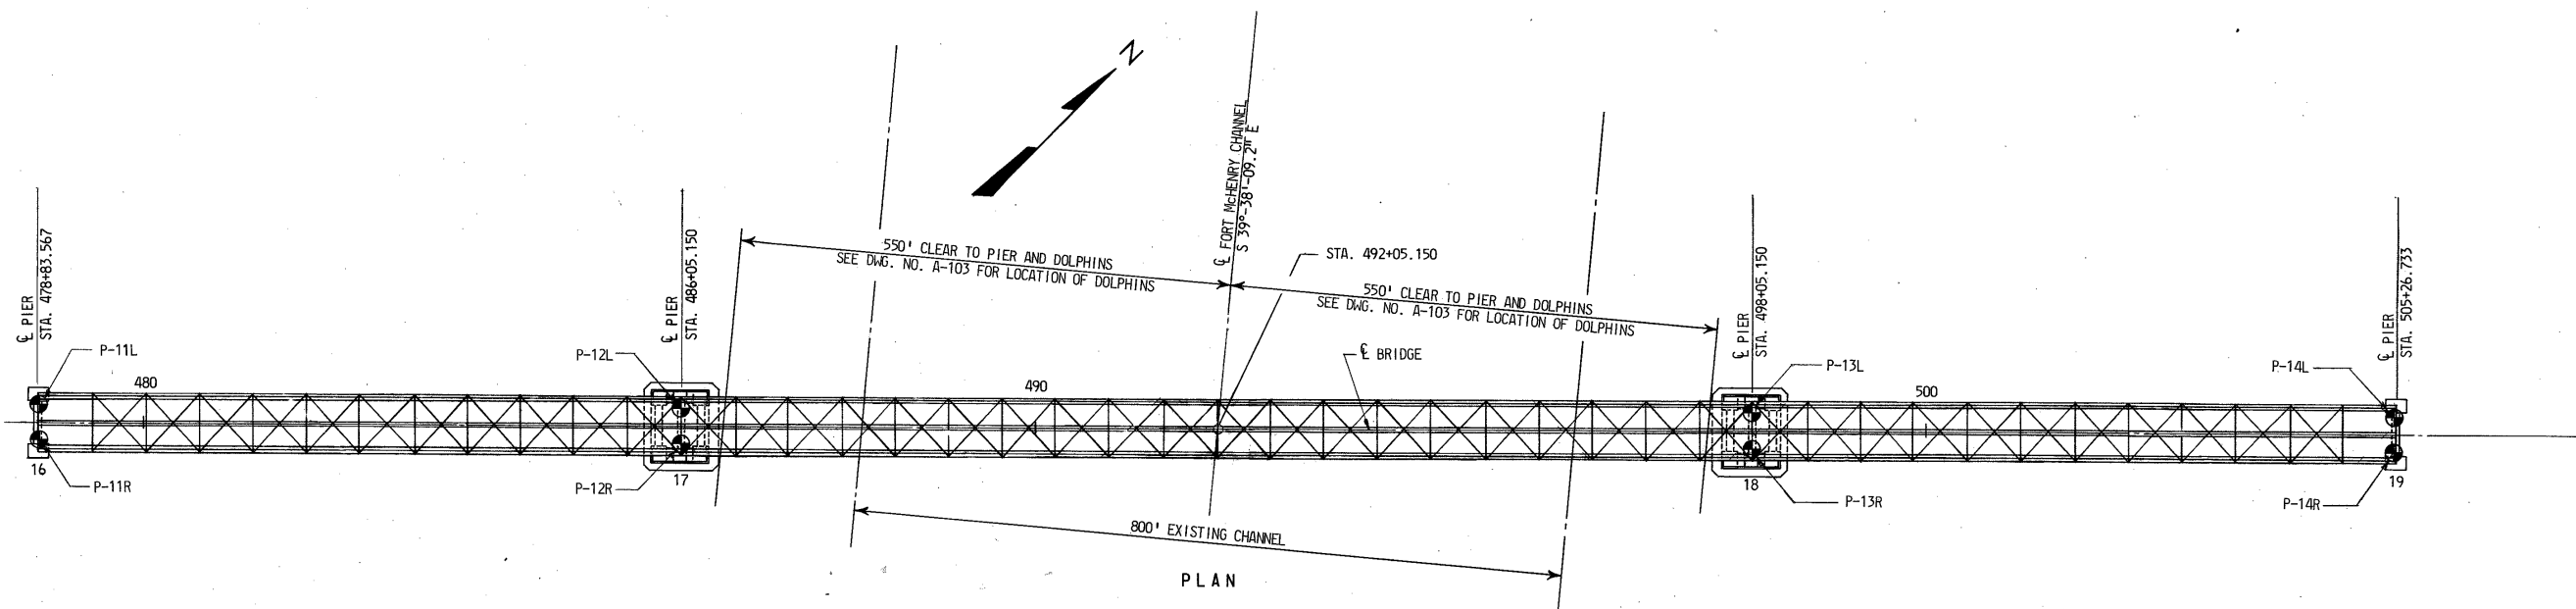

9,084.333'
8,636.333' C.C. BEARINGS OF ABUTMENTS

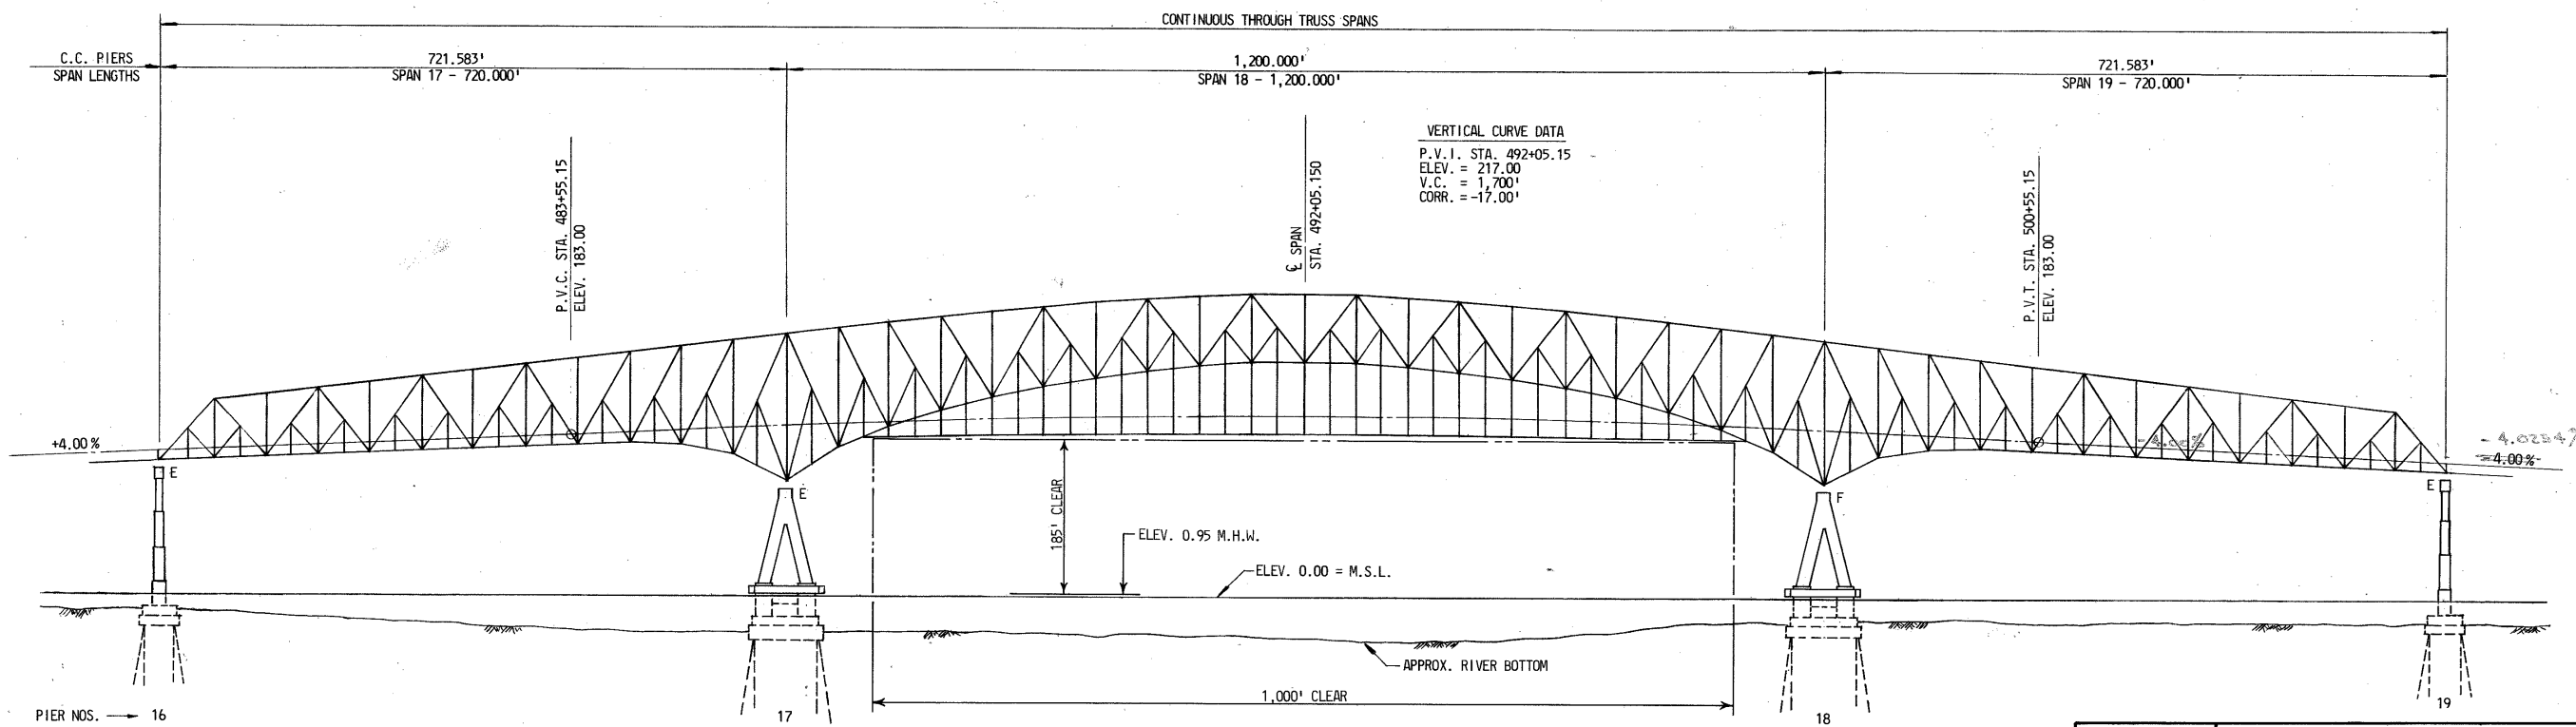


ELEVATION
All elevations this sheet subject to note 12 DWG. A-102 Contract OT-8-849


NOTES:
ALL DIMENSIONS & SPAN LENGTHS SHOWN ARE HORIZONTAL.
FOR GENERAL NOTES SEE DWG. NO. A-102.
⊕ DENOTES BORING LOCATION.
FOR LOCATION OF SURVEY TOWERS SEE DWG. NO. A-103.

AS BUILT


REVISIONS	STATE OF MARYLAND DEPARTMENT OF TRANSPORTATION STATE HIGHWAY ADMINISTRATION BALTIMORE, MD. BALTIMORE HARBOR OUTER CROSSING PATAPSCO RIVER BRIDGE GENERAL PLAN AND ELEVATION - II		
	SCALE 1" = 100'	DATE JAN., 1972	CONTRACT OT-8 & OT-9
	MADE BY E.R.A. TRACED BY C.E.S. CHECKED BY S.J.S. & J.W.H.	J. E. GREINER COMPANY, INC. CONSULTING ENGINEERS BALTIMORE, MARYLAND	
File No	Packet No	Folder No	DRAWING NO. A-105 SHEET NO. 5 OF 24 INDEXED

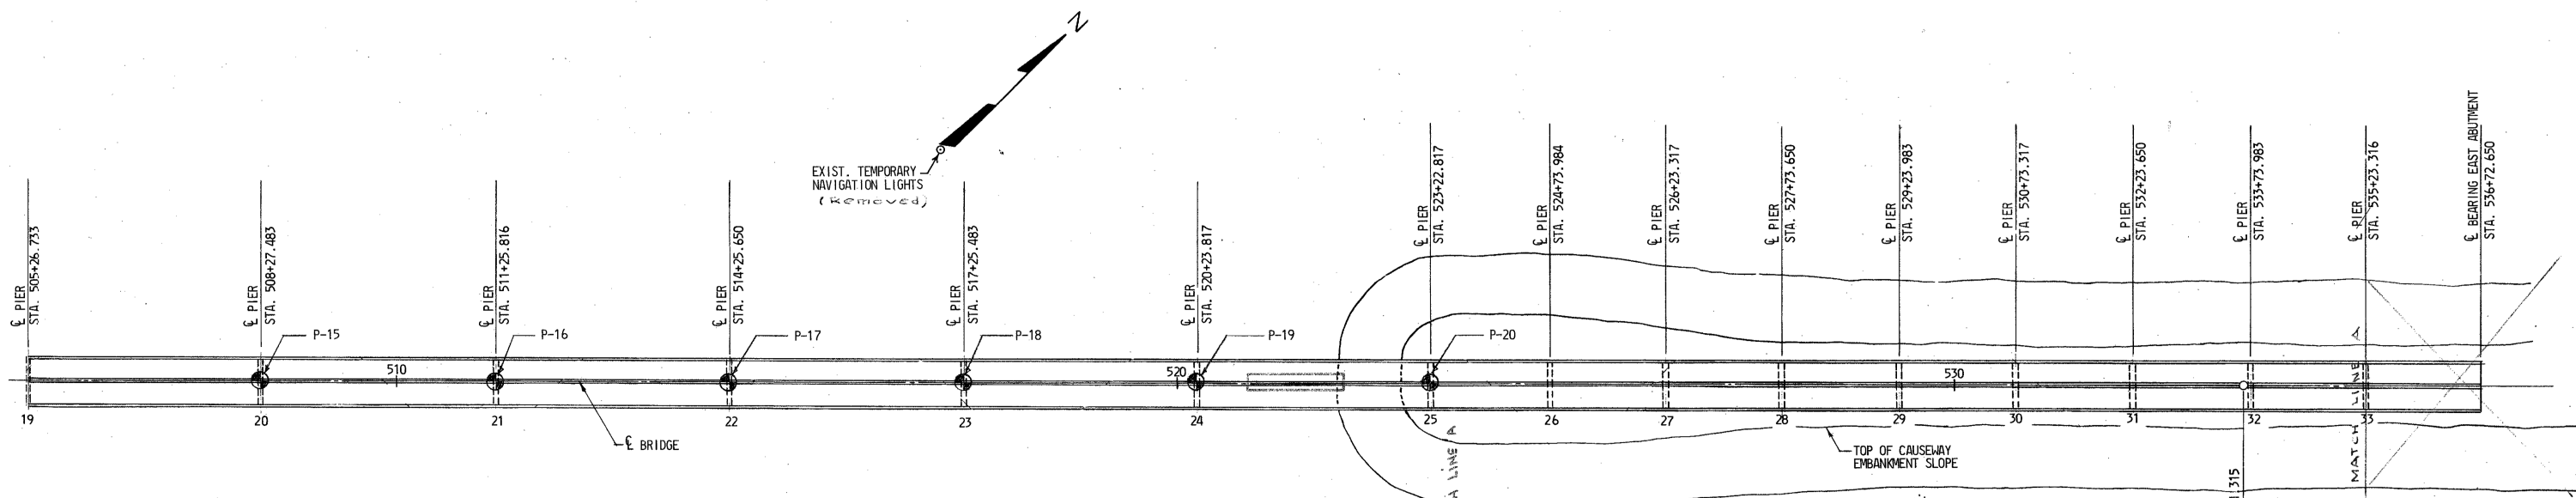

8-636-3333 C.C. BEARINGS OF ABUTMENTS

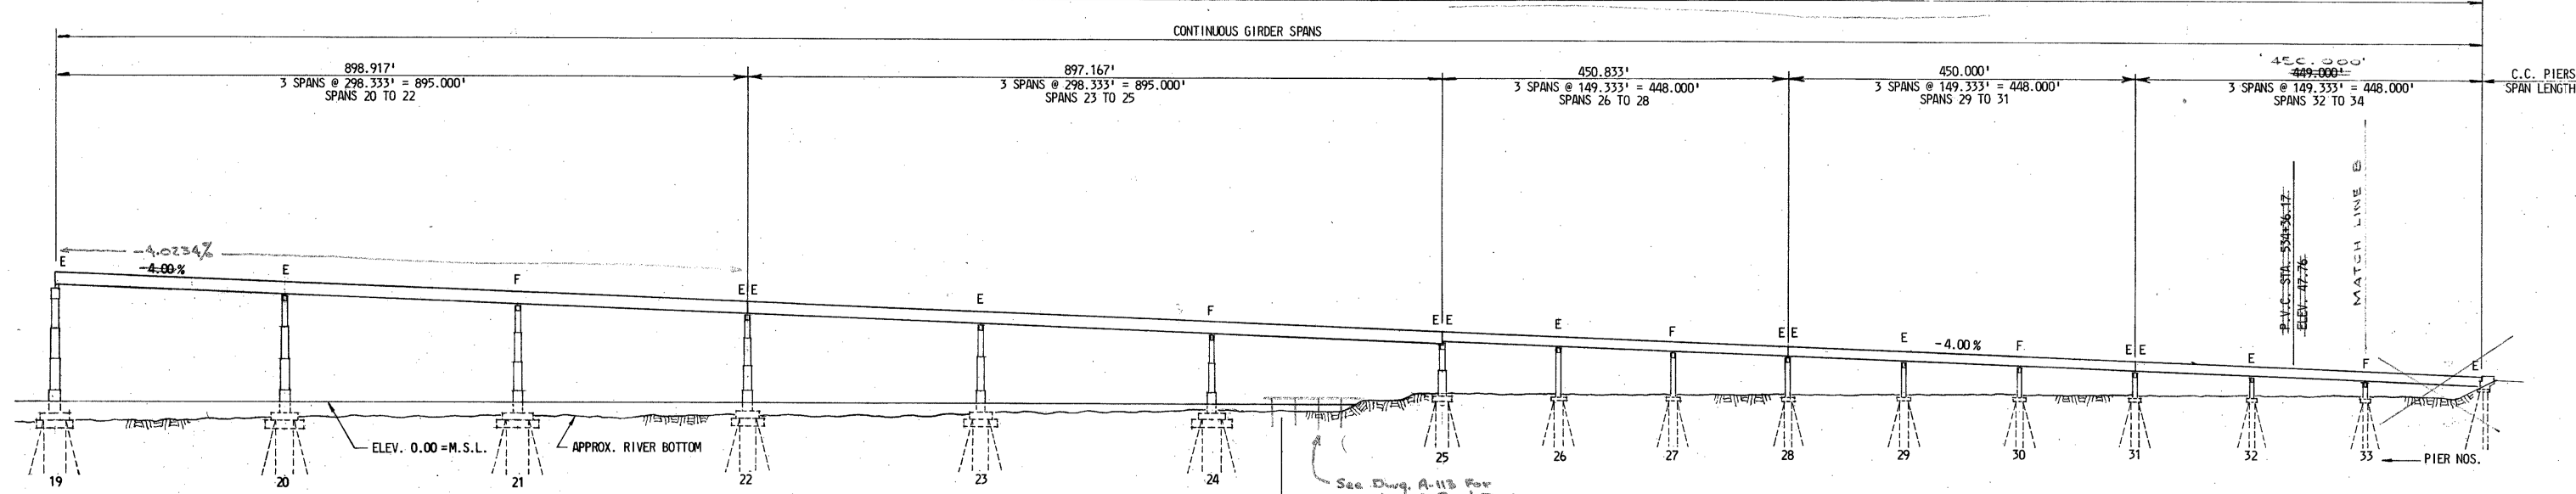



All elevations this sheet subject to Note 12 Dwg. A-102 Contract OT-8 & 9

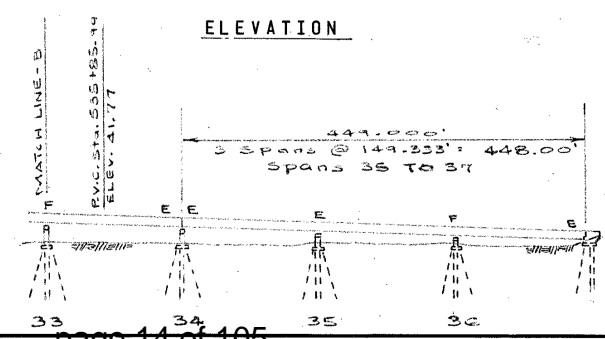

NOTES:
 ALL DIMENSIONS & SPAN LENGTHS SHOWN ARE HORIZONTAL.
 FOR GENERAL NOTES SEE DWG. NO. A-102.
 DENOTES BORING LOCATION.
 FOR LOCATION OF SURVEY TOWERS SEE DWG. NO. A-103.

AS BUILT


REVISIONS	STATE OF MARYLAND DEPARTMENT OF TRANSPORTATION STATE HIGHWAY ADMINISTRATION BALTIMORE, MD. BALTIMORE HARBOR OUTER CROSSING PATAPSCO RIVER BRIDGE GENERAL PLAN AND ELEVATION - III		
	SCALE 1"=100'	DATE JAN., 1972	CONTRACT OT-8 OT-9
	MADE BY E.R.A.	J. E. GREINER COMPANY, INC. CONSULTING ENGINEERS BALTIMORE, MARYLAND	
	TRACED BY C.E.S.		
	CHECKED BY S.J.S. & J.W.H.		
	DRAWING NO. A-106		
	SHEET NO. 6 OF 24		
	INDEXED		

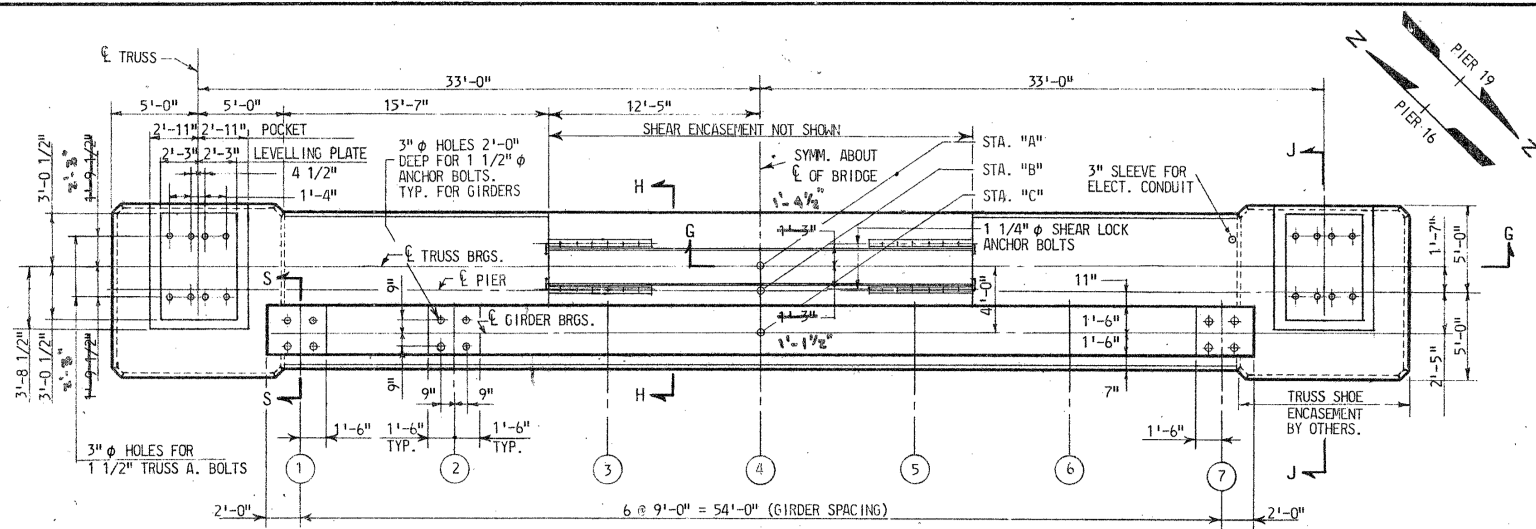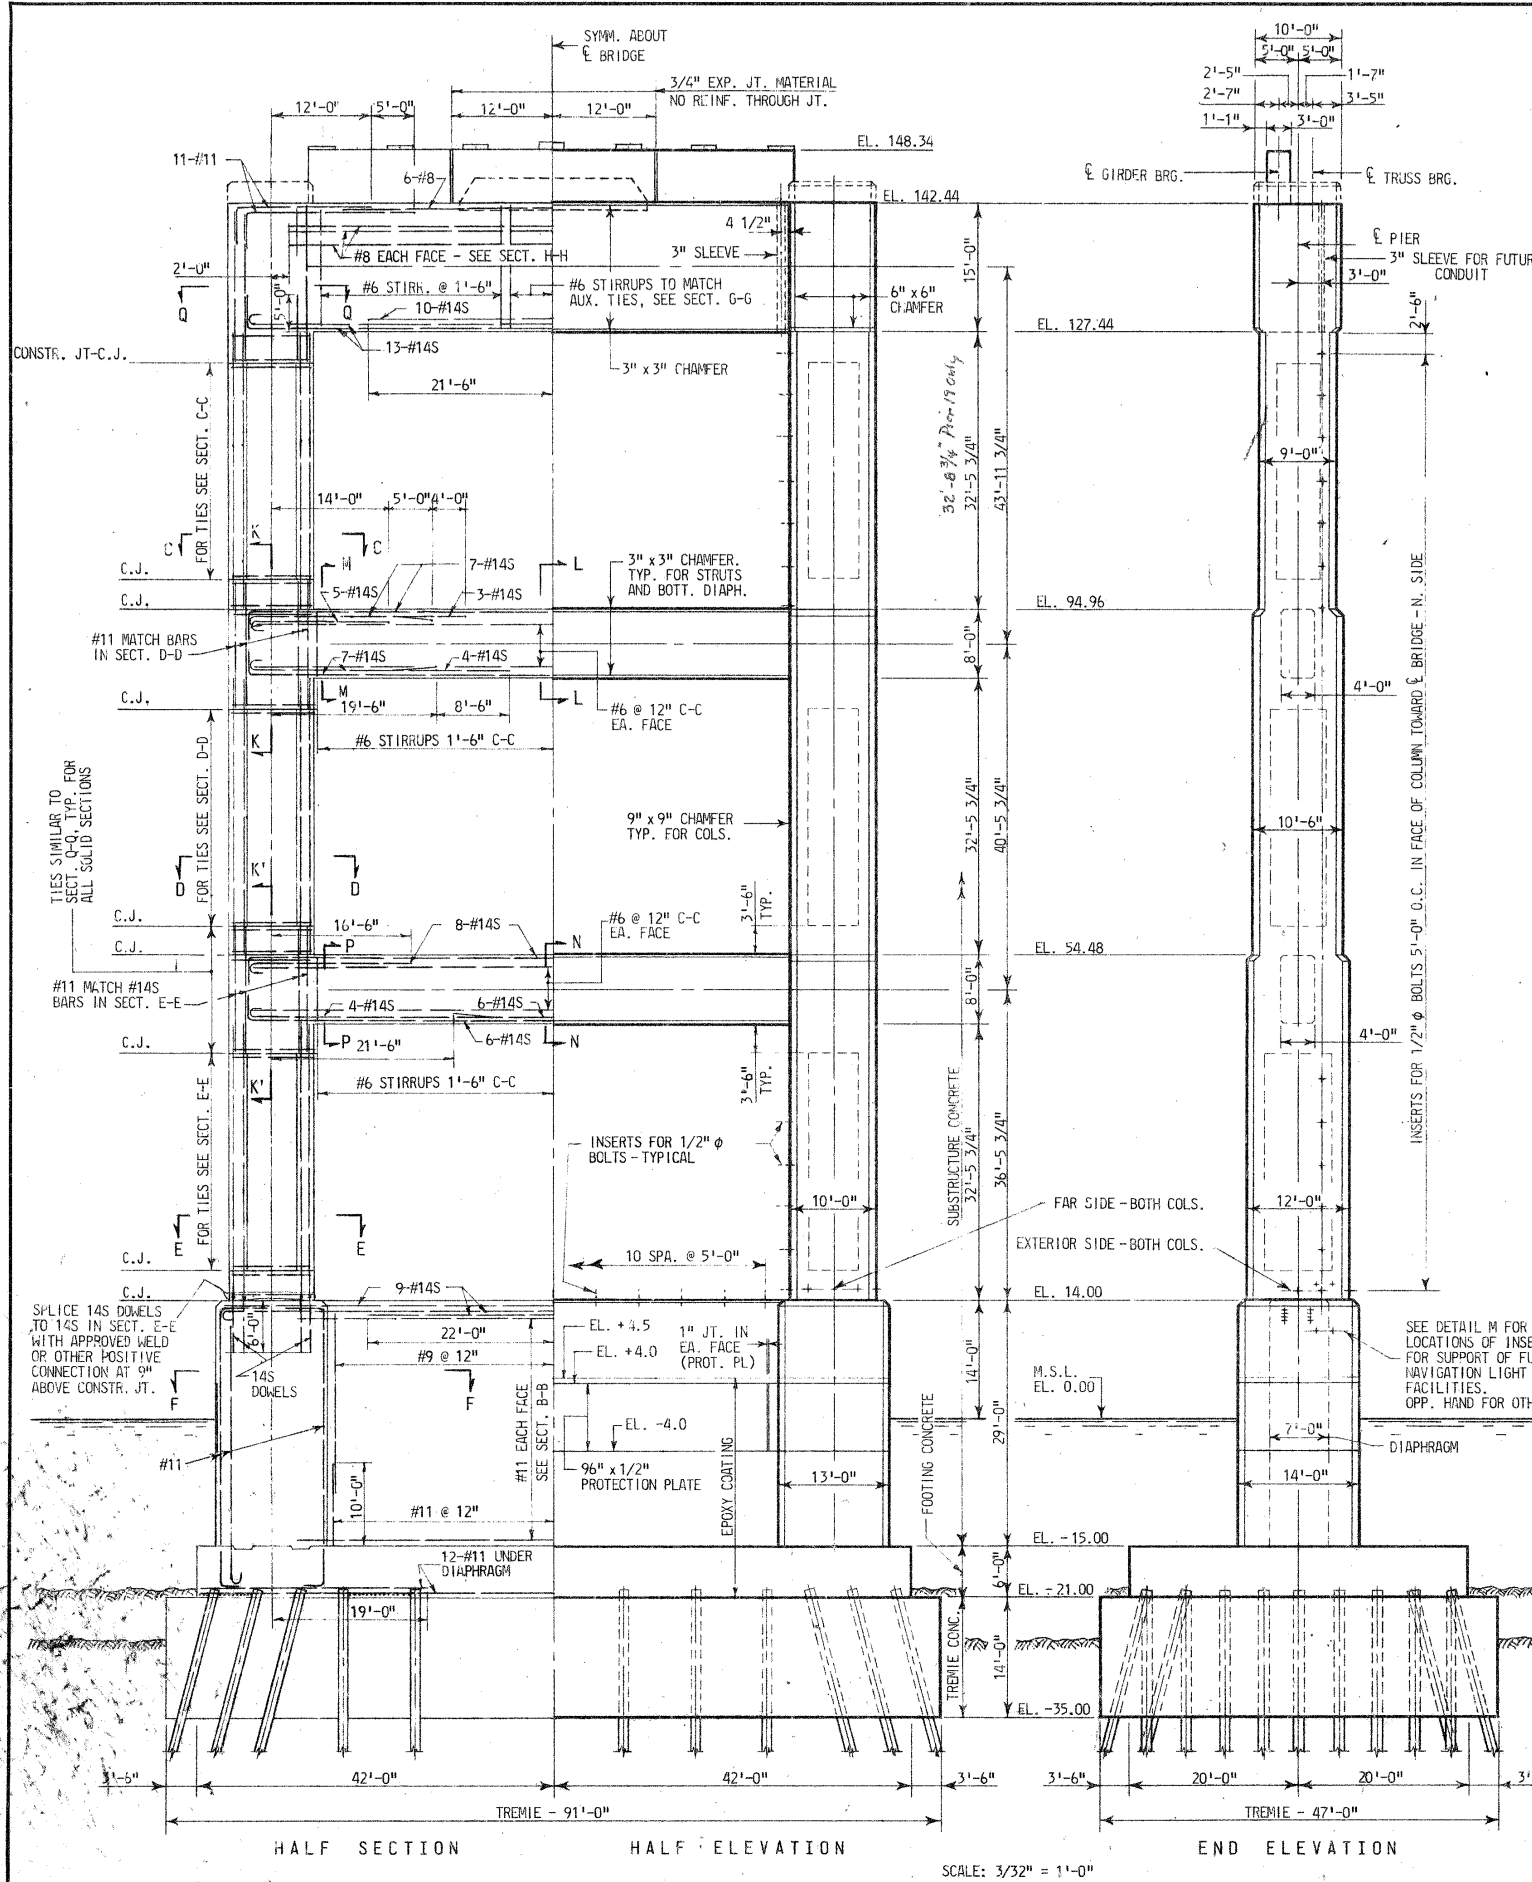

STATION	PIER	
	16	19
"A"	478+85.150	505+25.150
"B"	478+83.567	505+26.733
"C"	478+81.150	505+29.150

TOP PLAN
SCALE: 3/16" = 1'-0"


NOTE: PADS SHALL BE POURED 1/4" HIGH BY THE SUBSTRUCTURE CONTRACTOR AND GROUND TO THE CORRECT ELEVATION BY THE SUPERSTRUCTURE CONTRACTOR.

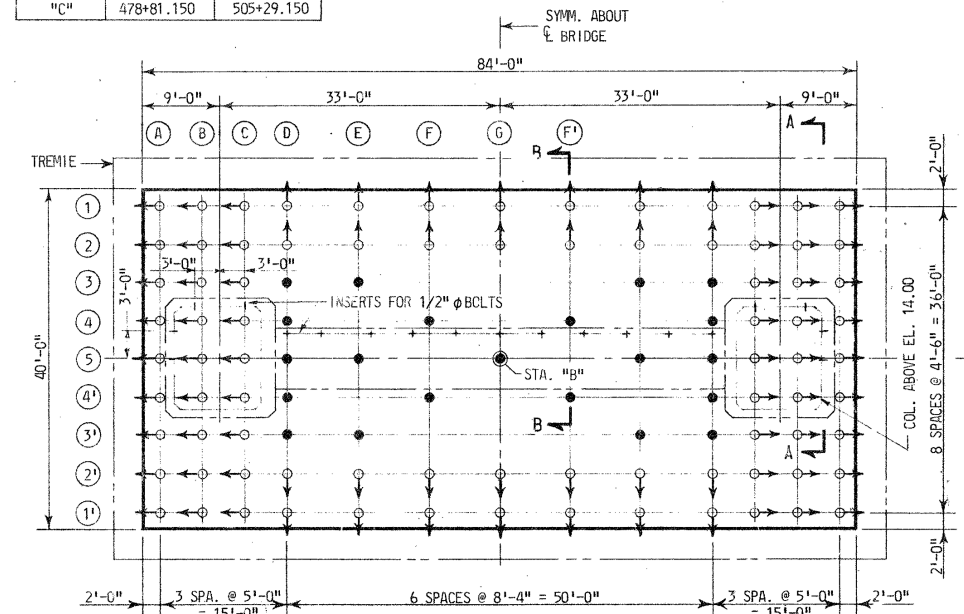

LEGEND:
● = PLUMB PILES
◐ = BATTER PILES 1:4


PILE PLAN
SCALE: 3/32" = 1'-0"

NOTE:
ALL PILES HP 14 x 102.
DIMENSIONS OF PILES SHOWN ARE AT BOTTOM OF FOOTING, EL. -21.00.
ORIENTATION: BATTERED PILES SHALL BE DRIVEN WITH THE WEBS IN LINE WITH THE DIRECTION OF BATTER.
PLUMB PILES SHALL BE DRIVEN WITH WEBS PARALLEL TO THE PIER
ESTIMATED PILE TIP EL.: PIER 16 - EL. -110 (AVERAGE)
PIER 19 - EL. -112 (AVERAGE)

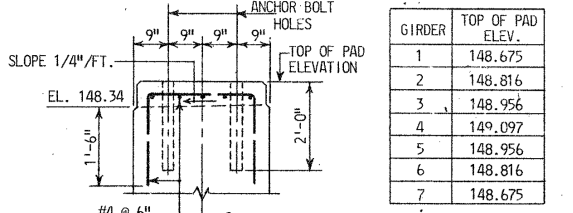


SECTION S-S
GIRDER BRG. PAD DETAILS
SCALE: 1/2" = 1'-0"

GIRDER	TOP OF PAD ELEV.
1	148.675
2	148.816
3	148.956
4	149.097
5	148.956
6	148.816
7	148.675

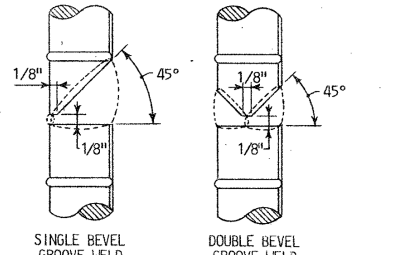


APPROVED BUTT SPLICES FOR REINFORCING BARS
NOT TO SCALE
NOTE: AN APPROVED THERMIT WELDING PROCESS SPLICE WILL ALSO BE ACCEPTABLE.

NOTES:
FOR GENERAL NOTES SEE DWG. NO. A-102.
FOR DETAIL OF CONSTRUCTION JOINT KEYS SEE SECT. J-J DWG. NO. A-108.
FOR TEST PILE AND LOAD TEST LOCATIONS, PILE SPLICE DETAIL AND STEEL PROTECTION PLATE DETAILS SEE DWG. NO. A-113.
ALL Elevations this Sheet Subject to Note 12 DWG A-102 of Cont. of T-9

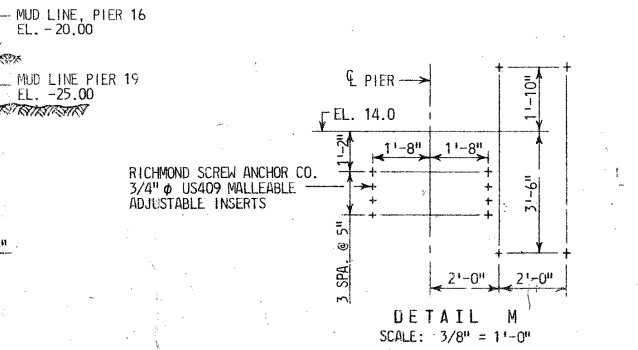

DETAIL M
SCALE: 3/8" = 1'-0"

REVISIONS As-Built	STATE OF MARYLAND DEPARTMENT OF TRANSPORTATION STATE HIGHWAY ADMINISTRATION BALTIMORE, MD. BALTIMORE HARBOR OUTER CROSSING PATAPSCO RIVER BRIDGE PIERS 16 AND 19 PLANS AND ELEVATIONS		
	SCALE: AS SHOWN	DATE: JAN., 1972	CONTRACT: OT-8
MADE BY: H.E.K.	J. E. GREINER COMPANY, INC. CONSULTING ENGINEERS BALTIMORE, MARYLAND		
TRACED BY: E.J.M.			
CHECKED BY: E.E.B.			
	DRAWING NO. A-107	SHEET NO. 7 OF 24	
	INDEXED		

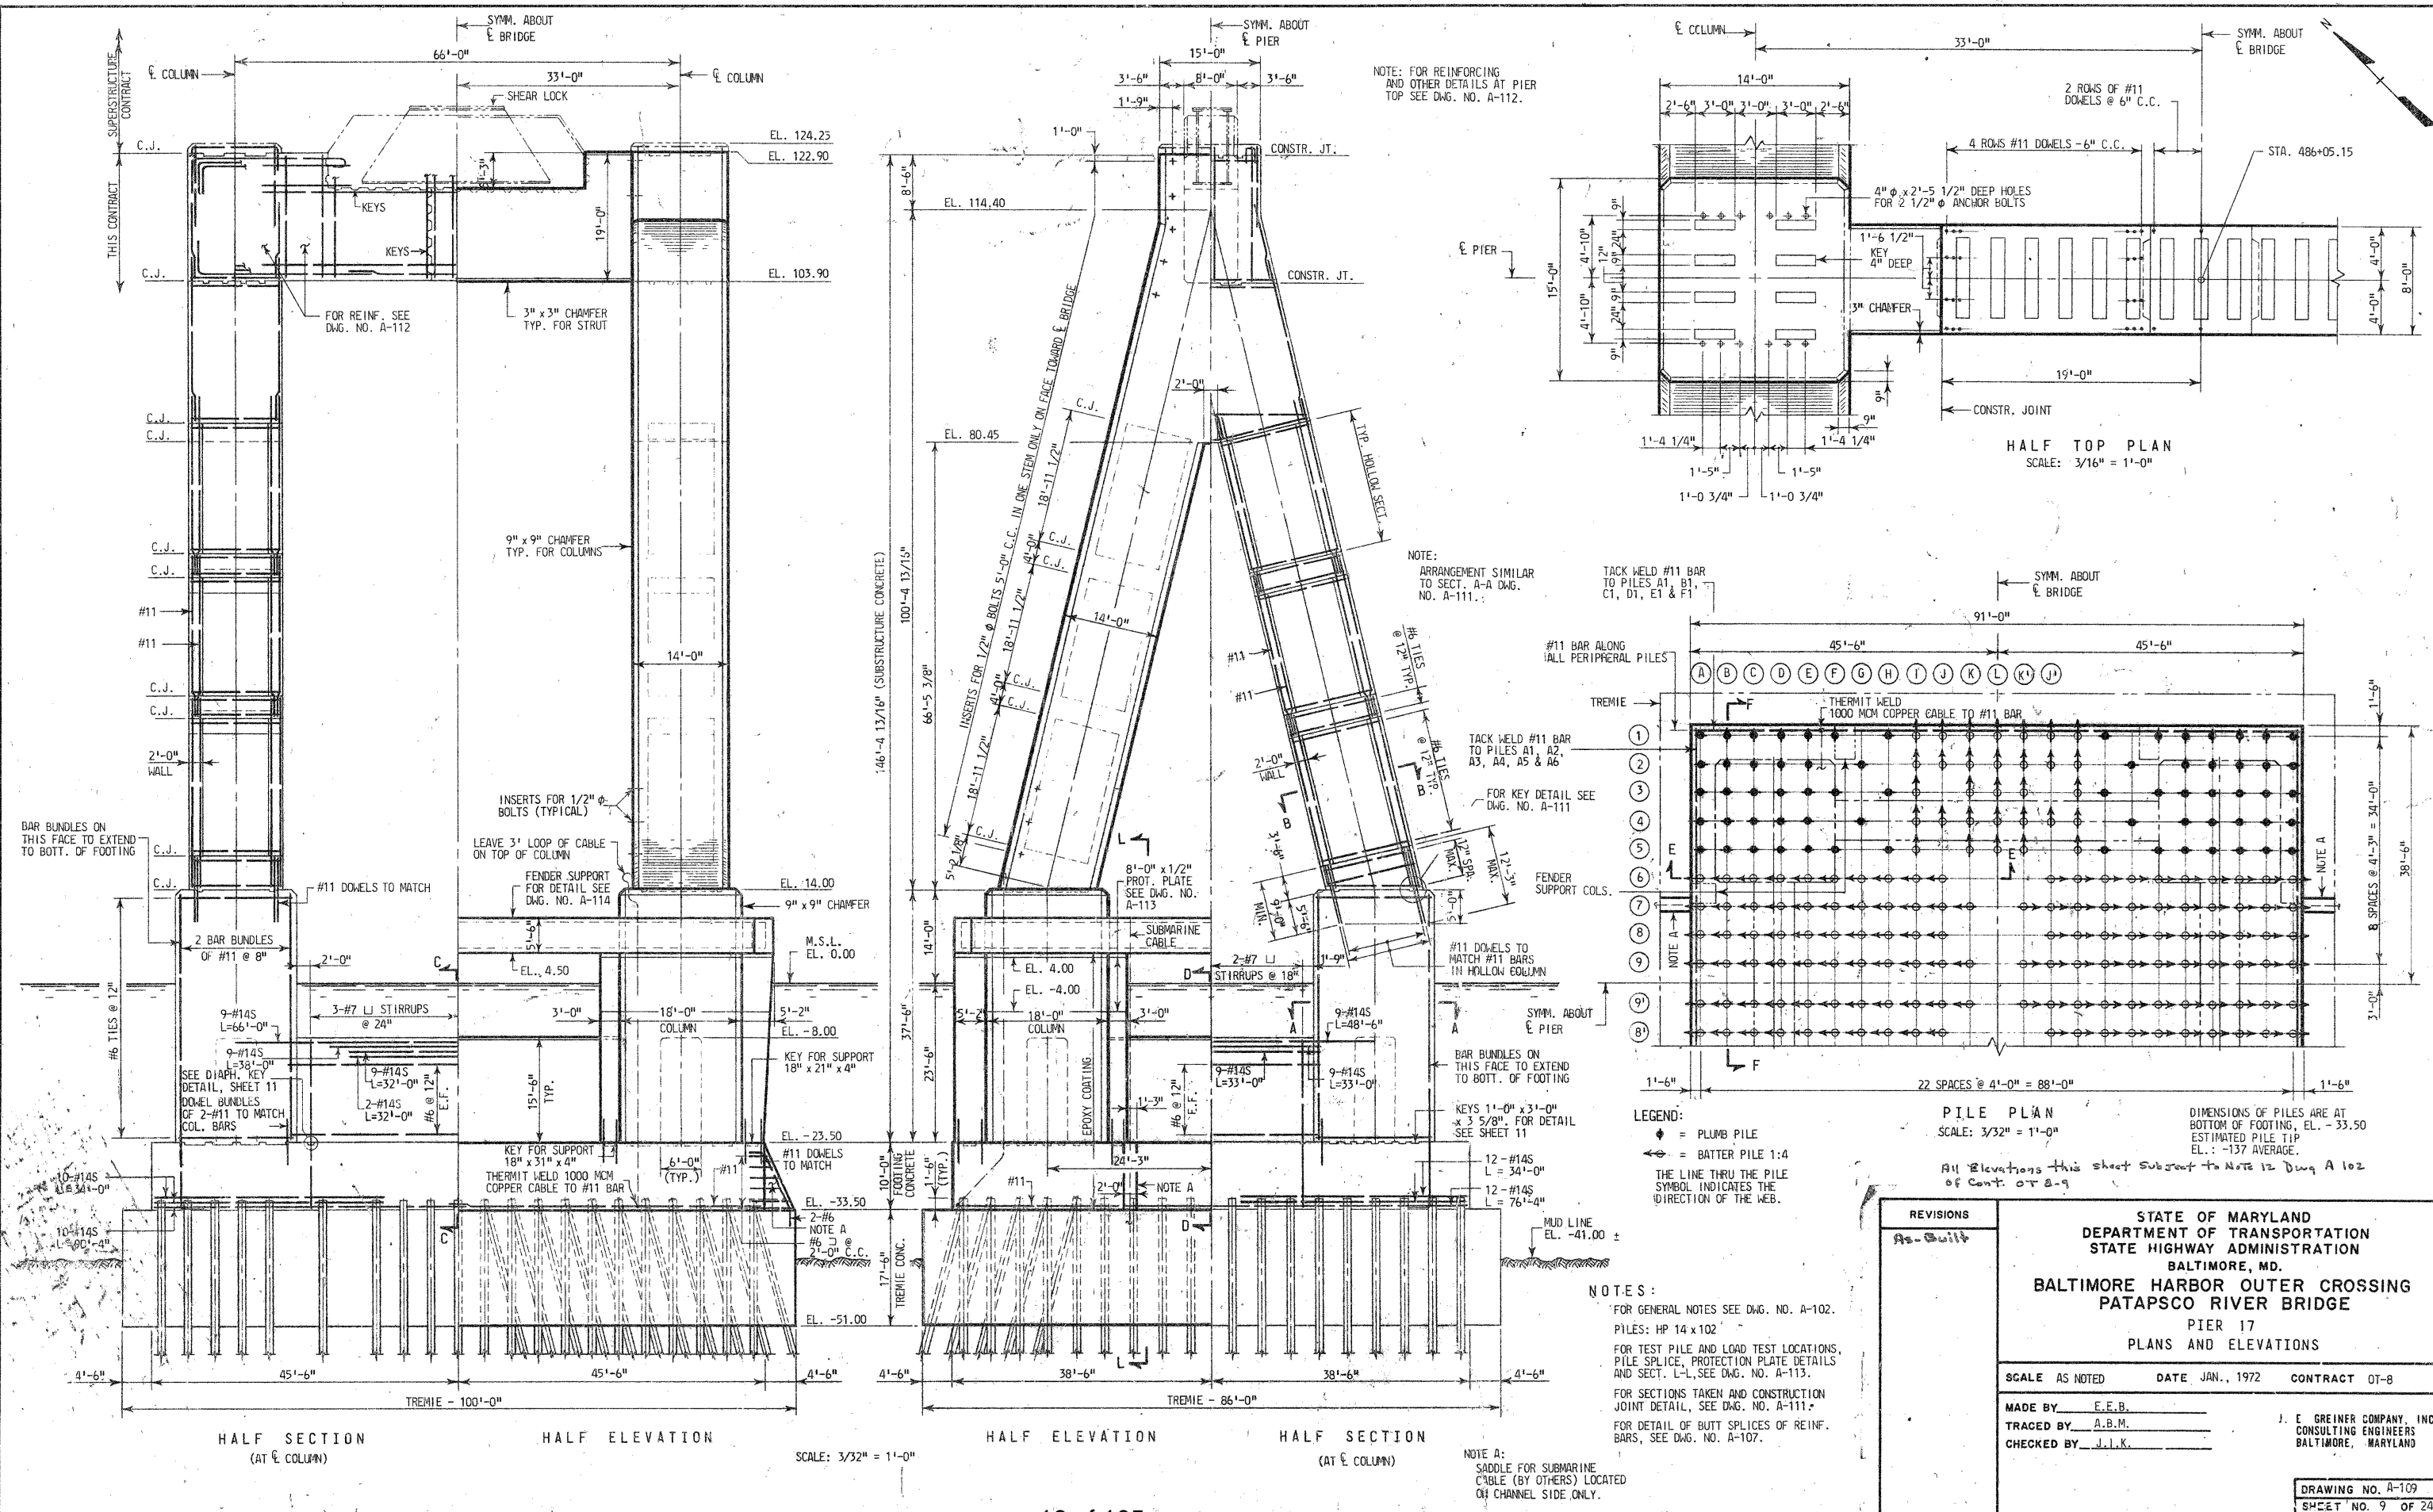

HALF SECTION (AT COLUMN)

HALF ELEVATION

SCALE: 3/32" = 1'-0"

HALF ELEVATION

HALF SECTION (AT PIER)

NOTES:
 FOR GENERAL NOTES SEE DWG. NO. A-102.
 PILES: HP 14 x 102
 FOR TEST PILE AND LOAD TEST LOCATIONS, PILE SPLICE, PROTECTION PLATE DETAILS AND SECT. L-L, SEE DWG. NO. A-113.
 FOR SECTIONS TAKEN AND CONSTRUCTION JOINT DETAIL, SEE DWG. NO. A-111.
 FOR DETAIL OF BUTT SPLICES OF REIN. BARS, SEE DWG. NO. A-107.

NOTE A:
 SADDLE FOR SUBMARINE CABLE (BY OTHERS) LOCATED ON CHANNEL SIDE ONLY.

REVISIONS		
As-Built		


STATE OF MARYLAND
 DEPARTMENT OF TRANSPORTATION
 STATE HIGHWAY ADMINISTRATION
 BALTIMORE, MD.
**BALTIMORE HARBOR OUTER CROSSING
 PATAPSCO RIVER BRIDGE**
 PIER 17
 PLANS AND ELEVATIONS

SCALE AS NOTED DATE JAN., 1972 CONTRACT OT-8

MADE BY: E.E.B.
 TRACED BY: A.B.M.
 CHECKED BY: J.L.K.


J. E. GREINER COMPANY, INC.
 CONSULTING ENGINEERS
 BALTIMORE, MARYLAND

DRAWING NO. A-109
 SHEET NO. 9 OF 24
 INDEXED

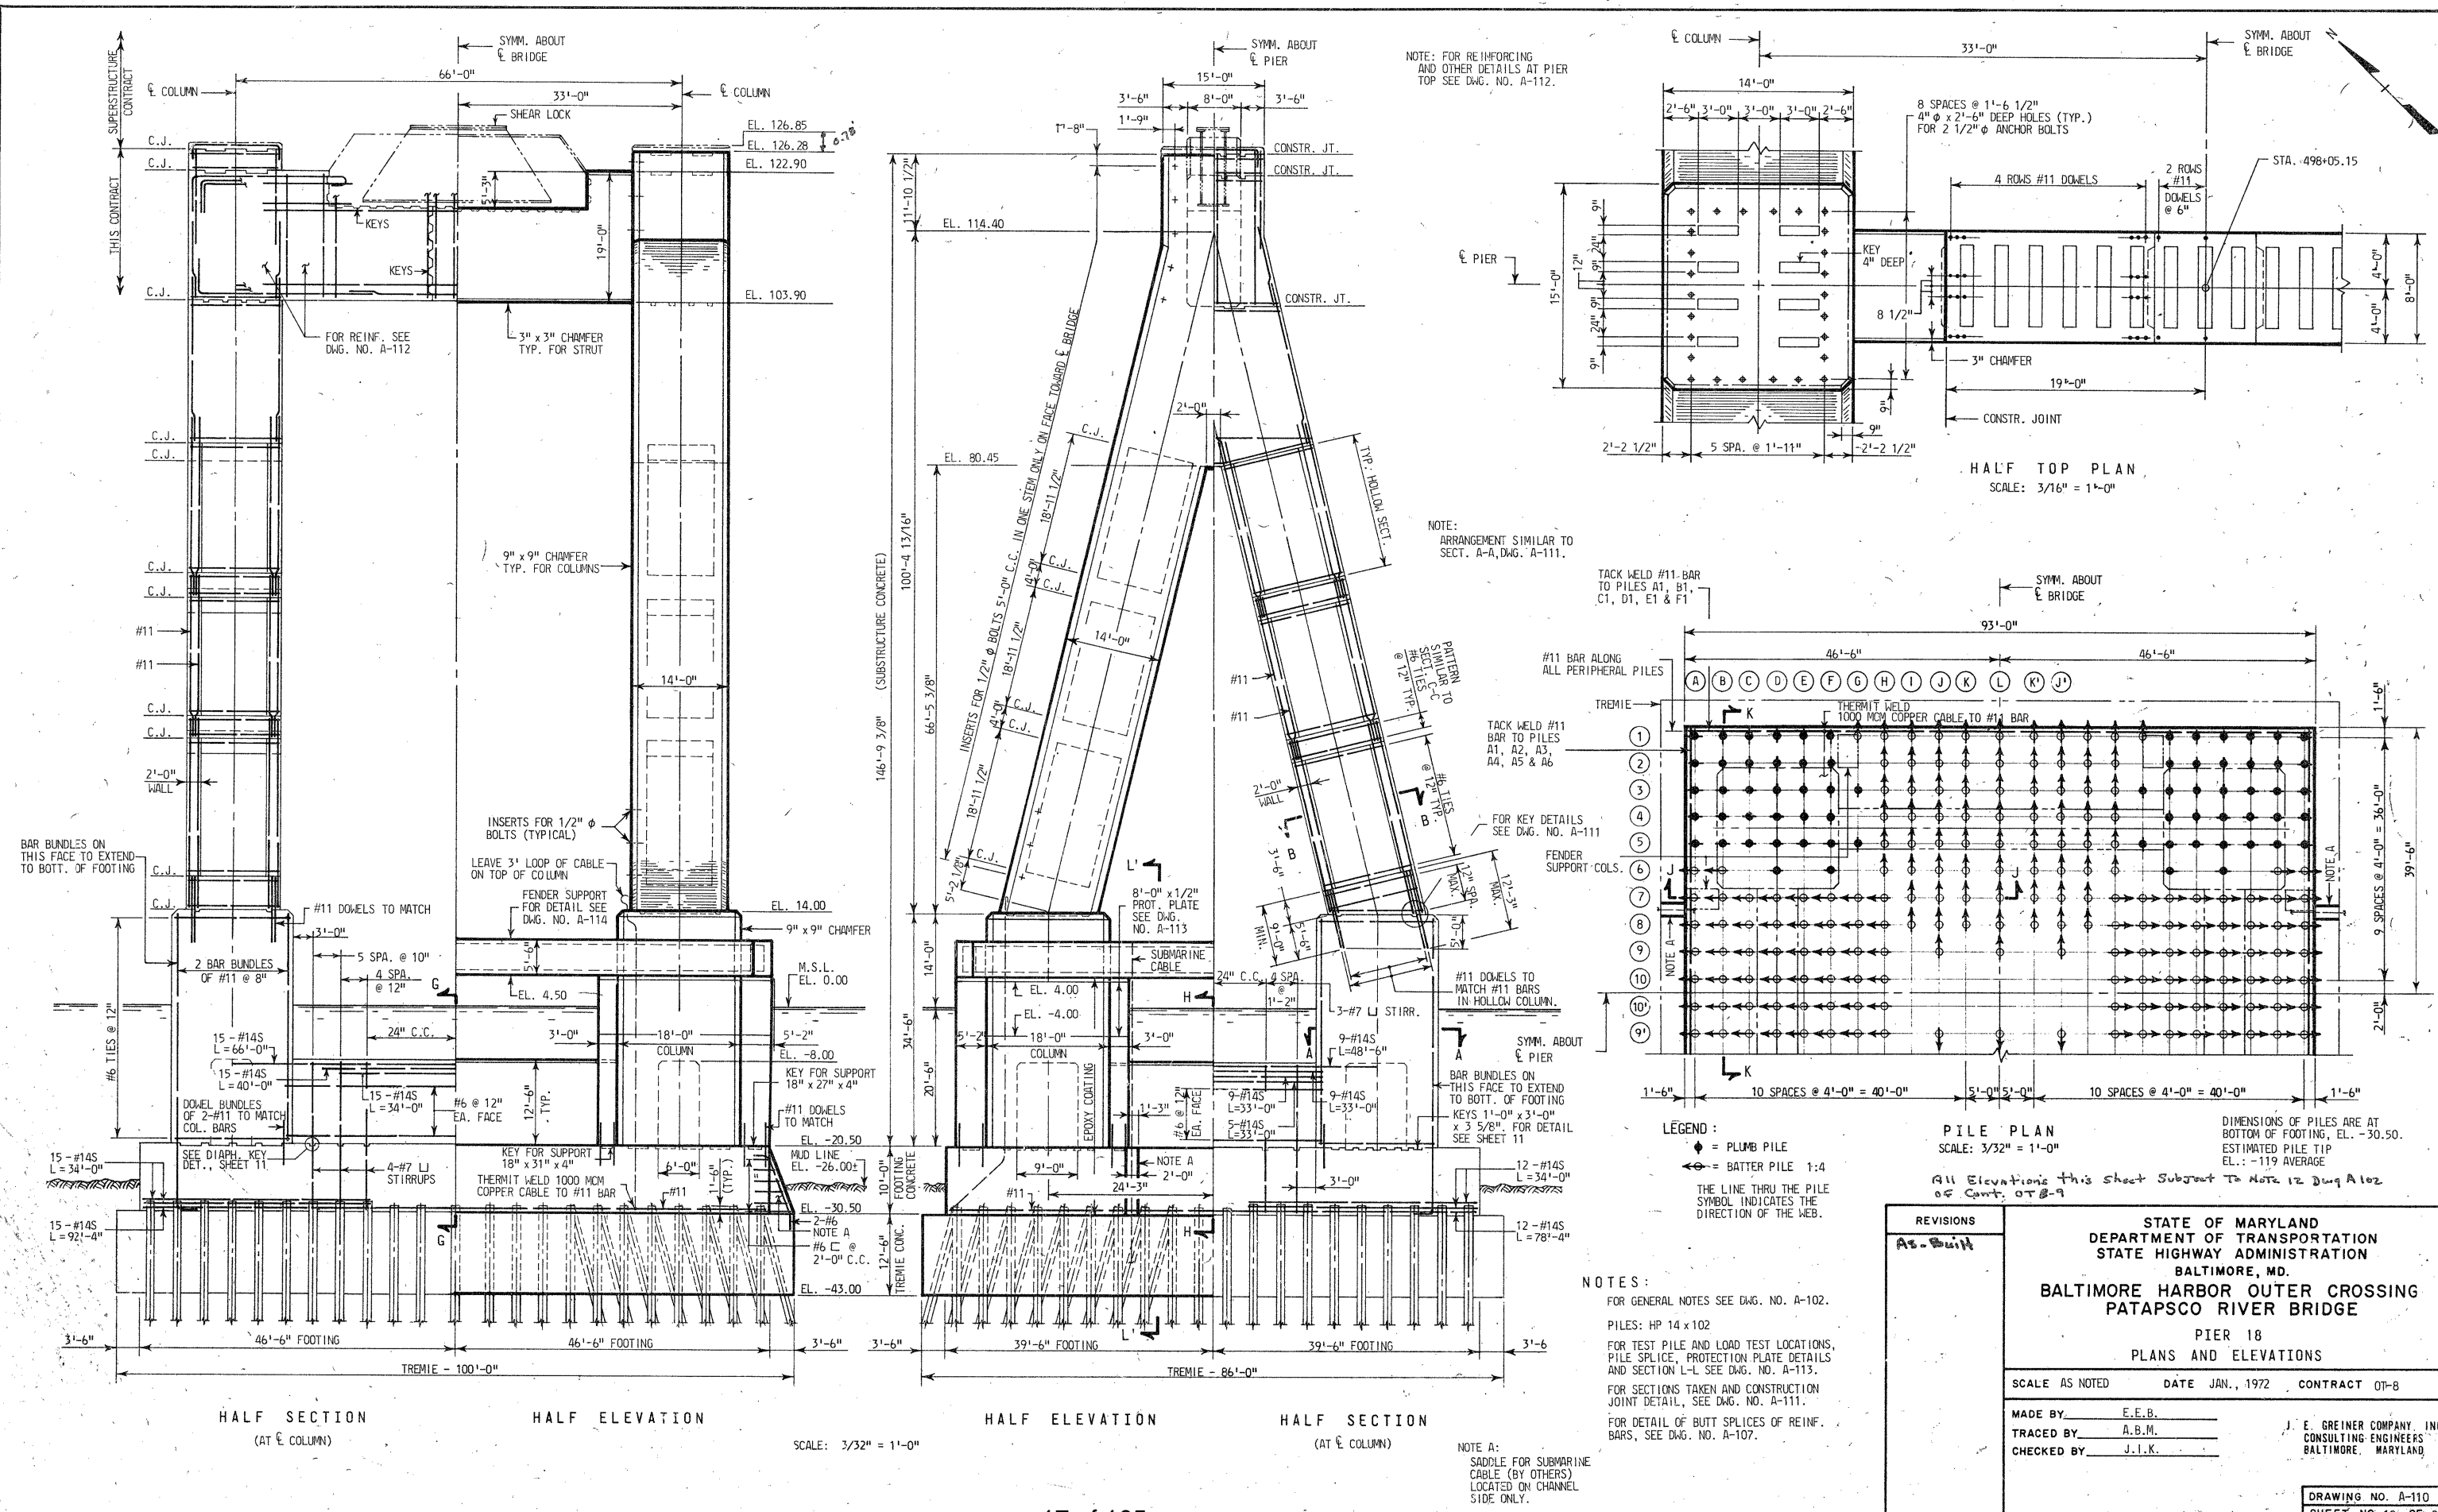


REVISIONS As-Built	STATE OF MARYLAND DEPARTMENT OF TRANSPORTATION STATE HIGHWAY ADMINISTRATION BALTIMORE, MD. BALTIMORE HARBOR OUTER CROSSING PATAPSCO RIVER BRIDGE PIER 18 PLANS AND ELEVATIONS		
	SCALE AS NOTED	DATE JAN., 1972	CONTRACT OT-8
	MADE BY E.E.B. TRACED BY A.B.M. CHECKED BY J.I.K.	J. E. GREINER COMPANY, INC. CONSULTING ENGINEERS BALTIMORE, MARYLAND	

DRAWING NO. A-110
 SHEET NO. 10 OF 24
 INDEXED

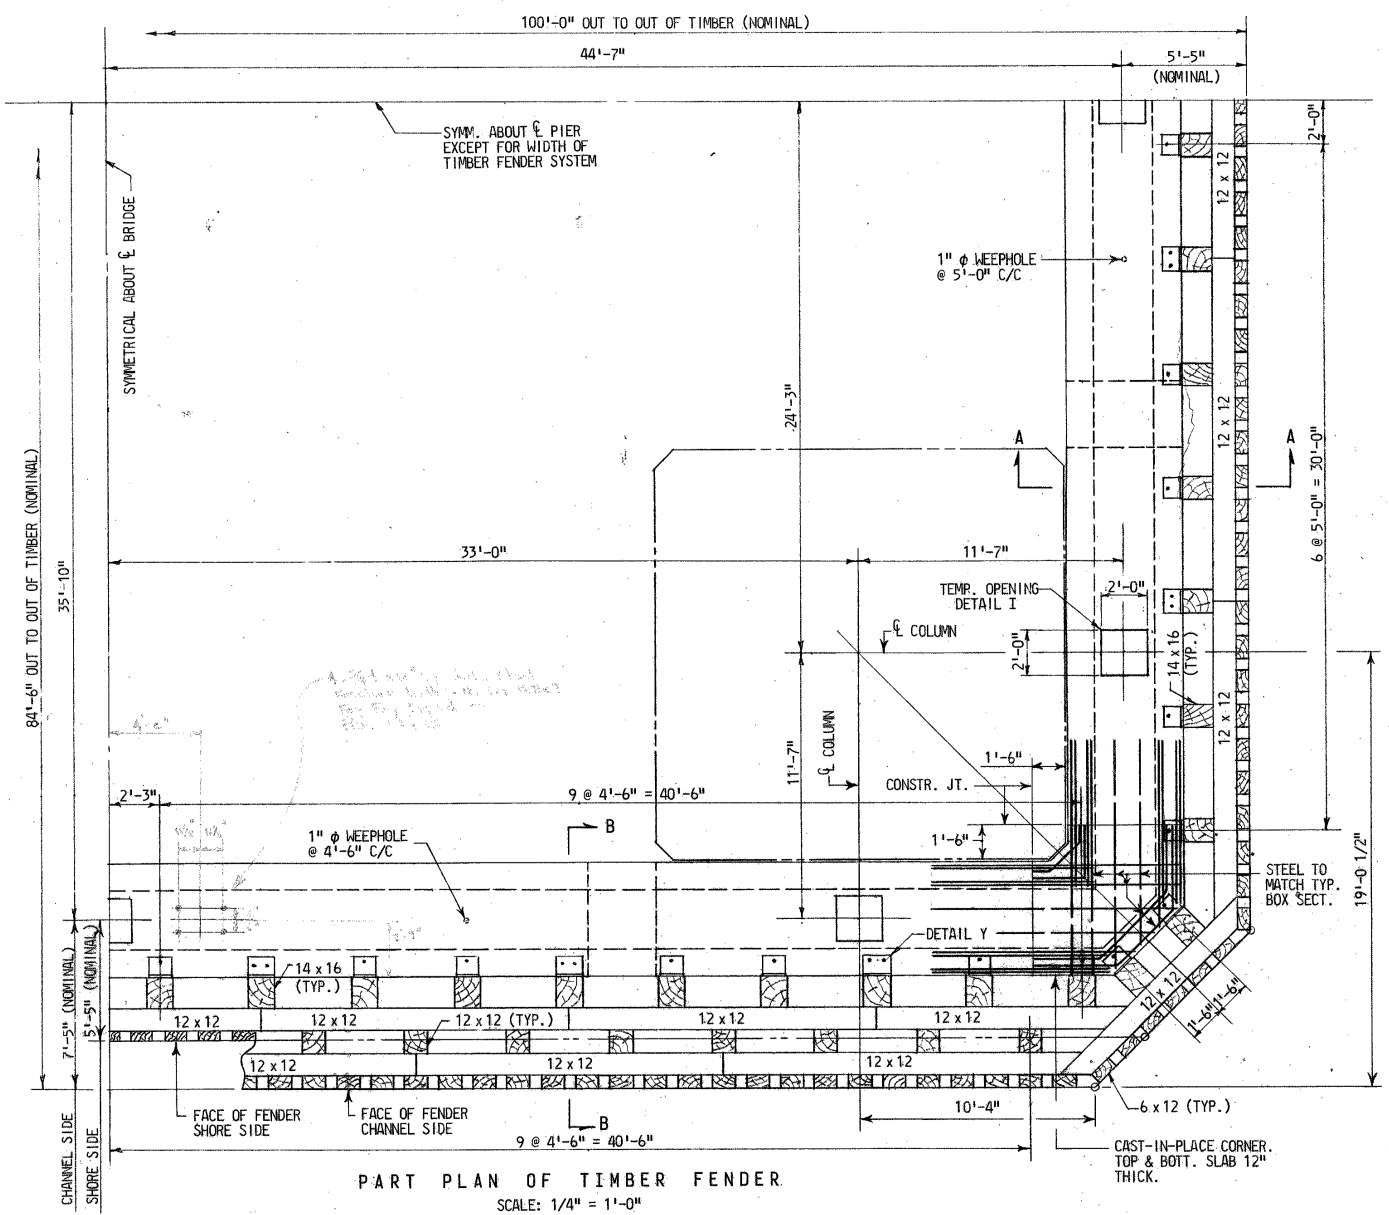


PART PLAN OF TIMBER FENDER
SCALE: 1/4" = 1'-0"

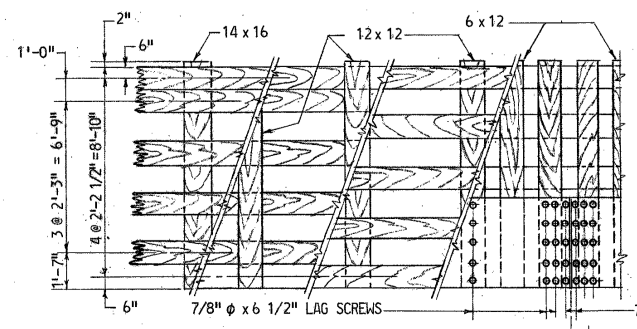


PART TYPICAL ELEVATION
SHOWING BOLTING OF PROTECTION PLATE
SCALE: 1/4" = 1'-0"


NOTE:
TOP ENDS OF ALL VERTICAL TIMBERS TO BE COVERED WITH 16 OZ. COPPER CAPS EXTENDING DOWN A MINIMUM OF TWO INCHES ON ALL SIDES. CORNERS OF CAPS ARE TO BE LAPPED AND SOLDERED, AND BOTTOMS ARE TO BE TURNED IN. FASTEN TO TIMBERS WITH COPPER NAILS CLOSELY SPACED.

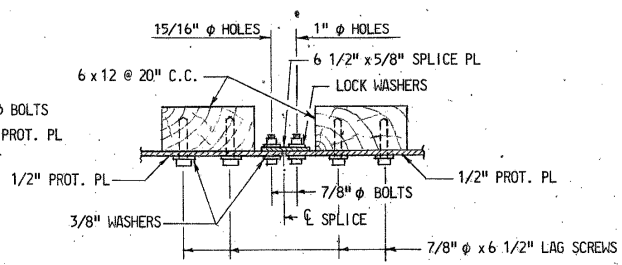


SPLICE IN PROTECTION PLATE
SCALE: 1" = 1'-0"

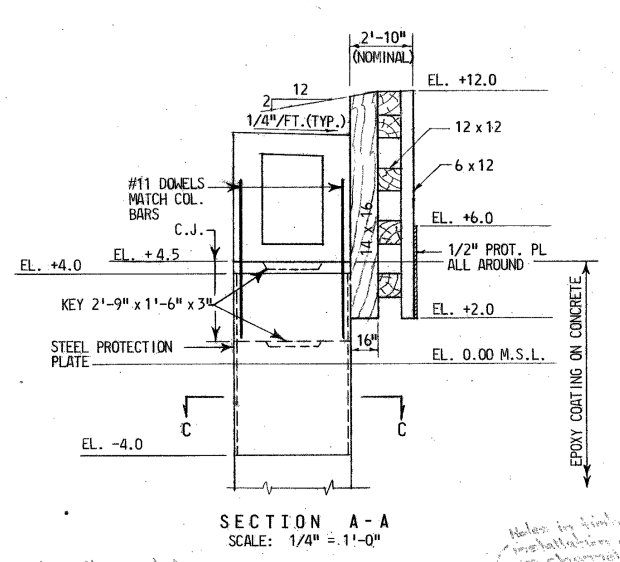


SECTION A-A
SCALE: 1/4" = 1'-0"

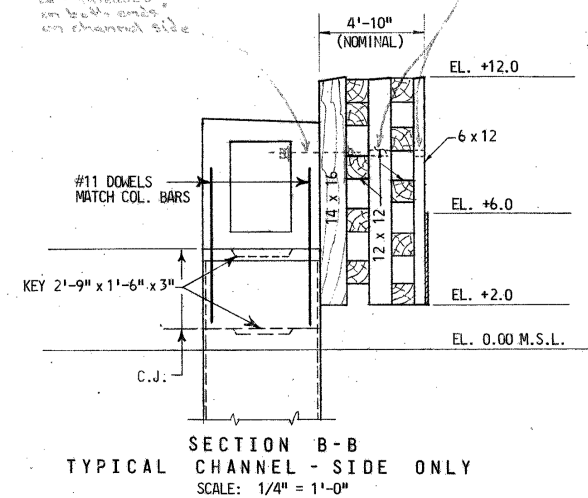


SECTION B-B
TYPICAL CHANNEL - SIDE ONLY
SCALE: 1/4" = 1'-0"

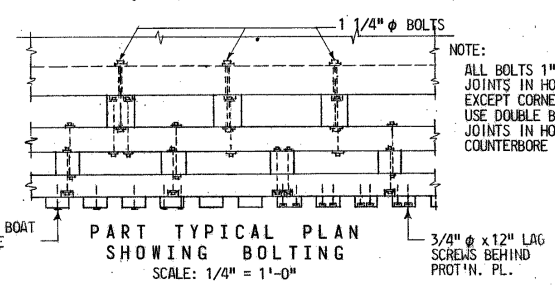


PART TYPICAL PLAN
SHOWING BOLTING
SCALE: 1/4" = 1'-0"

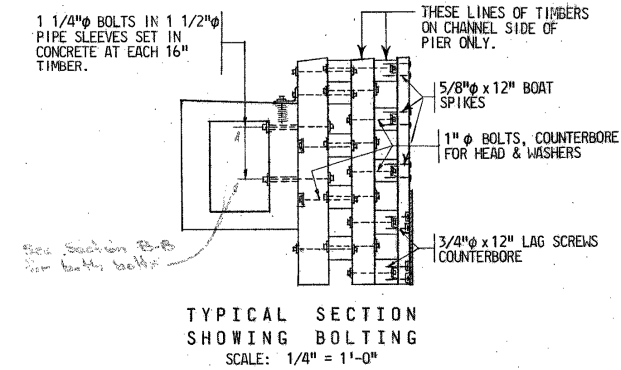


TYPICAL SECTION
SHOWING BOLTING
SCALE: 1/4" = 1'-0"

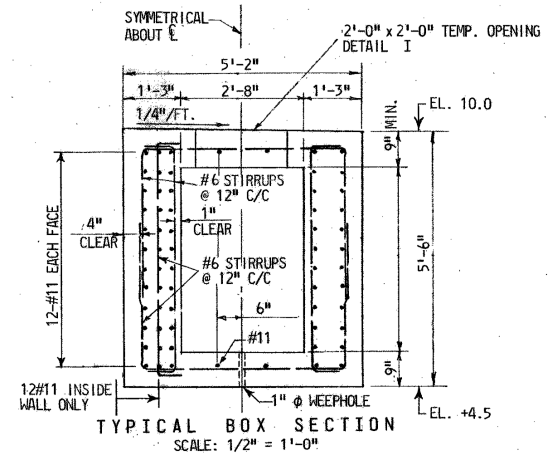


TYPICAL BOX SECTION
SCALE: 1/2" = 1'-0"

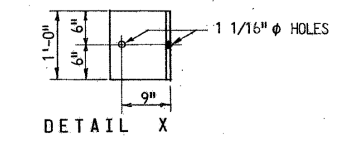


DETAIL X

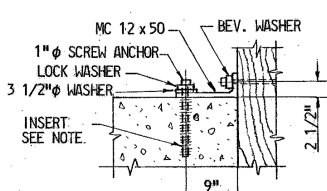


SECTION

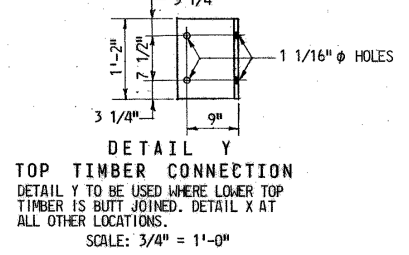


DETAIL Y
TOP TIMBER CONNECTION
DETAIL Y TO BE USED WHERE LOWER TOP TIMBER IS BUTT JOINED. DETAIL X AT ALL OTHER LOCATIONS.
SCALE: 3/4" = 1'-0"

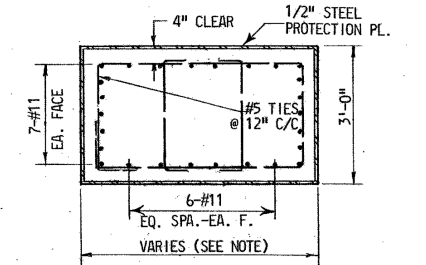


SECTION C-C
TYPICAL COLUMN SECTION
SCALE: 1/2" = 1'-0"

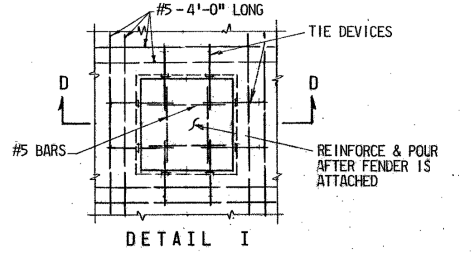

DETAIL I

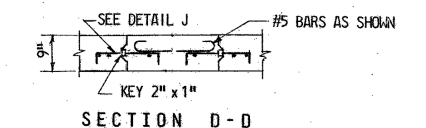


SECTION D-D

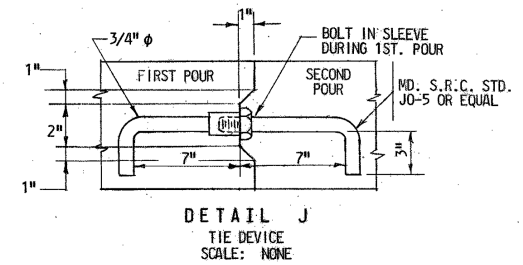


DETAIL J
TIE DEVICE
SCALE: NONE

NOTES:
FOR GENERAL NOTES SEE DWG. NO. A-102.
PROVIDE STANDARD MALLEABLE WASHERS FOR ALL BOLTS BEARING ON TIMBER.
SCREW ANCHORS FOR TOP TIMBER CONNECTIONS TO BE INSERTED WHEN CONCRETE IS POURED.
FOR DETAILS OF PIERS AND FENDER SUPPORTS SEE DWGS. NO. A-109 & A-110
FENDER COLUMNS ON N. AND S. SIDES ARE TAPERED DOWN TO FIT WITHIN FOOTING DIMENSIONS.
ALL CONCRETE AND REIN. STEEL SHALL BE PAID FOR AS "SUBSTRUCTURE CONCRETE" AND "REINFORCING STEEL".
THE CONCRETE FENDER SUPPORT SHALL BE COMPLETE BEFORE COFFERDAM IS REMOVED.
All elevations this sheet subject to Note 12 Dwg. A-102 Contract 01-89.


AS BUILT		
REVISIONS	STATE OF MARYLAND DEPARTMENT OF TRANSPORTATION STATE HIGHWAY ADMINISTRATION BALTIMORE, MD.	
	BALTIMORE HARBOR OUTER CROSSING PATAPSCO RIVER BRIDGE	
	FENDER SYSTEM PIERS 17 AND 18	
SCALE: AS NOTED	DATE JAN., 1972	CONTRACT 01-8
MADE BY: E.E.B.	J. E. GREINER COMPANY, INC. CONSULTING ENGINEERS BALTIMORE, MARYLAND	
TRACED BY: E.J.M.		
CHECKED BY: J.I.K.		
	DRAWING NO. A-114	
	SHEET NO. 14 OF 24	
	INDEXED	

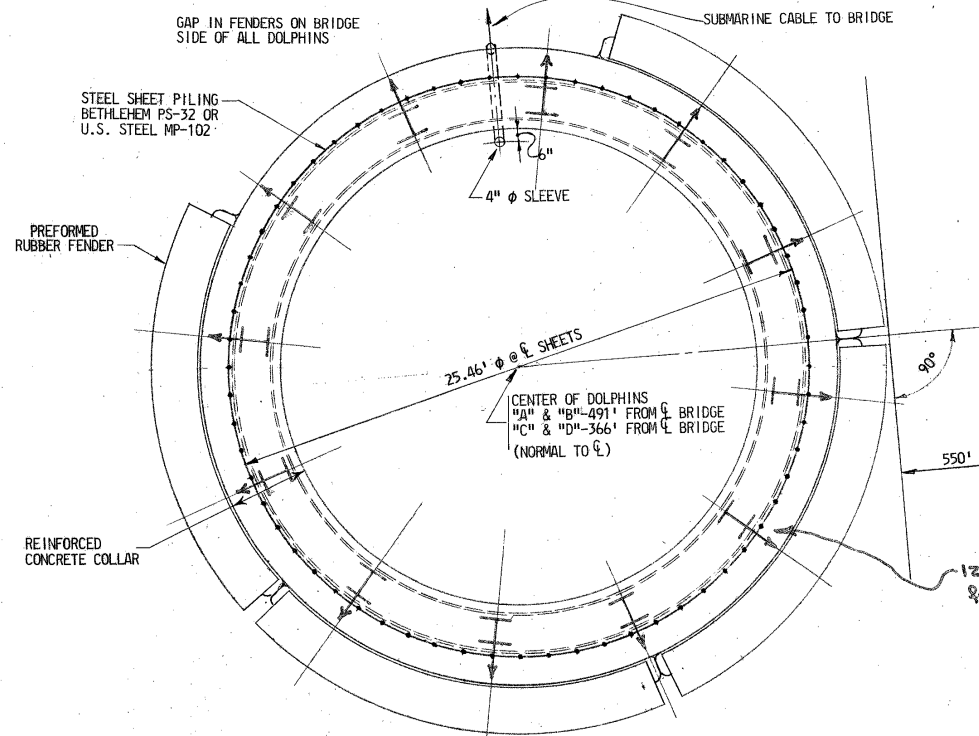


PLAN OF DOLPHIN
SCALE: 1/4" = 1'-0"

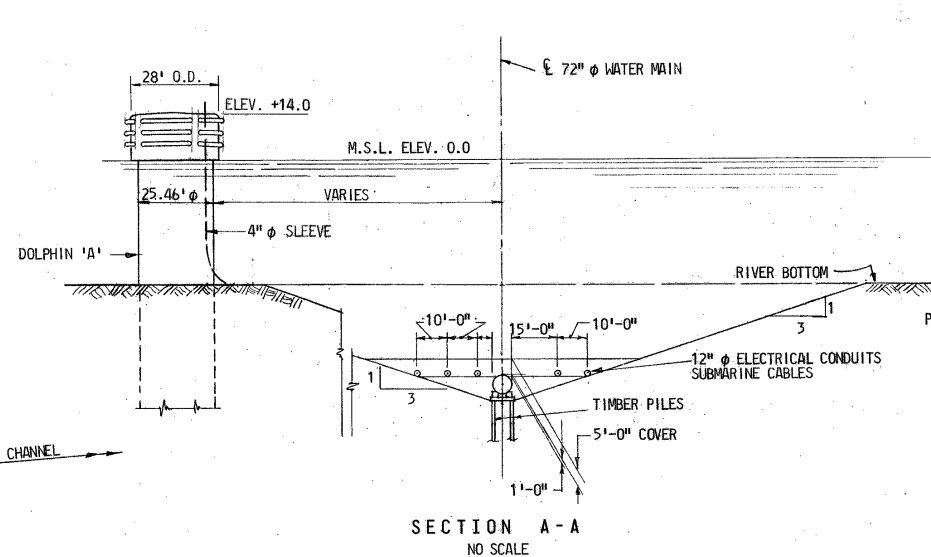


SECTION A-A
NO SCALE

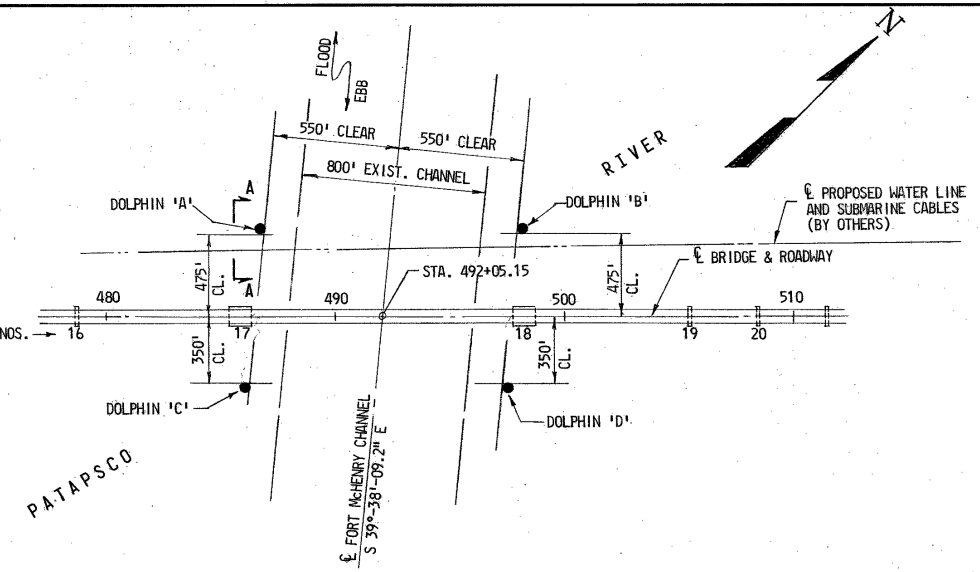

LOCATION PLAN
SCALE: 1" = 400'

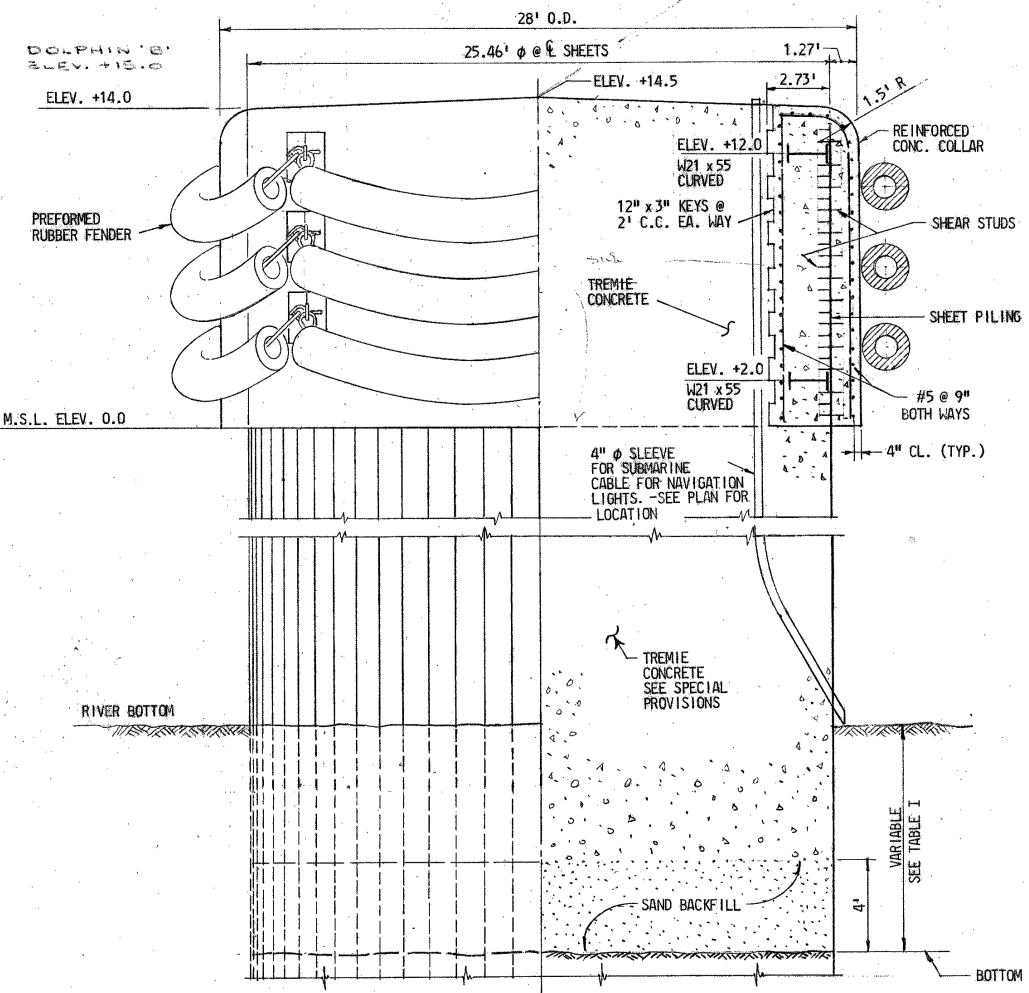


HALF ELEVATION HALF SECTION
SCALE: 1/4" = 1'-0"

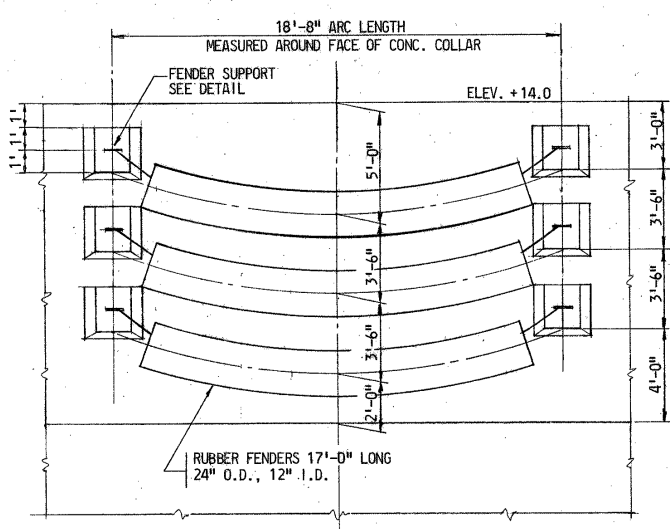


FENDER ARRANGEMENT
DEVELOPED VIEW
SCALE: 1/4" = 1'-0"


DOLPHIN	ELEVATION		
	BOTTOM OF EXC.	BOTTOM OF TREMIE	RIVER BOTTOM
A	- 52	- 48	- 40
B	- 52	- 48	- 26
C	- 52	- 48	- 40
D	- 52	- 48	- 26

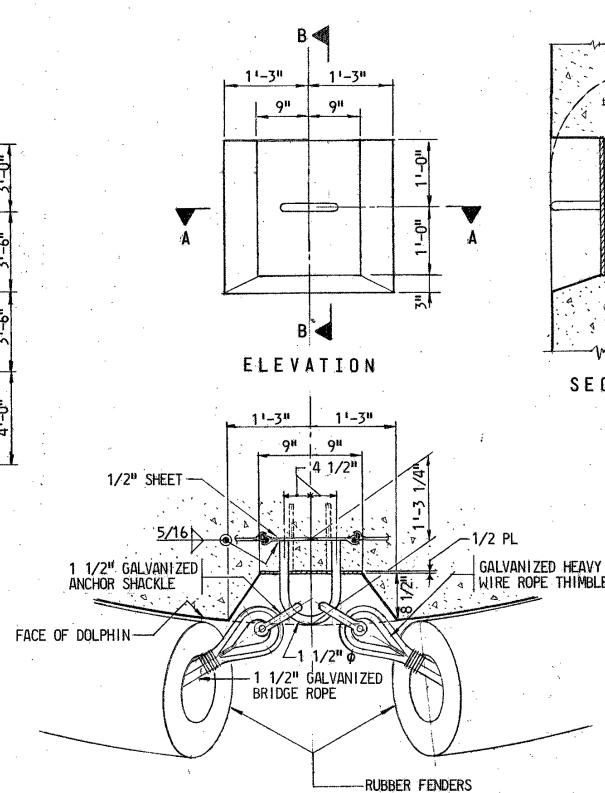

SECTION A-A
FENDER SUPPORT DETAILS
TYPICAL EXCEPT AS NOTED
SCALE: 3/4" = 1'-0"

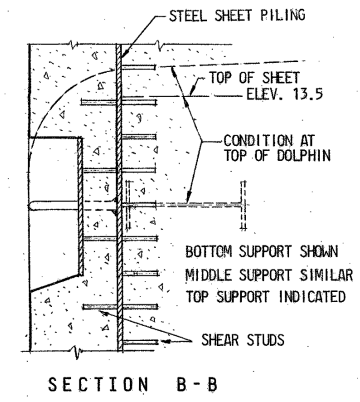


SECTION B-B

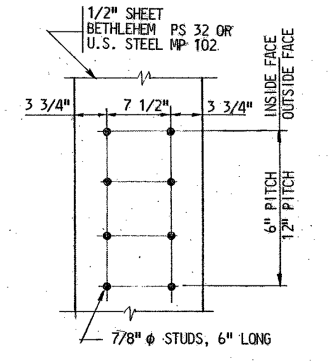


SHEAR STUD PATTERN

NOTES:
FOR GENERAL NOTES SEE DWG. NO. A-102.
THE SHEET PILING SHALL BE DRIVEN AS SPECIFIED.
MATERIAL INSIDE THE SHEETING SHALL BE EXCAVATED TO ELEVATIONS INDICATED IN TABLE I.
ALL ELEVATIONS THIS SHEET SUBJECT TO NOTE 12 DWG. A-102 CONTRACT 01-849

AS BUILT		
REVISIONS	DATE	CONTRACT
STATE OF MARYLAND DEPARTMENT OF TRANSPORTATION STATE HIGHWAY ADMINISTRATION BALTIMORE, MD. BALTIMORE HARBOR OUTER CROSSING PATAPSCO RIVER BRIDGE DOLPHINS		
SCALE AS NOTED	DATE JAN., 1972	CONTRACT OT-8
MADE BY: E.B.M.	J. F. GREINER COMPANY, INC. CONSULTING ENGINEERS BALTIMORE, MARYLAND	
TRACED BY: E.B.M.		
CHECKED BY: E.E.B.		
DRAWING NO. A-115 SHEET NO. 15 OF 24 INDEXED		

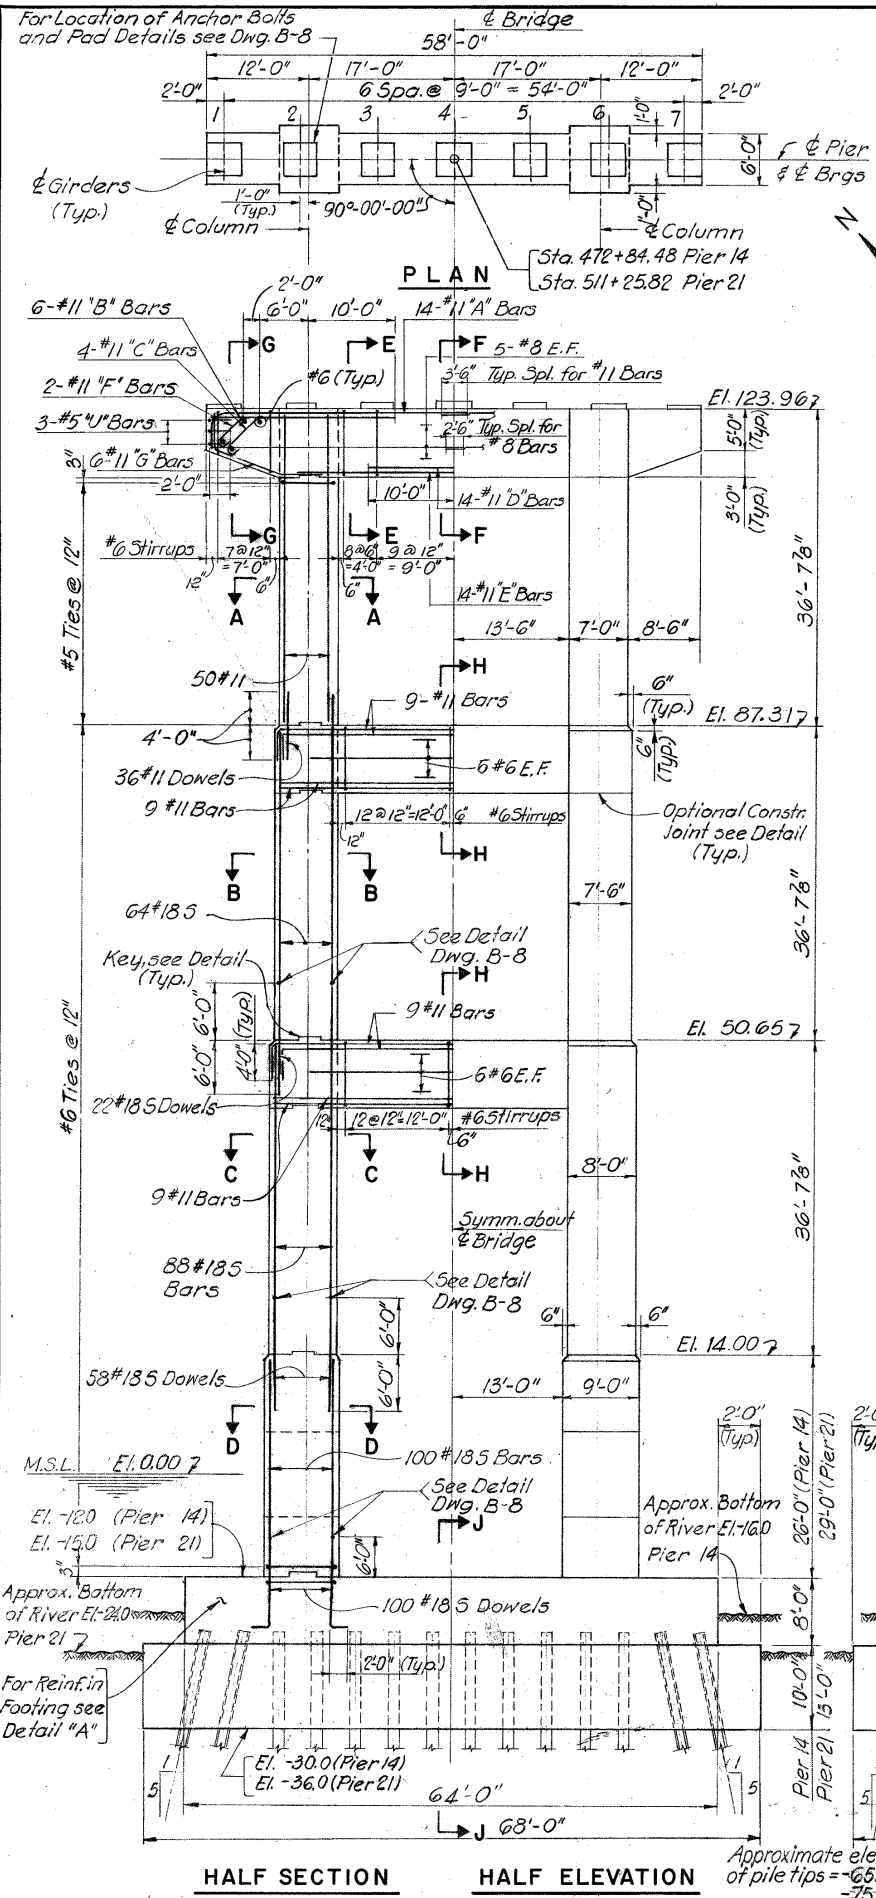


GIRDER No.	PAD ELEVATION SCHEDULE						
	1	2	3	4	5	6	7
PIER 14	124.29	124.43	124.57	124.71	124.57	124.43	124.29
PIER 21	124.29	124.43	124.57	124.71	124.57	124.43	124.29



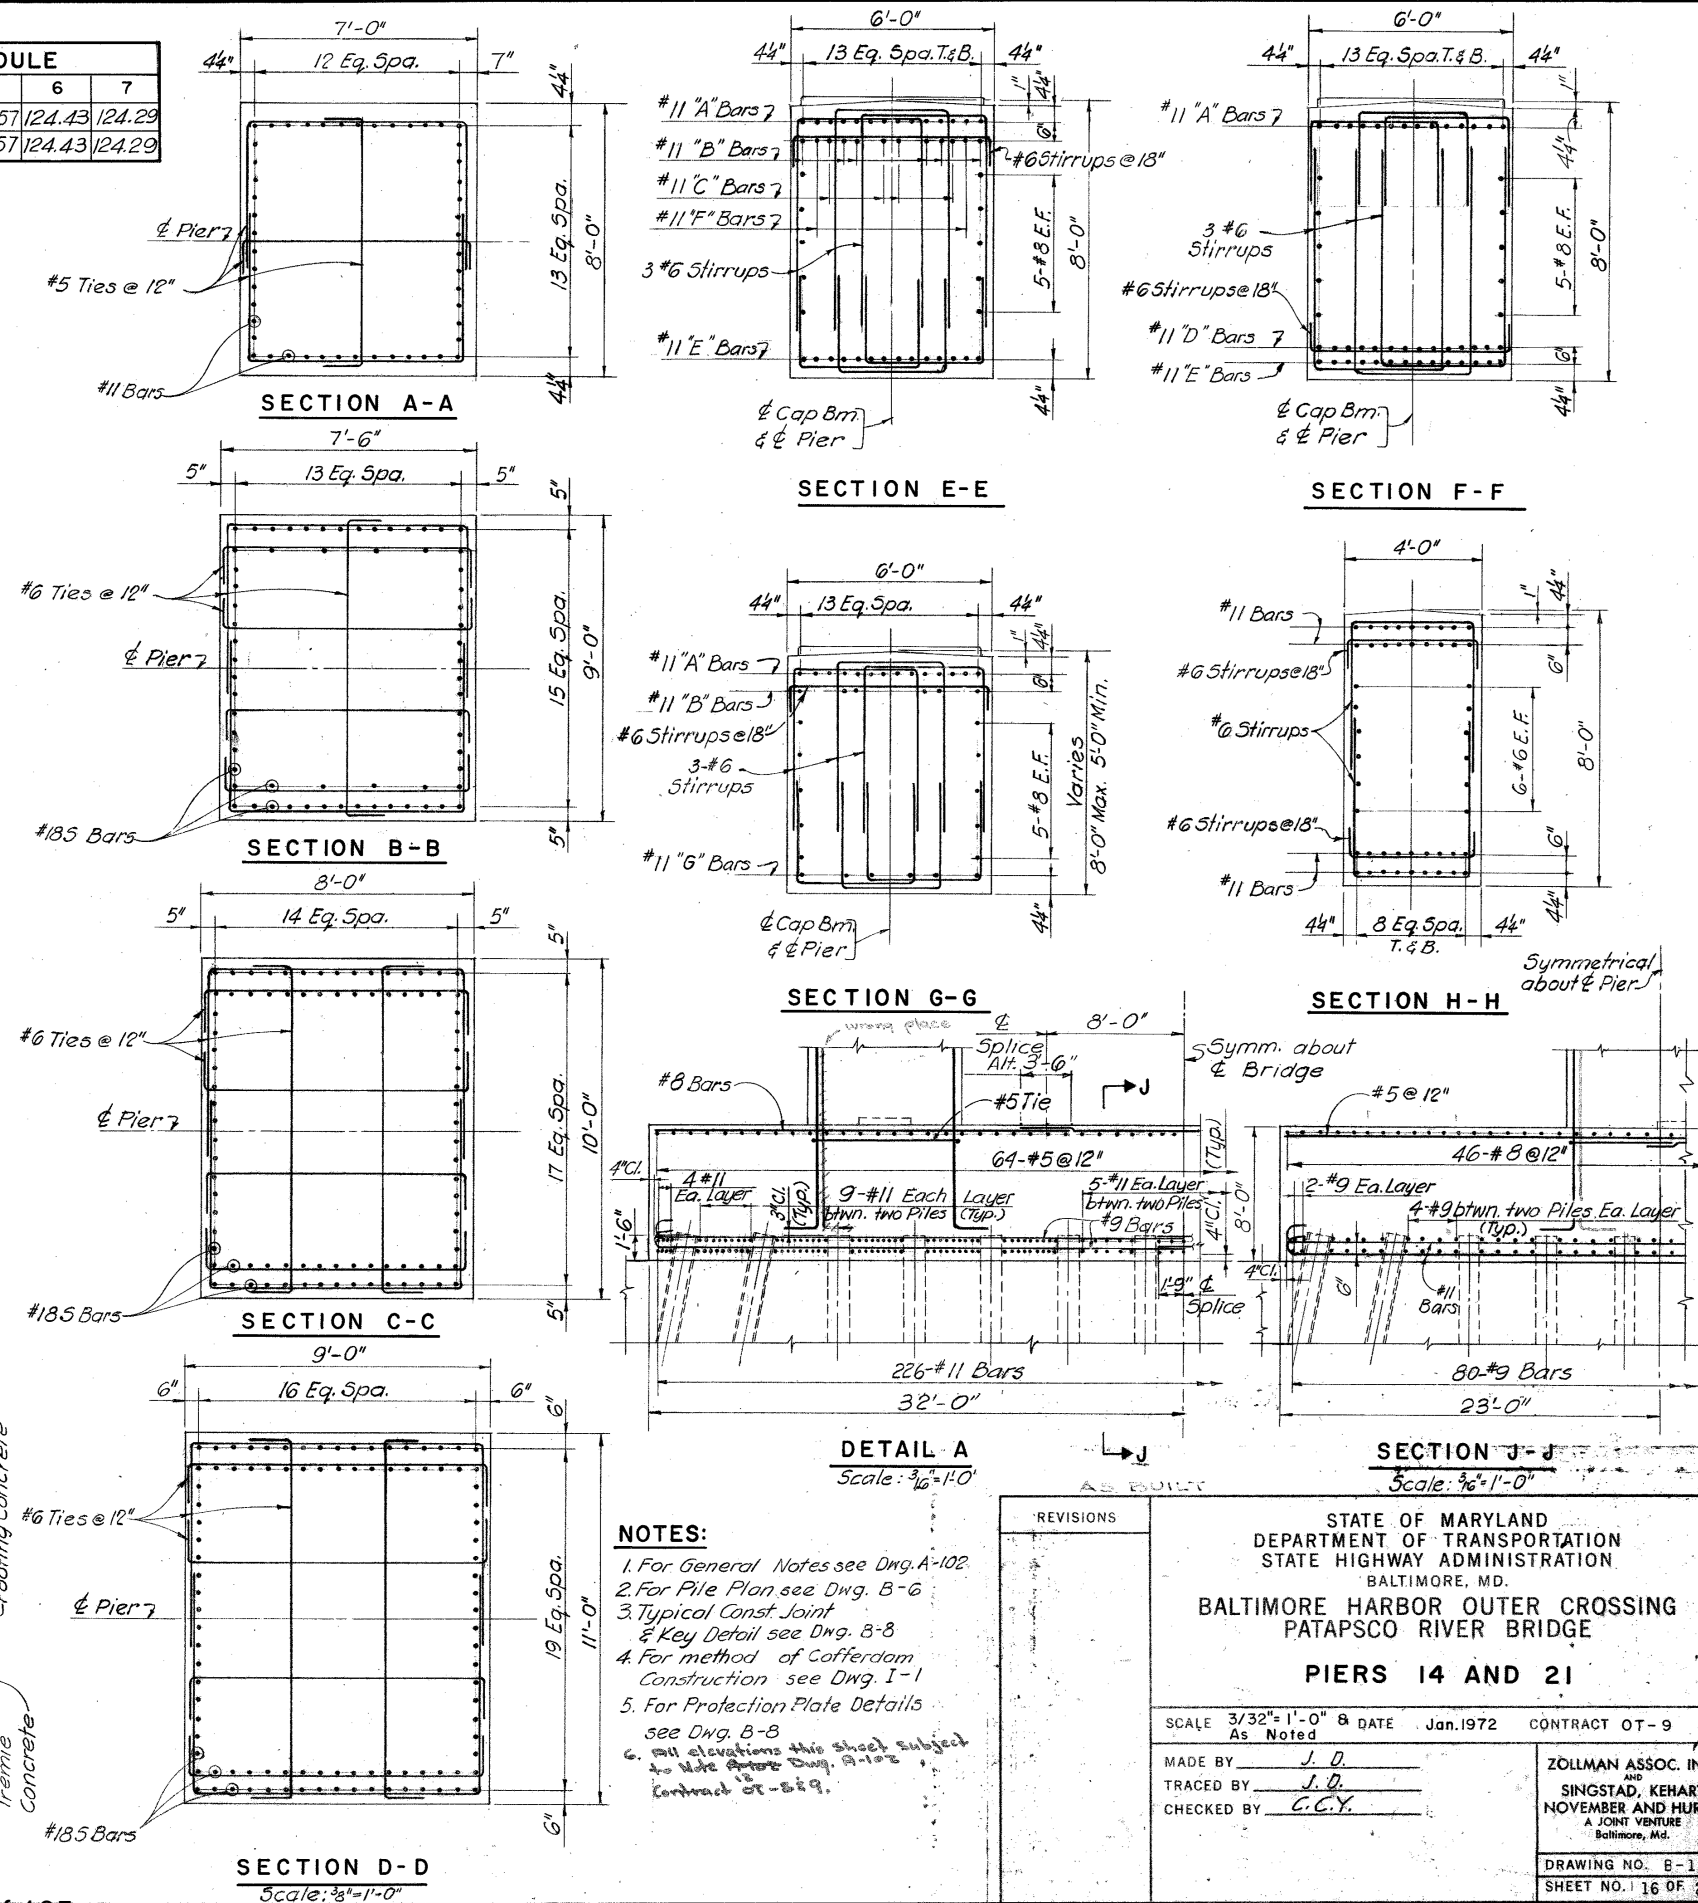


- NOTES:**
1. For General Notes see Dwg. A-102
 2. For Pile Plan see Dwg. B-6
 3. Typical Const. Joint & Key Detail see Dwg. B-8
 4. For method of Cofferdam Construction see Dwg. I-1
 5. For Protection Plate Details see Dwg. B-8
 6. All elevations this sheet subject to site survey Dwg. A-102 Contract OT-9-549.

REVISIONS		AS BUILT	
STATE OF MARYLAND DEPARTMENT OF TRANSPORTATION STATE HIGHWAY ADMINISTRATION BALTIMORE, MD.			
BALTIMORE HARBOR OUTER CROSSING PATAPSCO RIVER BRIDGE			
PIERS 14 AND 21			
SCALE 3/32" = 1'-0" & DATE Jan. 1972		CONTRACT OT-9	
MADE BY J. D.		ZOLLMAN ASSOC. INC.	
TRACED BY J. D.		SINGSTAD, KEHART NOVEMBER AND HURKA A JOINT VENTURE Baltimore, Md.	
CHECKED BY C.C.Y.		DRAWING NO. B-1	
		SHEET NO. 16 OF 24	
INDEXED			

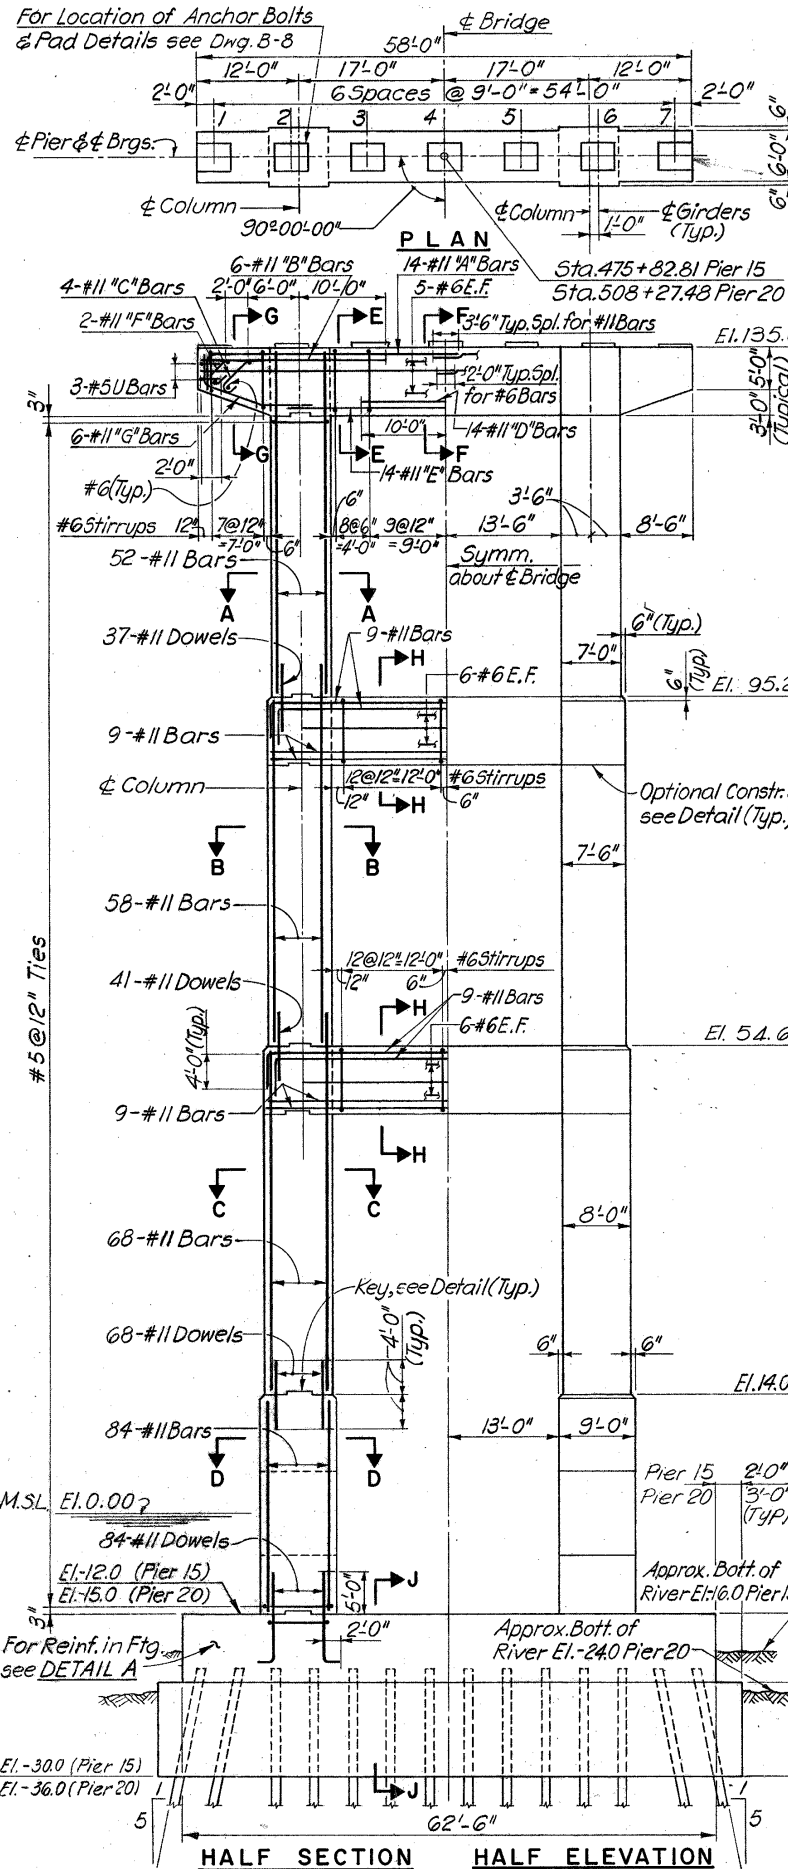

PAD ELEVATION SCHEDULE							
GIRDER No	1	2	3	4	5	6	7
PIER 15	136.22	136.37	136.51	136.65	136.51	136.37	136.22
PIER 20	136.22	136.37	136.51	136.65	136.51	136.37	136.22



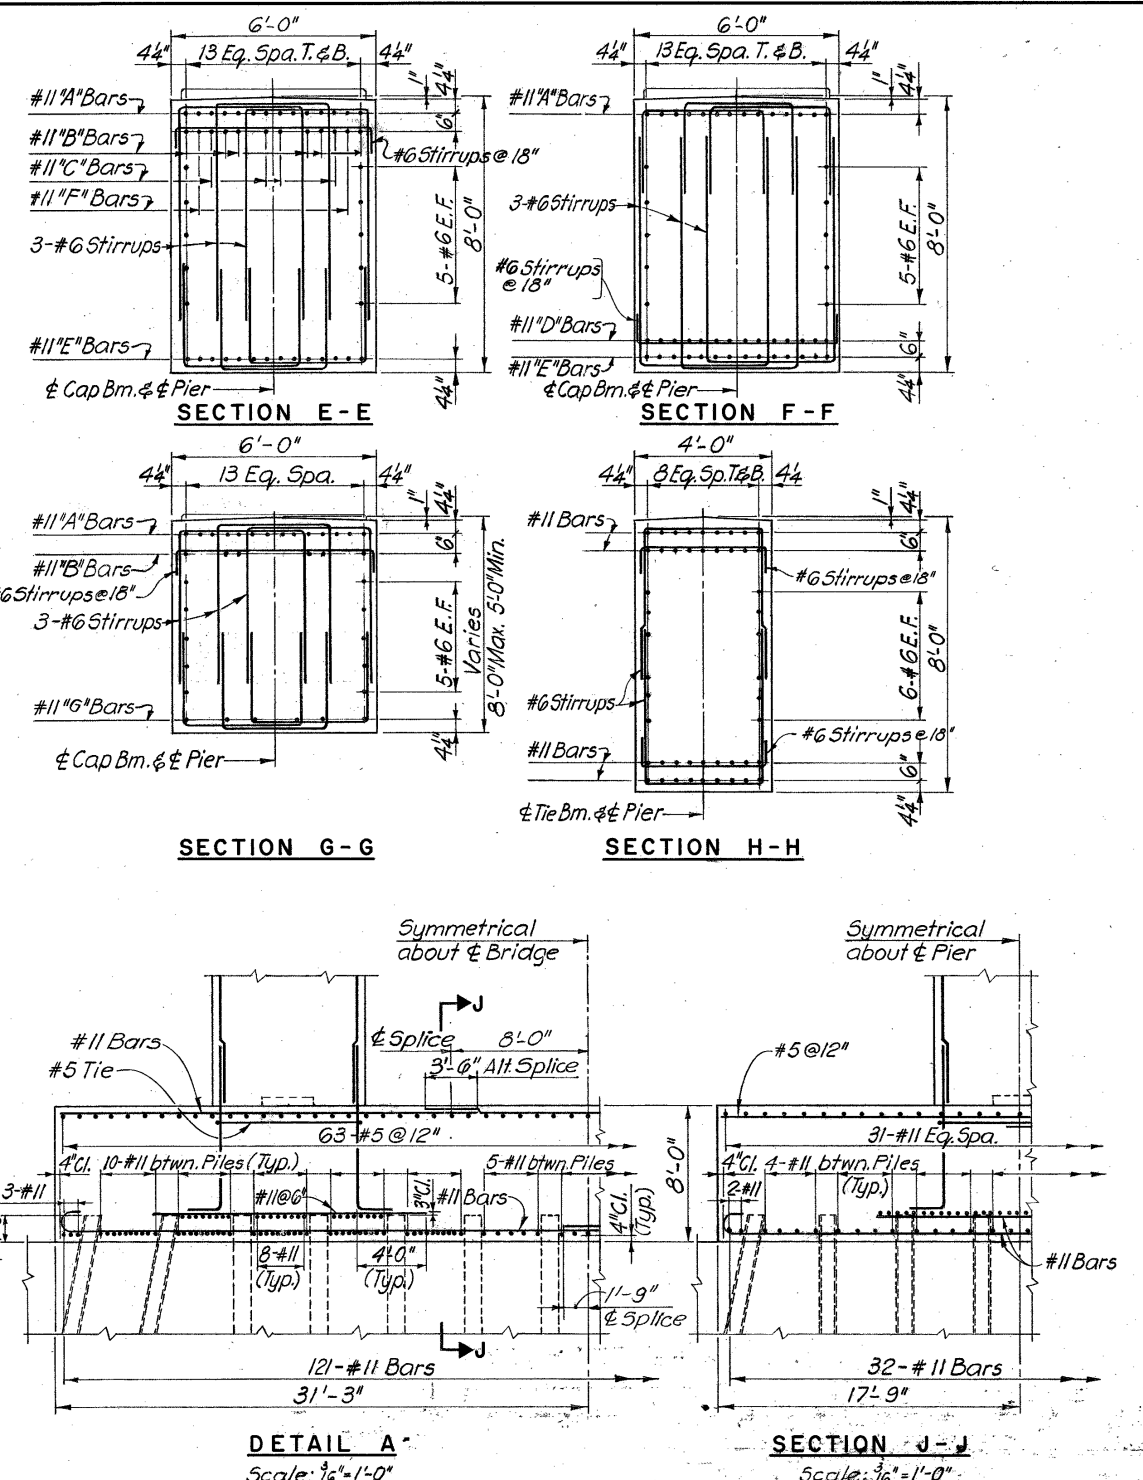
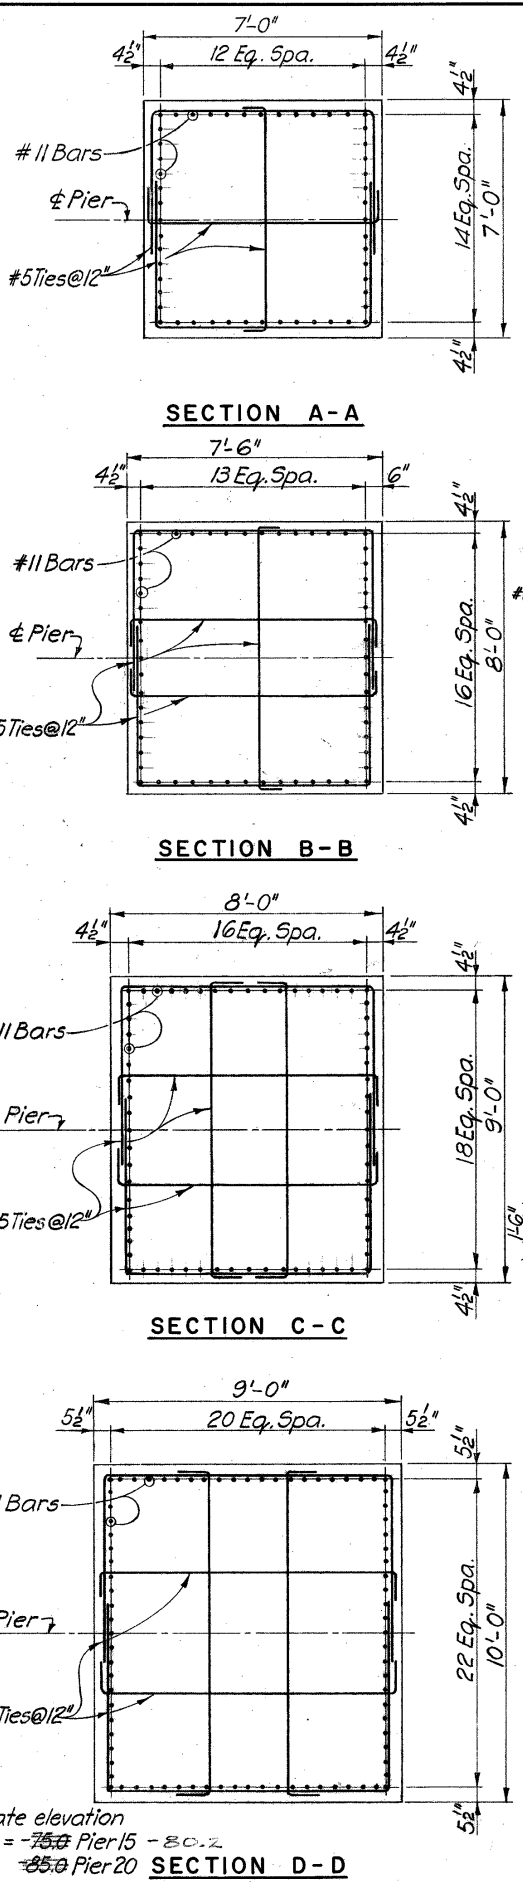
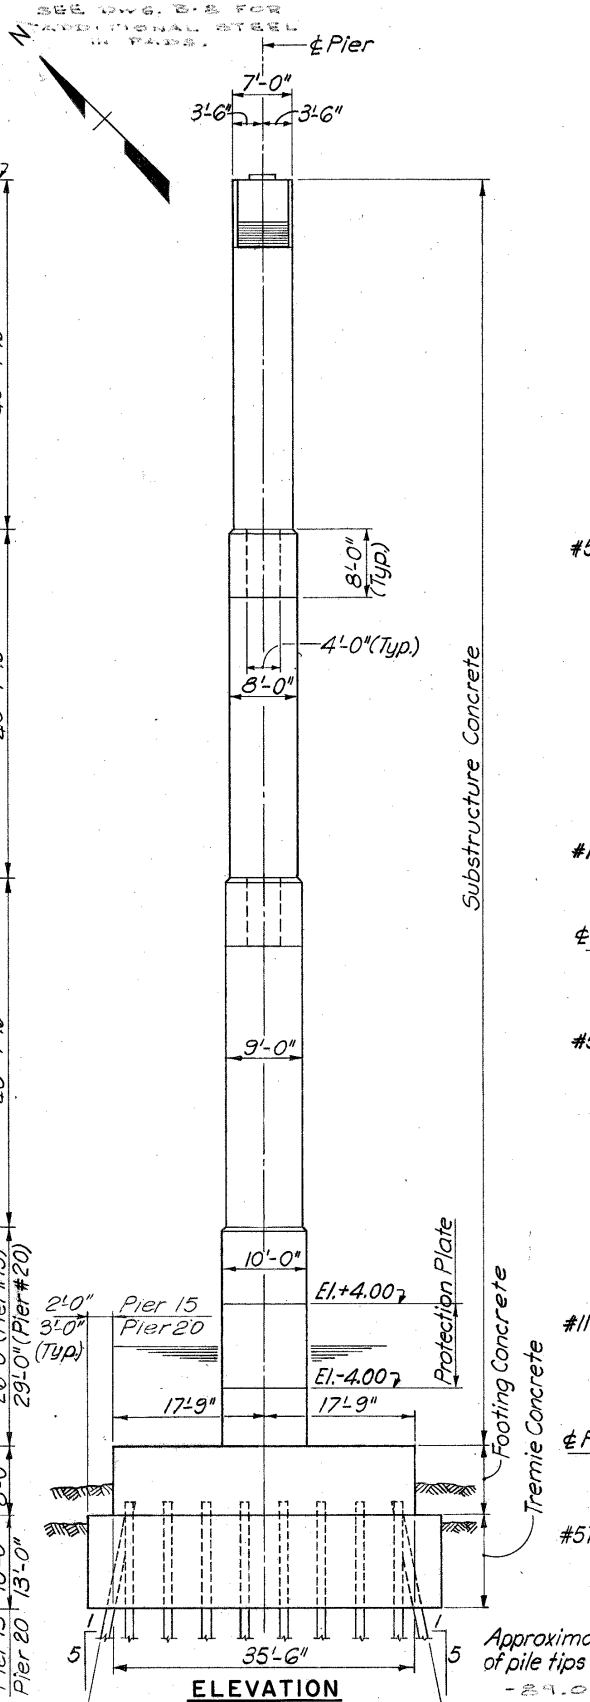


- NOTES:**
- For General Notes see Dwg. A-102
 - For Pile Plan see Dwg. B-6
 - For Typical Construction Joint and Key Detail see Dwg. B-3
 - For method of cofferdam construction see Dwg. I-1
 - For Protection Plate Details see Dwg. B-8
 - All elevations in this sheet subject to Note 12 Dwg. A-102 Contract DC-869

REVISIONS		AS BUILT	
STATE OF MARYLAND DEPARTMENT OF TRANSPORTATION STATE HIGHWAY ADMINISTRATION BALTIMORE, MD.			
BALTIMORE HARBOR OUTER CROSSING PATAPSCO RIVER BRIDGE			
PIERS 15 AND 20			
SCALE	3/32"=1'-0" & As Noted	DATE	Jan. 1972
		CONTRACT	OT-9
MADE BY	O.S.	ZOLLMAN ASSOC. INC. AND SINGSTAD, KEHART NOVEMBER AND HURKA A JOINT VENTURE Baltimore, Md.	
TRACED BY	O.S.		
CHECKED BY	C.C.Y.		
DRAWING NO. B-2		SHEET NO. 17 OF 24	
INDEXED			

For Location of Anchor Bolts & Pad Details see Dwg. B-8


PAD ELEVATION SCHEDULE							
GIRDER No.	1	2	3	4	5	6	7
ELEV.	100.30	100.45	100.59	100.73	100.59	100.45	100.30

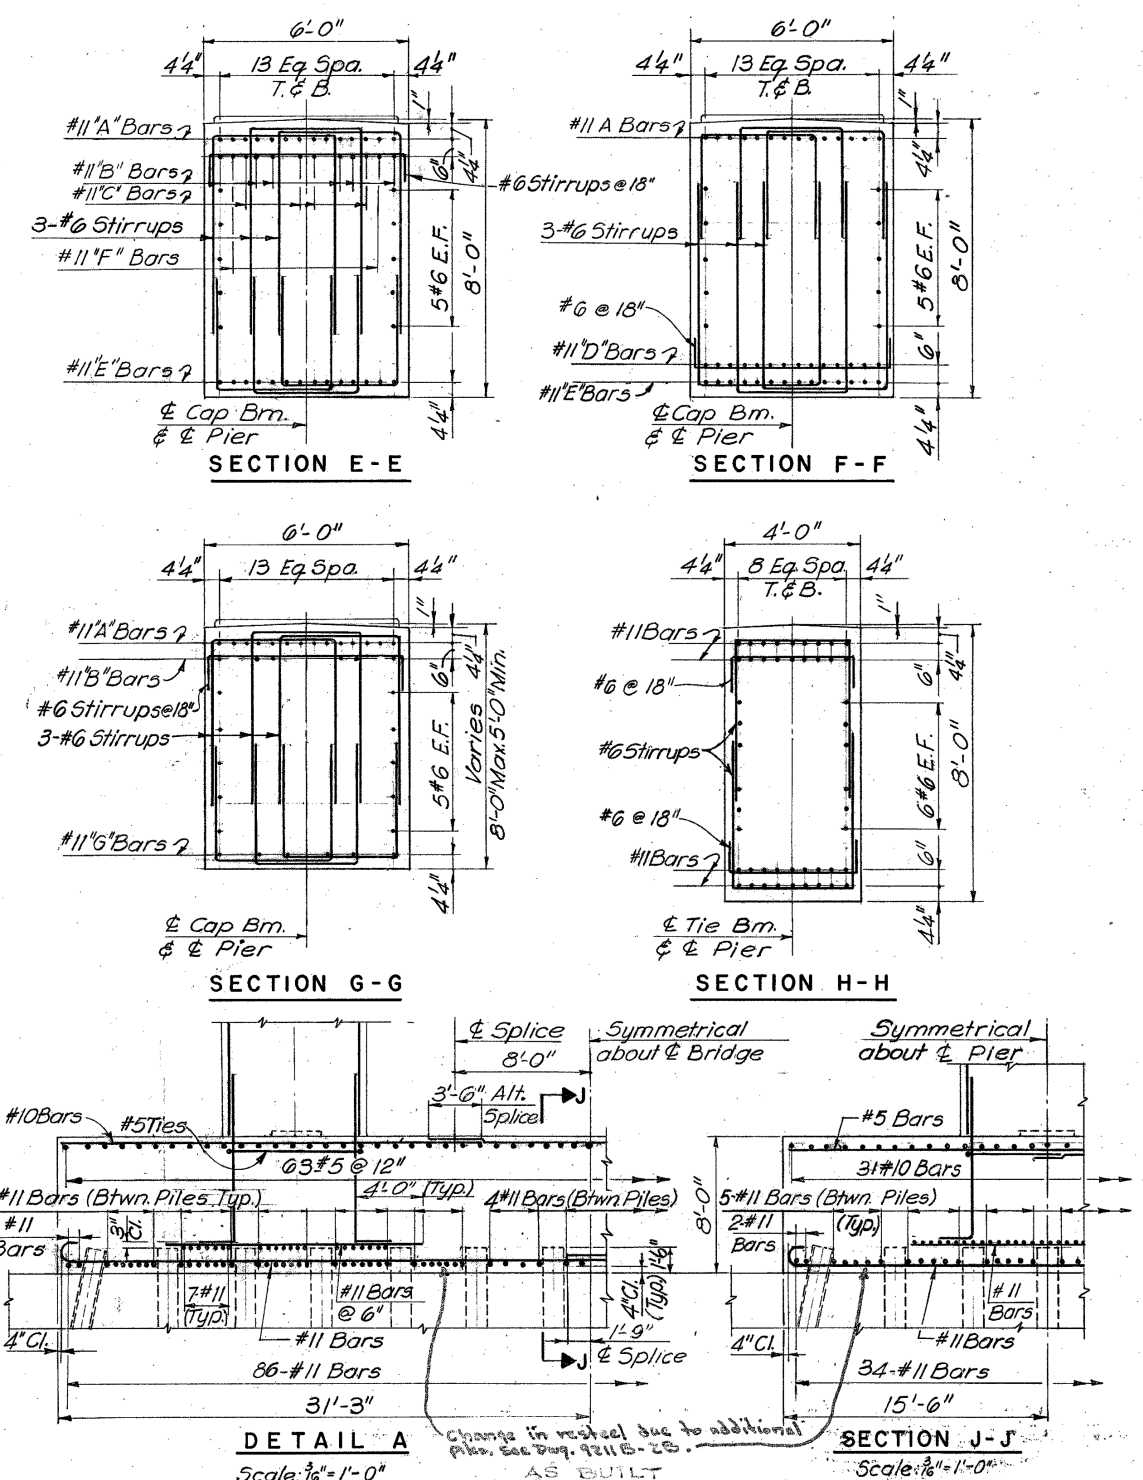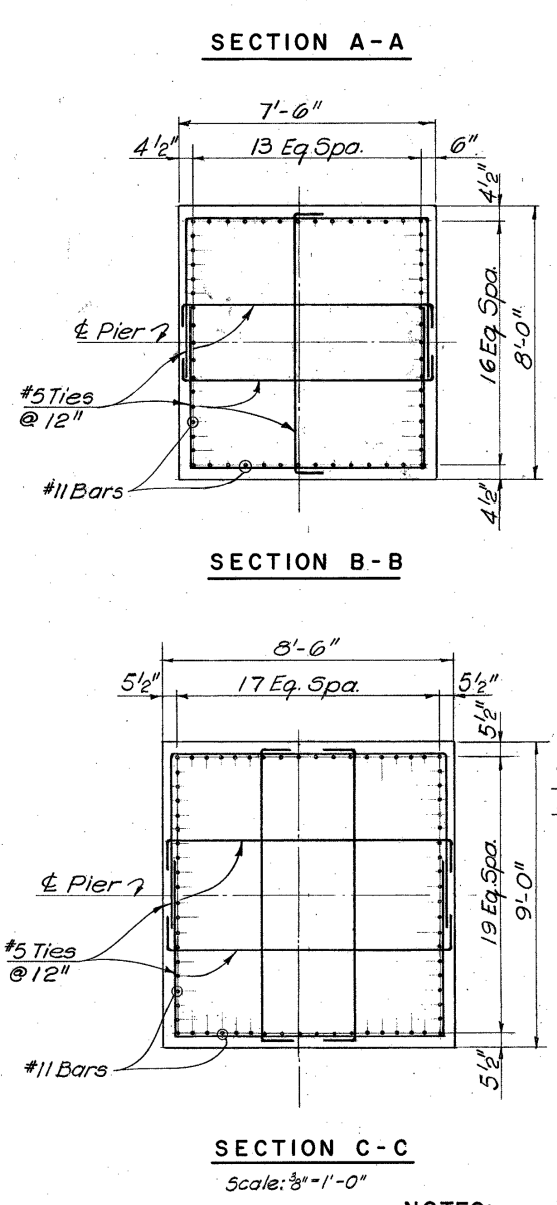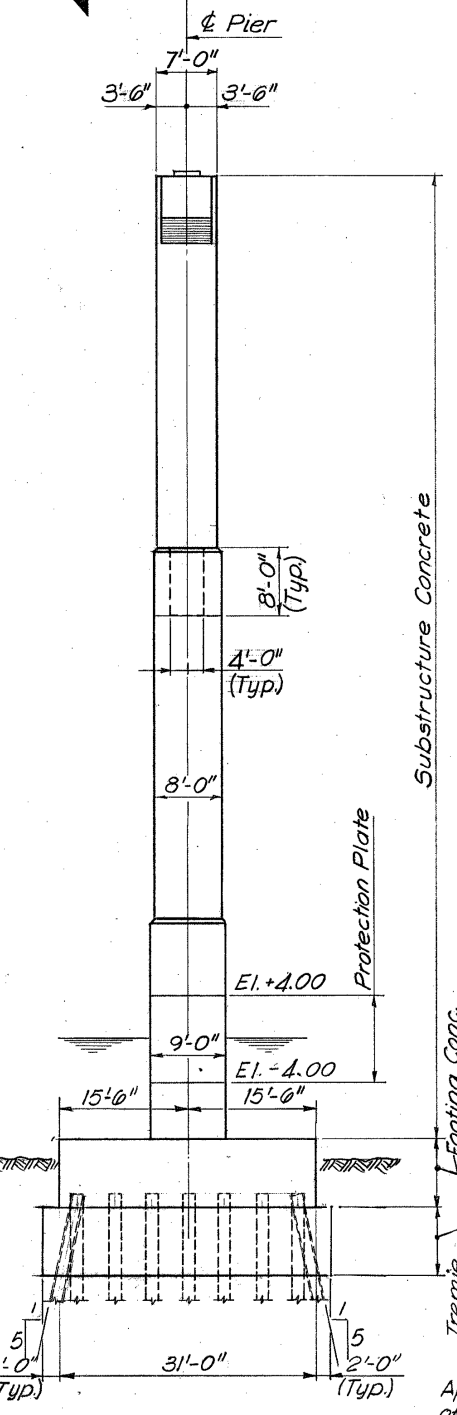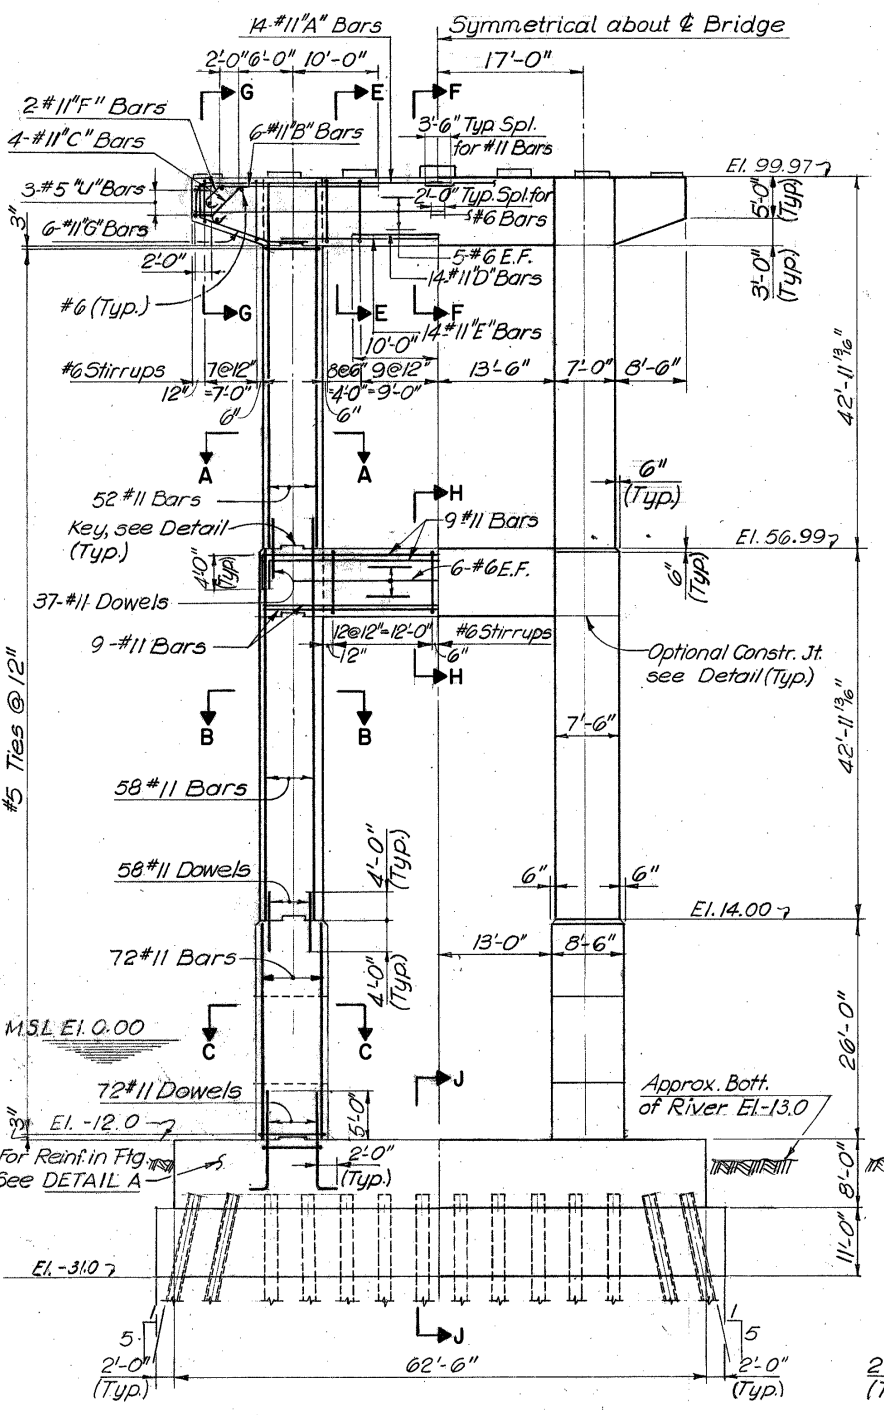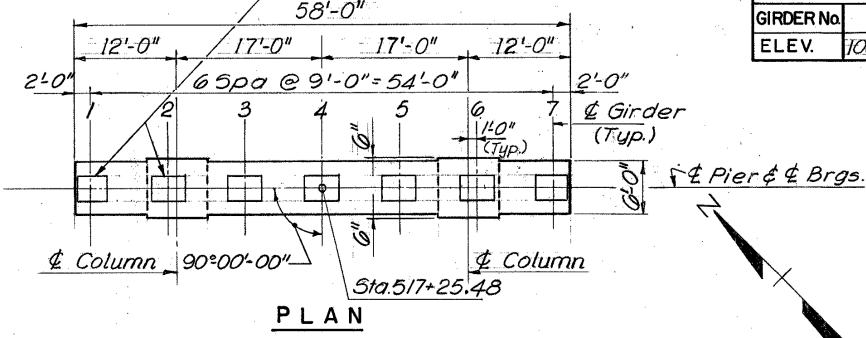


DETAIL A
Scale: 3/8" = 1'-0"

- NOTES:
1. For General Notes see Dwg. A-102
 2. For Pile Plan see Dwg. B-6
 3. For Typical Construction Joint and Key Detail see Dwg. B-8
 4. For method of cofferdam construction see Dwg. I-1
 5. For Protection Plate see Dwg. B-8
 6. All elevations this sheet subject to Note 12 Dwg. A-102 Cont. of B-8.




REVISIONS		STATE OF MARYLAND DEPARTMENT OF TRANSPORTATION STATE HIGHWAY ADMINISTRATION BALTIMORE, MD. BALTIMORE HARBOR OUTER CROSSING PATAPSCO RIVER BRIDGE PIER 23	
SCALE 3/32" = 1'-0" & DATE Jan. 1972 CONTRACT OT-9 As Noted		ZOLLMAN ASSOC. INC. AND SINGSTAD, KEHART NOVEMBER AND HURKA A JOINT VENTURE Baltimore, Md.	
MADE BY R.R. TRACED BY R.B. CHECKED BY C.C.V.		DRAWING NO. B-4 SHEET NO. 19 OF 24 INDEXED	

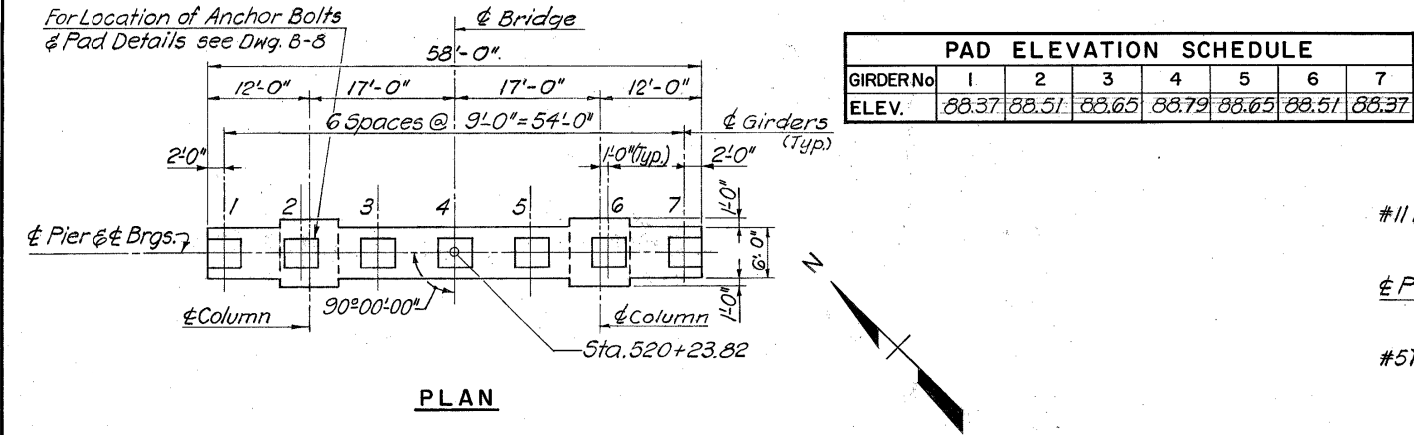

PAD ELEVATION SCHEDULE							
GIRDER NO.	1	2	3	4	5	6	7
ELEV.	88.37	88.51	88.65	88.79	88.65	88.51	88.37

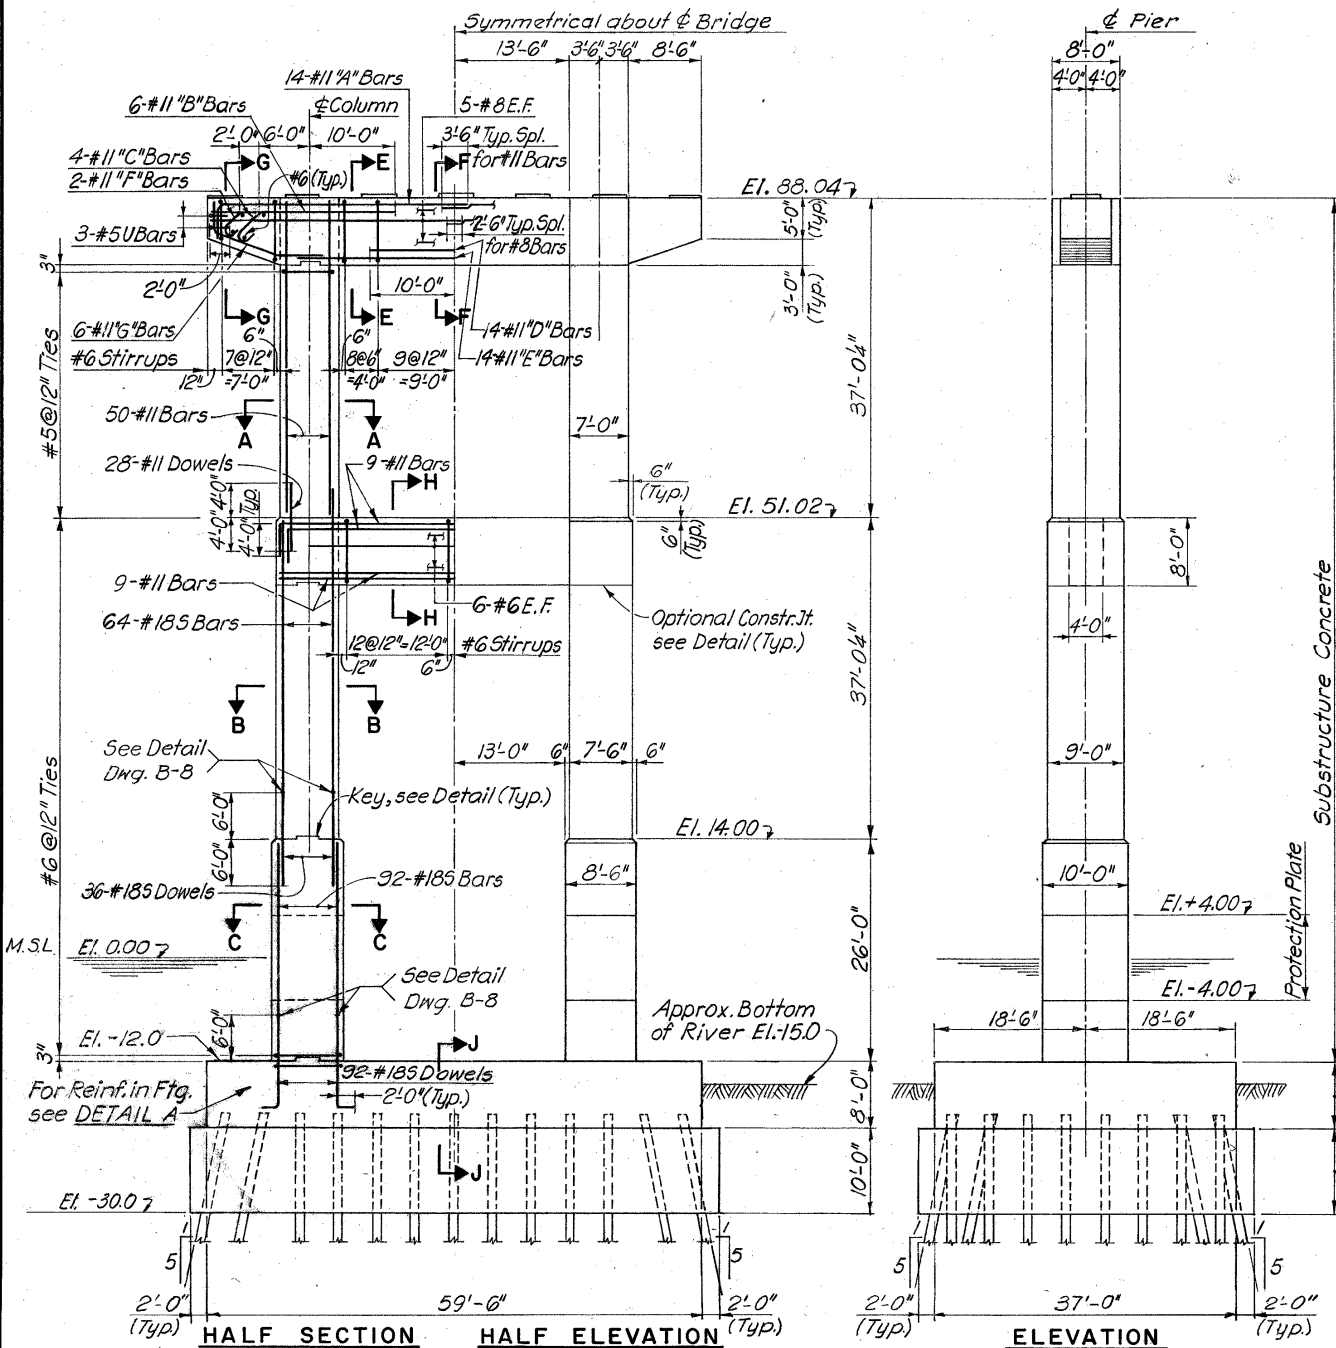







Approximate elevation of pile tips = -105.6 - 116.3

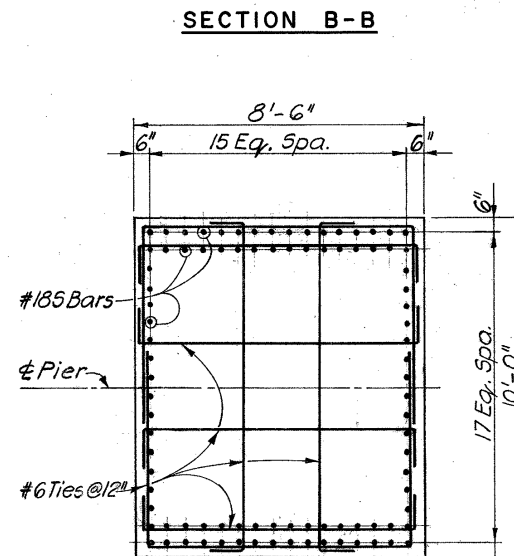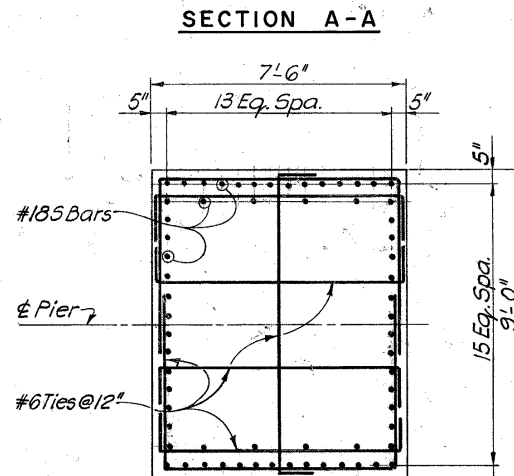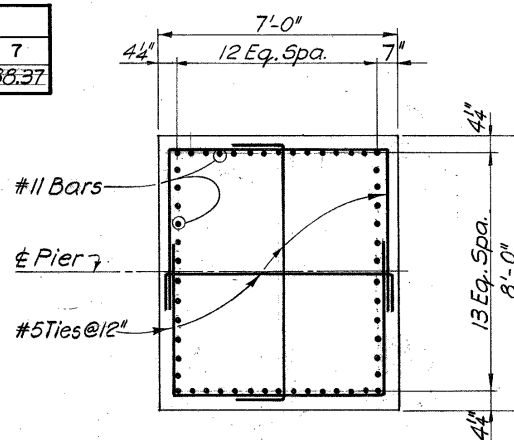

SECTION C-C Scale: 3/8"=1'-0"



NOTES:

1. For General Notes see Dwg. A-102
2. For Pile Plan see Dwg. B-6
3. For Typical Construction Joint & Key Detail see Dwg. B-8
4. For method of cofferdam construction see Dwg. I-1
5. For Protection Plate Details see Dwg. B-8
6. All elevations this sheet subject to Note 12 Dwg. A-102 Contract No. B-29.

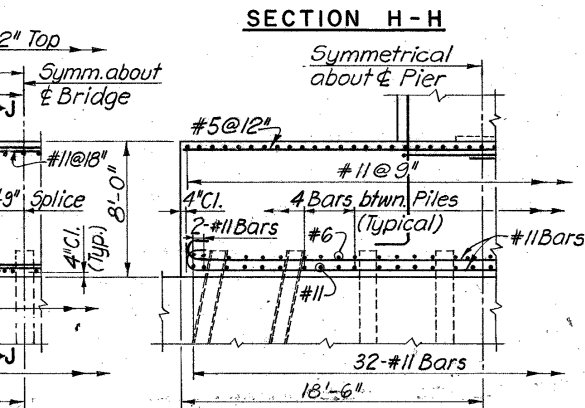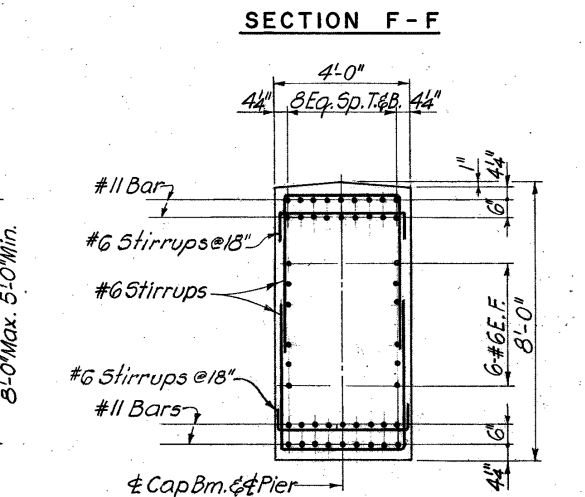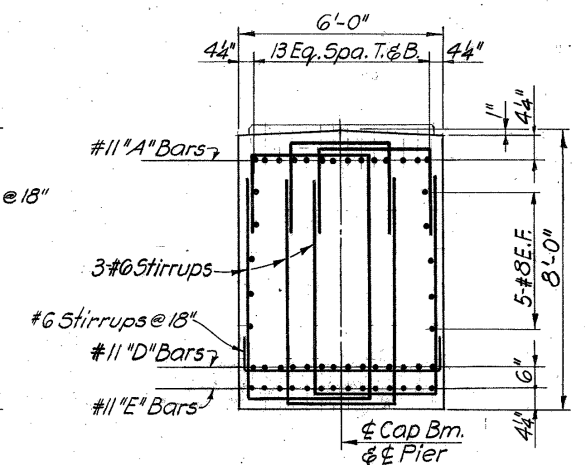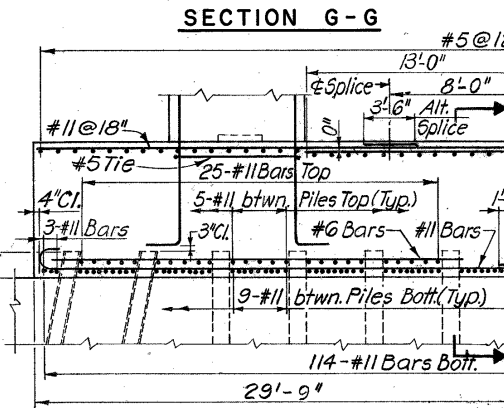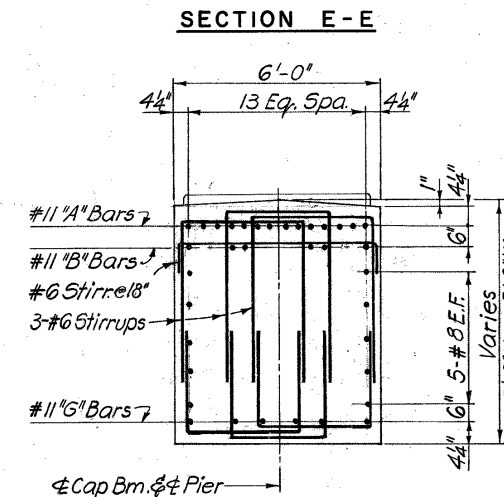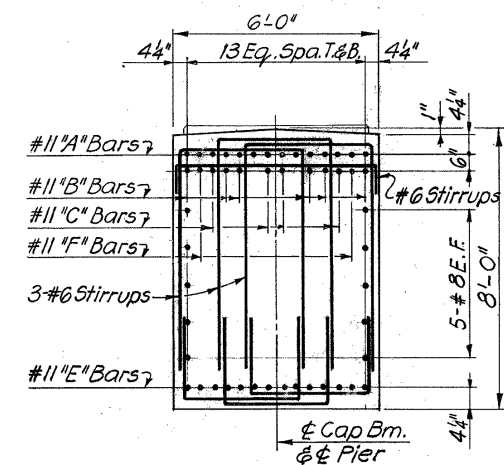


AS BUILT		STATE OF MARYLAND DEPARTMENT OF TRANSPORTATION STATE HIGHWAY ADMINISTRATION BALTIMORE, MD.	
BALTIMORE HARBOR OUTER CROSSING PATAPSCO RIVER BRIDGE			
PIER 24			
SCALE 3/32"=1'-0" & As Noted	DATE Jan. 1972	CONTRACT OT 99	
MADE BY O.S.	TRACED BY O.S.	CHECKED BY C.C.Y.	ZOLLMAN ASSOC. INC. AND SINGSTAD, KEHART NOVEMBER AND HURKA A JOINT VENTURE Baltimore, Md.
DRAWING NO. B-5			INDEXED
SHEET NO. 20 OF 24			

NOTE: FOR DETAILS NOT SHOWN SEE
PART PLAN OF FENDER SHEET NO. 4

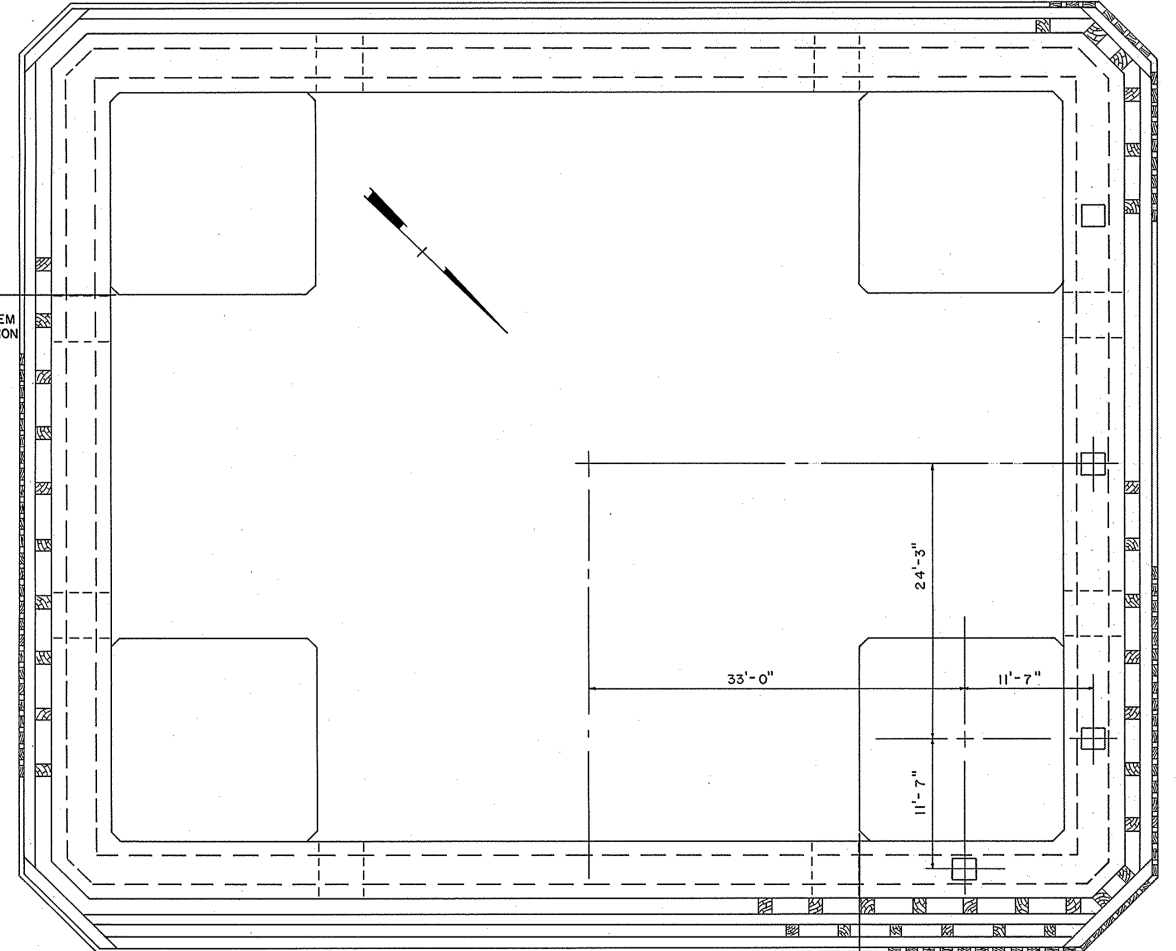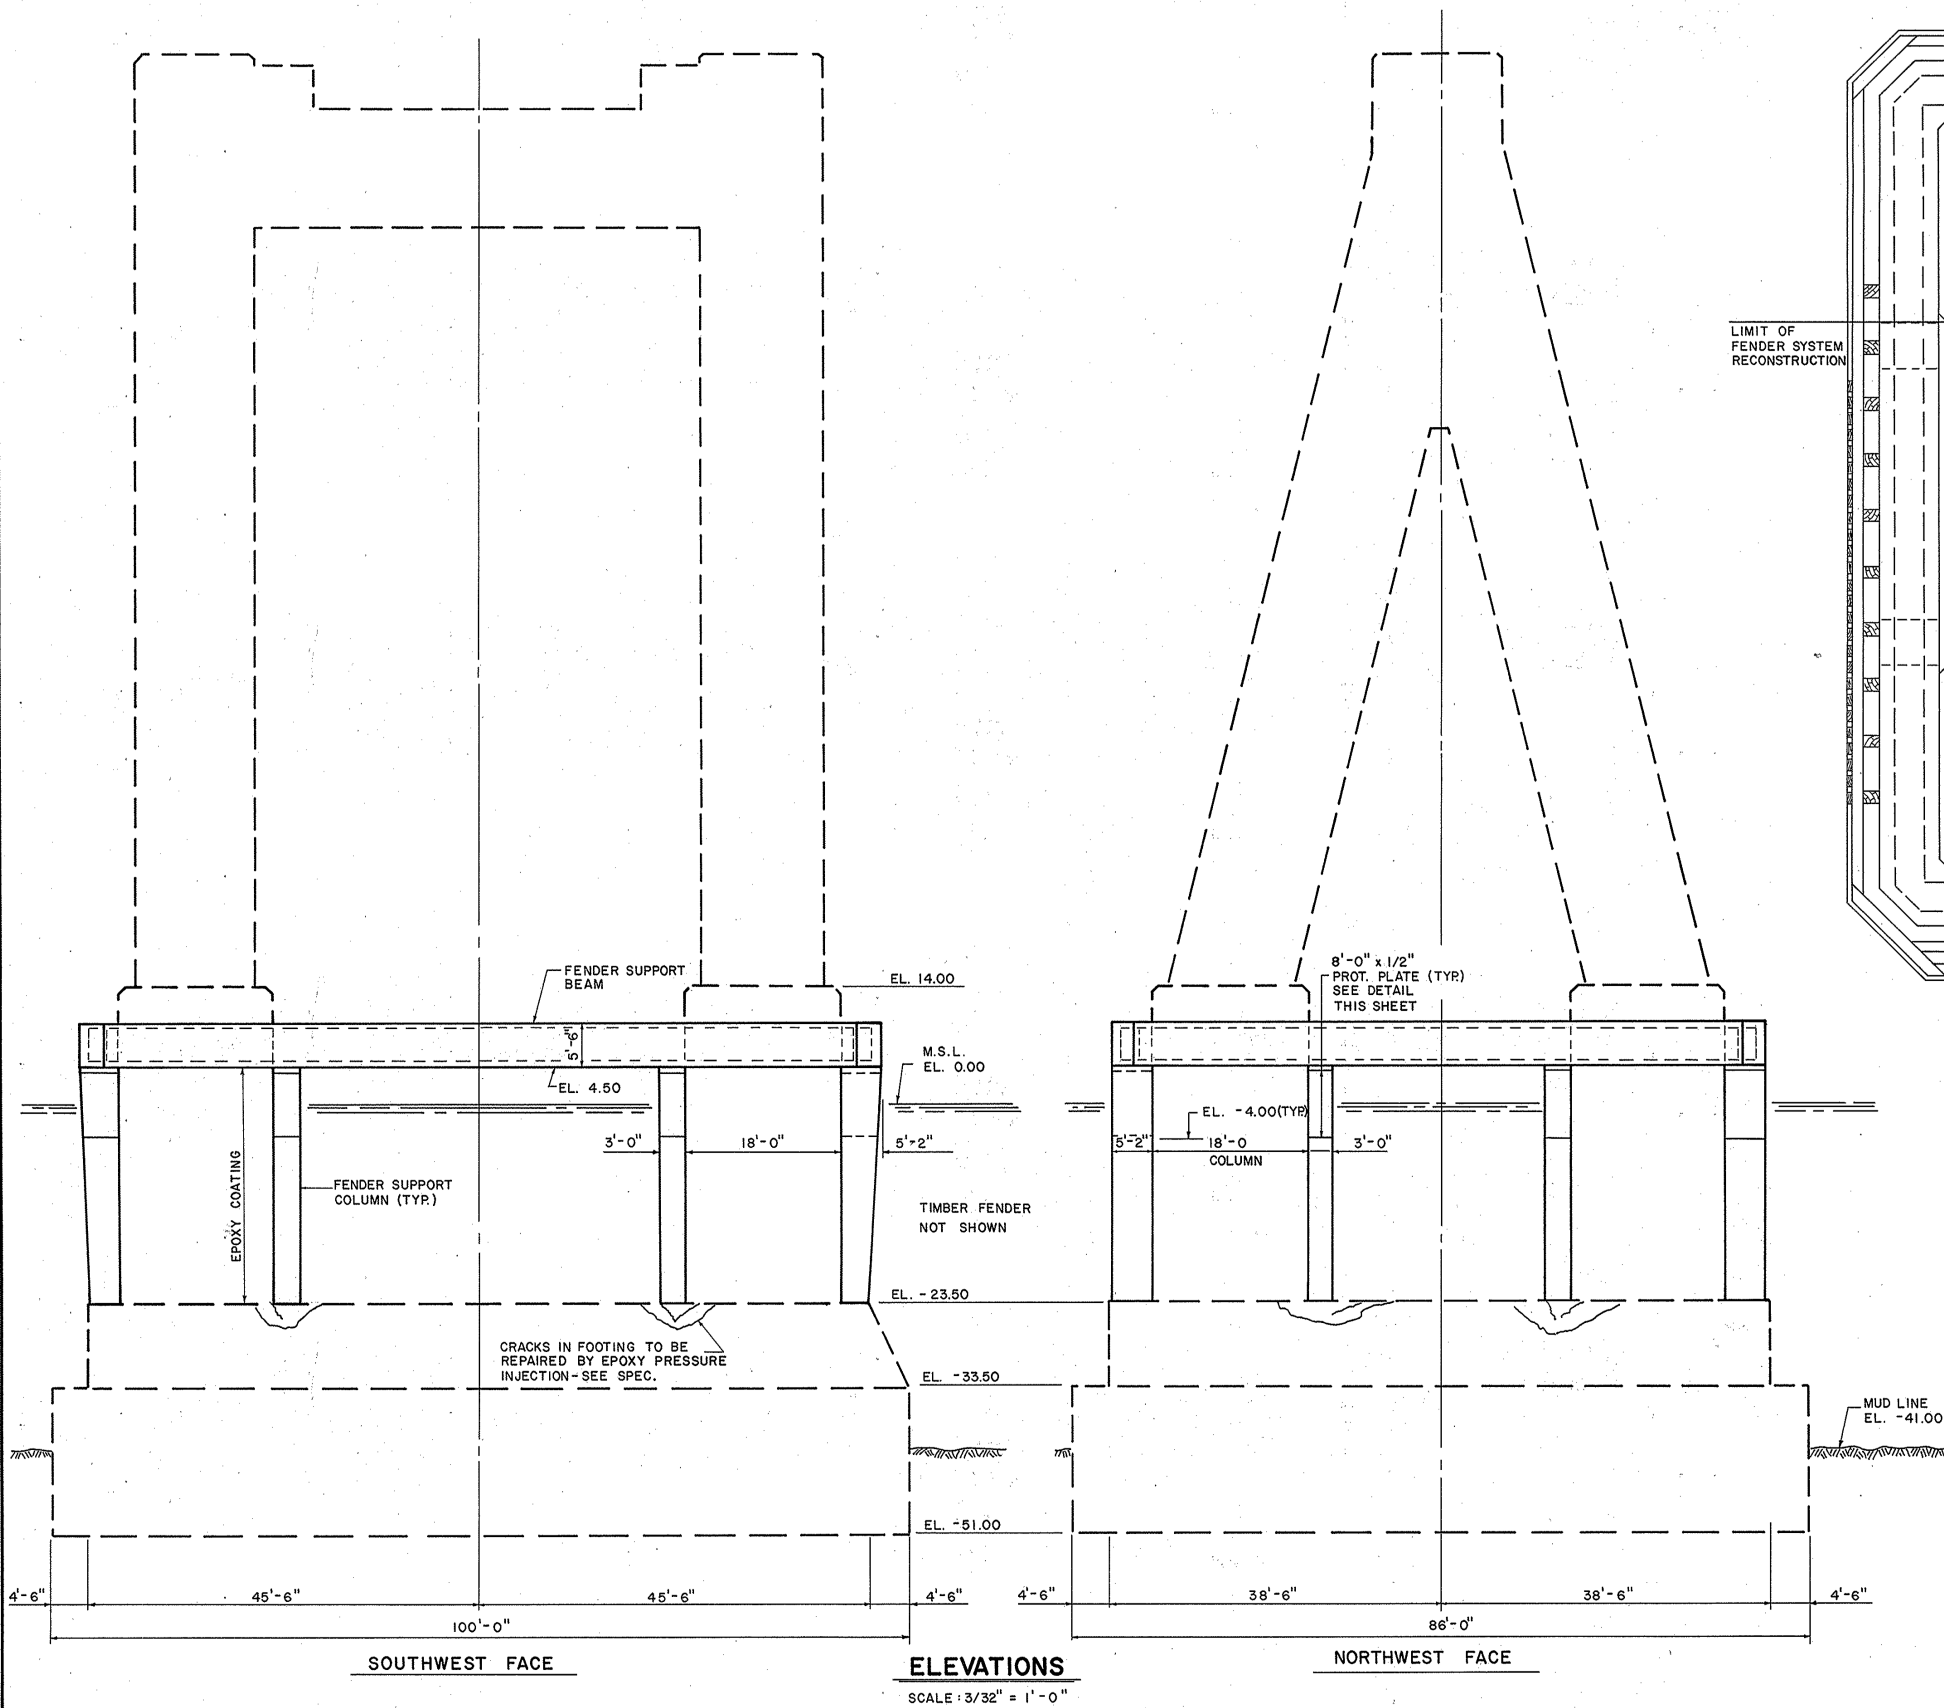

PLAN VIEW
SCALE: 1/8" = 1'-0"

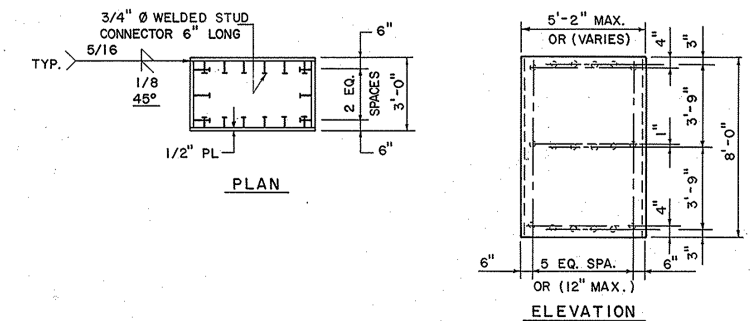

PROTECTION PLATE DETAIL
SCALE: 1/4" = 1'-0"

REVISIONS	STATE OF MARYLAND DEPARTMENT OF TRANSPORTATION TOLL FACILITIES ADMINISTRATION PIER 17 FENDER SYSTEM PLAN AND ELEVATION
	CONT. NO. <u>BRB 4-722</u> PREL. TRAC. BY <u>J.C.U.</u> FINAL TRAC. BY <u>J.C.U.</u> SHEET NO. <u>3</u> OF <u>5</u>



MARYLAND TRANSPORTATION AUTHORITY

BIN: BCZ472001

Date: 03/29/2021

MD 695

OVER PATAPSCO RIVER

Photos

PHOTO NO.: GENERAL
PHOTO - 6-Bridge-Channel 2

Location: Channel Looking
North



PHOTO NO.: GENERAL
PHOTO - Non-Bridge-2nd
General Picture

Location: Typical Main
Channel Pier and Fender
System (Pier 18, West
Elevation Shown)





MARYLAND TRANSPORTATION AUTHORITY

BIN: BCZ472001

Date: 03/29/2021

MD 695

OVER PATAPSCO RIVER

PHOTO NO.: GENERAL
PHOTO - 5-Bridge-Channel 1

Location: Channel Looking
South



PHOTO NO.: GENERAL
PHOTO - Non-Bridge-2nd
General Picture

Location: Typical Dolphin
(Dolphin 4 Shown)





MARYLAND TRANSPORTATION AUTHORITY

BIN: BCZ472001

Date: 03/29/2021

MD 695

OVER PATAPSCO RIVER

PHOTO NO.: GENERAL
PHOTO - Non-Bridge-2nd
General Picture

Location: Looking Inside Pier
17 (Pier 18 Similar)



PHOTO NO.: GENERAL
PHOTO - 2-Bridge-Elevation
2

Location: North Elevation
(Looking South)





MARYLAND TRANSPORTATION AUTHORITY

BIN: BCZ472001

Date: 03/29/2021

MD 695

OVER PATAPSCO RIVER

PHOTO NO.: GENERAL
PHOTO - Non-Bridge-2nd
General Picture

Location: Typical Pier (Pier
24, West Elevation Shown)



PHOTO NO.: GENERAL
PHOTO - 1-Bridge-Elevation
1

Location: South Elevation
(Looking Northwest)





NO LETTER OF CONCERNS ATTACHED



MARYLAND TRANSPORTATION AUTHORITY

BIN: BCZ472001

Date: 03/29/2021

INSPECTION FINDINGS



MARYLAND TRANSPORTATION AUTHORITY

BIN: **BCZ472001**

Date: **03/29/2021**

MD 695

OVER PATAPSCO RIVER

5. Inspection Findings

- a. MDTA Repair Category Summary
- b. Load Rating Summary and Requirement
- c. Major Rehabilitation/ System Preservation Recommendation Summary
- d. Inspection Dates and Access
- e. Inaccessible Locations and Recommendations
- f. Condition Rating Summary
- g. Element Data
- h. Condition Description Notes and Repair Recommendations
- i. Photo Sheets



MARYLAND TRANSPORTATION AUTHORITY

BIN: BCZ472001

Date: 3/29/2021

MD 695

OVER PATAPSCO RIVER

2021 BRIDGE - UNDERWATER Inspection Report

FOR

STRUCTURE No. BCZ472001

MDTA REPAIR CATEGORY SUMMARY

MDTA Repair Category	Number of New Inspection Findings	Total Number of Inspection Findings
Repair 2-High Priority	1	5
Repair 3-Medium	0	50



MARYLAND TRANSPORTATION AUTHORITY

BIN: **BCZ472001**

Date: **03/29/2021**

MD 695

OVER PATAPSCO RIVER

Major Rehabilitation/System Preservation Recommendation Summary

Major Rehab/Sys. Preservation candidate for evaluation/Testing: **NO**

If Yes, which component(s):

Deck (58):

Superstructure (59):

Substructure (60):



MARYLAND TRANSPORTATION AUTHORITY

BIN: **BCZ472001**

Date: **3/29/2021**

MD 695

OVER PATAPSCO RIVER

**MARYLAND TRANSPORTATION AUTHORITY
2021 Bridge - Underwater INSPECTION REPORT**

Bridge No: BCZ472001

Bridge Name: BCZ427001

Carries: MD 695

Crossing: PATAPSCO RIVE

Bridge Type: D-Steel Continuous

County: 510-BALTIMORE CITY

No. of Spans: 0037

Year Built: 1976

City/Town: Baltimore City

Inspection Type: Bridge - Underwater

Inspection Crew: ADS, CDN, KAM, MTO, NMG, RK

ITEM	60	SUBSTRUCTURE UNDERWATER
-------------	-----------	--------------------------------

# ELEMENT	TYPE	14	15	16	17	18	19	20	21
60.03 - Capbeam/Top of Pier		N	N	7	7	7	7	N	N
60.04 - Columns	Reinforced Concrete	7	7	7	7	7	7	7	7
60.05 - Footing	Reinforced Concrete	7	7	7	7	7	7	7	7
60.06 - Erosion/Scour		7	7	7	6	7	6	7	7
60.09 - Fender/Armoring		N	N	N	N	N	N	N	N
60.25 - Fender System	Timber	N	N	N	6	6	N	N	N
60.41 - Dolphins	Reinforced Concrete					5			



MARYLAND TRANSPORTATION AUTHORITY

BIN: BCZ472001

Date: 3/29/2021

MD 695

OVER PATAPSCO RIVER

**MARYLAND TRANSPORTATION AUTHORITY
2021 Bridge - Underwater INSPECTION REPORT**

Bridge No: BCZ472001

Bridge Name: BCZ427001

Carries: MD 695

Crossing: PATAPSCO RIVE

Bridge Type: D-Steel Continuous

County: 510-BALTIMORE CITY

No. of Spans: 0037

Year Built: 1976

City/Town: Baltimore City

Inspection Type: Bridge - Underwater

Inspection Crew: ADS, CDN, KAM, MTO, NMG, RK

ITEM	60	SUBSTRUCTURE UNDERWATER
-------------	-----------	--------------------------------

# ELEMENT	22	23	24
60.03 - Capbeam/Top of Pier	N	N	N
60.04 - Columns	7	7	7
60.05 - Footing	7	7	7
60.06 - Erosion/Scour	7	7	7
60.09 - Fender/Armorin g	N	N	N
60.25 - Fender System	N	N	N
60.41 - Dolphins			



MARYLAND TRANSPORTATION AUTHORITY

BIN: BCZ472001

Date: 3/29/2021

MD 695

OVER PATAPSCO RIVER

MARYLAND TRANSPORTATION AUTHORITY
2021 BRIDGE - UNDERWATER INSPECTION REPORT

Bridge No: BCZ472001

Bridge Name: BCZ427001

Carries: MD 695

Crossing: PATAPSCO RIVE

Bridge Type: D-Steel Continuous

County: 510-BALTIMORE CITY

No. of Spans: 0037

Year Built: 1976

City/Town: Baltimore City

Inspection Type: BRIDGE - UNDERWATER

Inspection Crew: ADS, CDN, KAM, MTO, NMG, RK

ITEM 61 CHANNEL UNDERWATER

Table with 3 columns: # ELEMENT, TYPE, and a numerical value. Rows include items like Aggradation/De gradation, Embankment Erosion, Drift, Vegetation, Alignment, Fender system, Spur Dikes/Jetties, Riprap, and Adequacy of Opening.





MARYLAND TRANSPORTATION AUTHORITY

BIN: BCZ472001

Date: 3/29/2021

MD 695

OVER PATAPSCO RIVER

**MARYLAND TRANSPORTATION AUTHORITY
2021 BRIDGE - UNDERWATER INSPECTION REPORT**

Bridge No: BCZ472001

Bridge Name: BCZ427001

Carries: MD 695

Crossing: PATAPSCO RIVE

Bridge Type: D-Steel Continuous

County: 510-BALTIMORE CITY

No. of Spans: 0037

Year Built: 1976

City/Town: Baltimore City

Inspection Type: BRIDGE - UNDERWATER

Inspection Crew: ADS, CDN, KAM, MTO, NMG, RK

ITEM

61

CHANNEL UNDERWATER





MARYLAND TRANSPORTATION AUTHORITY

BIN: **BCZ472001**

Date: **03/29/2021**

MD 695

OVER PATAPSCO RIVER

Condition Notes and Repair Recommendations for Item 58 - 62

Condition Rating 2021	Condition Rating 2017	Element # Location	Condition Description Notes	Repair Recommendations	Photos	MDTA Repair	Repair ID	Status
		60.03 - Capbeam/Top of Pier						
7		Span 16						
7		Span 16	Moderate marine growth up to 1" thick consisting of barnacles and algae on all faces of diaphragm wall.					
7		Span 16	Severe corrosion on steel protection plates with up to 3/8" deep pitting near the waterline.					
7		Span 16	Minor honeycombing up to 1/8" deep on submerged concrete surfaces.					
7		Span 16	Numerous areas of epoxy coating failure on concrete faces of diaphragm wall.					
7		Span 17	Moderate marine growth up to 1" thick consisting of barnacles and algae on all faces of diaphragm wall.					
7		Span 17	Severe corrosion on steel protection plates with up to 3/8" deep pitting near the waterline.					
7		Span 17	Minor honeycombing up to 1/8" deep on submerged concrete surfaces.					
7		Span 17	Numerous areas of epoxy coating failure on concrete faces of diaphragm wall.					
7		Span 18	Moderate marine growth up to 3" thick consisting of barnacles and algae on all faces of diaphragm wall.					



MARYLAND TRANSPORTATION AUTHORITY

BIN: **BCZ472001**

Date: **03/29/2021**

MD 695

OVER PATAPSCO RIVER

Condition Notes and Repair Recommendations for Item 58 - 62

		60.03 - Capbeam/Top of Pier					
7		Span 18	Severe corrosion on steel protection plates with up to 3/8" deep pitting near the waterline.				
7		Span 18	Minor honeycombing up to 1/8" deep on submerged concrete surfaces.				
7		Span 18	Numerous areas of epoxy coating failure on concrete faces of diaphragm wall.				
7		Span 18	North Diaphragm Wall, Top Surface - Irregular throughout up to 3/4" deep.				
7		Span 18	Moderate marine growth up to 3" thick consisting of barnacles and algae on all faces of diaphragm wall.				
7		Span 18	Severe corrosion on steel protection plates with up to 3/8" deep pitting near the waterline.				
7		Span 18	Minor honeycombing up to 1/8" deep on submerged concrete surfaces.				
7		Span 18	Numerous areas of epoxy coating failure on concrete faces of diaphragm wall (up to 70%).				
7		Span 18	North Diaphragm Wall, Top Surface - Irregular throughout up to 3/4" deep.				
7		Span 19	Moderate marine growth up to 3" thick consisting of barnacles and algae near the surface on all faces of diaphragm wall.				
7		Span 19	Severe corrosion on steel protection plates with up to 1/4" deep pitting near the waterline.				



MARYLAND TRANSPORTATION AUTHORITY

BIN: **BCZ472001**

Date: **03/29/2021**

MD 695

OVER PATAPSCO RIVER

Condition Notes and Repair Recommendations for Item 58 - 62

		60.03 - Capbeam/Top of Pier						
7		Span 19	Minor honeycombing up to 1/8" deep on submerged concrete surfaces.					
7		Span 19	Random areas of epoxy coating failure on concrete faces of diaphragm wall (5%-10%).					
		60.04 - Columns						
7		Span 14	Severe corrosion on steel protection plates with up to 3/8" deep pitting near the waterline. Note, the Pier columns and steel protection plates have been epoxy coated since the previous inspection. The epoxy coating on the steel plates is failing in the tidal zone.	Replace or repair the steel protection plates at Pier 14.	1, 2	3	2013-BCZ4720 01-00034	OPEN
7		Span 14	Moderate marine growth up to 1" thick consisting of barnacles and algae on all faces of columns.					
7		Span 14	Minor honeycombing up to 1/8" deep on submerged concrete surfaces.					
7		Span 14	Northeast corner of North Column, below protection plate - 6" high x 3" wide x 1.5" deep spall					
7		Span 15	Severe corrosion on steel protection plates with up to 3/8" deep pitting near the waterline. Note, the Pier columns and steel protection plates have been epoxy coated since the previous inspection. The epoxy coating on the steel plates is failing in the tidal zone.	Replace or repair the steel protection plates at Pier 15.		3	2013-BCZ4720 01-00035	OPEN



MARYLAND TRANSPORTATION AUTHORITY

BIN: **BCZ472001**

Date: **03/29/2021**

MD 695

OVER PATAPSCO RIVER

Condition Notes and Repair Recommendations for Item 58 - 62

		60.04 - Columns						
7		Span 15	Moderate marine growth up to 1" thick consisting of barnacles and algae on all faces of columns.					
7		Span 15	Pier columns and steel protection plates have been epoxy coated since the previous inspection. The epoxy coating on the steel plates is failing in the tidal zone.					
7		Span 16	Moderate marine growth up to 1" thick consisting of barnacles and algae on all faces of columns.					
7		Span 16	Severe corrosion on steel protection plates with up to 3/8" deep pitting near the waterline.	Replace steel protection plates at Pier 16.		3	2013-BCZ4720 01-00036	OPEN
7		Span 16	Numerous areas of original epoxy coating failure on concrete faces of columns.					
7		Span 16	Both Columns - Minor spalls located above steel protection plate up to 6" high x 1'-0" wide x 1" deep.					
7		Span 16	Minor honeycombing up to 1/8" deep on submerged concrete surfaces.					
7		Span 16	North Column, Northwest Chamfer, 1'-1" above footing - 1'-0" long x 2" high x 1" deep void along horizontal construction joint.	Repair the spall/void at Pier 16 at the northwest chamfer of the north column, 1'-1" above the footing.		3	2013-BCZ4720 01-00045	OPEN
7		Span 16	North Column, Northwest Chamfer, 2'-10" above footing - 5" long x 1" high x 1/2" deep void along horizontal construction joint.	Repair the spall/void at Pier 16 at the northwest chamfer of the north column, 2'-10" above the footing.		3	2013-BCZ4720 01-00046	OPEN



MARYLAND TRANSPORTATION AUTHORITY

BIN: **BCZ472001**

Date: **03/29/2021**

MD 695

OVER PATAPSCO RIVER

Condition Notes and Repair Recommendations for Item 58 - 62

		60.04 - Columns							
7		Span 16	North Column, Northeast Chamfer, 6" above footing - 2'-0" long x 1 1/2" high x 1" deep void along horizontal construction joint.	Repair the spall/void at Pier 16 at the northeast chamfer of the north column, 6" above the footing.		3		2013-BCZ4720-01-00047	OPEN
7		Span 16	North Column, Northeast Chamfer, 2'-6" above footing - 2'-0" long x 2" high x 2 1/2" deep void along horizontal construction joint.	Repair the spall/void at Pier 16 at the northeast chamfer of the north column, 2'-6" above the footing.		3		2013-BCZ4720-01-00048	OPEN
7		Span 17	Moderate marine growth up to 1" thick consisting of barnacles and algae on all faces of columns.						
7		Span 17	Severe corrosion on steel protection plates with up to 3/8" deep pitting near the waterline.	Replace steel protection plates at Pier 17.		3		2013-BCZ4720-01-00037	OPEN
7		Span 17	Numerous areas of original epoxy coating failure on concrete faces of columns.						
7		Span 17	Minor honeycombing up to 1/8" deep on submerged concrete surfaces.						
7		Span 17	Typical Columns, Above Horizontal Concrete Waler - Vertical, horizontal, and map cracks up to 1/8" wide, some with failed epoxy repairs.	Epoxy inject the cracks on the above water portions of the columns of Pier 17.	3	3		2013-BCZ4720-01-00032	OPEN
7		Span 18	Moderate marine growth up to 3" thick consisting of barnacles and algae on all faces of columns.						
7		Span 18	Severe corrosion on steel protection plates with up to 3/8" deep pitting near the waterline.	Replace steel protection plates at Pier 18.	8	3		2013-BCZ4720-01-00038	OPEN
7		Span 18	Minor honeycombing up to 1/8" deep on submerged concrete surfaces.						



MARYLAND TRANSPORTATION AUTHORITY

BIN: **BCZ472001**

Date: **03/29/2021**

MD 695

OVER PATAPSCO RIVER

Condition Notes and Repair Recommendations for Item 58 - 62

		60.04 - Columns						
7		Span 18	Numerous areas of original epoxy coating failure on concrete faces of columns.					
7		Span 18	Typical Columns, Above Horizontal Concrete Waler - Vertical and horizontal cracks up to 1/8" wide with failed epoxy repairs.	Epoxy inject the cracks on the above water portions of the columns of Pier 18.	9	3	2017-BCZ4720 01-00001	OPEN
7		Span 19	Moderate marine growth up to 3" thick consisting of barnacles and algae on all faces of columns.					
7		Span 19	Severe corrosion on steel protection plates with up to 1/4" deep pitting near the waterline.	Replace steel protection plates at Pier 19.		3	2013-BCZ4720 01-00039	OPEN
7		Span 19	Numerous areas of original epoxy coating failure on concrete faces of columns.					
7		Span 19	Minor honeycombing up to 1/8" deep on submerged concrete surfaces.					
7		Span 20	Moderate marine growth up to 1" thick consisting of barnacles and algae on all faces of footing.					
7		Span 20	Severe corrosion on steel protection plates with up to 3/8" deep pitting near the waterline.	Replace steel protection plates at Pier 20.	21	3	2013-BCZ4720 01-00040	OPEN
7		Span 20	Minor honeycombing up to 1/8" deep on submerged concrete surfaces.					
7		Span 20	Areas of original epoxy coating failure on concrete faces of columns.					
7		Span 20	South Column, Southeast Corner, above steel plate - 1'-0" high x 4" wide x 1" deep spall.	Repair the spall/void at Pier 20 on the southeast corner of the south column.	22	3	2013-BCZ4720 01-00050	OPEN



MARYLAND TRANSPORTATION AUTHORITY

BIN: **BCZ472001**

Date: **03/29/2021**

MD 695

OVER PATAPSCO RIVER

Condition Notes and Repair Recommendations for Item 58 - 62

		60.04 - Columns						
7		Span 21	Moderate marine growth up to 1" thick consisting of barnacles and algae on all faces of columns.					
7		Span 21	Severe corrosion on steel protection plates with up to 3/8" deep pitting near the waterline.	Replace steel protection plates at Pier 21.		3	2013-BCZ4720 01-00041	OPEN
7		Span 21	Minor honeycombing up to 1/8" deep on submerged concrete surfaces.					
7		Span 21	Areas of original epoxy coating failure on concrete faces of columns.					
7		Span 22	Moderate marine growth up to 2" thick consisting of barnacles and algae on all faces of columns.					
7		Span 22	Severe corrosion on steel protection plates with up to 3/8" deep pitting near the waterline.	Replace steel protection plates at Pier 22.		3	2013-BCZ4720 01-00042	OPEN
7		Span 22	Minor honeycombing up to 1/8" deep on submerged concrete surfaces.					
7		Span 22	Areas of original epoxy coating failure on concrete faces of columns (5%-10%).					
7		Span 23	Moderate marine growth up to 2" thick consisting of barnacles and algae on all faces of columns.					
7		Span 23	Severe corrosion on steel protection plates with up to 3/8" deep pitting near the waterline. Note, the Pier columns and steel protection plates have been epoxy coated since the previous inspection. The epoxy coating on the steel plates is failing in the tidal zone.	Replace or repair the steel protection plates at Pier 23.		3	2013-BCZ4720 01-00043	OPEN



MARYLAND TRANSPORTATION AUTHORITY

BIN: **BCZ472001**

Date: **03/29/2021**

MD 695

OVER PATAPSCO RIVER

Condition Notes and Repair Recommendations for Item 58 - 62

60.04 - Columns								
7		Span 23	Pier columns and steel protection plates have been epoxy coated since the previous inspection. The epoxy coating on the steel plates is failing in the tidal zone.					
7		Span 23	Minor honeycombing up to 1/8" deep on submerged concrete surfaces.					
7		Span 24	Moderate marine growth up to 2" thick consisting of barnacles and algae on all faces of columns.					
7		Span 24	Epoxy-filled fiberglass jackets have been installed at both columns since the previous inspection. The pier columns have been epoxy painted below the jackets.	Replace steel protection plates at Pier 24. A fiberglass jacket was installed at both columns.	23	3	2013-BCZ4720 01-00044	CLOSE-CONSULTANT
7		Span 24	Minor honeycombing up to 1/8" deep on submerged concrete surfaces.					
7		Span 24	North Column, Northwest Corner, 4'-6" above footing - 1 1/2" high x 7" wide x 2" deep spall.	Repair the spall/void at Pier 24 at the northwest corner of the north column, 4'-6" above the footing.		3	2013-BCZ4720 01-00051	OPEN
60.05 - Footing								
7		Span 14	Moderate marine growth consisting of barnacles and algae up to 1" thick on all exposed faces of footing.					
7		Span 14	Minor honeycombing up to 1/8" deep on submerged concrete surfaces.					
7		Span 14	Random areas of small chips and honeycombing along the edges of the exposed footing.					



MARYLAND TRANSPORTATION AUTHORITY

BIN: **BCZ472001**

Date: **03/29/2021**

MD 695

OVER PATAPSCO RIVER

Condition Notes and Repair Recommendations for Item 58 - 62

		60.05 - Footing						
7		Span 14	East Face, 6'-0" from southeast corner - 3" high x 6" wide x 1 1/2" deep edge spall.	Repair spall/void at Pier 14 on the east face of the footing, 6'-0" from the southeast corner.		3	2013-BCZ4720 01-00052	OPEN
7		Span 14	Construction debris and steel H-piles on and protruding from the top of the footing.					
7		Span 15	Moderate marine growth up to 1" thick consisting of barnacles and algae on all faces of footing.					
7		Span 15	Minor honeycombing up to 1/8" deep on submerged concrete surfaces.					
7		Span 15	Random areas of small chips and honeycombing along the edges of the exposed footing.					
7		Span 15	Construction debris and steel H-piles on and protruding from the top of the footing.					
7		Span 15	Southwest Corner - 9" high x 1'-6" wide x 2" deep corner spall.	Repair the spall/void at Pier 15 on the southwest corner of the footing.		3	2013-BCZ4720 01-00053	OPEN
7		Span 15	East Face, 17'-0" from northeast corner- 4" high x 1'-10" wide x 2" deep edge spall.	Repair the spall/void at Pier 15 on the east face of the footing, 17'-0" from the northeast corner.		3	2013-BCZ4720 01-00054	OPEN
7		Span 16	Moderate marine growth up to 1" thick consisting of barnacles and algae on all faces of footing.					
7		Span 16	Numerous areas of original epoxy coating failure on concrete faces of footing (up to 50%).					
7		Span 16	Minor honeycombing up to 1/8" deep on submerged concrete surfaces.					



MARYLAND TRANSPORTATION AUTHORITY

BIN: **BCZ472001**

Date: **03/29/2021**

MD 695

OVER PATAPSCO RIVER

Condition Notes and Repair Recommendations for Item 58 - 62

		60.05 - Footing						
7		Span 16	Random areas of small chips and honeycombing along the edges of the exposed footing.					
7		Span 16	Construction debris and steel H-piles on and protruding from the top of the footing.					
7		Span 17	Moderate marine growth up to 1" thick consisting of barnacles and algae on all faces of footing.					
7		Span 17	Random areas of small chips and honeycombing along the edges of the exposed footing.					
7		Span 17	Numerous areas of original epoxy coating failure on concrete faces of footings (up to 80%).					
7		Span 17	Minor honeycombing up to 1/8" deep on submerged concrete surfaces.					
7		Span 17	Typical Sub-footing - Honeycombing and minor spalling 3/4" to 1 1/2" deep on vertical faces.					
7		Span 17	Top of Footing, North and South Edges - Several small spalls up to 8" high x 1'-6" wide x 1 1/2" deep.					
7		Span 17	Top of Footing, 3'-0" from Northwest Corner - 4" high x 7" wide x 1 1/2" deep spall.	Repair the spall at Pier 17 on the footing, 3'-0" from the northwest corner.		3	2013-BCZ472001-00055	OPEN
7		Span 17	Footing, Southeast Corner, 1'-0" below top - 8'-0" long x 1/8" wide horizontal crack.		4			



MARYLAND TRANSPORTATION AUTHORITY

BIN: **BCZ472001**

Date: **03/29/2021**

MD 695

OVER PATAPSCO RIVER

Condition Notes and Repair Recommendations for Item 58 - 62

		60.05 - Footing						
7		Span 17	Sub-footing, Northeast Corner, 3'-0" below top - 9" high x 4'-0" wide (North and East Faces) x 6'-0"+ horizontal penetration void at mudline.	Repair the void at Pier 17 in the sub-footing, 3'-0" from the top at the northeast corner.		3	2013-BCZ472001-00056	OPEN
7		Span 18	Moderate marine growth up to 1" thick consisting of barnacles and algae on all faces of footing.					
7		Span 18	Minor honeycombing up to 1/8" deep on submerged concrete surfaces.					
7		Span 18	Numerous areas of original epoxy coating failure on concrete faces of footing (up to 80%).					
7		Span 18	Random areas of small chips and honeycombing along the edges of the exposed footing.					
7		Span 18	Construction debris and steel H-piles on and protruding from the top of the footing.					
7		Span 18	The following was not found during this inspection: Footing, Northwest Corner, 3'-0" from Top - 3" high x 4" wide x 1" deep void.					
7		Span 19	Moderate marine growth up to 3" thick consisting of barnacles and algae on all faces of footing.					
7		Span 19	Numerous areas of original epoxy coating failure on concrete faces of footing (5%-10%).					
7		Span 19	Minor honeycombing up to 1/8" deep on submerged concrete surfaces.					



MARYLAND TRANSPORTATION AUTHORITY

BIN: **BCZ472001**

Date: **03/29/2021**

MD 695

OVER PATAPSCO RIVER

Condition Notes and Repair Recommendations for Item 58 - 62

		60.05 - Footing					
7		Span 19	Random areas of small chips and honeycombing along the edges of the exposed footing.				
7		Span 19	Honeycombing and minor spalling 3/4" to 1 1/2" deep on vertical faces of sub-footing.				
7		Span 19	Construction debris and steel H-piles on and protruding from the top of the footing.				
7		Span 19	Sub-footing, Northwest Corner - Concrete overpour on top of footing up to 1'-6" high.				
7		Span 19	Sub-footing, West Face, 26'-0" from Northwest Corner, 6" below top - 6" high x 15'-0" long x 10" deep void. (Buried under the mudline during the 2017 and 2021 inspections).				
7		Span 19	Sub-footing, Southwest Corner - 6" diameter x 3" deep corner spall. (Buried under the mudline during the 2017 and 2021 inspection).				
7		Span 19	Sub-footing, East Face, 12'-0" from Northeast Corner, 9" below top - 10" high x 16'-0" long x 10" deep void. (Buried under the mudline during the 2017 and 2021 inspection).				
7		Span 19	Sub-footing, East Face, Northeast Corner - 4'-0" long x 1" wide horizontal crack with associated 1'-6" high delamination. (Buried under the mudline during the 2017 and 2021 inspection).				



MARYLAND TRANSPORTATION AUTHORITY

BIN: **BCZ472001**

Date: **03/29/2021**

MD 695

OVER PATAPSCO RIVER

Condition Notes and Repair Recommendations for Item 58 - 62

		60.05 - Footing						
7		Span 20	Moderate marine growth up to 1" thick consisting of barnacles and algae on all faces of footing.					
7		Span 20	Minor honeycombing up to 1/8" deep on submerged concrete surfaces.					
7		Span 20	No epoxy coating observed on exposed concrete faces of footing.					
7		Span 20	Random areas of small chips and honeycombing along the edges of the exposed footing.					
7		Span 20	Construction debris and steel H-piles on and protruding from the top of the footing.					
7		Span 21	Moderate marine growth up to 1" thick consisting of barnacles and algae on all faces of footing.					
7		Span 21	Minor honeycombing up to 1/8" deep on submerged concrete surfaces.					
7		Span 21	Random areas of small chips and honeycombing along the edges of the exposed footing.					
7		Span 21	Footing - Up to 75% of the top of the footing is covered with construction debris and sediment.					
7		Span 21	Areas of original epoxy coating failure on concrete faces of footing (5%-10%).					
7		Span 22	Moderate marine growth up to 1" thick consisting of barnacles and algae on all faces of footing.					



MARYLAND TRANSPORTATION AUTHORITY

BIN: **BCZ472001**

Date: **03/29/2021**

MD 695

OVER PATAPSCO RIVER

Condition Notes and Repair Recommendations for Item 58 - 62

		60.05 - Footing						
7		Span 22	Minor honeycombing up to 1/8" deep on submerged concrete surfaces.					
7		Span 22	Random areas of small chips and honeycombing along the edges of the exposed footing.					
7		Span 22	Construction debris and steel H-piles on and protruding from the top of the footing.					
7		Span 22	Footing, North Face, 12'-0" from northwest corner - 1'-0" high x 10" wide x 1/2" deep spall.					
7		Span 22	Footing, East Face, 4'-0" from northeast corner - 1'-0" high x 1'-7" wide x 3" deep edge spall.	Repair the spall at Pier 22 on the east face of the footing, 4'-0" from the northeast corner.		3	2013-BCZ472001-00060	OPEN
7		Span 22	Areas of original epoxy coating failure on concrete faces of footing (5%-10%).					
7		Span 23	Moderate marine growth up to 2" thick consisting of barnacles and algae on all faces of footing.					
7		Span 23	Minor honeycombing up to 1/8" deep on submerged concrete surfaces.					
7		Span 23	Numerous areas of epoxy coating failure on concrete faces of footing (up to 50%). (As of the 2017 inspection, this defect was not found).					
7		Span 23	Random areas of small chips and honeycombing along the edges of the exposed footing.					



MARYLAND TRANSPORTATION AUTHORITY

BIN: **BCZ472001**

Date: **03/29/2021**

MD 695

OVER PATAPSCO RIVER

Condition Notes and Repair Recommendations for Item 58 - 62

		60.05 - Footing						
7		Span 24	Moderate marine growth up to 2" thick consisting of barnacles and algae on all faces of footing.					
7		Span 24	Minor honeycombing up to 1/8" deep on submerged concrete surfaces.					
7		Span 24	Numerous areas of original epoxy coating failure on concrete faces of footing (up to 75%).					
7		Span 24	Random areas of small chips and honeycombing along the edges of the exposed footing.					
7		Span 24	Construction debris and steel H-piles on and protruding from the top of the footing.					
		60.06 - Erosion/Scour						
7		Span 14	Channel bottom composition is small rubble and sand with mudline penetrations up to 7" deep.					
7		Span 14	Up to 2'-6" vertical exposure of the footing. See Drawing 1 for more detail.					
7		Span 15	Channel bottom composition is small rubble and sand with mudline penetrations up to 1'-0" deep.					
7		Span 15	Up to 5'-9" vertical exposure of the footing. See Drawing 2 for more detail.					
7		Span 16	Channel bottom composition is small rubble, shells and sand with mudline penetrations up to 6" deep.					



MARYLAND TRANSPORTATION AUTHORITY

BIN: **BCZ472001**

Date: **03/29/2021**

MD 695

OVER PATAPSCO RIVER

Condition Notes and Repair Recommendations for Item 58 - 62

		60.06 - Erosion/Scour						
7		Span 16	Up to 3'-0" vertical exposure of the footing. See Drawing 3 for more detail.					
6		Span 17	Channel bottom composition is small rubble, shells and sand with mudline penetrations up to 3" deep.					
6		Span 17	Up to 10'-0" vertical exposure of the footing (full exposed). See Drawings 4 and 5 for more detail.	Install riprap at all faces of Pier 17 to cover exposed sub-footing.		3	2013-BCZ4720 01-00017	OPEN
6		Span 17	Up to 3'-0" vertical exposure of the sub-footing. See Drawings 4 and 5 for more detail.					
7		Span 18	Channel bottom composition is small rubble, shells and sand with mudline penetrations up to 3" deep.					
7		Span 18	Southeast Corner of Footing - Localized scour up to 8'-0" diameter x 1'-0" deep.					
7		Span 18	Up to 7'-0" vertical exposure of the footing. See Drawings 6 and 7 for more detail.					
6		Span 19	Channel bottom composition is small rubble, shells and mud with mudline penetrations up to 3" deep.					
6		Span 19	Up to 6'-0" vertical exposure of the footing (full exposed at northwest corner). See Drawing 9 for more detail.					
6		Span 19	Up to 2'-0" vertical exposure of the sub-footing at northwest corner. See Drawing 9 for more detail.					



MARYLAND TRANSPORTATION AUTHORITY

BIN: **BCZ472001**

Date: **03/29/2021**

MD 695

OVER PATAPSCO RIVER

Condition Notes and Repair Recommendations for Item 58 - 62

		60.06 - Erosion/Scour						
7		Span 20	Channel bottom composition is small rubble and sand with mudline penetrations up to 1'-0" deep.					
7		Span 20	Up to 8'-0" vertical exposure of the footing (full exposed at west corner). See Drawing 10 for more detail.					
7		Span 20	Up to 3" vertical exposure of the sub-footing at northwest corner. See Drawing 10 for more detail.					
7		Span 21	Channel bottom composition is small rubble and sand with mudline penetrations up to 1'-0" deep.					
7		Span 21	Up to 6'-10" vertical exposure of the footing. See Drawing 11 for more detail.					
7		Span 22	Channel bottom composition is small rubble, shells and sand with mudline penetrations up to 3" deep.					
7		Span 22	Up to 6'-0" vertical exposure of the footing. See Drawing 12 for more detail.					
7		Span 23	Channel bottom composition is small rubble, shells and sand with mudline penetrations up to 1'-0" deep.					
7		Span 23	Up to 5" vertical exposure of the footing. See Drawing 13 for more detail.					
7		Span 24	Channel bottom composition is small rubble, shells and sand with mudline penetrations up to 1'-0" deep.					



MARYLAND TRANSPORTATION AUTHORITY

BIN: **BCZ472001**

Date: **03/29/2021**

MD 695

OVER PATAPSCO RIVER

Condition Notes and Repair Recommendations for Item 58 - 62

		60.06 - Erosion/Scour						
7		Span 24	Up to 1'-6" vertical exposure of the footing. See Drawing 14 for more detail.					
		60.25 - Fender System						
6		Span 17	Moderate marine growth consisting of barnacles and algae typically 1" thick on all faces of concrete fender columns.					
6		Span 17	Moderate corrosion of hardware and 3/4" deep pick penetrations of timber components on fender system.	Replace the corroded fasteners on Pier 17 fender system.		3	2013-BCZ4720 01-00007	OPEN
6		Span 17	Random vertical timber members have severe splits, checks, or impact damage. The rotten timber members have been replaced since the previous inspection.	Replace the rotten timber members in the Pier 17 fender.		3	2013-BCZ4720 01-00006	CLOSE-CONSULTANT
6		Span 17	Vertical Timber Planks and Walers - Random missing caps.	Replace missing caps on the Pier 17 fender system.		3	2013-BCZ4720 01-00027	OPEN
6		Span 17	Steel Fender Plates - 100% section loss at several locations, most notably at corners of fender system. This item has been repaired since the previous inspection (Closed Consultant). The steel fender plates have isolated coating loss and light corrosion on the hardware throughout.	Replace sections of steel plates with 100% section loss in Pier 17 fender system. This item has been rehabilitated since the previous inspection (Close consultant).	5	3	2013-BCZ4720 01-00028	CLOSE-CONSULTANT
6		Span 17	Typical Concrete Fender Waler, Top Surface - Typical 1/8-inch wide cracks.	Epoxy inject the cracks on the above water portions of the walers at Pier 17.		3	2013-BCZ4720 01-00021	OPEN



MARYLAND TRANSPORTATION AUTHORITY

BIN: **BCZ472001**

Date: **03/29/2021**

MD 695

OVER PATAPSCO RIVER

Condition Notes and Repair Recommendations for Item 58 - 62

		60.25 - Fender System						
6		Span 17	North Concrete Fender Waler - 10" long x 1'-0" wide x 3/4" deep spall with associated delamination near northeast column.	North Concrete Fender Waler - Patch the 10" long x 1'-0" wide x 3/4" deep spall with associated delamination near northeast column.	6	3	2017-BCZ4720 01-00002	OPEN
6		Span 17	Fender Waler Column, North Face at footing - 8" high x 4" wide x 2" deep spall					
6		Span 17	Damaged faded signs on fenders.		7			
6		Span 18	Moderate marine growth consisting of barnacles and algae typically 1" thick on all faces of concrete fender columns.					
6		Span 18	Moderate corrosion of hardware and 3/4" deep pick penetrations of timber components on fender system.	Replace the corroded fasteners on Pier 18 fender system.		3	2013-BCZ4720 01-00008	OPEN
6		Span 18	Random vertical timber members have severe splits, checks, or impact damage. The rotten timber members have been replaced since the previous inspection.	Replace the rotten timber members in the Pier 18 fender system.	10, 11	3	2013-BCZ4720 01-00005	CLOSE-CONSULTANT
6		Span 18	Vertical Timber Planks and Walers - Random missing caps.	Replace the missing caps on the Pier 18 fender system.		3	2013-BCZ4720 01-00009	OPEN
6		Span 18	Northeast Center Fender Column - Extends 2" out from face of footing.					
6		Span 18	Northeast and Northwest Corners - Isolated locations of collision damage to vertical timbers.	Replace the crushed vertical timber members in the Pier 18 fender system.		3	2013-BCZ4720 01-00010	OPEN
6		Span 18	Damaged and faded signs on fenders.	Replace the faded sign on the Pier 18 fender system.	12	3	2013-BCZ4720 01-00031	OPEN



MARYLAND TRANSPORTATION AUTHORITY

BIN: **BCZ472001**

Date: **03/29/2021**

MD 695

OVER PATAPSCO RIVER

Condition Notes and Repair Recommendations for Item 58 - 62

		60.25 - Fender System						
6		Span 18	Steel Fender Plates - 100% section loss at several locations, most notably at corners of fender system. This item has been repaired since the previous inspection. The steel fender plates have isolated coating loss and light corrosion on the hardware throughout.	Replace sections of the steel fender plates with 100% section loss in the Pier 18 fender system.	13	3	2013-BCZ4720 01-00029	CLOSE-CONSULTANT
6		Span 18	Typical Concrete Fender Waler, Top Surface - Typical 1/8-inch wide cracks.	Epoxy inject the cracks on the above water portions of the walers at Pier 18.		3	2013-BCZ4720 01-00022	OPEN
6		Span 18	North Concrete Fender Waler, Northwest Corner - Scaled and delaminated on the underside, 5'-0" long x 3'-0" wide x 3" deep with moderate efflorescence, rust staining, and exposed steel reinforcement with up to 100% section loss.	North Concrete Fender Waler, Northwest Corner - Clean and patch scaled and delaminated on the underside, 5'-0" long x 3'-0" wide x 3" deep with moderate efflorescence, rust staining, and exposed steel reinforcement with up to 100% section loss.	14	2	2021-BCZ4720 01-00001	OPEN
6		Span 18	North Concrete Fender Waler, Northeast Corner - Scaled and delaminated on the underside, 2'-0" long x 2'-0" wide x 3" deep with moderate efflorescence, rust staining, and exposed steel reinforcement with up to 100% section loss.	North Concrete Fender Waler, Northeast Corner - Clean and patch scaled and delaminated on the underside, 2'-0" long x 2'-0" wide x 3" deep with moderate efflorescence, rust staining, and exposed steel reinforcement with up to 100% section loss.		2	2013-BCZ4720 01-00030	OPEN
6		Span 18	Abandoned flood light on the northeast corner of the fender system.	Remove the abandoned flood light on the northeast corner of the fender system.		3	2017-BCZ4720 01-00003	OPEN



MARYLAND TRANSPORTATION AUTHORITY

BIN: **BCZ472001**

Date: **03/29/2021**

MD 695

OVER PATAPSCO RIVER

Condition Notes and Repair Recommendations for Item 58 - 62

		60.41 - Dolphins						
5		Span 18	Typical Dolphin - Lower edge of concrete cap at all dolphins exhibit severe scaling around circumference up to 2'-0" high x 1'-6" deep with exposed vertical steel reinforcement up to 10" long and horizontal reinforcement deboned up to 75% of the circumference. Exposed reinforcement exhibits severe corrosion with up to 75% section loss.	Repair the severe scaling at all dolphins at the lower edges of the concrete caps. Clean and epoxy coat any exposed reinforcing, and patch deteriorated and missing concrete. Replace the heavily deteriorated reinforcing as necessary.		3	2013-BCZ4720 01-00061	OPEN
5		Span 18	Typical Dolphin - Moderate marine growth up to 1" thick consisting of barnacles and algae.					
5		Span 18	Typical Dolphin - Severe corrosion on middle and bottom fender anchorages and wire rope with 75% to 90% section loss. Remaining fenders are scratched, torn, or twisted at random locations. As of the 2021 inspection, this defect has been repaired.	Replace the severely corroded middle and bottom fender anchorages and wire rope with 75% to 90% section loss.		3	2017-BCZ4720 01-00004	CLOSE-CONSULTANT
5		Span 18	Typical Dolphin - Channel bottom composition is small rubble and sand with mudline penetrations up to 3'-0" deep. Debris on channel bottom adjacent to all dolphins (damaged fenders, etc.).					
5		Span 18	Typical Dolphin, Steel Sheeting – Moderate to heavy corrosion with 20% to 30% section loss from the mudline to approximately 22'-0" below the bottom of the concrete cap with pitting up to 1/8" deep.	All dolphins - Install submerged sacrificial anodes on the steel sheeting of the dolphins to prevent further corrosion and section loss to the steel.	15	3	2017-BCZ4720 01-00005	OPEN



MARYLAND TRANSPORTATION AUTHORITY

BIN: **BCZ472001**

Date: **03/29/2021**

MD 695

OVER PATAPSCO RIVER

Condition Notes and Repair Recommendations for Item 58 - 62

		60.41 - Dolphins						
5		Span 18	Typical Dolphin, Steel Sheeting – Heavy corrosion with 30% to 50% section loss from 22'-0" to 5'-0" below the bottom of the concrete cap with pitting up to 3/8" deep.		16			
5		Span 18	Typical Dolphin, Steel Sheeting – Severe corrosion with up to 100% section loss (perforations) from 5'-0" below the bottom of the concrete cap to bottom of cap with pitting up to 1/2" deep.	All Dolphins - Install steel protective jackets from the bottom of the concrete cap to 5'-0" below the bottom of the cap in areas of perforated steel. Pressure inject grout within the perforations after jacket is installed.	17	2	2017-BCZ4720 01-00006	OPEN
5		Span 18	Dolphin 1: Cap is rotated out of plumb 10-degrees toward the north.	Monitor Dolphin 1 for further cap rotation.		2	2013-BCZ4720 01-00001	OPEN
5		Span 18	Dolphin 1: Horizontal joint approximately 22'-0" on the Northeast face below the bottom of cap exhibits a deformed steel panel with exposed concrete and minor void.					
5		Span 18	Dolphin 1: Rubber fenders are missing and attachment hardware is damaged at the following locations - Southeast middle.	Replace the missing and damaged 24" rubber fenders and connection hardware at Dolphin 1. As of the 2021 inspection, new fenders were installed; however, the southeast middle fender is still missing.		3	2013-BCZ4720 01-00002	OPEN
5		Span 18	Dolphin 2, Steel Sheeting: Battered H-piles located approximately 20'-0" below bottom of cap (5/16-inch wide flange) penetrate into openings in the sheet pile shaft. The openings typically exhibit voids in the exposed concrete, up to 9" deep.					



MARYLAND TRANSPORTATION AUTHORITY

BIN: **BCZ472001**

Date: **03/29/2021**

MD 695

OVER PATAPSCO RIVER

Condition Notes and Repair Recommendations for Item 58 - 62

		60.41 - Dolphins						
5		Span 18	Dolphin 2, Steel Sheeting, Northeast Face: Opening at H-pile interface with a 2'-0" wide x 6'-0" high x 3'-0" deep void in exposed concrete.	Repair the void at Dolphin 2 at the opening in the sheet pile at interface with H-pile on northwest face.		3	2013-BCZ4720 01-00065	OPEN
5		Span 18	Dolphin 2, Steel Sheeting, Southwest Face: Opening at H-pile interface with a 1'-0" wide x 4'-0" high x 1'-0" deep void in exposed concrete.	Repair the void at Dolphin 2 at opening in sheet pile at interface with H-pile on southwest face.		3	2013-BCZ4720 01-00066	OPEN
5		Span 18	Dolphin 2, Cap, Southwest Face: Spall at middle rubber fender connection up to 2'-4" long x 8" high x 10" deep with exposed and corroded reinforcing.	Repair the spall at Dolphin 2 at middle rubber fender connection on southwest face.		3	2013-BCZ4720 01-00067	OPEN
5		Span 18	Dolphin 2: Rubber fenders are missing and attachment hardware is damaged at the following locations - East middle.	Replace the missing and damaged 24" rubber fenders and connection hardware at Dolphin 2. As of the 2021 inspection, new fenders were installed; however, the east middle fender is still missing.	18	3	2013-BCZ4720 01-00018	OPEN
5		Span 18	Dolphin 2, H-piles, typically have heavy corrosion with pitting up to 1/8" deep for the full-height.					
5		Span 18	Dolphin 3, Steel Sheeting, North Face, Approximately 28'-0" below bottom of cap: 6" diameter cut hole with a 2'-0" long x 4" high x 4" wide protruding timber. Exposed concrete is in good condition.					
5		Span 18	Dolphin 3: Scaled area in the concrete cap, 6" diameter x 10" deep, located 1' above the waterline.					



Condition Notes and Repair Recommendations for Item 58 - 62

		60.41 - Dolphins						
5		Span 18	Dolphin 3: Steel Sheeting, West Face, 2' below the cap - 1'-0" high x 8" wide perforation that can be probed up to 6'-0" with active loss of fill.		19			
5		Span 18	Dolphin 4, Steel Sheeting, Top 3'-0": Several areas of 100% section loss throughout with perforations up to 2'-0" high x 8" wide. Void in concrete within perforations up to 5'-0" high x 4'-0" deep x full-circumference.	Repair the concrete voids in Dolphin 4 by patching perforations within the steel sheeting with steel plates and pressure injecting grout within the perforations in the steel sheeting.	20	2	2013-BCZ4720 01-00023	OPEN
5		Span 18	Dolphins 3 and 4: The rubber fenders have been replaced since the previous inspection.	Replace missing and damaged 24" rubber fenders and connection hardware at Dolphin 4. Replace the missing and damaged 24" rubber fenders and connection hardware at Dolphin 3.		3, 3	2013-BCZ4720 01-00003, 2013-BCZ4720 01-00004	CLOSE-CONSULTANT
		61.01 - Aggradation/Degradation						
7		Channel	The channel profile has not significantly changed since the previous 2013 inspection report. Refer to the underwater inspection drawings for further details on the exposed portions of the footings and sub-footings.					
7		Channel	Refer to the 2015 Hydrographic Survey in ASIR for specific details pertaining to the channel bottom.					



MARYLAND TRANSPORTATION AUTHORITY

BIN: **BCZ472001**

Date: **03/29/2021**

MD 695

OVER PATAPSCO RIVER

Condition Notes and Repair Recommendations for Item 58 - 62

		61.03 - Drift						
6		Channel	Construction debris including large tires, spools and pieces of steel wire rope, steel beams, and general soil deposits are found on the top of the pier footings and surrounding channel bottom. These defects have been recorded per span, and further details can be found in the underwater inspection drawings.					
		61.06 - Fender system						
5		Channel	Refer to Span 17& 18 - Fender System for defects on the timber fender system.					
5		Channel	Refer to Span 18 - Dolphins for defects on the steel/concrete dolphins.					



Photos	
<p>PHOTO NO.: 1</p> <p>Location: Pier 14, Typical Column</p> <p>Direction: North</p> <p>Description: Failing epoxy coating on the steel protection plate</p> <p>Element #: 60.04 - Columns</p> <p>Condition State Rating: 7</p> <p>MDTA Repair: 3 Repair Id: 2013-BCZ472001-00034</p>	
<p>PHOTO NO.: 2</p> <p>Location: Pier 14, South Column</p> <p>Direction: North</p> <p>Description: New epoxy paint on concrete column below the protection plate</p> <p>Element #: 60.04 - Columns</p> <p>Condition State Rating: 7</p> <p>MDTA Repair: 3 Repair Id: 2013-BCZ472001-00034</p>	

PHOTO NO.: 3

Location: Pier 17, Typical
Column

Direction: East

Description: Typical epoxy
repairs above the waler

Element #: 60.04 - Columns

Condition State Rating: 7

MDTA Repair: 3
Repair Id: 2013-BCZ472001-
00032



PHOTO NO.: 4

Location: Pier 17 Footing,
Southeast Corner

Direction: North

Description: 1/8" wide
horizontal crack

Element #: 60.05 - Footing

Condition State Rating: 7

MDTA Repair:
Repair Id:

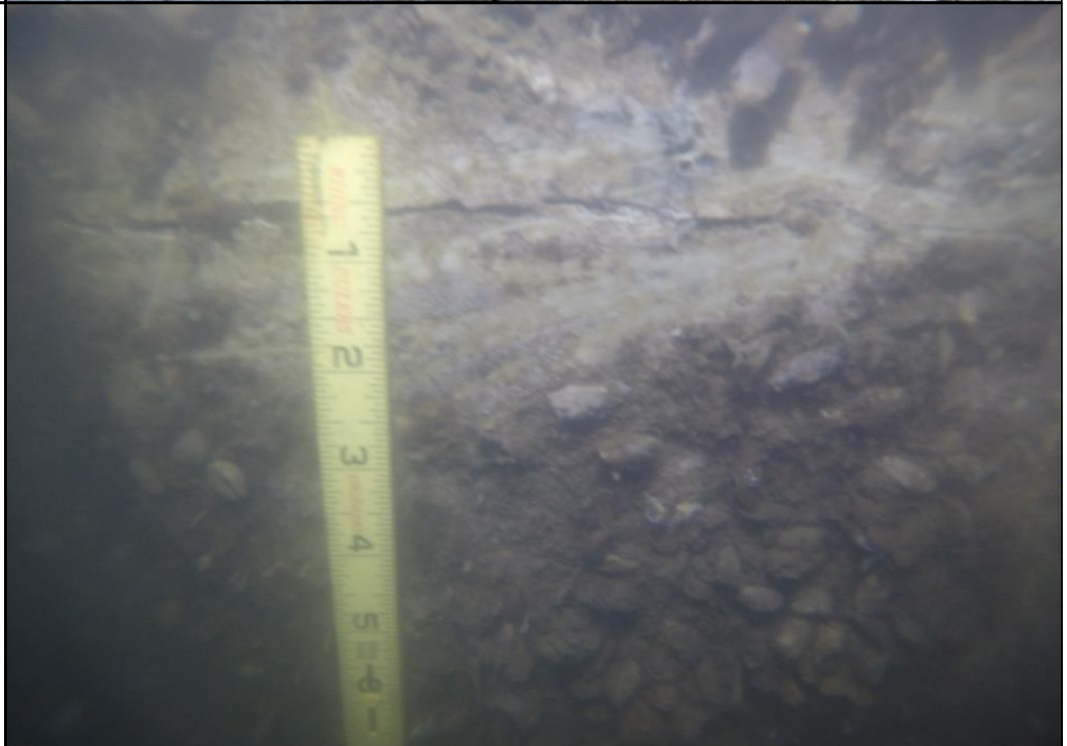


PHOTO NO.: 5

Location: Pier 17, Fender System (Typical)

Direction: Northeast

Description: New steel fender plate

Element #: 60.25 - Fender System

Condition State Rating: 6

MDTA Repair: 3
Repair Id: 2013-BCZ472001-00028



PHOTO NO.: 6

Location: Pier 17, Fender Waler, Near Northeast Column

Direction: Southwest

Description: Spall with associated delamination

Element #: 60.25 - Fender System

Condition State Rating: 6

MDTA Repair: 3
Repair Id: 2017-BCZ472001-00002



PHOTO NO.: 7

Location: Pier 17, South
Face

Direction: North

Description: Damaged
"Bridge Work Ahead" sign

Element #: 60.25 - Fender
System

Condition State Rating: 6

MDTA Repair:
Repair Id:



PHOTO NO.: 8

Location: Pier 18, Northwest
Column

Direction: Southeast

Description: Typical condition
of steel plates in the tidal
zone

Element #: 60.04 - Columns

Condition State Rating: 7

MDTA Repair: 3
Repair Id: 2013-BCZ472001-
00038



PHOTO NO.: 9

Location: Pier 18, Typical
Column

Direction: West

Description: Typical cracks
above the steel plate

Element #: 60.04 - Columns

Condition State Rating: 7

MDTA Repair: 3
Repair Id: 2017-BCZ472001-
00001



PHOTO NO.: 10

Location: Pier 18, Fender
System

Direction: North

Description: Typical checking
on timber members

Element #: 60.25 - Fender
System

Condition State Rating: 6

MDTA Repair: 3
Repair Id: 2013-BCZ472001-
00005



PHOTO NO.: 11

Location: Pier 18, Fender System, South Face

Direction: North

Description: Typical split fender board

Element #: 60.25 - Fender System

Condition State Rating: 6

MDTA Repair: 3
Repair Id: 2013-BCZ472001-00005



PHOTO NO.: 12

Location: Pier 18, Fender System

Direction: North

Description: Typical damaged "Bridge Work Above" sign

Element #: 60.25 - Fender System

Condition State Rating: 6

MDTA Repair: 3
Repair Id: 2013-BCZ472001-00031



PHOTO NO.: 13

Location: Pier 18 Fender System

Direction: Northeast

Description: New steel fender plates installed

Element #: 60.25 - Fender System

Condition State Rating: 6

MDTA Repair: 3
Repair Id: 2013-BCZ472001-00029



PHOTO NO.: 14

Location: Pier 18 Fender Waler, Northwest Corner

Direction: North

Description: Area of spalling and scaling with exposed reinforcement

Element #: 60.25 - Fender System

Condition State Rating: 6

MDTA Repair: 2
Repair Id: 2021-BCZ472001-00001



PHOTO NO.: 15
 Location: Dolphin 3
 Direction: North
 Description: Typical condition of steel sheeting near the mudline
 Element #: 60.41 - Dolphins
 Condition State Rating: 5
 MDTA Repair: 3
 Repair Id: 2017-BCZ472001-00005



PHOTO NO.: 16
 Location: Dolphin 3
 Direction: North
 Description: Typical condition of steel sheeting from 22' to 5' below the cap.
 Element #: 60.41 - Dolphins
 Condition State Rating: 5
 MDTA Repair:
 Repair Id:



PHOTO NO.: 17

Location: Dolphin 3

Direction: North

Description: Severe corrosion with perforations on the steel sheeting near the bottom of the cap

Element #: 60.41 - Dolphins

Condition State Rating: 5

MDTA Repair: 2
Repair Id: 2017-BCZ472001-00006



PHOTO NO.: 18

Location: Dolphin 2, East Face

Direction: Northeast

Description: Missing Middle Fender

Element #: 60.41 - Dolphins

Condition State Rating: 5

MDTA Repair: 3
Repair Id: 2013-BCZ472001-00018



PHOTO NO.: 19

Location: Dolphin 3, West
Face

Direction: East

Description: Severe corrosion
of steel sheeting with large
perforation

Element #: 60.41 - Dolphins

Condition State Rating: 5

MDTA Repair:
Repair Id:



PHOTO NO.: 20

Location: Dolphin 4

Direction: North

Description: Typical
widespread areas of severe
corrosion in the steel
sheeting with large
perforations

Element #: 60.41 - Dolphins

Condition State Rating: 5

MDTA Repair: 2
Repair Id: 2013-BCZ472001-
00023

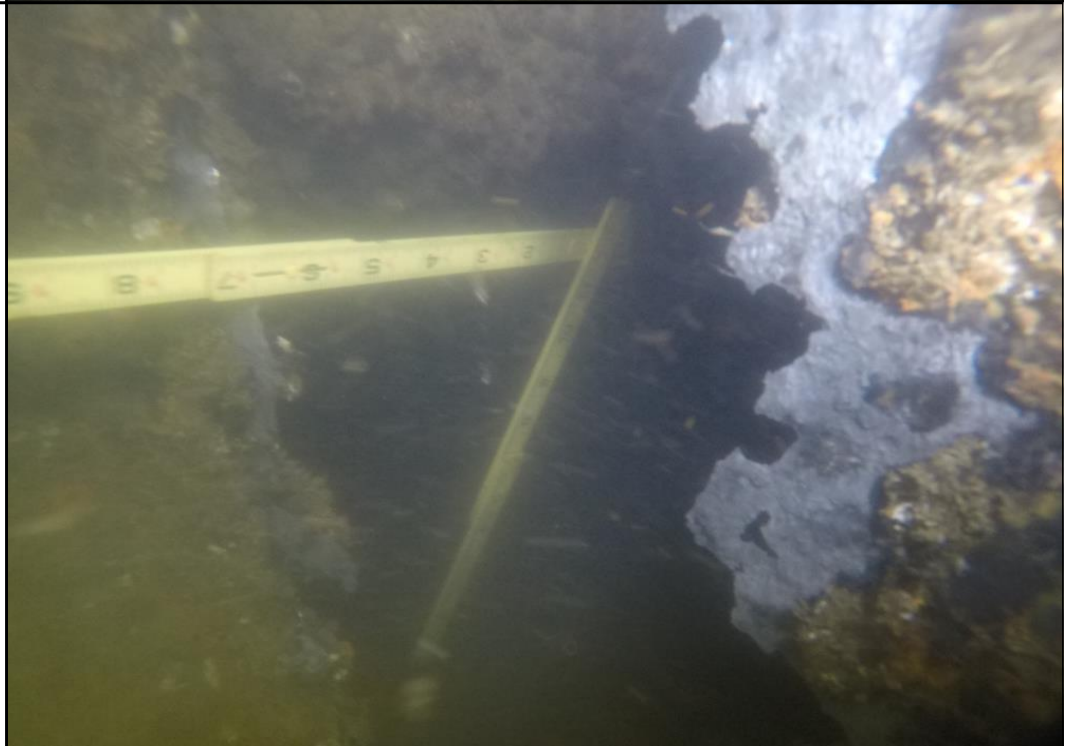


PHOTO NO.: 21

Location: Pier 20, South
Column

Direction: North

Description: Typical corrosion
on steel protection plates
below the waterline

Element #: 60.04 - Columns

Condition State Rating: 7

MDTA Repair: 3
Repair Id: 2013-BCZ472001-
00040

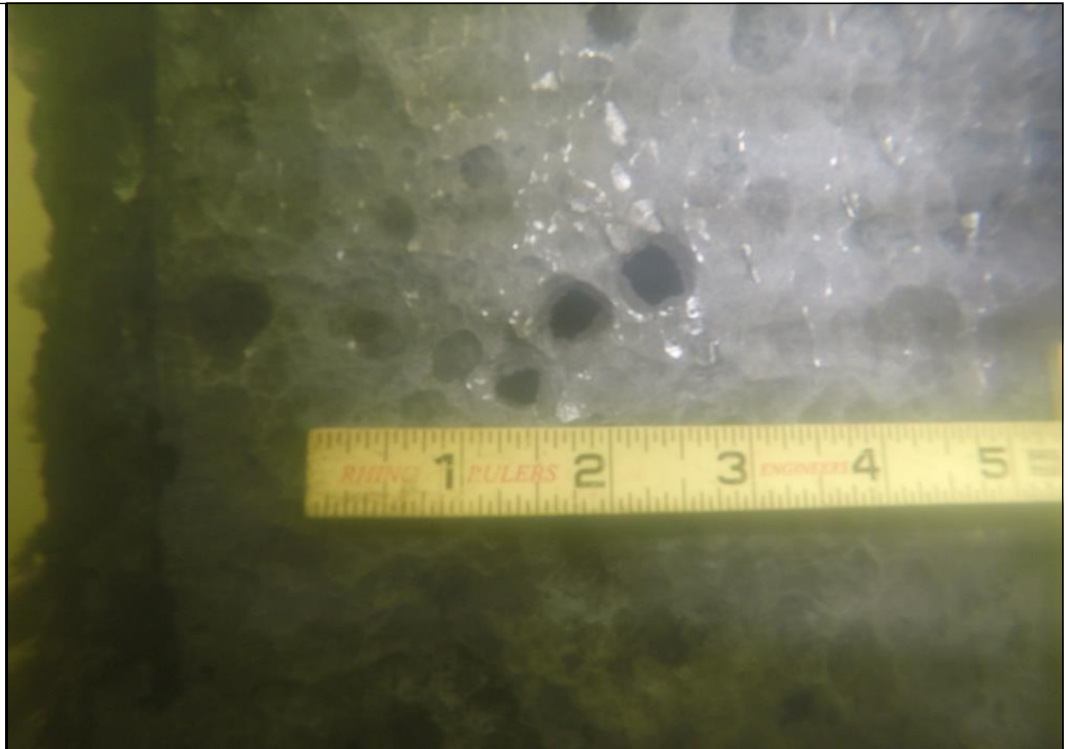


PHOTO NO.: 22

Location: Pier 20, South
Column, Southeast Corner

Direction: Northwest

Description: Spall above the
protection plate.

Element #: 60.04 - Columns

Condition State Rating: 7

MDTA Repair: 3
Repair Id: 2013-BCZ472001-
00050





MARYLAND TRANSPORTATION AUTHORITY

BIN: BCZ472001

Date: 03/29/2021

MD 695

OVER PATAPSCO RIVER

PHOTO NO.: 23

Location: Pier 24 Columns

Direction: Northeast

Description: New fiberglass jackets installed

Element #: 60.04 - Columns

Condition State Rating: 7

MDTA Repair: 3

Repair Id: 2013-BCZ472001-00044



**MARYLAND TRANSPORTATION AUTHORITY
INSPECTION REPORT
SOUNDING SHEET
(All measurements are in inches)**

Sheet 1 of 1

Date: 03/29/2021

Bridge No: BCZ472001

Bridge Name: BCZ427001

Carries: MD 695

Crossing: PATAPSCO RIVE

County: 510-BALTIMORE

Bridge Type: D-Steel Continuous


Year Built: 1976

City/Town: 04000-Baltimore


No. of Spans: 0037

Inspection Crew: ADS, CDN, KAM, MTO, NMG, Clearance View

Name

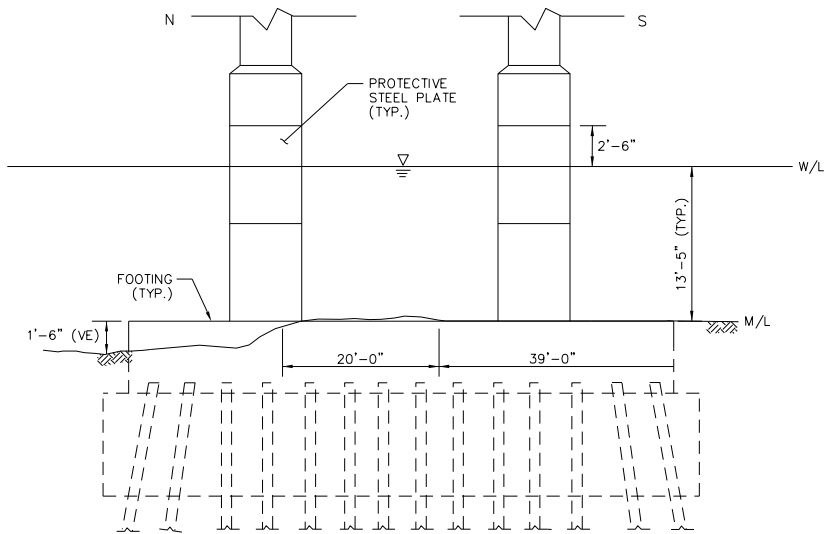

WEST ELEVATION

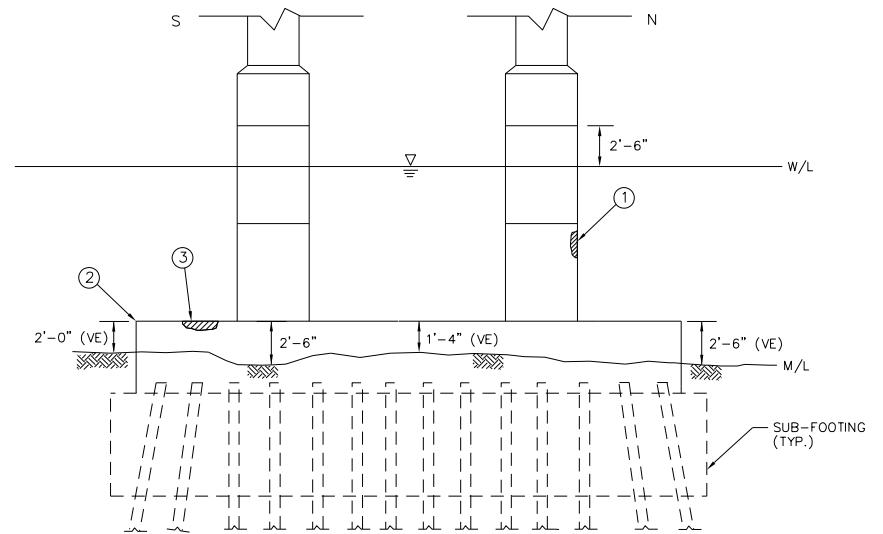

EAST ELEVATION

- ① SPALL ON THE NORTH EAST CORNER OF NORTH COLUMN BELOW PROTECTION PLATE, 6" H X 3" W X 1.5" D.
- ② THE MUDLINE IS LEVEL WITH THE FOOTING ON THE CENTERLINE OF THE SOUTH FACE.
- ③ FOOTING, 6'-0" FROM SOUTHEAST CORNER - 3" H X 6" W X 1 1/2" DEEP EDGE SPALL.

(VE) INDICATES VERTICAL EXPOSURE.

GENERAL NOTES:

- 1. MODERATE MARINE GROWTH UP TO 1" THICK CONSISTING OF BARNACLES AND ALGAE.
- 2. CHANNEL BOTTOM COMPOSITION IS SMALL RUBBLE AND SAND WITH MUDLINE PENETRATIONS UP TO 7" DEEP.
- 3. SEVERE CORROSION ON STEEL PLATES WITH UP TO 3/8" DEEP PITTING.
- 4. RANDOM AREAS OF SMALL CHIPS AND HONEYCOMBING ALONG EDGES OF EXPOSED FOOTING.
- 5. MINOR HONEYCOMBING UP TO 1/8" DEEP ON ALL SUBMERGED CONCRETE SURFACES THROUGHOUT.
- 6. PIER COLUMNS AND STEEL PROTECTION PLATES EPOXY COATED SINCE PREVIOUS INSPECTION. EPOXY COATING ON STEEL PLATES IS FAILING IN THE TIDAL ZONE.
- 7. CONSTRUCTION DEBRIS AND STEEL H-PILES ON AND PROTRUDING FROM TOP OF FOOTING.

FRANCIS SCOTT KEY BRIDGE FACILITY
I-695 OVER THE PATAPSCO RIVER
STRUCTURE NO. BCZ472001


PIER 14

SCALE	NOT TO SCALE
INSP. DATE	MARCH 29 TO APRIL 8, 2021
DIVERS SUP.	M. OWINGS, PE, C. NEMEC, PE
INSP. DIVERS	A. SCHINDHELM, PE, C. NEMEC, PE, K. MORROW, N. GUZMA
ENGINEERS	M. OWINGS, PE, C. NEMEC, PE




CONTRACT NO.
AE-3016-000-001
DRAWING NO.

1

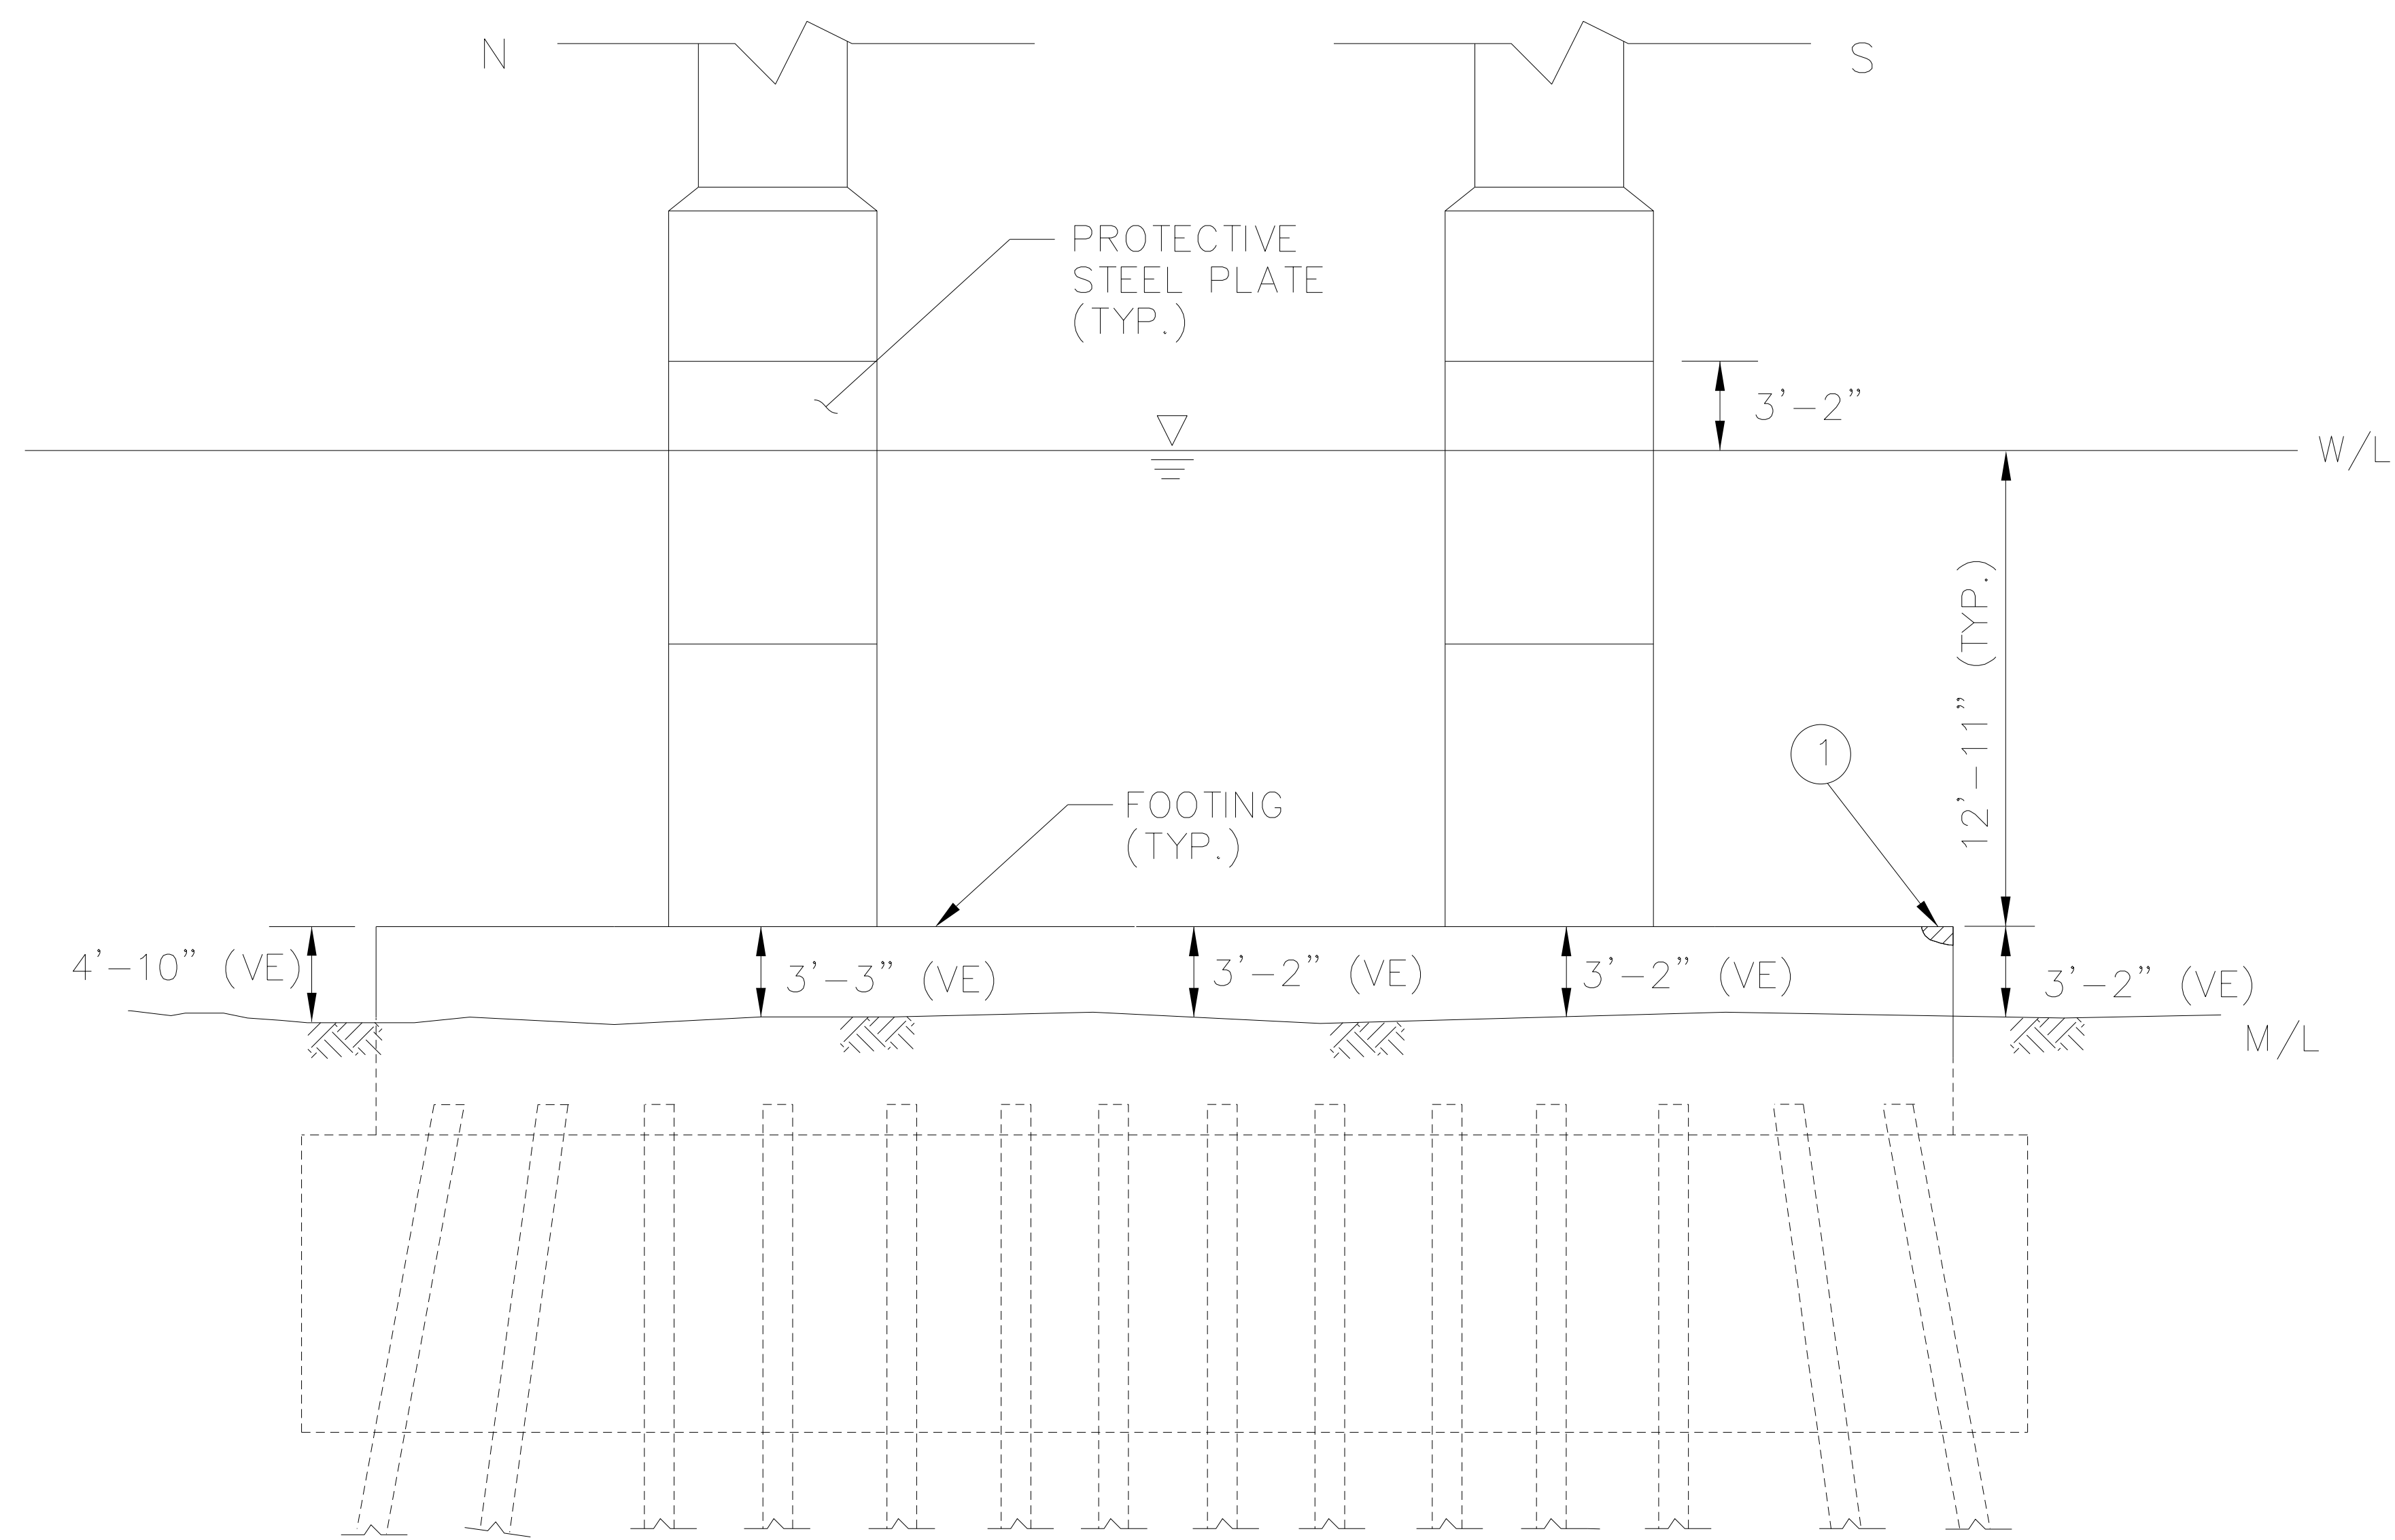

WEST ELEVATION

① FOOTING, SOUTHWEST CORNER - 9" H x 1'-6" W x 2" D CORNER SPALL

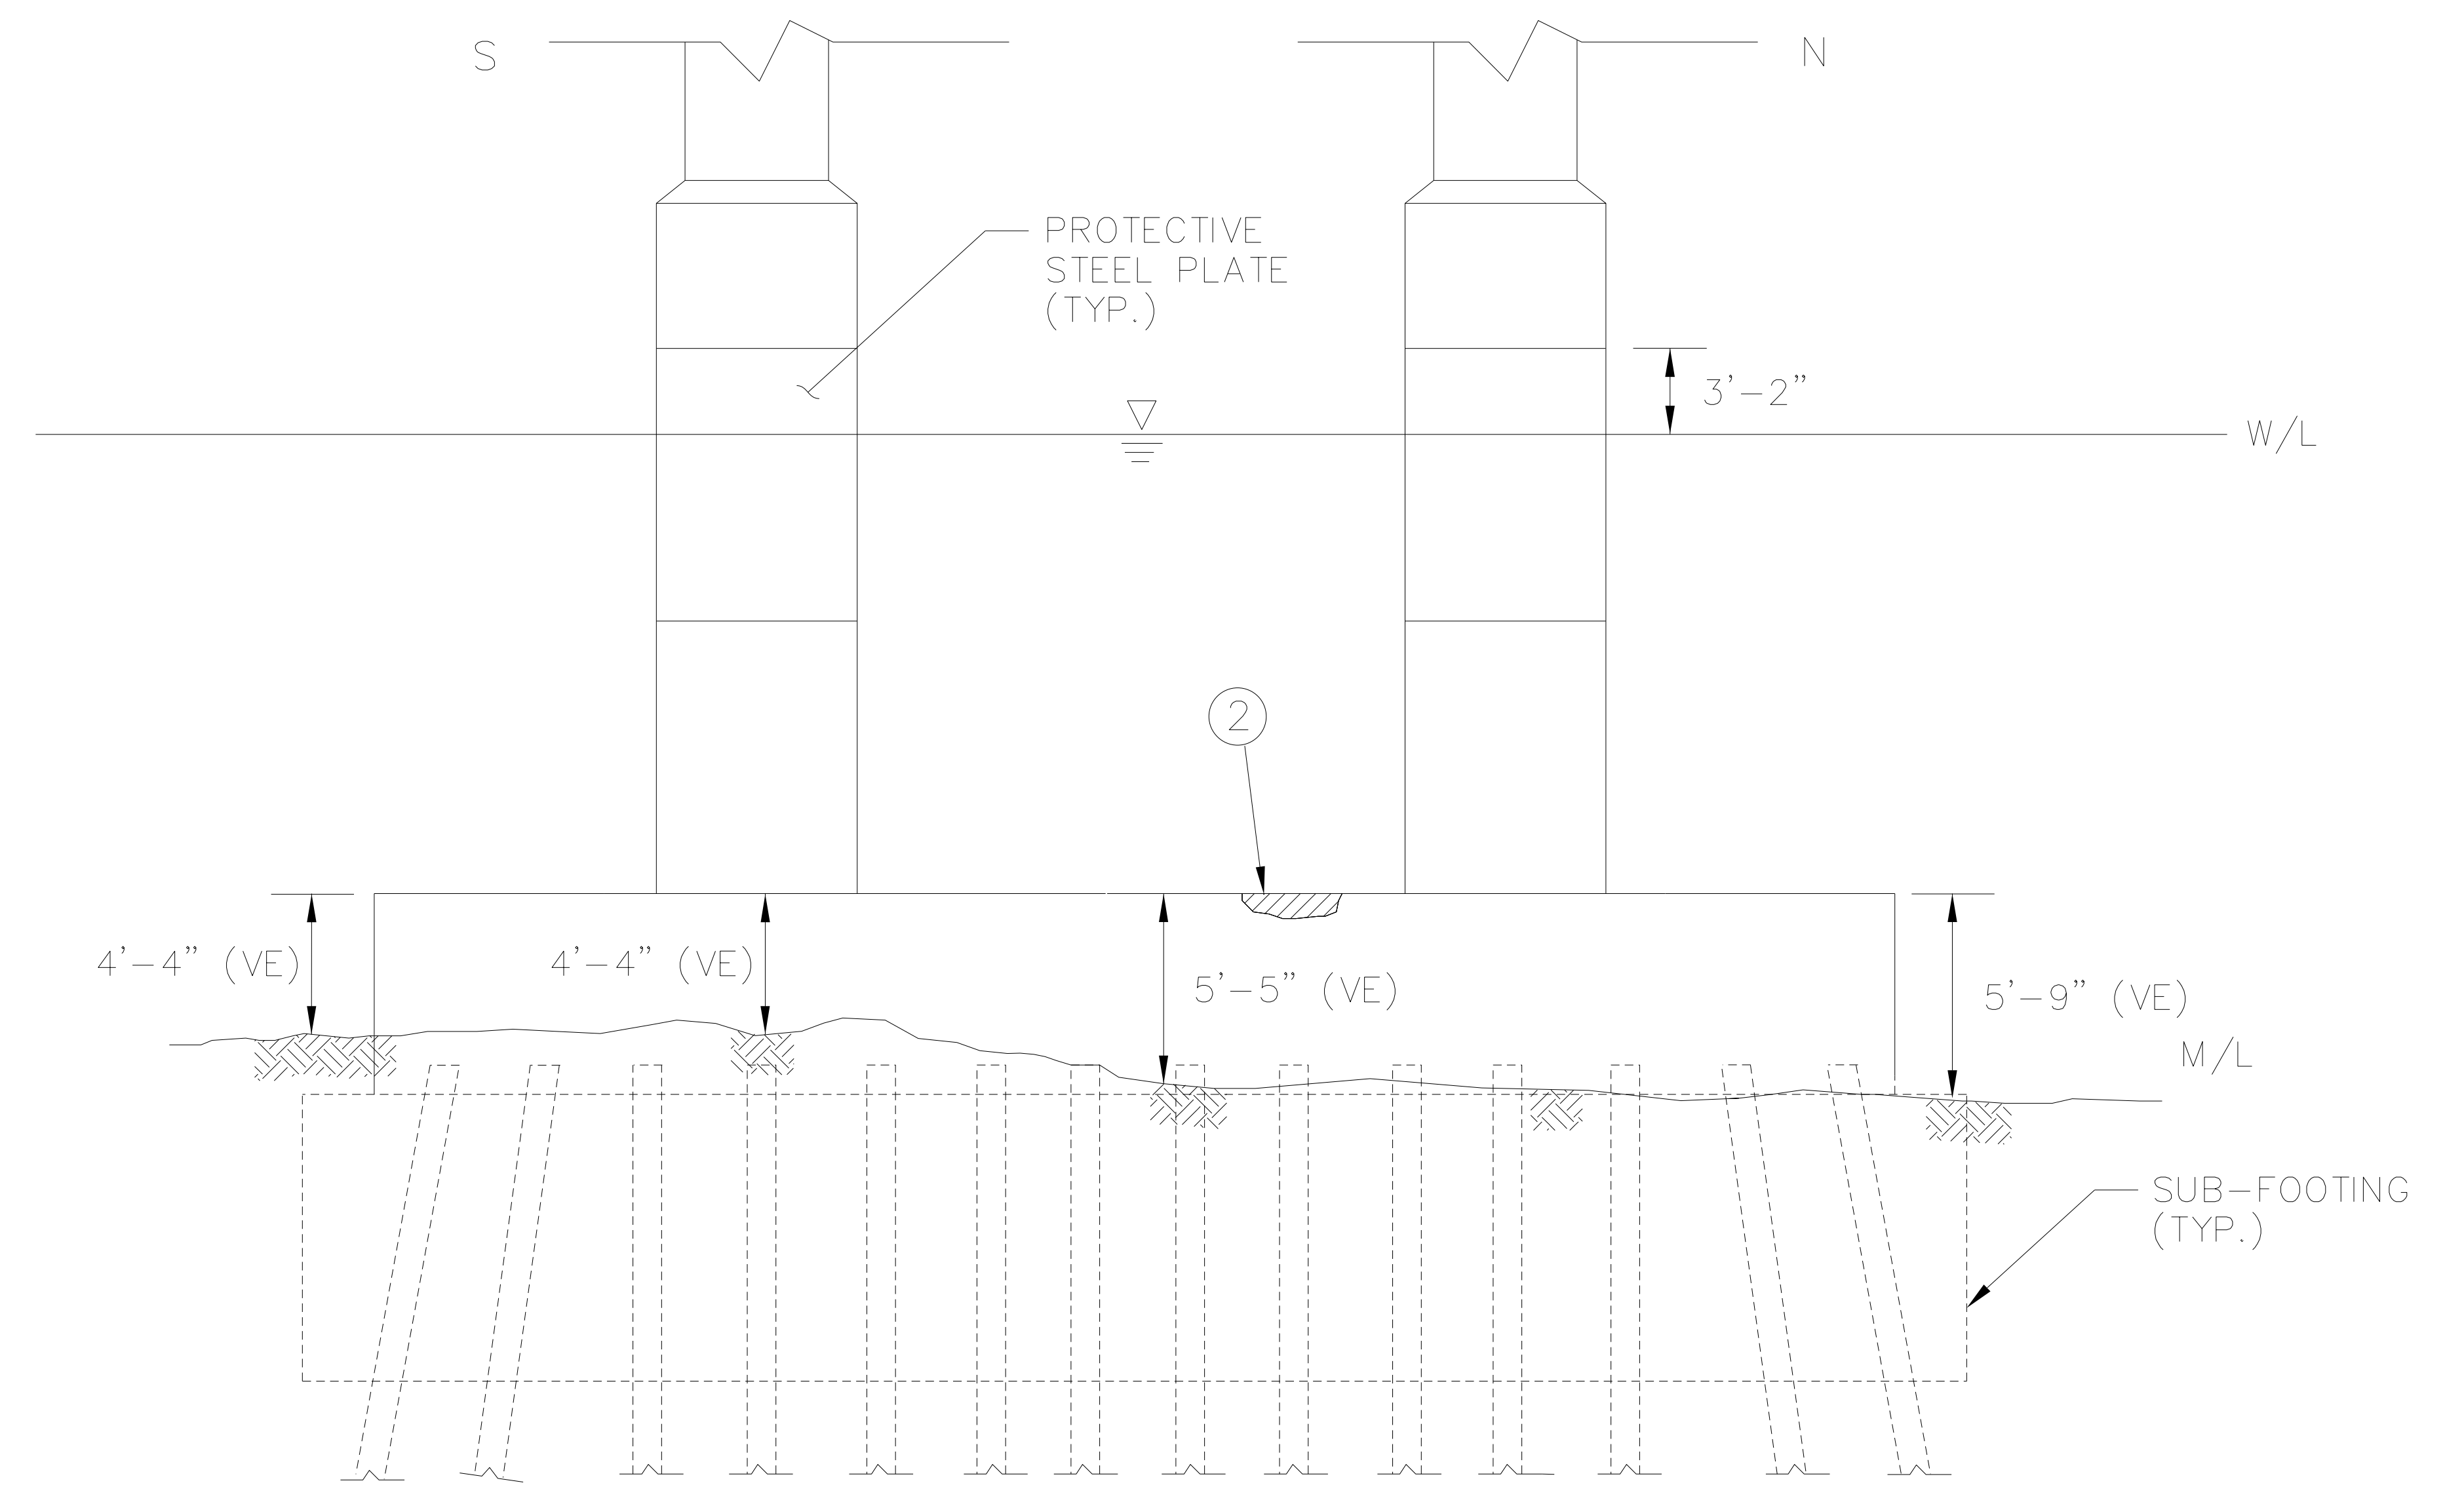

EAST ELEVATION

② FOOTING, 17'-0" FROM NORTHEAST CORNER - 4" H x 1'-10" W x 2" D EDGE SPALL.

(VE) INDICATES VERTICAL EXPOSURE.

GENERAL NOTES:


1. MODERATE MARINE GROWTH UP TO 1" THICK CONSISTING OF BARNACLES AND ALGAE.
2. CHANNEL BOTTOM COMPOSITION IS SMALL RUBBLE AND SAND WITH MUDLINE PENETRATIONS UP TO 1'-0".
3. SEVERE CORROSION ON STEEL PLATES WITH UP TO 3/8" DEEP PITTING.
4. RANDOM AREAS OF SMALL CHIPS AND HONEYCOMBING ALONG EDGES OF EXPOSED FOOTING.
5. MINOR HONEYCOMBING UP TO 1/8" DEEP ON ALL SUBMERGED CONCRETE SURFACES THROUGHOUT.
6. PIER COLUMNS AND STEEL PROTECTION PLATES EPOXY COATED SINCE PREVIOUS INSPECTION. EPOXY COATING ON STEEL PLATES IS FAILING IN THE TIDAL ZONE.
7. CONSTRUCTION DEBRIS AND STEEL H-PILES ON AND PROTRUDING FROM TOP OF FOOTING.

FRANCIS SCOTT KEY BRIDGE FACILITY I-695 OVER THE PATAPSCO RIVER STRUCTURE NO. BCZ472001 PIER 15	SCALE	NOT TO SCALE
	INSP. DATE	MARCH 29 TO APRIL 8, 2021
	DIVERS SUP.	M. OWINGS, PE, C. NIEMIEC, PE A. SCHINDHELM, PE, C. NIEMIEC, PE,
	INSP. DIVERS	K. MORROW, N. GUZMA
ENGINEERS		M. OWINGS, PE, C. NIEMIEC, PE




CONTRACT NO.
AE-3016-000-001
DRAWING NO.

2

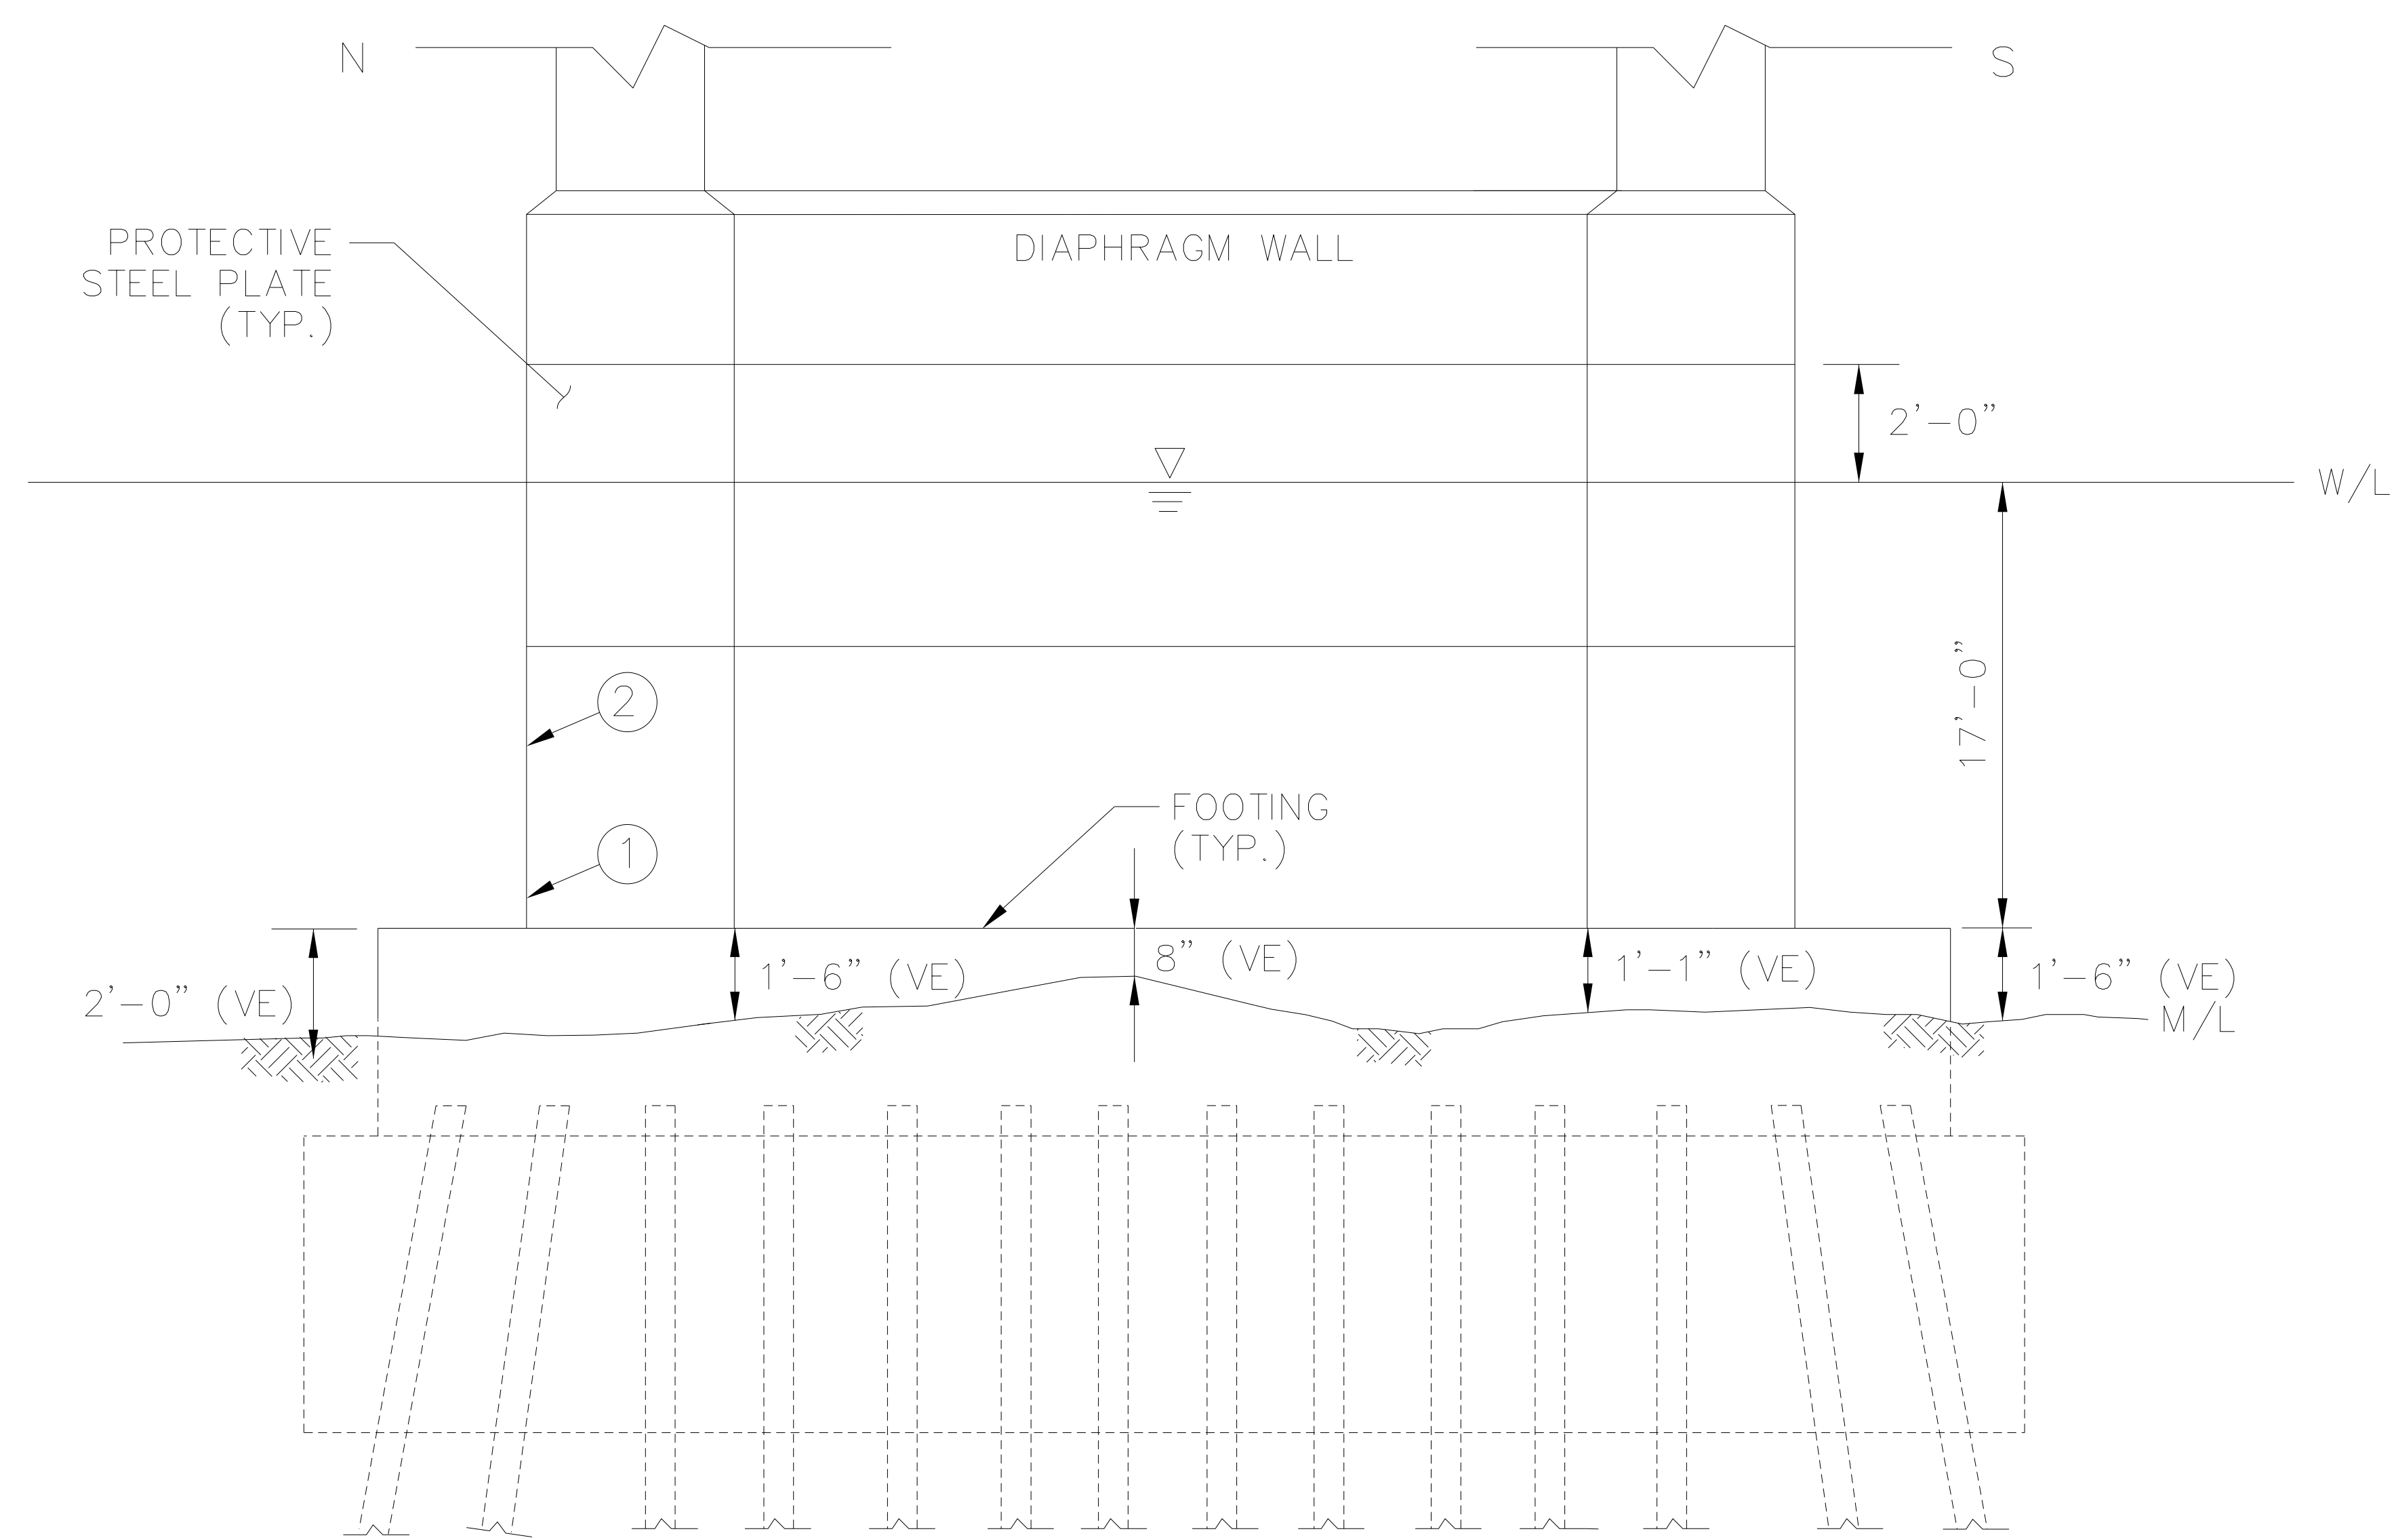

WEST ELEVATION

- ① NORTH COLUMN, NORTHWEST CHAMFER, 1'-1" ABOVE FOOTING - 1'-0" L x 2" H x 1" D VOID ALONG HORIZONTAL CONSTRUCTION JOINT.
- ② NORTH COLUMN, NORTHWEST CHAMFER, 2'-10" ABOVE FOOTING - 5" L x 1" H x 1/2" D VOID ALONG HORIZONTAL CONSTRUCTION JOINT.

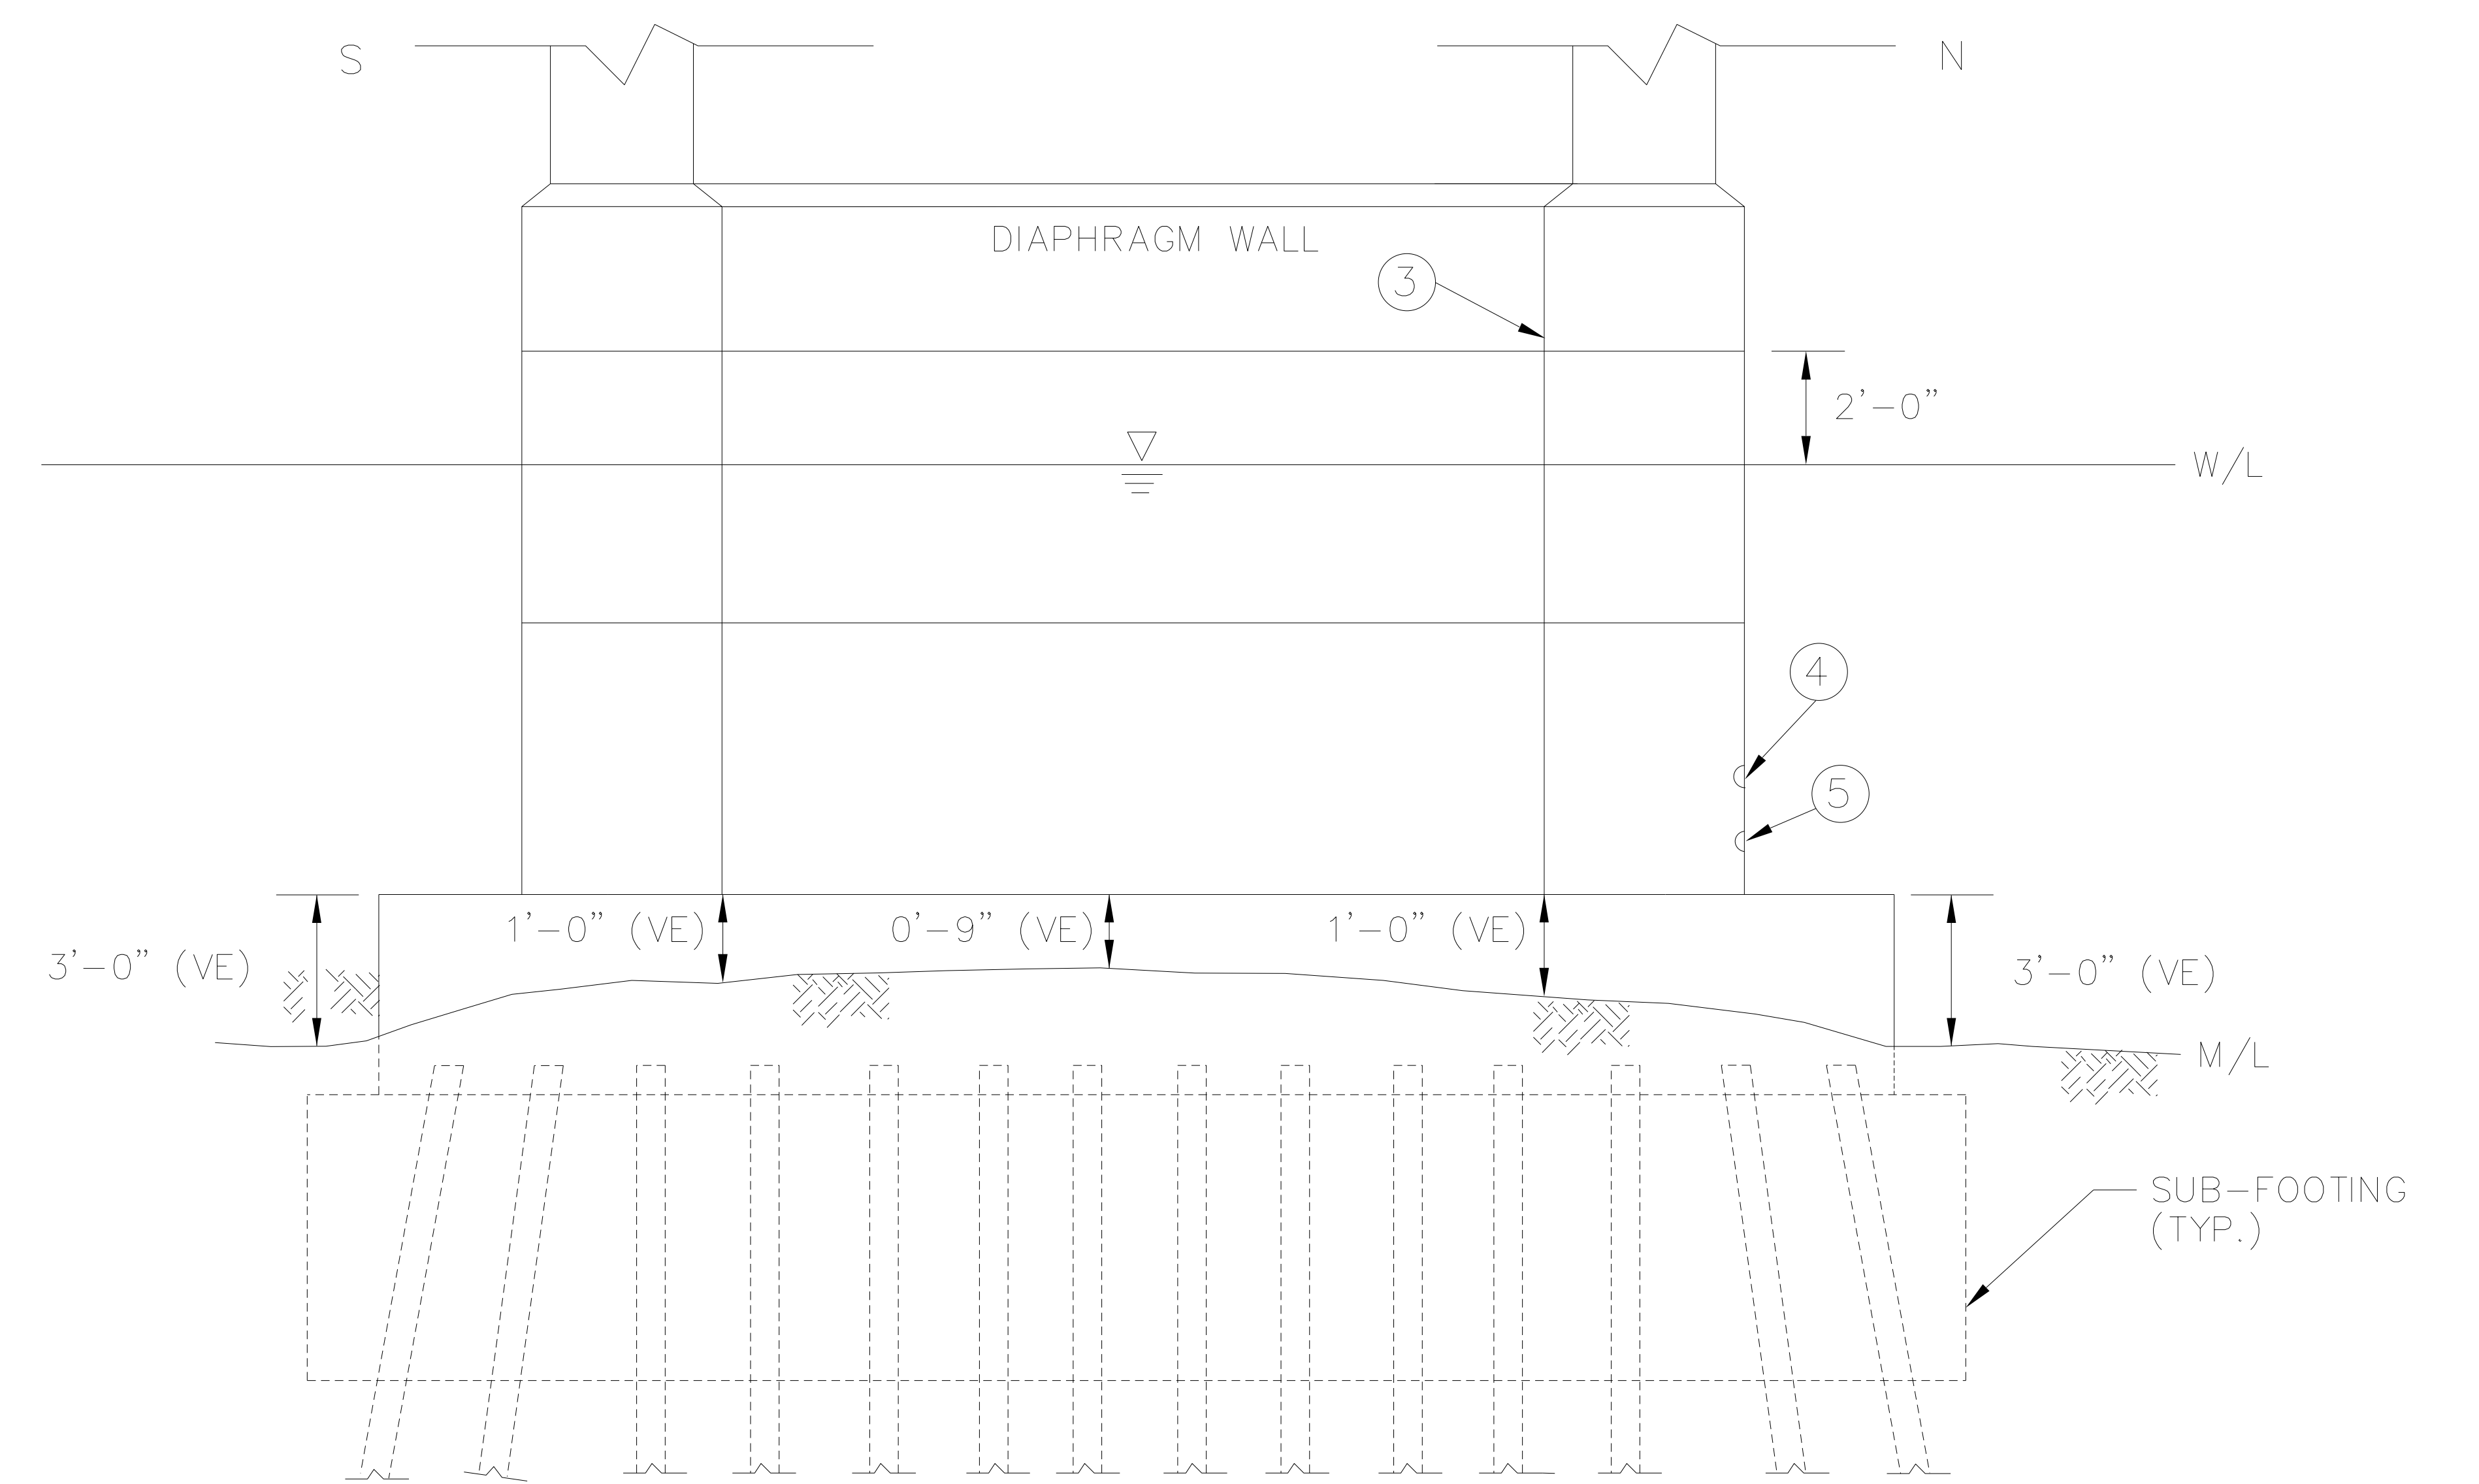

EAST ELEVATION

- ③ TYPICAL COLUMN, ABOVE STEEL PROTECTION PLATE - MINOR SPALLS UP TO 6" H x 1'-0" W x 1" D.
- ④ NORTH COLUMN, NORTHEAST CHAMFER, 2'-6" ABOVE FOOTING - 2'-0" L x 2" H x 2 1/2" D VOID ALONG HORIZONTAL CONSTRUCTION JOINT.
- ⑤ NORTH COLUMN, NORTHEAST CHAMFER, 6" ABOVE FOOTING - 2'-0" L x 1 1/2" H x 1" D VOID ALONG HORIZONTAL CONSTRUCTION JOINT.

GENERAL NOTES:

1. MODERATE MARINE GROWTH UP TO 1" THICK CONSISTING OF BARNACLES AND ALGAE.
2. CHANNEL BOTTOM COMPOSITION IS SMALL RUBBLE, SHELLS AND SAND WITH MUDLINE PENETRATIONS UP TO 6" DEEP.
3. SEVERE CORROSION ON STEEL PLATES WITH UP TO 3/8" DEEP PITTING.
4. SEVERAL AREAS OF ORIGINAL EPOXY COATING FAILURE ON CONCRETE FACES OF PIER COLUMNS AND FOOTING (UP TO 50% OF SURFACE AREA).
5. CONSTRUCTION DEBRIS AND STEEL H-PILES ON AND PROTRUDING FROM TOP OF FOOTING.
6. RANDOM AREAS OF SMALL CHIPS AND HONEYCOMBING ALONG EDGES OF EXPOSED FOOTING.
7. MINOR HONEYCOMBING UP TO 1/8" DEEP ON ALL SUBMERGED CONCRETE SURFACES THROUGHOUT.


(VE) INDICATES VERTICAL EXPOSURE.

FRANCIS SCOTT KEY BRIDGE FACILITY I-695 OVER THE PATAPSCO RIVER STRUCTURE NO. BCZ472001 PIER 16	SCALE <u>NOT TO SCALE</u>
	INSP. DATE <u>MARCH 29 TO APRIL 8, 2021</u>
	DIVERS SUP. <u>M. OWINGS, PE, C. NIEMIEC, PE</u>
	INSP. DIVERS <u>A. SCHINDHELM, PE, C. NIEMIEC, PE,</u> <u>K. MORROW, N. GUZMA</u>
	ENGINEERS <u>M. OWINGS, PE, C. NIEMIEC, PE</u>



CONTRACT NO.
AE-3016-000-001
DRAWING NO.

3

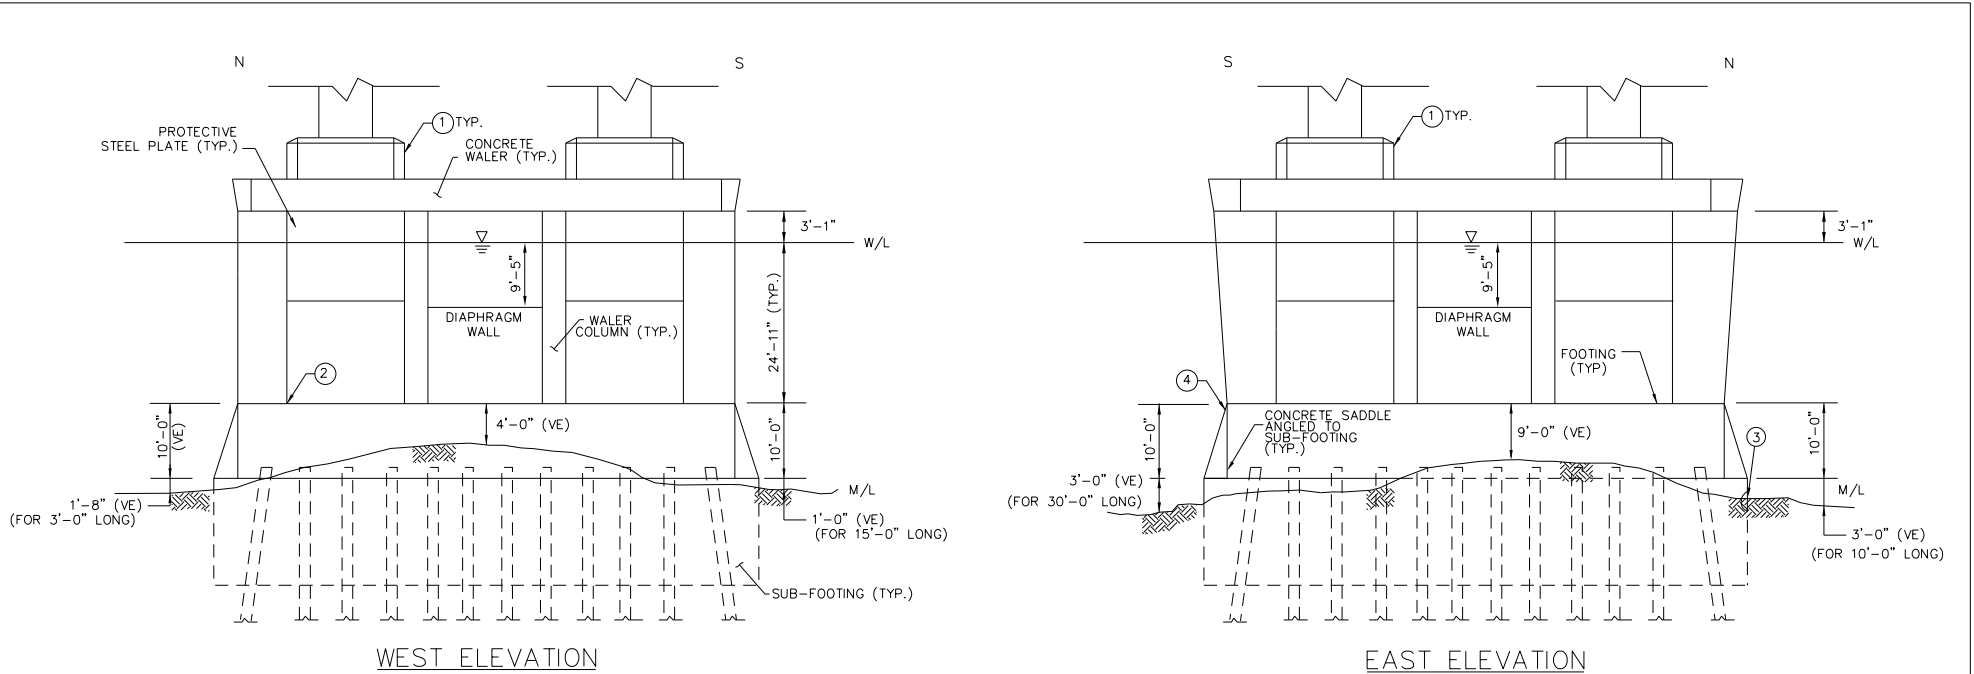

- ① TYPICAL COLUMN, ABOVE CONCRETE WALER – RANDOM MAP CRACKING UP TO 1/8" WIDE.
- ② FOOTING, 3'-0" FROM NORTHWEST CORNER – 4" H x 7" W x 1 1/2" D SPALL.


- ③ SUB-FOOTING, NORTHEAST CORNER AT MUDLINE – VOID LOCATED 3' BELOW TOP 9" H X 4'-0" W WITH 6'-0" ± OF PENETRATION (ALSO EXTENDS 4'-0" ALONG THE NORTH FACE).
- ④ FOOTING, SOUTHEAST CORNER 1'-0" BELOW THE TOP, HORIZONTAL CRACK 8'-0" L X 1/8" W.

GENERAL NOTES:


1. MODERATE MARINE GROWTH UP TO 1" CONSISTING OF BARNACLES AND ALGAE.
2. CHANNEL BOTTOM COMPOSITION IS SMALL RUBBLE AND SAND WITH UP TO 3" DEEP MUDLINE PENETRATIONS.
3. SEVERE CORROSION ON STEEL PLATES WITH UP TO 3/8" DEEP PITTING.
4. SEVERAL AREAS OF ORIGINAL EPOXY COATING FAILURE ON CONCRETE FACES OF PIER COLUMNS AND FOOTING (UP TO 80% OF SURFACE AREA).
5. CONSTRUCTION DEBRIS AND STEEL H-PILES ON AND PROTRUDING FROM TOP OF FOOTING.
6. MINOR HONEYCOMBING AND SHALLOW SPALLING ON VERTICAL FACES OF SUB-FOOTING 3/4" TO 1 1/2" DEEP MAX.
7. RANDOM AREAS OF SMALL CHIPS AND HONEYCOMBING ALONG EDGES OF EXPOSED FOOTING.
8. MINOR HONEYCOMBING UP TO 1/8" DEEP ON ALL SUBMERGED CONCRETE SURFACES THROUGHOUT.

FRANCIS SCOTT KEY BRIDGE FACILITY I-695 OVER THE PATAPSCO RIVER STRUCTURE NO. BCZ472001		SCALE NOT TO SCALE INSP. DATE MARCH 29 TO APRIL 8, 2021 DIVERS SUP. M. OWINGS, PE, C. NEMEC, PE A. SCHINDHELM, PE, C. NEMEC, PE, K. MORROW, N. GUZMA ENGINEERS M. OWINGS, PE, C. NEMEC, PE
PIER 17: WEST & EAST		

				CONTRACT NO. PE-3016-000-001 DRAWING NO. 4
<i>A Joint Venture</i>				

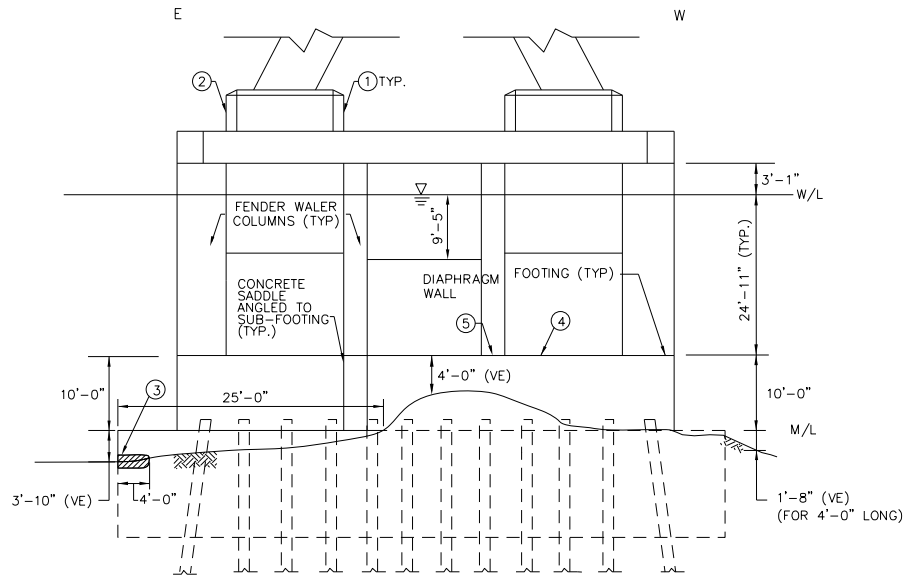

NORTH ELEVATION

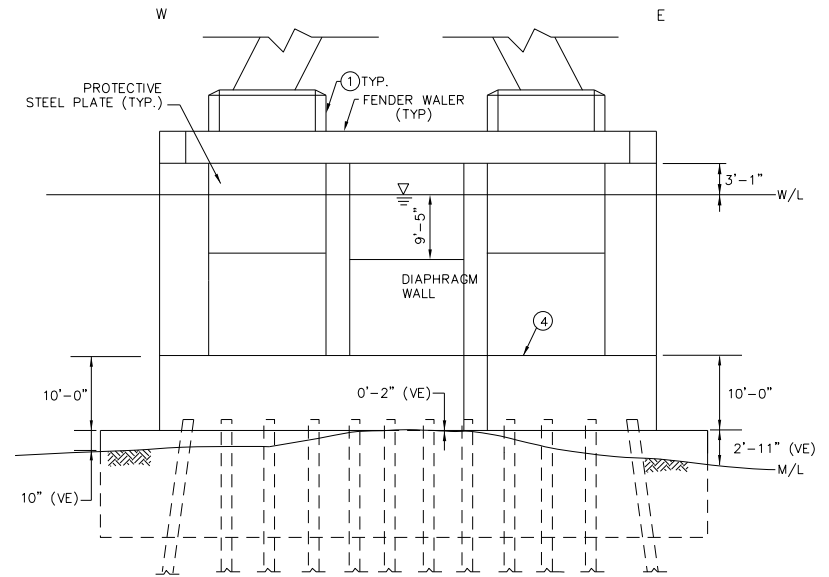

SOUTH ELEVATION

- ① TYPICAL COLUMN, ABOVE CONCRETE WALER – RANDOM MAP CRACKING UP TO 1/8" WIDE.
- ② NORTH COLUMN, EAST FACE, ABOVE CONCRETE WALER – 1/8" W VERTICAL CRACK WITH FAILED EPOXY REPAIR.
- ③ SUB-FOOTING, NORTHEAST CORNER AT MUDLINE – VOID LOCATED 3' BELOW TOP 9" H X 4'-0" W WITH 6'-0" ± OF PENETRATION (ALSO EXTENDS 4'-0" ALONG THE EAST FACE).
- ④ SEVERAL EDGE SPALLS LOCATED AT TOP OF FOOTING, UP TO 8" H X 1'-6" W X 1 1/2" D.
- ⑤ FENDER WALER COLUMN, NORTH FACE AT FOOTING, SPALL 8" H X 4" W X 2" D.


GENERAL NOTES:

- 1. MODERATE MARINE GROWTH UP TO 1" CONSISTING OF BARNACLES AND ALGAE.
- 2. CHANNEL BOTTOM COMPOSITION IS SMALL RUBBLE AND SAND WITH UP TO 3" DEEP MUDLINE PENETRATIONS.
- 3. SEVERE CORROSION ON STEEL PLATES WITH UP TO 3/8" DEEP PITTING.
- 4. SEVERAL AREAS OF ORIGINAL EPOXY COATING FAILURE ON CONCRETE FACES OF PIER COLUMNS AND FOOTING (UP TO 80% OF SURFACE AREA).
- 5. CONSTRUCTION DEBRIS AND STEEL H-PILES ON AND PROTRUDING FROM TOP OF FOOTING.
- 6. MINOR HONEYCOMBING AND SHALLOW SPALLING ON VERTICAL FACES OF SUB-FOOTING 3/4" TO 1 1/2" DEEP MAX.
- 7. RANDOM AREAS OF SMALL CHIPS AND HONEYCOMBING ALONG EDGES OF EXPOSED FOOTING.
- 8. MINOR HONEYCOMBING UP TO 1/8" DEEP ON ALL SUBMERGED CONCRETE SURFACES THROUGHOUT.


(VE) INDICATES VERTICAL EXPOSURE

FRANCIS SCOTT KEY BRIDGE FACILITY I-695 OVER THE PATAPSCO RIVER STRUCTURE NO. BCZ472001 PIER 17: NORTH & SOUTH	SCALE	NOT TO SCALE
	INSP. DATE	MARCH 29 TO APRIL 8, 2021
	DIVERS SUP.	M. OWINGS, PE, C. NIEMEC, PE
	INSP. DIVERS	A. SCHINDHELM, PE, C. NIEMEC, PE, K. MORROW, N. GUZMA
ENGINEERS		M. OWINGS, PE, C. NIEMEC, PE

	<p>WALLACE MONTGOMERY A Joint Venture</p>	<small>CONTRACT NO. PE-3016-000-001</small> <small>DRAWING NO.</small> 5
--	---	---

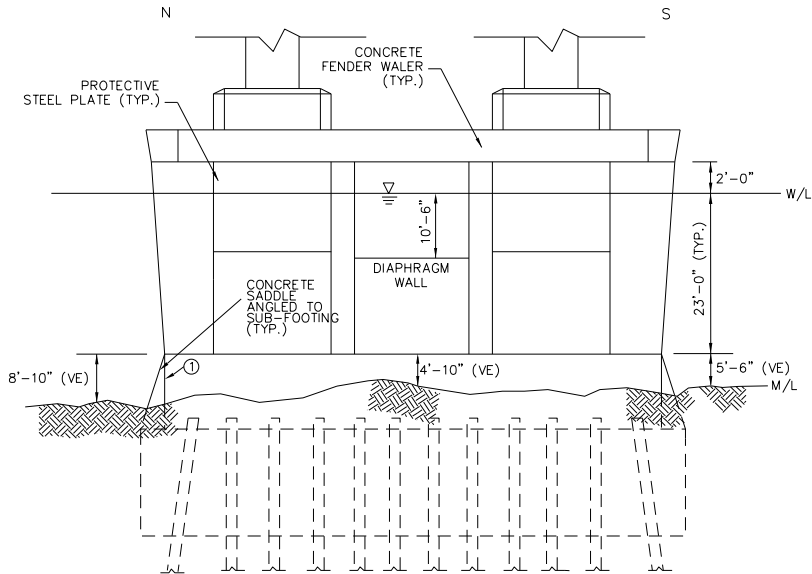

WEST ELEVATION

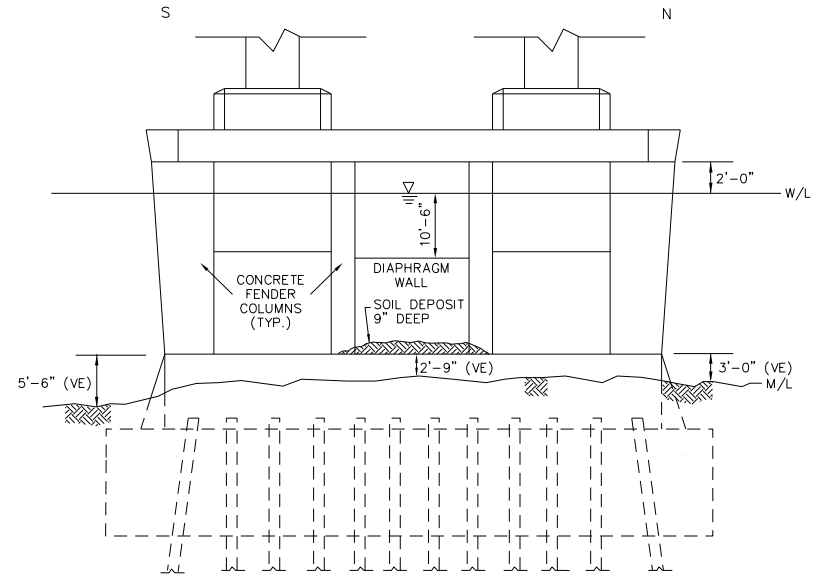

EAST ELEVATION

① FOOTING, NORTHWEST CORNER, 3'-0" FROM TOP - THE 3" H X 4" W X 1" D SPALL WAS NOT FOUND DURING THIS INSPECTION.


GENERAL NOTES:

1. MODERATE MARINE GROWTH UP TO 1" CONSISTING OF BARNACLES AND ALGAE.
2. CHANNEL BOTTOM COMPOSITION IS SMALL RUBBLE AND SAND WITH UP TO 3" DEEP MUDLINE PENETRATIONS.
3. SEVERE CORROSION ON STEEL PLATES WITH UP TO 3/8" DEEP PITTING.
4. SEVERAL AREAS OF ORIGINAL EPOXY COATING FAILURE ON CONCRETE FACES OF PIER COLUMNS AND FOOTING (UP TO 80% OF SURFACE AREA).
5. CONSTRUCTION DEBRIS AND STEEL H-PILES ON AND PROTRUDING FROM TOP OF FOOTING.
6. MINOR HONEYCOMBING AND SHALLOW SPALLING ON VERTICAL FACES OF SUB-FOOTING 3/4" TO 1 1/2" DEEP MAX.
7. RANDOM AREAS OF SMALL CHIPS AND HONEYCOMBING ALONG EDGES OF EXPOSED FOOTING.
8. MINOR HONEYCOMBING UP TO 1/8" DEEP ON ALL SUBMERGED CONCRETE SURFACES THROUGHOUT.


(VE) INDICATES VERTICAL EXPOSURE

FRANCIS SCOTT KEY BRIDGE FACILITY I-695 OVER THE PATAPSCO RIVER STRUCTURE NO. BCZ472001 PIER 18: WEST & EAST	SCALE <u>NOT TO SCALE</u>
	INSP. DATE <u>MARCH 29 TO APRIL 8, 2021</u>
	DIVERS SUP. <u>M. OWINGS, PE, C. NIEMEC, PE</u>
	INSP. DIVERS <u>A. SCHINDHELM, PE, C. NIEMEC, PE, K. MORROW, N. GUZMA</u>
	ENGINEERS <u>M. OWINGS, PE, C. NIEMEC, PE</u>

			<small>CONTRACT NO. AE-3016-000-001</small> <small>DRAWING NO. 6</small>
<i>A Joint Venture</i>			

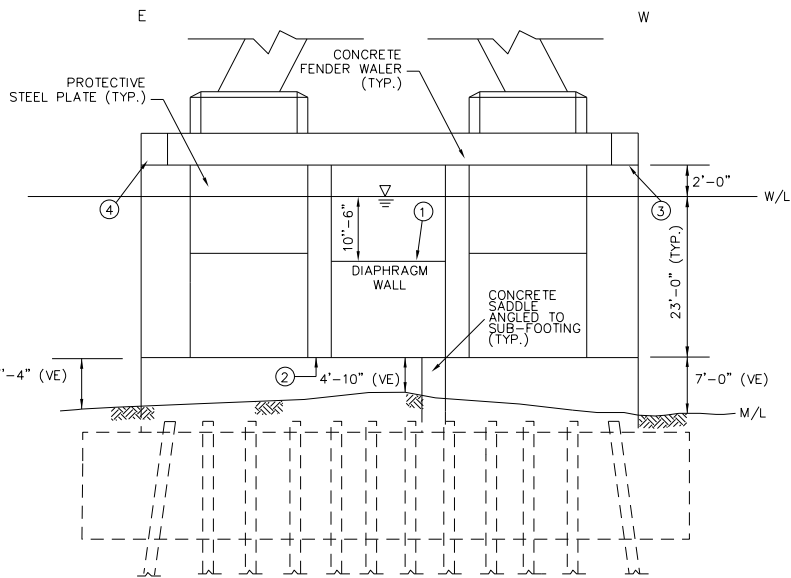

NORTH ELEVATION

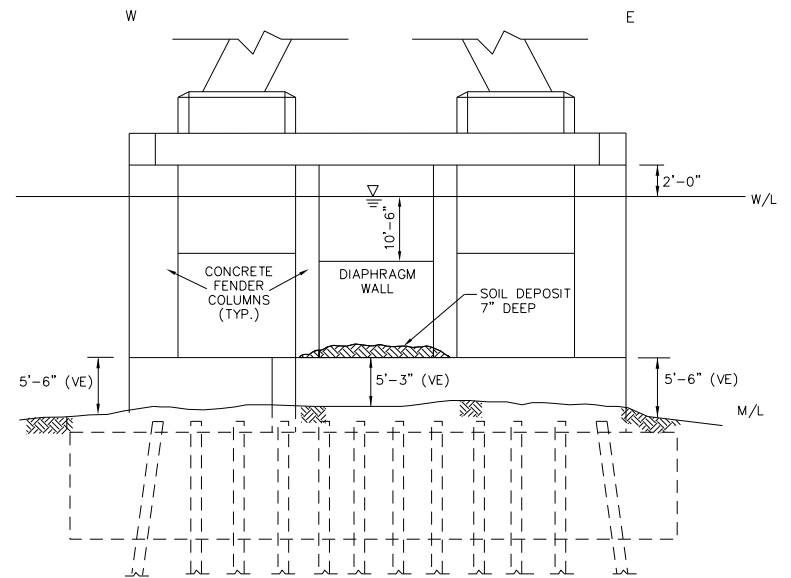

SOUTH ELEVATION

- ① TOP OF DIAPHRAGM WALL IRREGULAR THROUGHOUT UP TO 3/4" DEEP.
- ② COLUMN EXTENDS 2" OUT FROM FACE OF FOOTING.
- ③ HORIZONTAL CONCRETE WALER, NORTHWEST CORNER, BOTTOM - SCALED AND DELAMINATED UP TO 5'-0" L X 3'-0" W X 3" D WITH EXPOSED STEEL REINFORCEMENT WITH UP TO 100% SECTION LOSS, MODERATE EFFLORESCENCE, AND RUST STAINING.
- ④ HORIZONTAL CONCRETE WALER, NORTHEAST CORNER, BOTTOM - SCALED AND DELAMINATED UP TO 2'-0" L X 2'-0" W X 3" D WITH EXPOSED REINFORCEMENT WITH UP TO 75% SECTION LOSS, MODERATE EFFLORESCENCE, AND RUST STAINING.


GENERAL NOTES:

- 1. MODERATE MARINE GROWTH UP TO 1" CONSISTING OF BARNACLES AND ALGAE.
- 2. CHANNEL BOTTOM COMPOSITION IS SMALL RUBBLE AND SAND WITH UP TO 3" DEEP MUDLINE PENETRATIONS.
- 3. SEVERE CORROSION ON STEEL PLATES WITH UP TO 3/8" DEEP PITTING.
- 4. SEVERAL AREAS OF ORIGINAL EPOXY COATING FAILURE ON CONCRETE FACES OF PIER COLUMNS AND FOOTING (UP TO 80% OF SURFACE AREA).
- 5. CONSTRUCTION DEBRIS AND STEEL H-PILES ON AND PROTRUDING FROM TOP OF FOOTING.
- 6. MINOR HONEYCOMBING AND SHALLOW SPALLING ON VERTICAL FACES OF SUB-FOOTING 3/4" TO 1 1/2" DEEP MAX.
- 7. RANDOM AREAS OF SMALL CHIPS AND HONEYCOMBING ALONG EDGES OF EXPOSED FOOTING.
- 8. MINOR HONEYCOMBING UP TO 1/8" DEEP ON ALL SUBMERGED CONCRETE SURFACES THROUGHOUT.


(VE) INDICATES VERTICAL EXPOSURE

FRANCIS SCOTT KEY BRIDGE FACILITY 1-6% OVER THE PATAPSCO RIVER STRUCTURE NO. BCZ472001		SCALE NOT TO SCALE INSP. DATE MARCH 29 TO APRIL 8, 2021 DIVERS SUP. M. OWINGS, PE, C. NIEMEC, PE A. SCHINDHELM, PE, C. NIEMEC, PE, K. MORROW, N. GUZMA INSP. DIVERS ENGINEERS M. OWINGS, PE, C. NIEMEC, PE
PIER 18: NORTH & SOUTH		

			CONTRACT NO. AE-3016-000-001 DRAWING NO. 7
<i>A Joint Venture</i>			

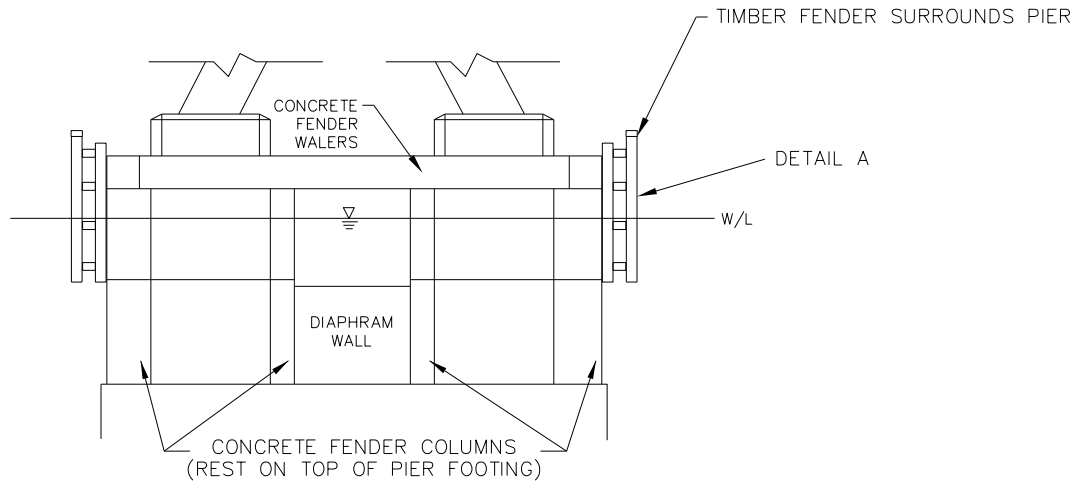

TYPICAL NORTH/SOUTH ELEVATION

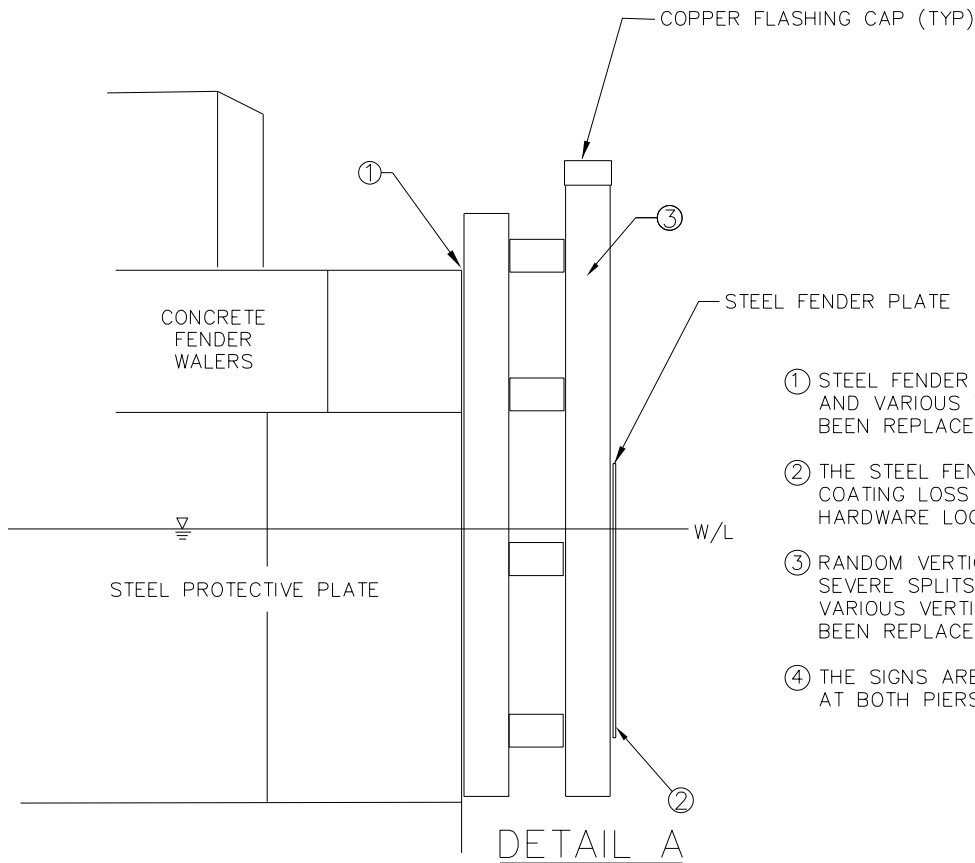


- ① STEEL FENDER PLATE, ASSOCIATED HARDWARE, AND VARIOUS VERTICAL TIMBER MEMBERS HAVE BEEN REPLACED OR REHABILITATED.
- ② THE STEEL FENDER PLATE HAS ISOLATED COATING LOSS AND LIGHT CORROSION OF THE HARDWARE LOCATED THROUGHOUT.
- ③ RANDOM VERTICAL TIMBER MEMBERS HAVE SEVERE SPLITS, CHECKS, OR IMPACT DAMAGE. VARIOUS VERTICAL TIMBER MEMBERS HAVE BEEN REPLACED.
- ④ THE SIGNS ARE TYPICALLY DAMAGED AND FADED AT BOTH PIERS.

FRANCIS SCOTT KEY BRIDGE FACILITY
 I-695 OVER THE PATAPSCO RIVER
 STRUCTURE NO. BCZ472001
PIERS 17 & 18:
FENDER NOTES

SCALE NOT TO SCALE
 INSP. DATE MARCH 29 TO APRIL 8, 2021
 DIVERS SUP. M.OWINGS, PE, C. NIEMIEC, PE
 INSP. DIVERS A. SCHINDHELM, PE, C. NIEMIEC, PE,
 K. MORROW, N. GUZMA
 ENGINEERS M.OWINGS, PE, C. NIEMIEC, PE




CONTRACT NO.
 AE-3016-000-001
 DRAWING NO.

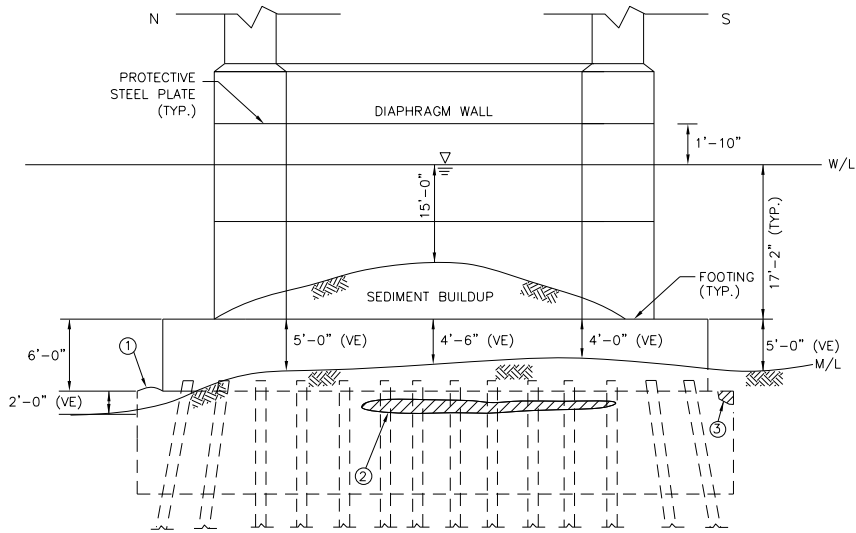

WEST ELEVATION

- ① SUB-FOOTING, NORTHWEST CORNER - CONCRETE OVERPOUR ON TOP 1'-6" HIGH.
- ② SUB-FOOTING, 26'-0" FROM NORTHWEST CORNER, 6" BELOW TOP - 6" H x 15'-0" L x 10" D VOID. (BURRIED DURING 2017 & 2021 INSPECTION)
- ③ SUB-FOOTING, SOUTHWEST CORNER - 6" DIA. x 3" D CORNER SPALL. (BURRIED DURING 2017 & 2021 INSPECTION)

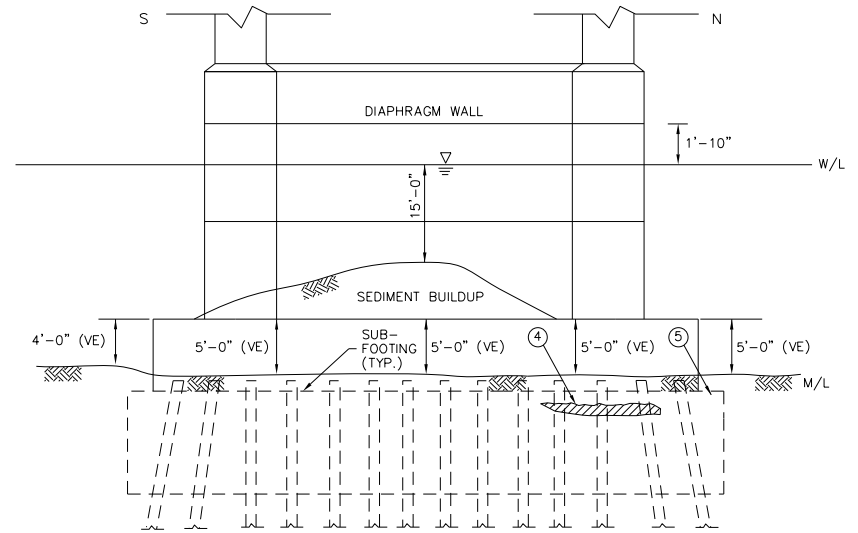

EAST ELEVATION

- ④ SUB-FOOTING, 12'-0" FROM NORTHEAST CORNER, 9" BELOW TOP - 10" H x 16'-0" L x 10" D VOID. (BURRIED DURING 2017 & 2021 INSPECTION)
- ⑤ SUB-FOOTING, EAST FACE, NORTH END - 4'-0" L x 1" W HORIZONTAL CRACK WITH ASSOCIATED 1'-6" HIGH DELAMINATION. (BURRIED DURING 2017 & 2021 INSPECTION)

GENERAL NOTES:

1. MODERATE MARINE GROWTH UP TO 3" THICK CONSISTING OF BARNACLES AND ALGAE.
2. CHANNEL BOTTOM COMPOSITION IS SMALL RUBBLE AND MUD WITH MUDLINE PENETRATIONS UP TO 3" DEEP.
3. MODERATE CORROSION ON STEEL PLATES WITH UP TO 3/8" DEEP PITTING.
4. A FEW RANDOM AREAS OF EPOXY COATING FAILURE ON CONCRETE FACES OF PIER COLUMNS AND FOOTING (5%-10%).
5. RANDOM AREAS OF SMALL CHIPS AND HONEYCOMBING ALONG EDGES OF EXPOSED FOOTING.
6. MINOR HONEYCOMBING UP TO 1/8" DEEP ON ALL SUBMERGED CONCRETE SURFACES THROUGHOUT.
7. CONSTRUCTION DEBRIS AND STEEL H-PILES ON AND PROTRUDING FROM TOP OF FOOTING.

(VE) INDICATES VERTICAL EXPOSURE

FRANCIS SCOTT KEY BRIDGE FACILITY
I-695 OVER THE PATAPSCO RIVER
STRUCTURE NO. BCZ472001

PIER 19

SCALE	NOT TO SCALE
INSP. DATE	MARCH 29 TO APRIL 8, 2021
DIVERS SUP.	M. OWINGS, PE, C. NIEMEC, PE
INSP. DIVERS	A. SCHINDHELM, PE, C. NIEMEC, PE, K. MORROW, N. GUZMA
ENGINEERS	M. OWINGS, PE, C. NIEMEC, PE


MARINE SOLUTIONS

AECOM **WSP**
A Joint Venture

WALLACE MONTGOMERY


CONTRACT NO.
AE-3016-000-001
DRAWING NO.

9

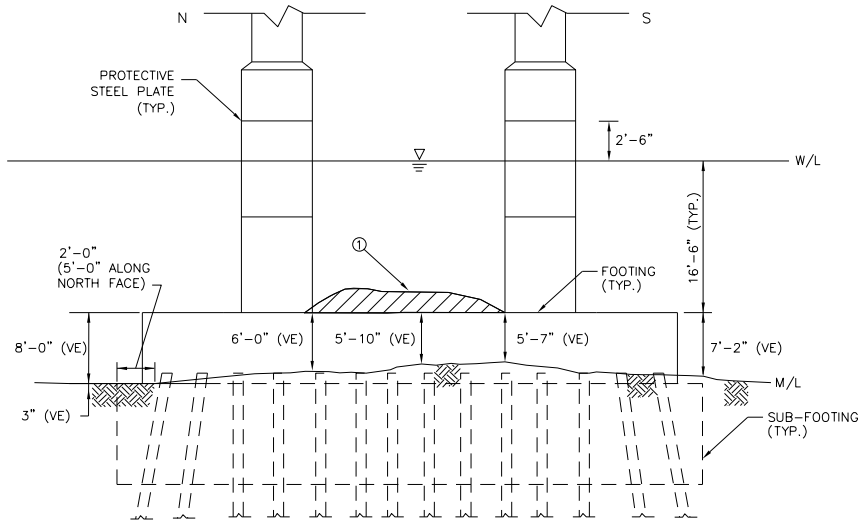

WEST ELEVATION

① BETWEEN COLUMNS, UP TO 2'-0" OF SEDIMENT ON TOP OF FOOTING.

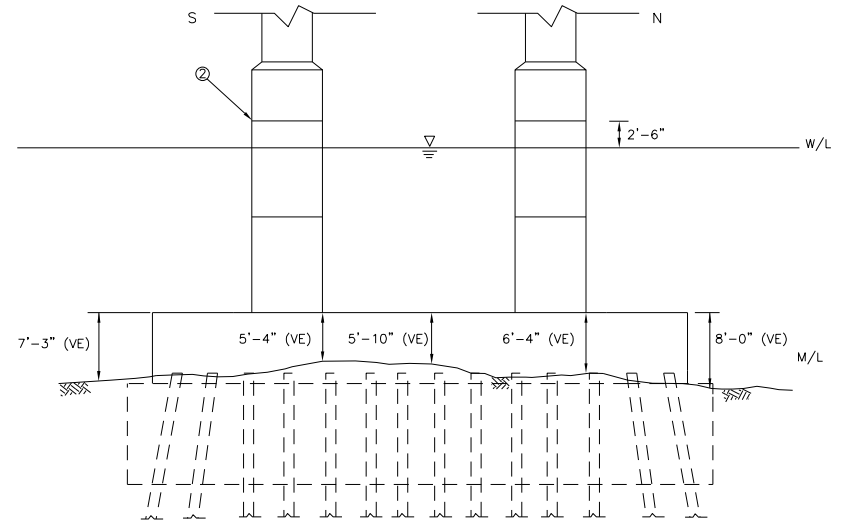

EAST ELEVATION

② SOUTH COLUMN, SOUTHEAST CORNER ABOVE PLATE- 1'-0" H X 4" W X 1" D EDGE SPALL.

GENERAL NOTES:

1. MODERATE MARINE GROWTH UP TO 1" THICK CONSISTING OF BARNACLES AND ALGAE.
2. CHANNEL BOTTOM COMPOSITION IS SMALL RUBBLE AND SAND WITH MUDLINE PENETRATIONS UP TO 1'-0" DEEP.
3. MODERATE CORROSION ON STEEL PLATES WITH UP TO 3/8" DEEP PITTING.
4. RANDOM AREAS OF SMALL CHIPS AND HONEYCOMBING ALONG EDGES OF EXPOSED FOOTING.
5. MINOR HONEYCOMBING UP TO 1/8" DEEP ON ALL SUBMERGED CONCRETE SURFACES THROUGHOUT.
6. EXPOSED FOOTING HAS RANDOM SPALLS UP TO 6" L X 3" W X 1" D ALONG THE TOP EDGE.
7. CONSTRUCTION DEBRIS AND STEEL H-PILES ON AND PROTRUDING FROM TOP OF FOOTING.

(VE) INDICATES VERTICAL EXPOSURE

FRANCIS SCOTT KEY BRIDGE FACILITY
1-6% OVER THE PATAPSCO RIVER
STRUCTURE NO. BCZ473001


PIER 20

SCALE NOT TO SCALE
INSP. DATE MARCH 29 TO APRIL 8, 2021
DIVERS SUP. M. OWINGS, PE, C. NIEMEC, PE
INSP. DIVERS A. SCHINDHELM, PE, C. NIEMEC, PE, K. MORROW, N. GUZMA
ENGINEERS M. OWINGS, PE, C. NIEMEC, PE




CONTRACT NO. AE-3016-000-001
DRAWING NO.

10

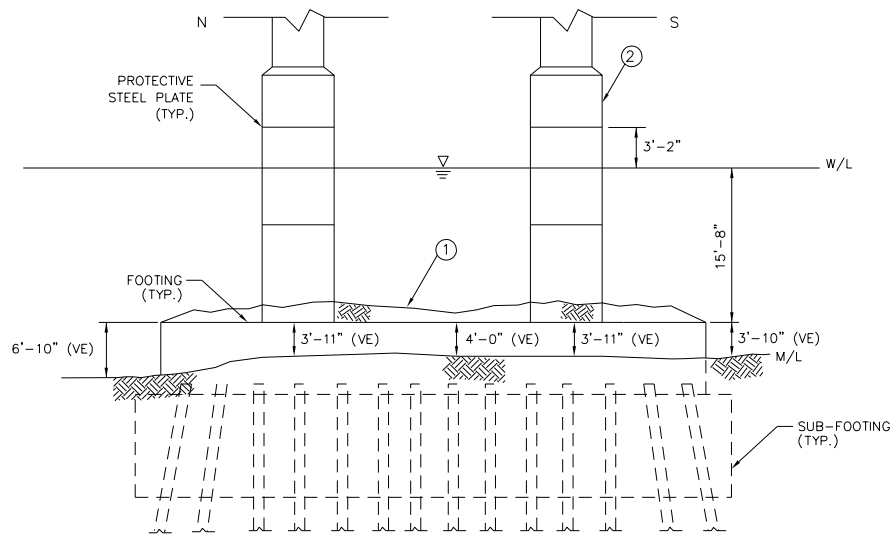

WEST ELEVATION

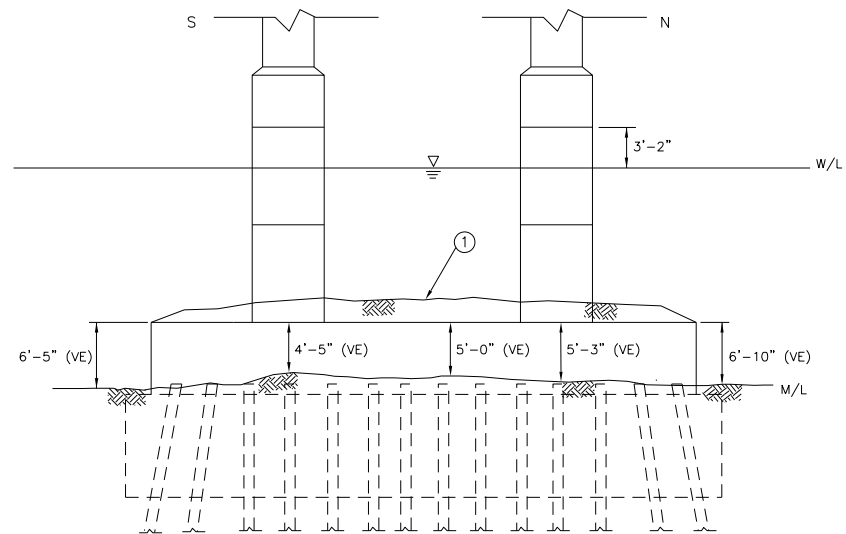

EAST ELEVATION

- ① 75% OF THE TOP OF THE FOOTING IS COVERED WITH DEBRIS (CONCRETE, STEEL AND SEDIMENT).
- ② THE COLUMNS ABOVE THE PROTECTION PLATE HAVE RANDOM CORNER SPALLS UP TO 6" H X 4" W X 1" D.

(VE) INDICATES VERTICAL EXPOSURE

GENERAL NOTES:

1. MODERATE MARINE GROWTH UP TO 1" THICK CONSISTING OF BARNACLES AND ALGAE.
2. CHANNEL BOTTOM COMPOSITION IS SMALL RUBBLE AND SAND WITH MUDLINE PENETRATIONS UP TO 1'-0" DEEP.
3. SEVERE CORROSION ON STEEL PLATES WITH UP TO 3/8" DEEP PITTING.
4. A FEW RANDOM AREAS OF EPOXY COATING FAILURE ON CONCRETE FACES OF PIER COLUMNS AND FOOTING (5%-10%).
5. RANDOM AREAS OF SMALL CHIPS AND HONEYCOMBING ALONG EDGES OF EXPOSED FOOTING.
6. MINOR HONEYCOMBING UP TO 1/8" DEEP ON ALL SUBMERGED CONCRETE SURFACES THROUGHOUT.

FRANCIS SCOTT KEY BRIDGE FACILITY
I-695 OVER THE PATAPSCO RIVER
STRUCTURE NO. BCZ472001


PIER 21

SCALE NOT TO SCALE
INSP. DATE MARCH 29 TO APRIL 8, 2021
DIVERS SUP. M. OWINGS, PE, C. NIEMEC, PE
A. SCHINDHELM, PE, C. NIEMEC, PE,
K. MORROW, N. GUZMA
ENGINEERS M. OWINGS, PE, C. NIEMEC, PE




CONTRACT NO. AE-3016-000-001
DRAWING NO.

11

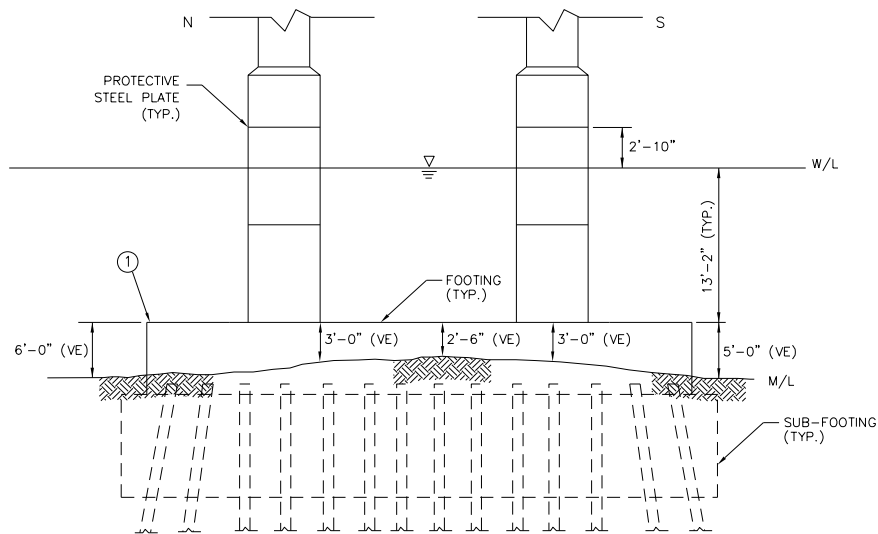

WEST ELEVATION

① FOOTING, NORTH FACE, 12'-0" FROM NORTHWEST CORNER - 1'-0" H x 10" W x 1/2" D EDGE SPALL.

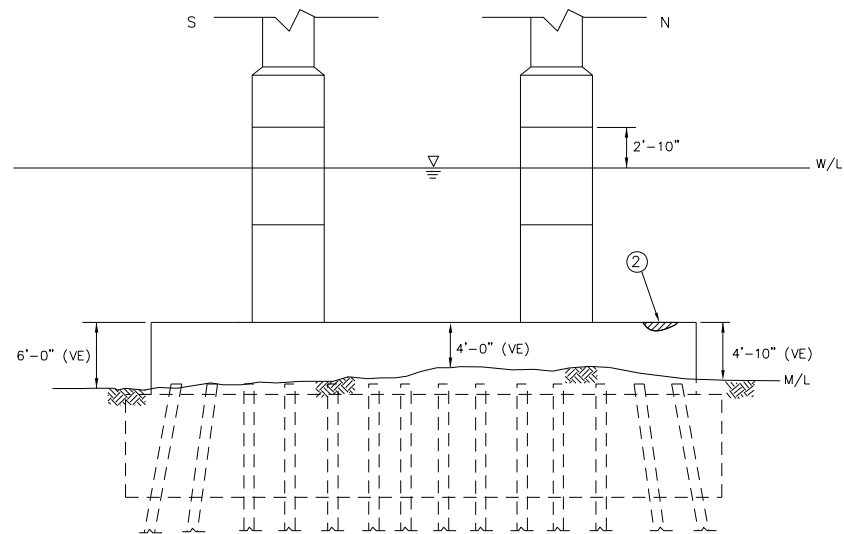

EAST ELEVATION

② FOOTING, EAST FACE, 4'-0" FROM NORTHEAST CORNER - 1'-0" H x 1'-7" W x 3" D EDGE SPALL.


GENERAL NOTES:

1. MODERATE MARINE GROWTH UP TO 3" THICK CONSISTING OF BARNACLES AND ALGAE.
2. CHANNEL BOTTOM COMPOSITION IS SMALL RUBBLE AND SAND WITH MUDLINE PENETRATIONS UP TO 3" DEEP.
3. SEVERE CORROSION ON STEEL PLATES WITH UP TO 3/8" DEEP PITTING.
4. A FEW RANDOM AREAS OF EPOXY COATING FAILURE ON CONCRETE FACES OF PIER COLUMNS AND FOOTING (5%-10%).
5. RANDOM AREAS OF SMALL CHIPS AND HONEYCOMBING ALONG EDGES OF EXPOSED FOOTING.
6. MINOR HONEYCOMBING UP TO 1/8" DEEP ON ALL SUBMERGED CONCRETE SURFACES THROUGHOUT.
7. CONSTRUCTION DEBRIS AND STEEL H-PILES ON AND PROTRUDING FROM TOP OF FOOTING.


(VE) INDICATES VERTICAL EXPOSURE

FRANCIS SCOTT KEY BRIDGE FACILITY I-695 OVER THE PATAPSCO RIVER STRUCTURE NO. BCZ472001 PIER 22	SCALE <u>NOT TO SCALE</u>
	INSP. DATE <u>MARCH 29 TO APRIL 8, 2021</u>
	DIVERS SUP. <u>M. OWINGS, PE, C. NIEMEC, PE</u>
	INSP. DIVERS <u>A. SCHINDHELM, PE, C. NIEMEC, PE, K. MORROW, N. GUZMA</u>
ENGINEERS <u>M. OWINGS, PE, C. NIEMEC, PE</u>	

			<small>CONTRACT NO. AE-3016-000-001</small> <small>DRAWING NO.</small> 12
<i>A Joint Venture</i>			

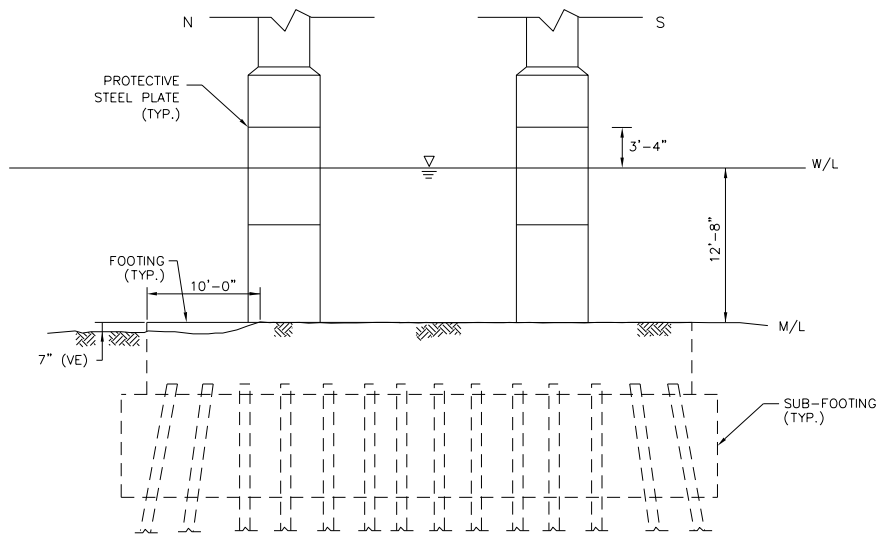

WEST ELEVATION

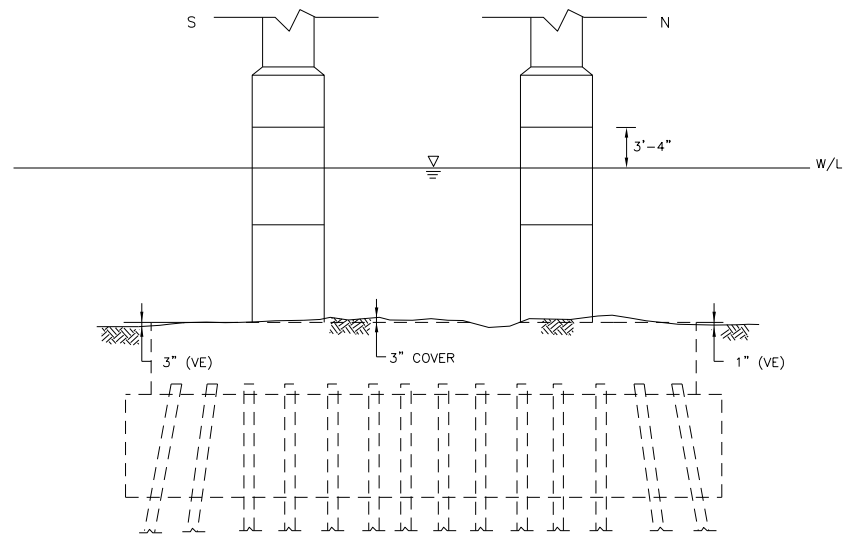

EAST ELEVATION

GENERAL NOTES:

1. MODERATE MARINE GROWTH UP TO 3" THICK CONSISTING OF BARNACLES AND ALGAE.
2. CHANNEL BOTTOM COMPOSITION IS SMALL RUBBLE AND SAND WITH MUDLINE PENETRATIONS UP TO 1'-0" DEEP.
3. SEVERE CORROSION ON STEEL JACKETS WITH UP TO 3/8" DEEP PITTING.
4. RANDOM AREAS OF SMALL CHIPS AND HONEYCOMBING ALONG EDGES OF EXPOSED FOOTING.
5. MINOR HONEYCOMBING UP TO 1/8" DEEP ON ALL SUBMERGED CONCRETE SURFACES THROUGHOUT.
6. PIER COLUMNS AND STEEL PROTECTION PLATES EPOXY COATED SINCE PREVIOUS INSPECTION. EPOXY COATING ON STEEL PLATES IS FAILING IN THE TIDAL ZONE.
7. CONSTRUCTION DEBRIS AND STEEL H-PILES ON AND PROTRUDING FROM TOP OF FOOTING.

(VE) INDICATES VERTICAL EXPOSURE

FRANCIS SCOTT KEY BRIDGE FACILITY
I-695 OVER THE PATAPSCO RIVER
STRUCTURE NO. BCZ472001


PIER 23

SCALE NOT TO SCALE
INSP. DATE MARCH 29 TO APRIL 8, 2021
DIVERS SUP. M. OWINGS, PE, C. NIEMEC, PE
A. SCHINDHELM, PE, C. NIEMEC, PE,
K. MORROW, N. GUZMA
ENGINEERS M. OWINGS, PE, C. NIEMEC, PE




CONTRACT NO.
AE-3016-000-001
DRAWING NO.

13

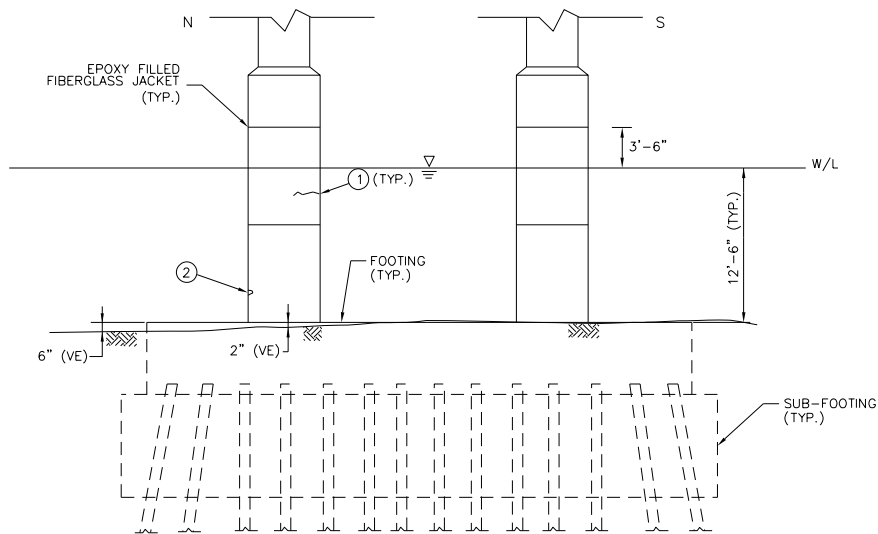

WEST ELEVATION

- ① EPOXY FILLED FIBERGLASS JACKETS HAVE BEEN INSTALLED SINCE THE PREVIOUS INSPECTION.
- ② NORTH COLUMN, NORTHWEST CORNER, 4'-6" ABOVE FOOTING - 2" H x 7" W x 2" D VOID.

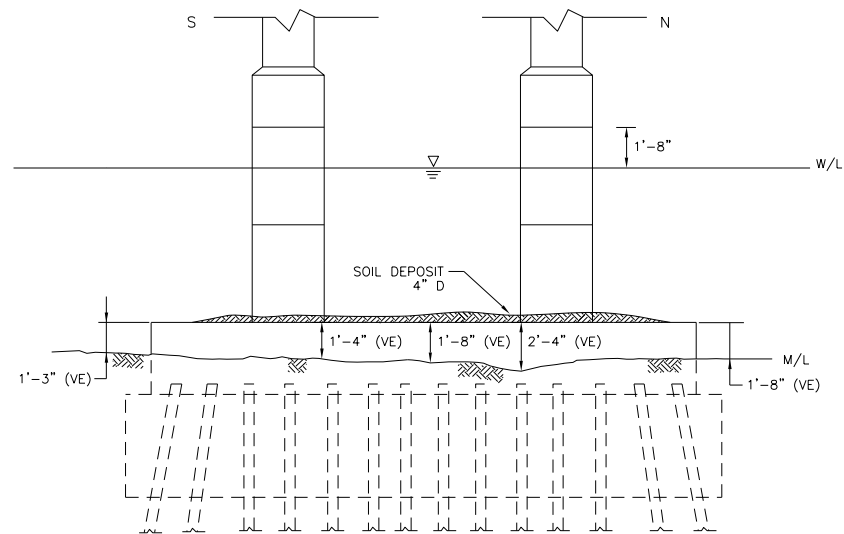

EAST ELEVATION


GENERAL NOTES:

1. MODERATE MARINE GROWTH UP TO 2" THICK CONSISTING OF BARNACLES AND ALGAE.
2. CHANNEL BOTTOM COMPOSITION IS SMALL RUBBLE AND SAND WITH MUDLINE PENETRATIONS UP TO 1'-0" DEEP.
3. OBSTRUCT THE STEEL PROTECTIVE PLATES [EPOXY FILLED FIBERGLASS JACKETS]
4. RANDOM AREAS OF SMALL CHIPS AND HONEYCOMBING ALONG EDGES OF EXPOSED FOOTING.
5. MINOR HONEYCOMBING UP TO 1/8" DEEP ON ALL SUBMERGED CONCRETE SURFACES THROUGHOUT.
6. PIER COLUMNS AND STEEL PROTECTION PLATES EPOXY COATED SINCE PREVIOUS INSPECTION. EPOXY COATING ON STEEL PLATES IS FAILING IN THE TIDAL ZONE.
7. CONSTRUCTION DEBRIS AND STEEL H-PILES ON AND PROTRUDING FROM TOP OF FOOTING.



(VE) INDICATES VERTICAL EXPOSURE

FRANCIS SCOTT KEY BRIDGE FACILITY 1-6% OVER THE PATAPSCO RIVER STRUCTURE NO. BCZ472001 PIER 24	SCALE <u>NOT TO SCALE</u>
	INSP. DATE <u>MARCH 29 TO APRIL 8, 2021</u>
	DIVERS SUP. <u>M. OWINGS, PE, C. NIEMEC, PE</u> <u>A. SCHINDHELM, PE, C. NIEMEC, PE,</u> <u>K. MORROW, N. GUZMA</u> ENGINEERS <u>M. OWINGS, PE, C. NIEMEC, PE</u>


			CONTRACT NO. AE-3016-000-001 DRAWING NO. 14
<i>A Joint Venture</i>			

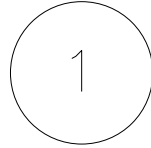


CHANNEL →

 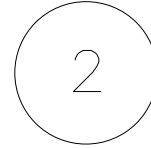

FRANCIS SCOTT KEY BRIDGE

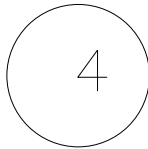

← SHIPPING

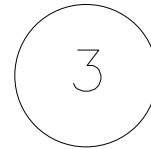

GENERAL NOTES (FOR ALL DOLPHINS):

1. MODERATE MARINE GROWTH UP TO 1" THICK CONSISTING OF BARNACLES AND ALGAE.
2. BOTTOM COMPOSITION IS SMALL RUBBLE, SILT, AND SAND.
3. NO APPARENT SCOURING OF BOTTOM MATERIALS, HOWEVER, MUDLINE PENETRATIONS UP TO 3'-0" DEEP.


**FRANCIS SCOTT KEY BRIDGE FACILITY
I-695 OVER THE PATAPSCO RIVER
STRUCTURE NO. BCZ472001**

DOLPHIN PLAN


SCALE NOT TO SCALE
 INSP. DATE MARCH 29 TO APRIL 8, 2021
 DIVERS SUP. M.OWINGS, PE, C. NIEMIEC, PE
 INSP. DIVERS A. SCHINDHELM, PE, C. NIEMIEC, PE,
K. MORROW, N. GUZMA
 ENGINEERS M.OWINGS, PE, C. NIEMIEC, PE



CONTRACT NO.
AE-3016-000-001
DRAWING NO.

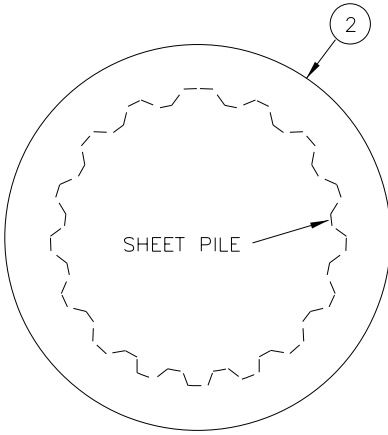

PLAN

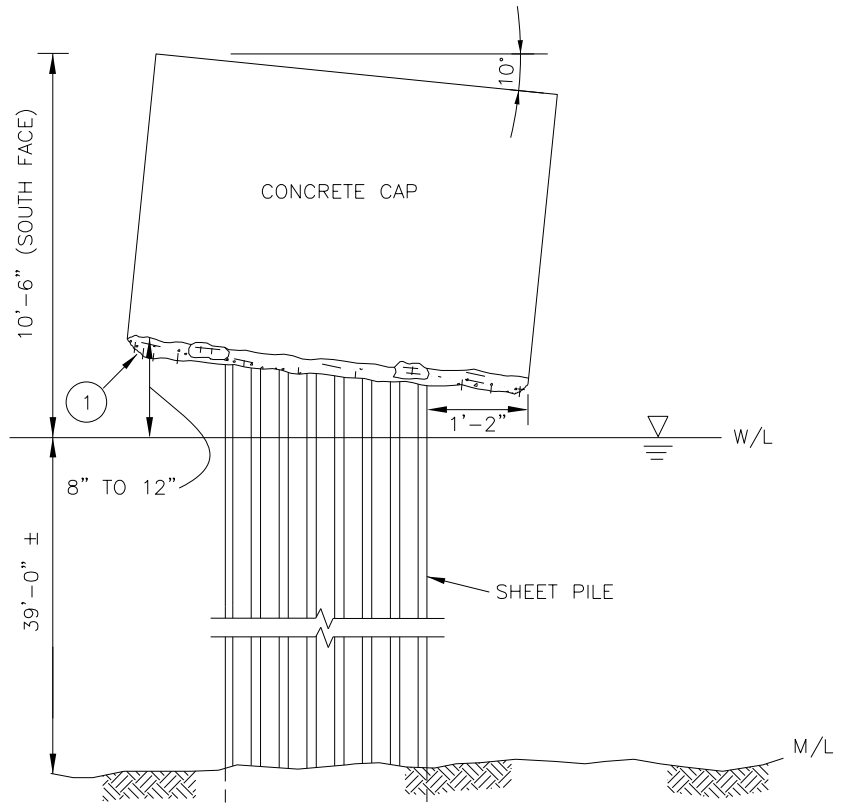

TYPICAL ELEVATION

- ① LOWER EDGE OF CONCRETE CAP EXHIBITS SEVERE SCALING AROUND ENTIRE CIRCUMFERENCE OF CAP, UP TO 2'-0" H x 1'-6" D, EXPOSING ENDS OF VERTICAL STEEL REINFORCEMENT, UP TO 10" LONG, AND A HORIZONTAL STEEL REINFORCING MEMBER THAT IS DEBONDED FOR 75% OF THE CIRCUMFERENCE. EXPOSED STEEL REINFORCEMENT IS SEVERELY CORRODED WITH UP TO 75% SECTION LOSS.
- ② HORIZONTAL JOINT APPROXIMATELY 22'-0" BELOW BOTTOM OF CAP EXHIBITS A DEFORMED STEEL PANEL WITH EXPOSED CONCRETE AND A MINOR VOID.

TYPICAL SHEETING:

MODERATE TO HEAVY CORROSION WITH 20% TO 30% SECTION LOSS FROM MUDLINE TO 22'-0" BELOW BOTTOM OF CAP WITH PITTING UP TO 1/8" DEEP.

HEAVY CORROSION WITH 30% TO 50% SECTION LOSS FROM 22'-0" TO 5'-0" BELOW BOTTOM OF CAP WITH PITTING 1/4" TO 3/8" DEEP.

SEVERE CORROSION WITH UP TO 100% SECTION LOSS (PERFORATIONS) FROM 5' BELOW BOTTOM OF CAP TO BOTTOM OF CAP WITH PITTING UP TO 1/2" DEEP.

RUBBER FENDERS ARE MISSING AND ATTACHMENT HARDWARE IS DAMAGED AT THE FOLLOWING LOCATIONS:
SOUTHEAST - MIDDLE

DOLPHIN CAP HAS ROTATED OUT OF PLUMB APPROXIMATELY 10-DEGREES DOWNWARD TOWARD THE NORTH.


FRANCIS SCOTT KEY BRIDGE FACILITY
I-695 OVER THE PATAPSCO RIVER
STRUCTURE NO. BCZ472001

DOLPHIN 1


SCALE NOT TO SCALE
INSP. DATE MARCH 29 TO APRIL 8, 2021
DIVERS SUP. M.OWINGS, PE, C. NIEMIEC, PE
INSP. DIVERS A. SCHINDHELM, PE, C. NIEMIEC, PE, K. MORROW, N. GUZMA
ENGINEERS M.OWINGS, PE, C. NIEMIEC, PE



CONTRACT NO. AE-3016-000-001
DRAWING NO.

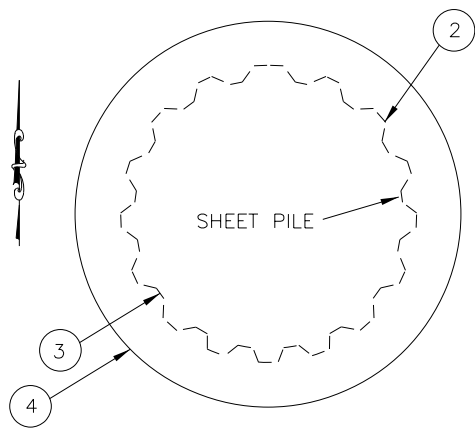

PLAN

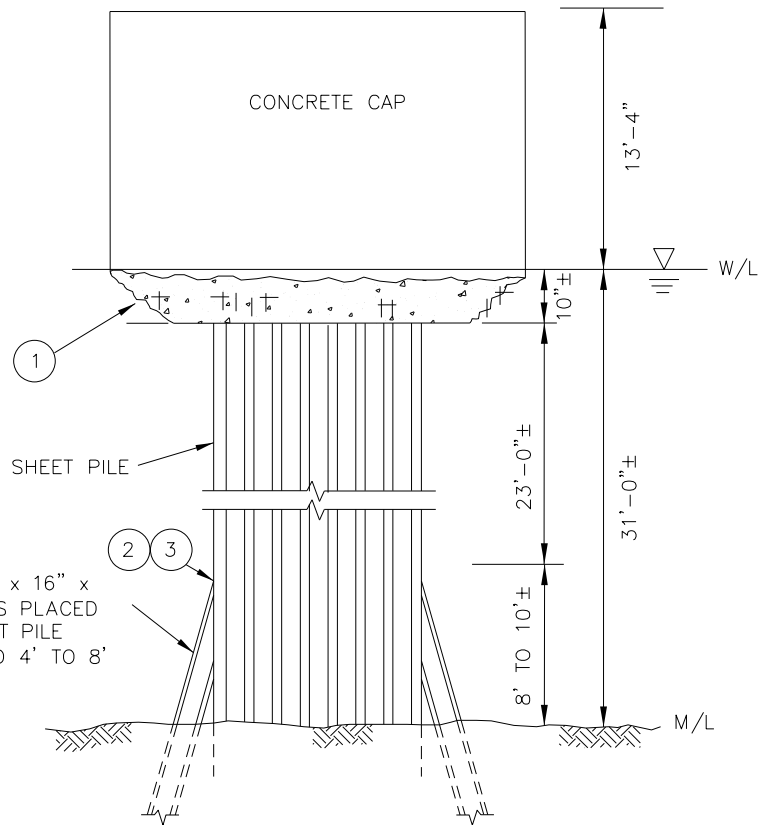

TYPICAL ELEVATION

BATTERED 16" x 16" x 5/16" H-PILES PLACED AROUND SHEET PILE SHAFT SPACED 4' TO 8' APART.

- ① LOWER EDGE OF CONCRETE CAP EXHIBITS SEVERE SCALING AROUND ENTIRE CIRCUMFERENCE OF CAP, UP TO 2'-0" H x 1'-6" D, EXPOSING ENDS OF VERTICAL STEEL REINFORCEMENT, UP TO 6" LONG. EXPOSED STEEL REINFORCEMENT HAS SEVERE CORROSION WITH UP TO 75% SECTION LOSS.
- ② OPENING IN SHEET PILE AT INTERFACE WITH H-PILE EXHIBITS A VOID IN EXPOSED CONCRETE, UP TO 2'-0" W x 6'-0" H x 3'-0" D.
- ③ OPENING IN SHEET PILE AT INTERFACE WITH H-PILE EXHIBITS A VOID IN EXPOSED CONCRETE, UP TO 1'-0" W x 4'-0" H x 1'-0" D.
- ④ SPALL AT RUBBER FENDER CONNECTION, 2'-4" L x 8" H x 10" D, WITH EXPOSED AND CORRODED STEEL REINFORCEMENT.

TYPICAL SHEETING:
 MODERATE TO HEAVY CORROSION WITH 20% TO 30% SECTION LOSS FROM MUDLINE TO 22'-0" BELOW BOTTOM OF CAP WITH PITTING UP TO 1/8" DEEP.

HEAVY CORROSION WITH 30% TO 50% SECTION LOSS FROM 22'-0" TO 5'-0" BELOW BOTTOM OF CAP WITH PITTING 1/4" TO 3/8" DEEP.

SEVERE CORROSION WITH UP TO 100% SECTION LOSS (PERFORATIONS) FROM 5'-0" BELOW BOTTOM OF CAP TO BOTTOM OF CAP WITH PITTING UP TO 1/2" DEEP.

RUBBER FENDERS ARE MISSING AND ATTACHMENT HARDWARE IS DAMAGED AT THE FOLLOWING LOCATIONS: EAST - MIDDLE

BATTERED H-PILES LOCATED APPROXIMATELY 20' BELOW BOTTOM OF CAP (5/16" WIDE FLANGE) PENETRATE INTO OPENINGS IN THE SHEET PILE SHAFT. THE OPENINGS TYPICALLY EXHIBIT VOIDS IN THE EXPOSED CONCRETE, UP TO 9" DEEP

THE H-PILES TYPICALLY HAVE HEAVY CORROSION WITH PITTING UP TO 1/8" DEEP OVER THE FULL EXPOSED HEIGHT.


FRANCIS SCOTT KEY BRIDGE FACILITY
I-695 OVER THE PATAPSCO RIVER
STRUCTURE NO. BCZ472001

DOLPHIN 2


SCALE NOT TO SCALE
 INSP. DATE MARCH 29 TO APRIL 8, 2021
 DIVERS SUP. M.OWINGS, PE, C. NIEMIEC, PE
 INSP. DIVERS A. SCHINDHELM, PE, C. NIEMIEC, PE, K. MORROW, N. GUZMA
 ENGINEERS M.OWINGS, PE, C. NIEMIEC, PE



CONTRACT NO. AE-3016-000-001
 DRAWING NO. 17
 page 93 of 105

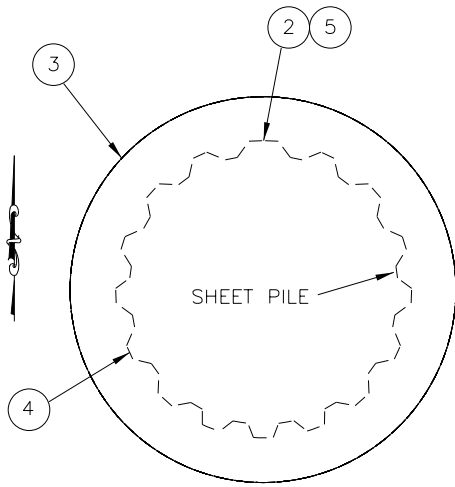

PLAN

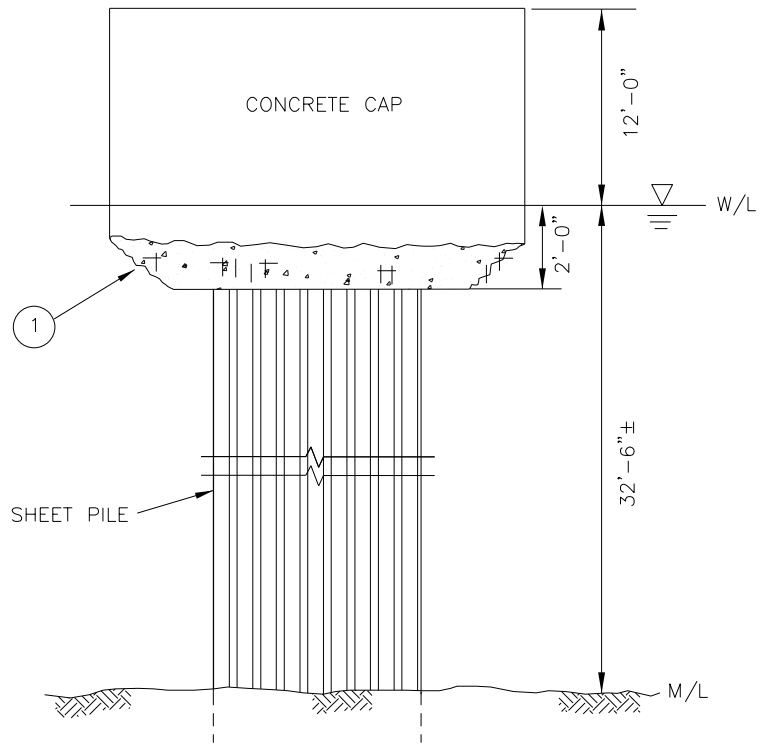

TYPICAL ELEVATION

- ① LOWER EDGE OF CONCRETE CAP EXHIBITS SEVERE SCALING AROUND ENTIRE CIRCUMFERENCE OF CAP, UP TO 12" H x 1'-6" D, EXPOSING ENDS OF VERTICAL STEEL REINFORCEMENT, UP TO 6" LONG, AND PARTIALLY DEBONDED HORIZONTAL STEEL REINFORCEMENT. EXPOSED STEEL REINFORCEMENT HAS SEVERE CORROSION WITH UP TO 75% SECTION LOSS.
- ② NORTH FACE OF THE SHEET PILE SHAFT HAS A 6" DIAMETER CUT HOLE WITH A 2'-0" L x 4" H x 4" W TIMBER PROTRUDING FROM THE HOLE LOCATED 28'-0" BELOW THE W/L. EXPOSED CONCRETE IS IN GOOD CONDITION.
- ③ SCALED AREA IN THE CONCRETE CAP, 6" DIAMETER x 10" D, LOCATED 1'-0" ABOVE W/L.
- ④ WEST FACE OF THE SHEET PILE SHAFT HAS A 12" H x 8" W PERFORATION LOCATED 2'-0" BELOW THE CAP UP TO 6'-0" DEEP WITH ACTIVE FILL LOSS.
- ⑤ NORTH FACE OF SHEET PILE SHAFT HAS A 6" H x 6" W REPAIR PLATE LOCATED 14'-0" BELOW THE CAP.

TYPICAL SHEETING:

MODERATE TO HEAVY CORROSION WITH 20% TO 30% SECTION LOSS FROM MUDLINE TO 22'-0" BELOW BOTTOM OF CAP WITH PITTING UP TO 1/8" DEEP.

HEAVY CORROSION WITH 30% TO 50% SECTION LOSS FROM 22'-0" TO 5'-0" BELOW BOTTOM OF CAP WITH PITTING 1/4" TO 3/8" DEEP.

SEVERE CORROSION WITH UP TO 100% SECTION LOSS (PERFORATIONS) FROM 5'-0" BELOW BOTTOM OF CAP TO BOTTOM OF CAP WITH PITTING UP TO 1/2" DEEP.

THE RUBBER FENDERS AND ATTACHMENT HARDWARE ARE IN GOOD CONDITION.

FRANCIS SCOTT KEY BRIDGE FACILITY
I-695 OVER THE PATAPSCO RIVER
STRUCTURE NO. BCZ472001



DOLPHIN 3

SCALE NOT TO SCALE
INSP. DATE MARCH 29 TO APRIL 8, 2021
DIVERS SUP. M.OWINGS, PE, C. NIEMIEC, PE
A. SCHINDHELM, PE, C. NIEMIEC, PE,
INSP. DIVERS K. MORROW, N. GUZMA
ENGINEERS M.OWINGS, PE, C. NIEMIEC, PE



CONTRACT NO.
AE-3016-000-001
DRAWING NO.

18
page 94 of 105

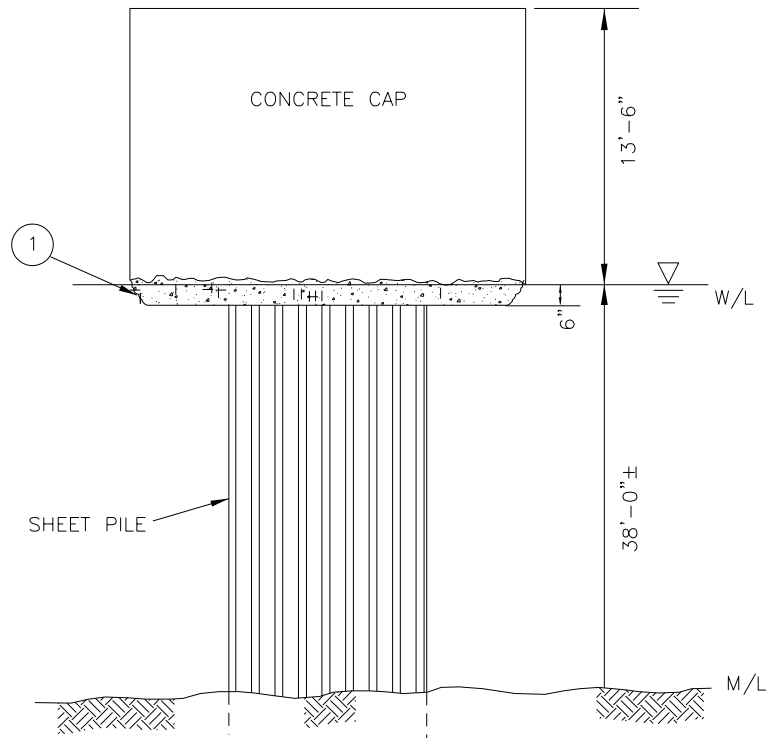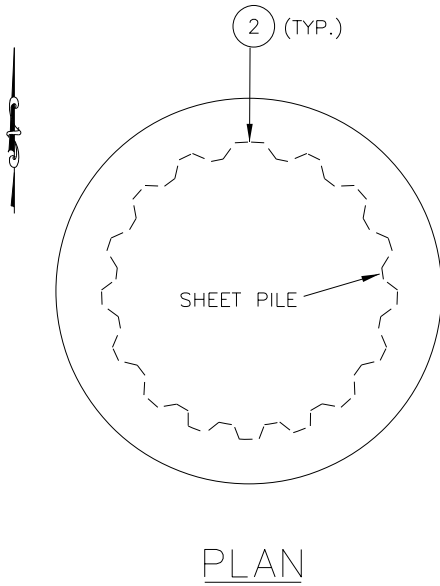

TYPICAL ELEVATION

- ① LOWER EDGE OF CONCRETE CAP EXHIBITS SEVERE SCALING AROUND ENTIRE CIRCUMFERENCE OF CAP, UP TO 2'-0" H x 1'-6" D, EXPOSING ENDS OF VERTICAL STEEL REINFORCEMENT UP TO 6" LONG, AND PARTIALLY DEBONDED HORIZONTAL STEEL REINFORCEMENT. EXPOSED STEEL REINFORCEMENT HAS MODERATE CORROSION.
- ② SEVERAL AREAS OF 100% SECTION LOSS IN SHEET PILE SHAFT THROUGHOUT TOP 5'-0" BELOW CONCRETE CAP WITH MULTIPLE PERFORATIONS UP TO 2'-0" H x 8" W. VOID IN CONCRETE BEHIND PERFORATIONS UP TO 5'-0" H x 4'-0" D x FULL CIRCUMFERENCE.

TYPICAL SHEETING:

MODERATE TO HEAVY CORROSION WITH 20% TO 30% SECTION LOSS FROM MUDLINE TO 22'-0" BELOW BOTTOM OF CAP WITH PITTING UP TO 1/8" DEEP.

HEAVY CORROSION WITH 30% TO 50% SECTION LOSS FROM 22'-0" TO 5'-0" BELOW BOTTOM OF CAP WITH PITTING 1/4" TO 3/8" DEEP.

SEVERE CORROSION WITH UP TO 100% SECTION LOSS (PERFORATIONS) FROM 5'-0" BELOW BOTTOM OF CAP TO BOTTOM OF CAP WITH PITTING UP TO 1/2" DEEP.

THE RUBBER FENDERS AND ATTACHMENT HARDWARE ARE IN GOOD CONDITION.

FRANCIS SCOTT KEY BRIDGE FACILITY
I-695 OVER THE PATAPSCO RIVER
STRUCTURE NO. BCZ472001

DOLPHIN 4


SCALE NOT TO SCALE
INSP. DATE MARCH 29 TO APRIL 8, 2021
DIVERS SUP. M.OWINGS, PE, C. NIEMIEC, PE
INSP. DIVERS A. SCHINDHELM, PE, C. NIEMIEC, PE,
K. MORROW, N. GUZMA
ENGINEERS M.OWINGS, PE, C. NIEMIEC, PE




CONTRACT NO. AE-3016-000-001
DRAWING NO.

19
page 95 of 105


Time Sequence of Channel Elevations - BCZ472001
Francis Scott Key Bridge - North Elevation
Sta. 470+00 to 496+50

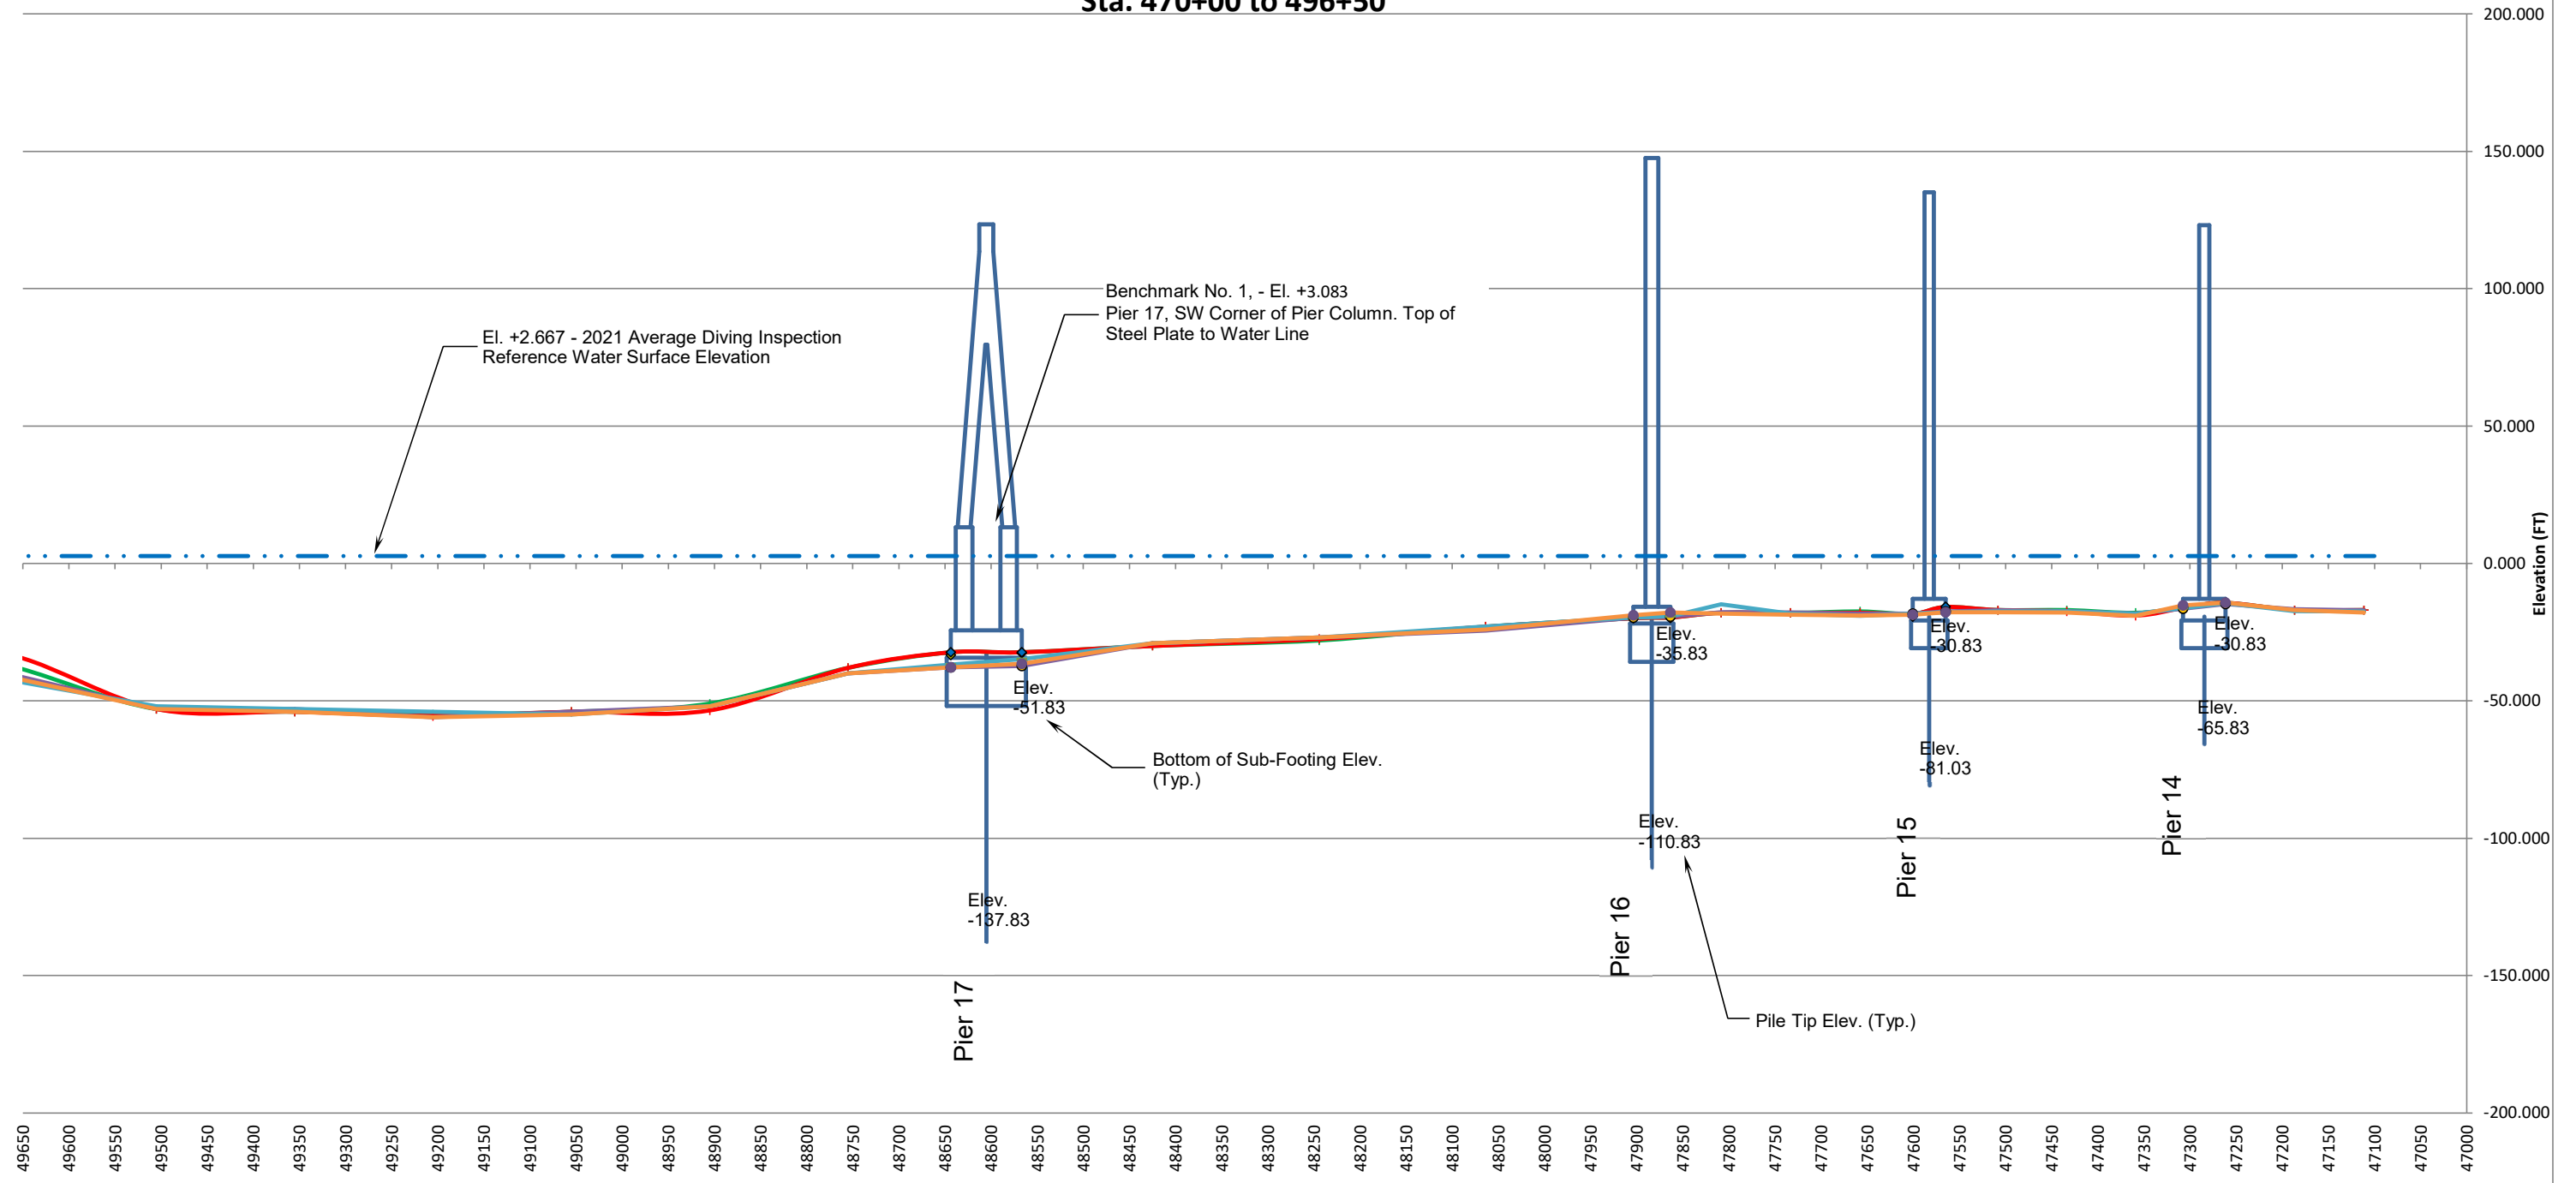


1. All elevations are in NAVD88 vertical datum.
2. Bridge pier and footing elevations are taken from plans dated 1972 (NGVD29) and were converted to NAVD88 vertical datum.
3. Hydrographic profiles were developed by incorporating soundings at the bridge piers from recent year diving reports in order to produce continuous profiles.
4. All available base year, current year and previous year diving inspection and hydrographic survey data sets, as referenced in the legend, have been utilized to develop these profiles. Incomplete data sets or those that could not be tied directly to a known point of vertical reference, or established benchmark, have been omitted.

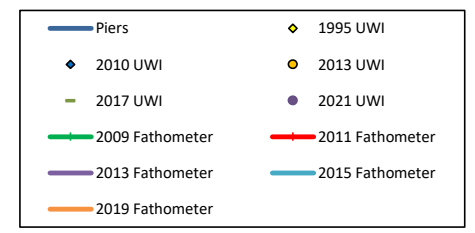


Time Sequence of Channel Elevations - BCZ472001
Francis Scott Key Bridge - North Elevation
Sta. 496+50 to 523+00

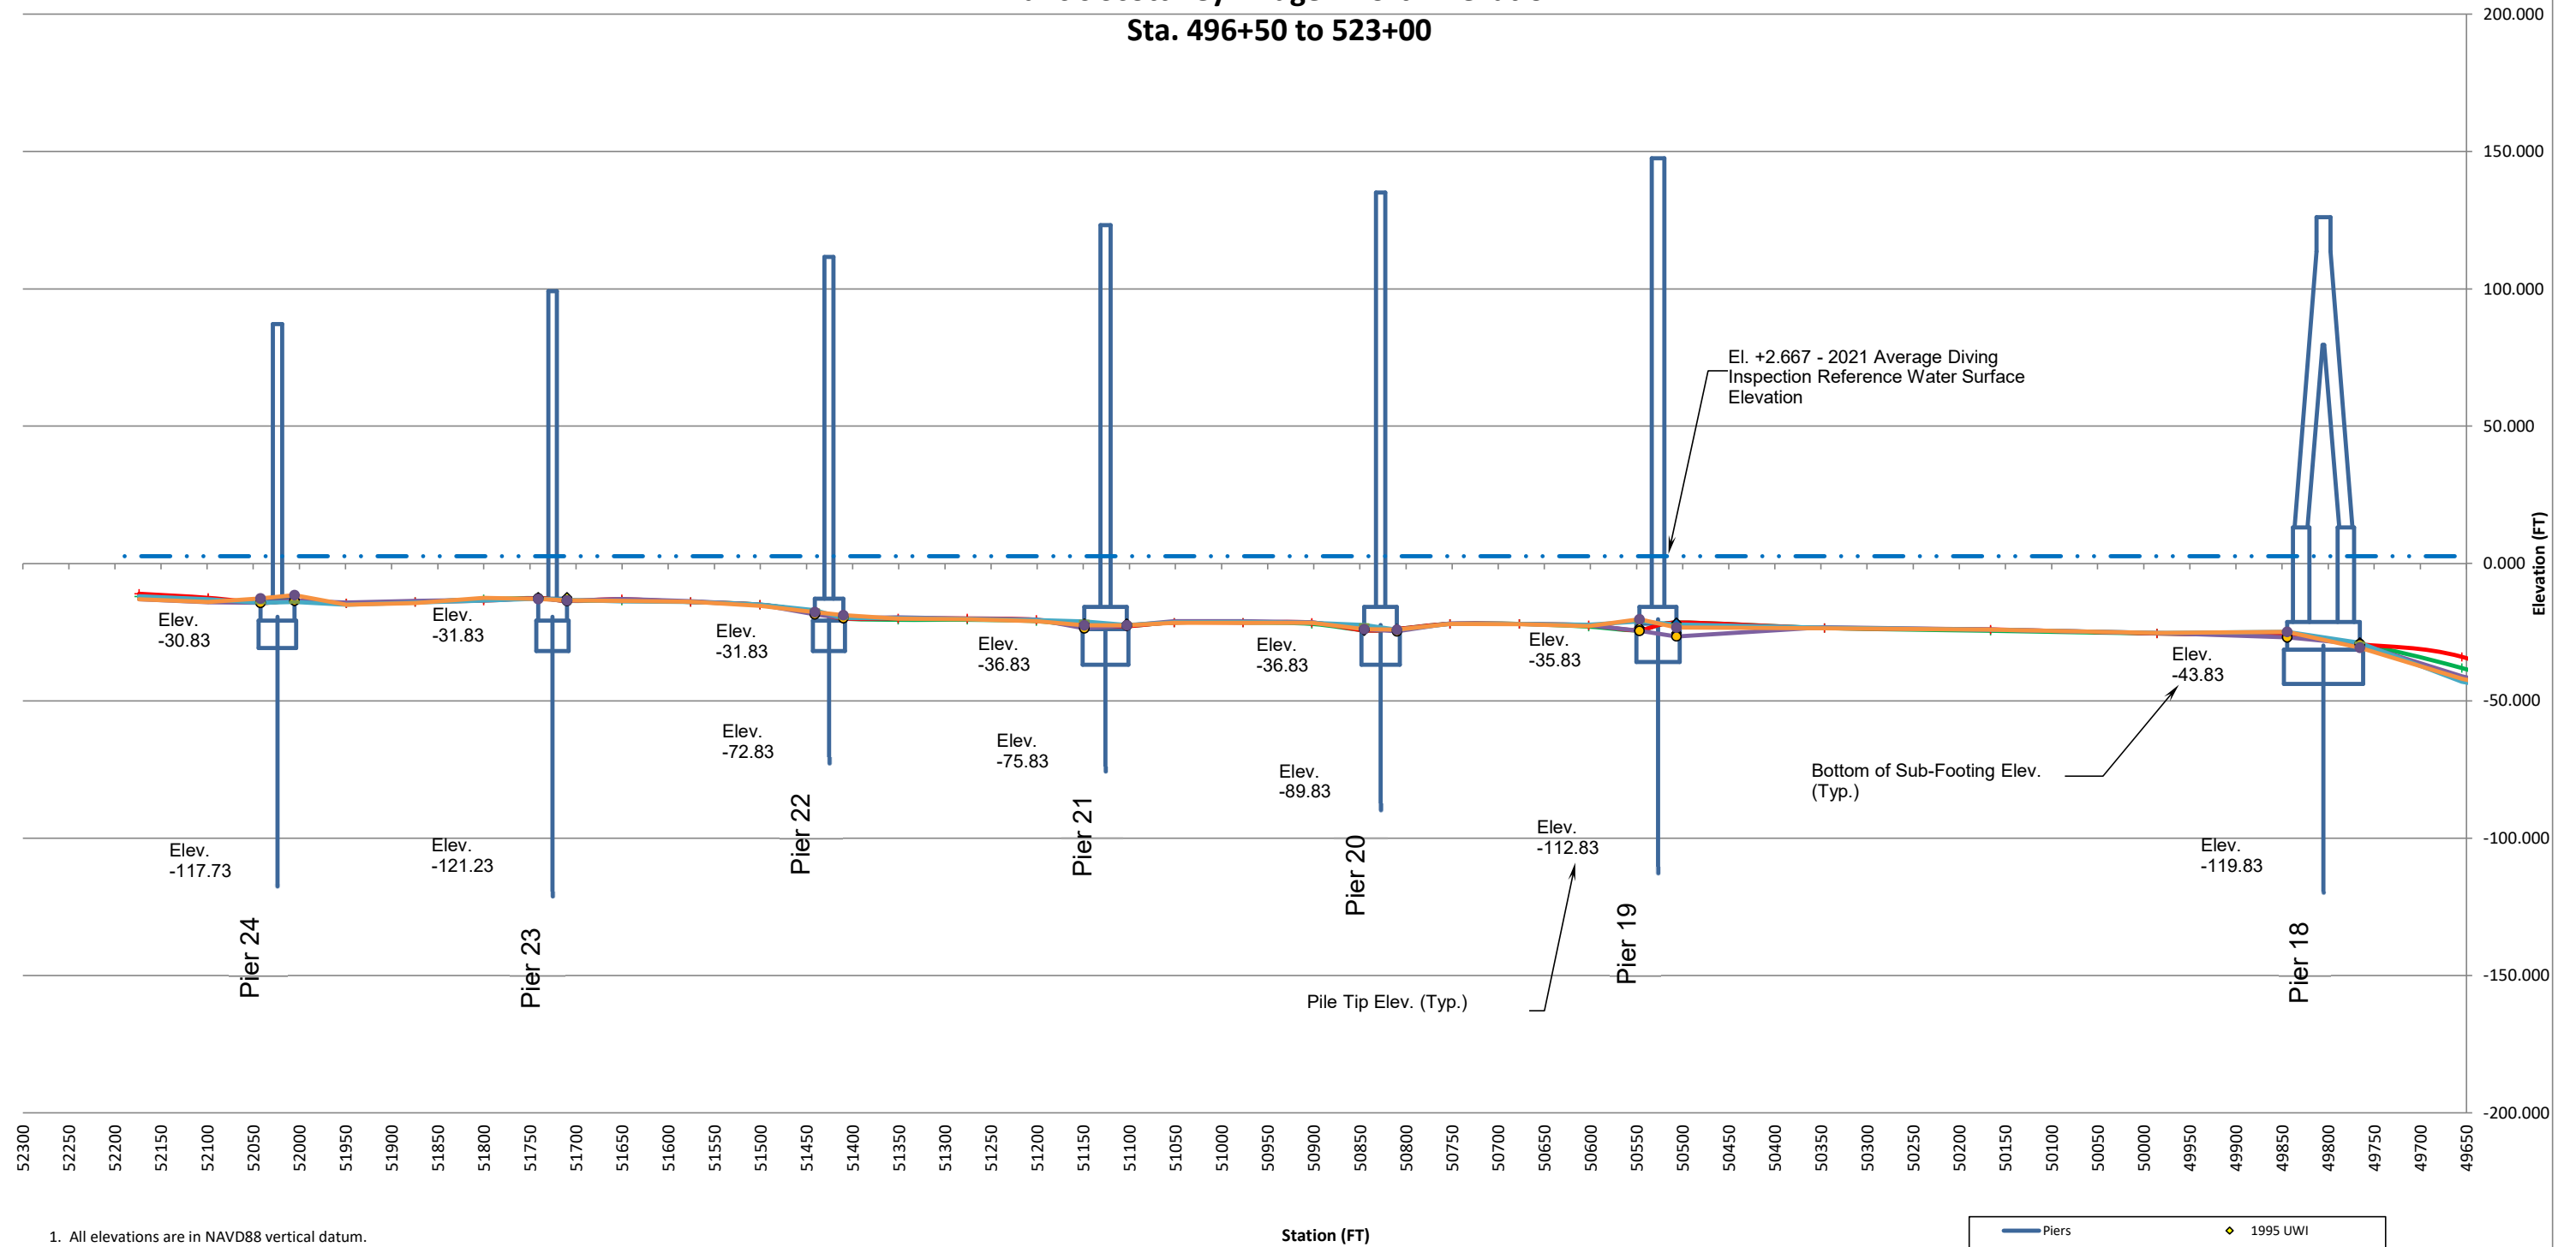


1. All elevations are in NAVD88 vertical datum.
2. Bridge pier and footing elevations are taken from plans dated 1972 (NGVD29) and were converted to NAVD88 vertical datum.
3. Hydrographic profiles were developed by incorporating soundings at the bridge piers from recent year diving reports in order to produce continuous profiles.
4. All available base year, current year and previous year diving inspection and hydrographic survey data sets, as referenced in the legend, have been utilized to develop these profiles. Incomplete data sets or those that could not be tied directly to a known point of vertical reference, or established benchmark, have been omitted.

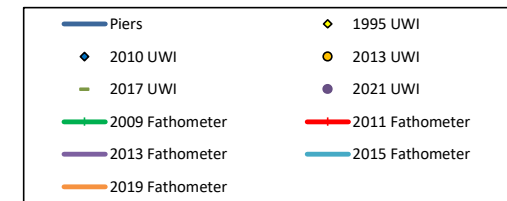


Time Sequence of Channel Elevations - BCZ472001 Francis Scott Key Bridge - South Elevation Sta. 470+00 to 496+50

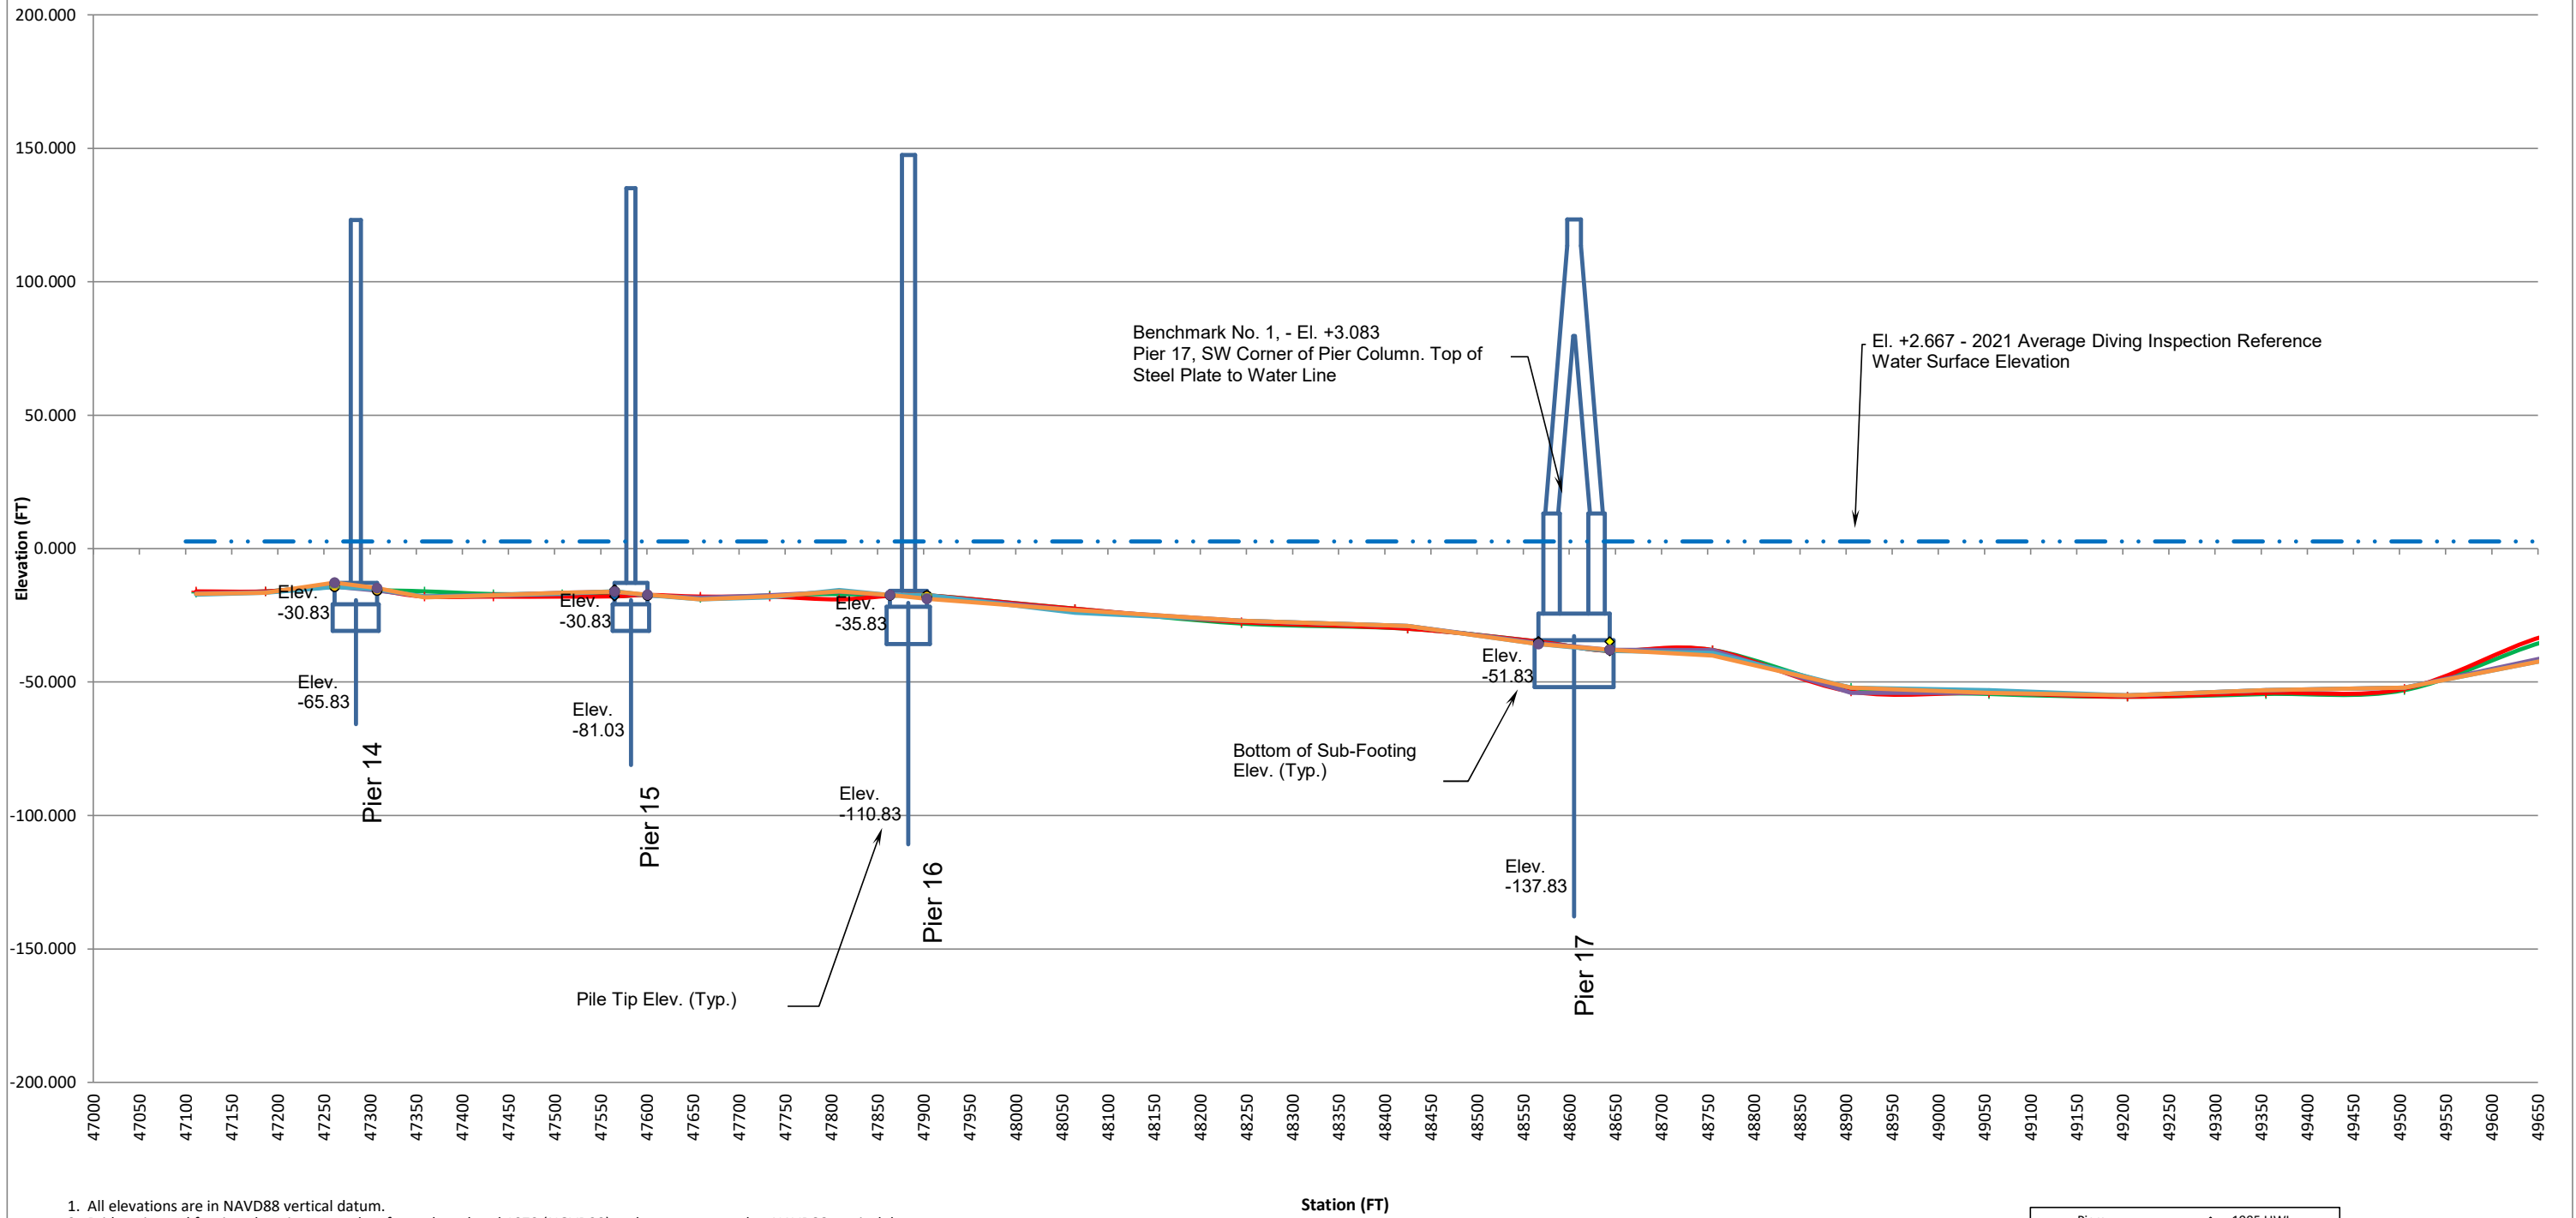


1. All elevations are in NAVD88 vertical datum.
 2. Bridge pier and footing elevations are taken from plans dated 1972 (NGVD29) and were converted to NAVD88 vertical datum.
 3. Hydrographic profiles were developed by incorporating soundings at the bridge piers from recent year diving reports in order to produce continuous profiles.
 4. All available base year, current year and previous year diving inspection and hydrographic survey data sets, as referenced in the legend, have been utilized to develop these profiles. Incomplete data sets or those that could not be tied directly to a known point of vertical reference, or established benchmark, have been omitted.

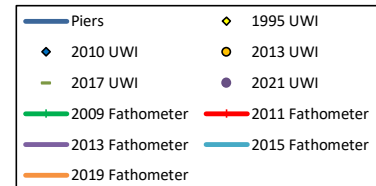

Time Sequence of Channel Elevations - BCZ472001 Francis Scott Key Bridge - South Elevation Sta. 496+50 to 523+00

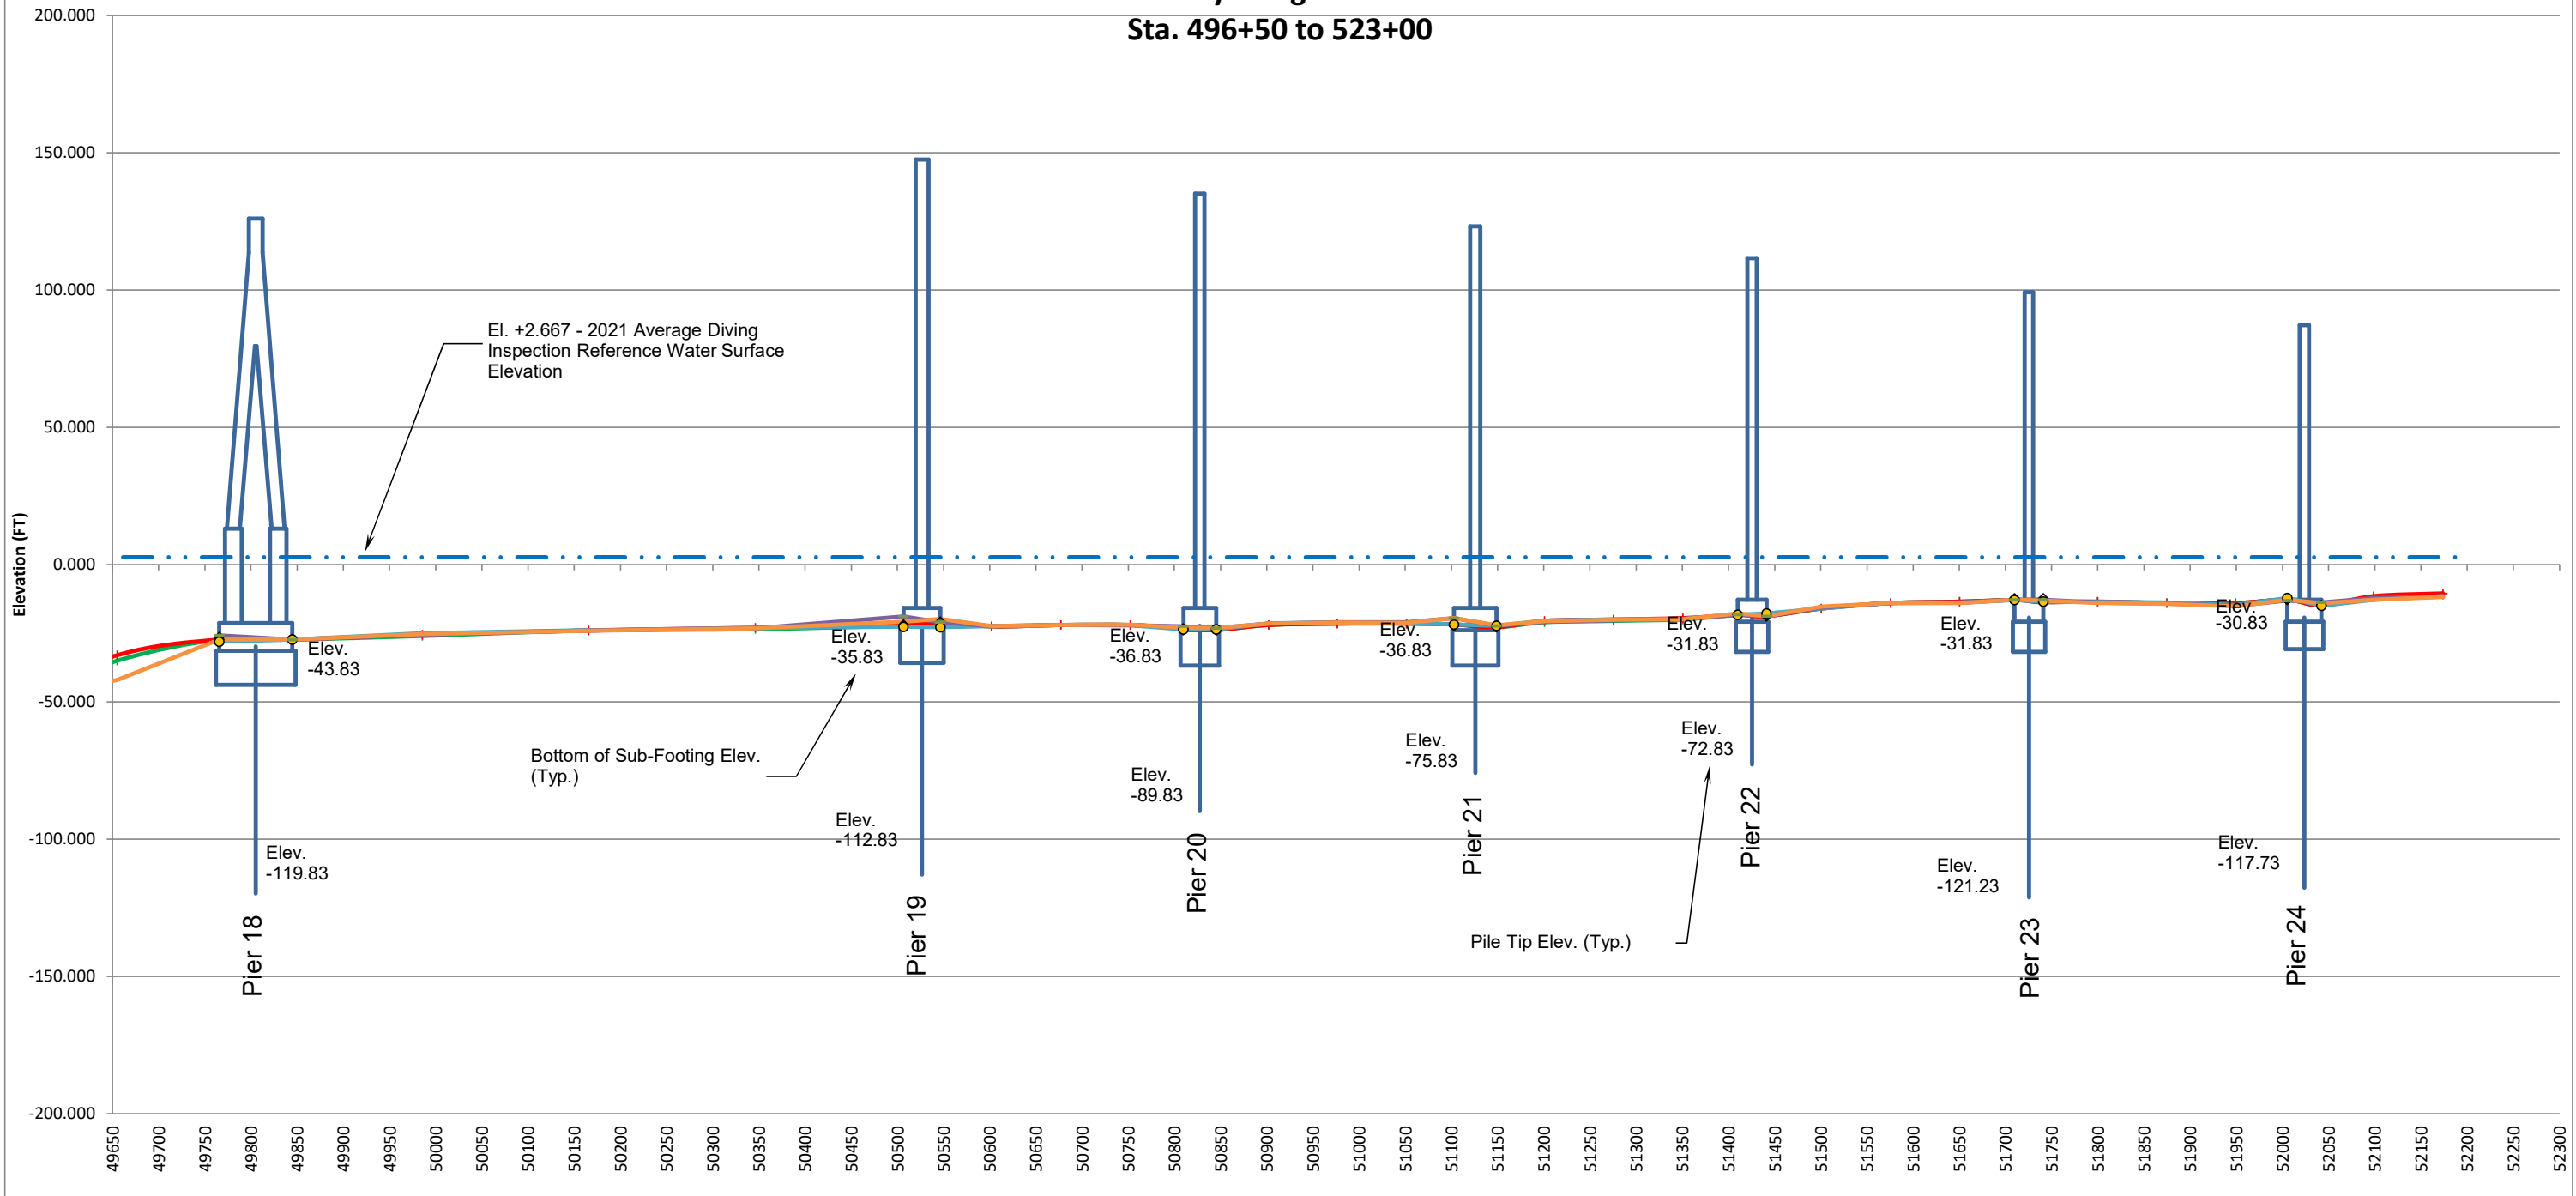

1. All elevations are in NAVD88 vertical datum.
 2. Bridge pier and footing elevations are taken from plans dated 1972 (NGVD29) and were converted to NAVD88 vertical datum.
 3. Hydrographic profiles were developed by incorporating soundings at the bridge piers from recent year diving reports in order to produce continuous profiles.
 4. All available base year, current year and previous year diving inspection and hydrographic survey data sets, as referenced in the legend, have been utilized to develop these profiles. Incomplete data sets or those that could not be tied directly to a known point of vertical reference, or established benchmark, have been omitted.

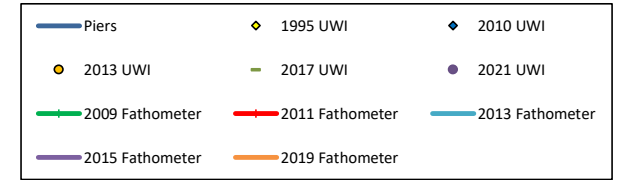



INVENTORY

(228) FOOTING-ABUTMENT:	1	2	0	
(229) SUBSTRUCT ABUTMENT:	1	1	0	
(230) FOOTING-PIER:	1	1	0	
(231) SUBSTRUCTURE PIER:	1	5	1	
(233) SUBSTRUCT DESIGN:	0	0		
(277) SUBSTRUCT-SPECIAL:	N	(219) SLOPE PROTECTION:	4	
(221) STRUCTURAL STEEL:	05	(235) PARAPET:	01	
(242) BEARING TYPE:	B	C	D	
(107) DECK STRUCTURE TYPE:	1	(270) CONCRETE SLAB:		
(271) REBARS:		(272) ADMIXTURES:		
(108) WEARING SURFACE:	1	8	8	
(243) JOINT TYPE:	B	C	D	
(236) RAILING:	2	-	3	9
(237) FENCING:	0	-		
(278) PAINT SYSTEM:				
(344) PAINT COLOR/NUMBER:				

GEOMETRICS

(112) NBIS BRIDGE LENGTH:	Y	(49) STRUCTURE LENGTH:	0090910		
(210) NUMBER OF SPANS:	0037	(48) LENGTH MAX SPAN:	1200		
(45) # SPANS IN MAIN UNIT:	003	(46) # APPROACH SPANS:	0034		
(209) # CONTINUOUS SPANS:	Y	(212) SPAN LENGTH 2:			
(211) SPAN LENGTH 1:		(214) SPAN LENGTH 4:			
(213) SPAN LENGTH 3:		(216) SPAN LENGTH 6:			
(215) SPAN LENGTH 5:		(218) SPAN LENGTH 8:			
(217) SPAN LENGTH 7:		(239) # STRINGERS-WIDENED:			
(238) # STRINGER-ORIGINAL:	07	(241) SPACING-WIDENED:	0		
(240) SPACING-ORIGINAL:	8	(52) DECK OUT-OUT WIDTH:	0612		
(51) DECK CURB-CURB WIDTHS:	0560	(223) SHOULDER WIDTHS:	0200	0200	
(50) CURB/SIDEWALK WIDTHS:	000	000	(205) MEDIAN WIDTH:	003	
(33) BRIDGE MEDIAN:	3	(35) STRUCTURE FLARED:	N		
(32) APPROACH ROAD WIDTH:	02	52	02	(47) INVEN ROUTE, TOTAL HORIZ CLEAR:	280
(10) INVENT ROUTE, MIN VERT CLEAR:	1506				
(53) BRIDGE ROADWAY, MIN VERT CLEAR:	1506				

GEOMETRICS (Cont.)

(54) MIN VERTICAL UNDERCLEARANCE:	1506	H
(55) MIN LATERAL UNDERCLEARANCE (RIGHT):	000	N
(56) MIN LATERAL UNDERCLEARANCE (LEFT):	000	

(342) HORIZONTAL CLEARANCE-ON:	02800	02800
(280) HORIZONTAL CLEARANCE-UNDER:		
(34) SKEW, IN DEGREES:	00	
(256) SPAN OF CELLS:	N	
(343) CENTERLINE LENGTH-CULVERTS/PIPES:	N	

(253) NUMBER OF CELLS:	N
(258) EARTHFILL:	N
(254) RISE:	N

LOAD RATINGS AND POSTINGS

(41) STATUS:	A
(31) DESIGN LOAD:	5
(70) POSTING:	5
(64) OPERATING RATING:	
(464) OPERATING RATING-H:	240
(564) OPERATING RATING-HS:	450
(664) OPERATING RATING-T3:	430
(764) OPERATING RATING-3S2:	540
(225) SPEED LIMIT ON STRUCTURE:	55
(226) MIN VERT CLEARANCE OVER ROADWAY POSTED:	X
(227) MIN VERT UNDERCLEARANCE POSTED:	Y

(224) WEIGHT POSTED, KIPS:	N
(66) INVENTORY RATING:	
(466) INVENTORY RATING-H:	170
(566) INVENTORY RATING-HS:	295
(666) INVENTORY RATING-T3:	275
(766) INVENTORY RATING-3S2:	980

BMS CONDITION RATINGS

FORM 6 OF 8

(90) INSPECTION DATE:	05312021		
(91) INSPECTION FREQUENCY, MONTHS:	24		
(92) CRITICAL FEATURE INSP:	Y24	Y48	N
(93) CRIT FEATURE INSP DATE:	05/31/2021	03/29/2021	N
(58) DECK:	6		
(59) SUPERSTRUCTURE:	6		
(60) SUBSTRUCTURE:	6		
(61) CHANNEL:	7		
(62) CULVERT:	N		
(340) INSPECTION CLASSIFICATION:			

(332) POSTING SIGNS:	N
(307) UNDER CONSTRUCTION:	0

B
D

S

APPRAISAL

FORM 7 OF 8

(67) STRUCTURAL EVALUATION:	5
(69) UNDERCLEARANCE:	N

(68) DECK GEOMETRY:	4
(72) APPROACH ALIGNMENT:	8

(71) WATERWAY ADEQUACY:

9

BSR

(36) TRAFFIC SAFETY FEATURES

RAILINGS: 1

APPROACH BARRIER: 1

TRANSITIONS: 1

APPROACH BARRIER ENDS: 1

(113) SCOUR EVALUATION:

8L

NAVIGATION AND HYDRAULICS

(38) NAVIGATION CONTROL:

1

(39) NAV VERT CLEARANCE:

185

(40) NAV HORIZONTAL CLEARANCE:

1100

(111) PIER/ABUTMENT PROTECTION:

2

(116) MIN NAV VERT CLEARANCE, VERT LIFT BRIDGE:

(247) DESIGN YEAR STORM:

(248) RUN-OFF Q:

(249) DRAINAGE AREA:

(250) STRUCTURE IN TIDAL AREA:

(251) HIGH WATER ELEVATION:

(252) YEAR HIGH WATER ELEVATION-LATEST:

HISTORY AND PROPOSED IMPROVEMENTS

FORM 8 OF 8

(201) CONTRACT NUMBERS:

OT12

(202) CONTRACT NUMBERS:

(203) SHA SPEC-YEAR:

(204) AASHTO SPEC-YEAR:

(263) SHA SPEC RECON 1:

(264) SHA SPEC RECON 2:

(265) AASHTO SPEC RECON 1:

(266) AASHTO SPEC RECON2 2:

(75) TYPE OF WORK:

(76) LENGTH OF IMPROVEMENT:

(94) BRIDGE IMPROVE COST:

(95) ROADWAY IMPROVE COST:

(96) TOTAL PROJECT COST:

(97) YEAR OF IMPROVEMENT:

MISCELLANEOUS

(244) SIGNS ON STRUCTURE:

Y

(245) BRIDGE ROADWAY LIGHTING:

Y

(246) ROADWAY LIGHTING:

Y

(260) UTILITIES - ON:

E

(261) UTILITIES - UNDER:

0

REMARKS:

--