National Transportation Safety Board
Office of Highway Safety
Washington, DC 20594

HWY24MH013

HIGHWAY FACTORS ATTACHMENT

Horizontal and Vertical Alignment on I-80/90

(4 Pages)

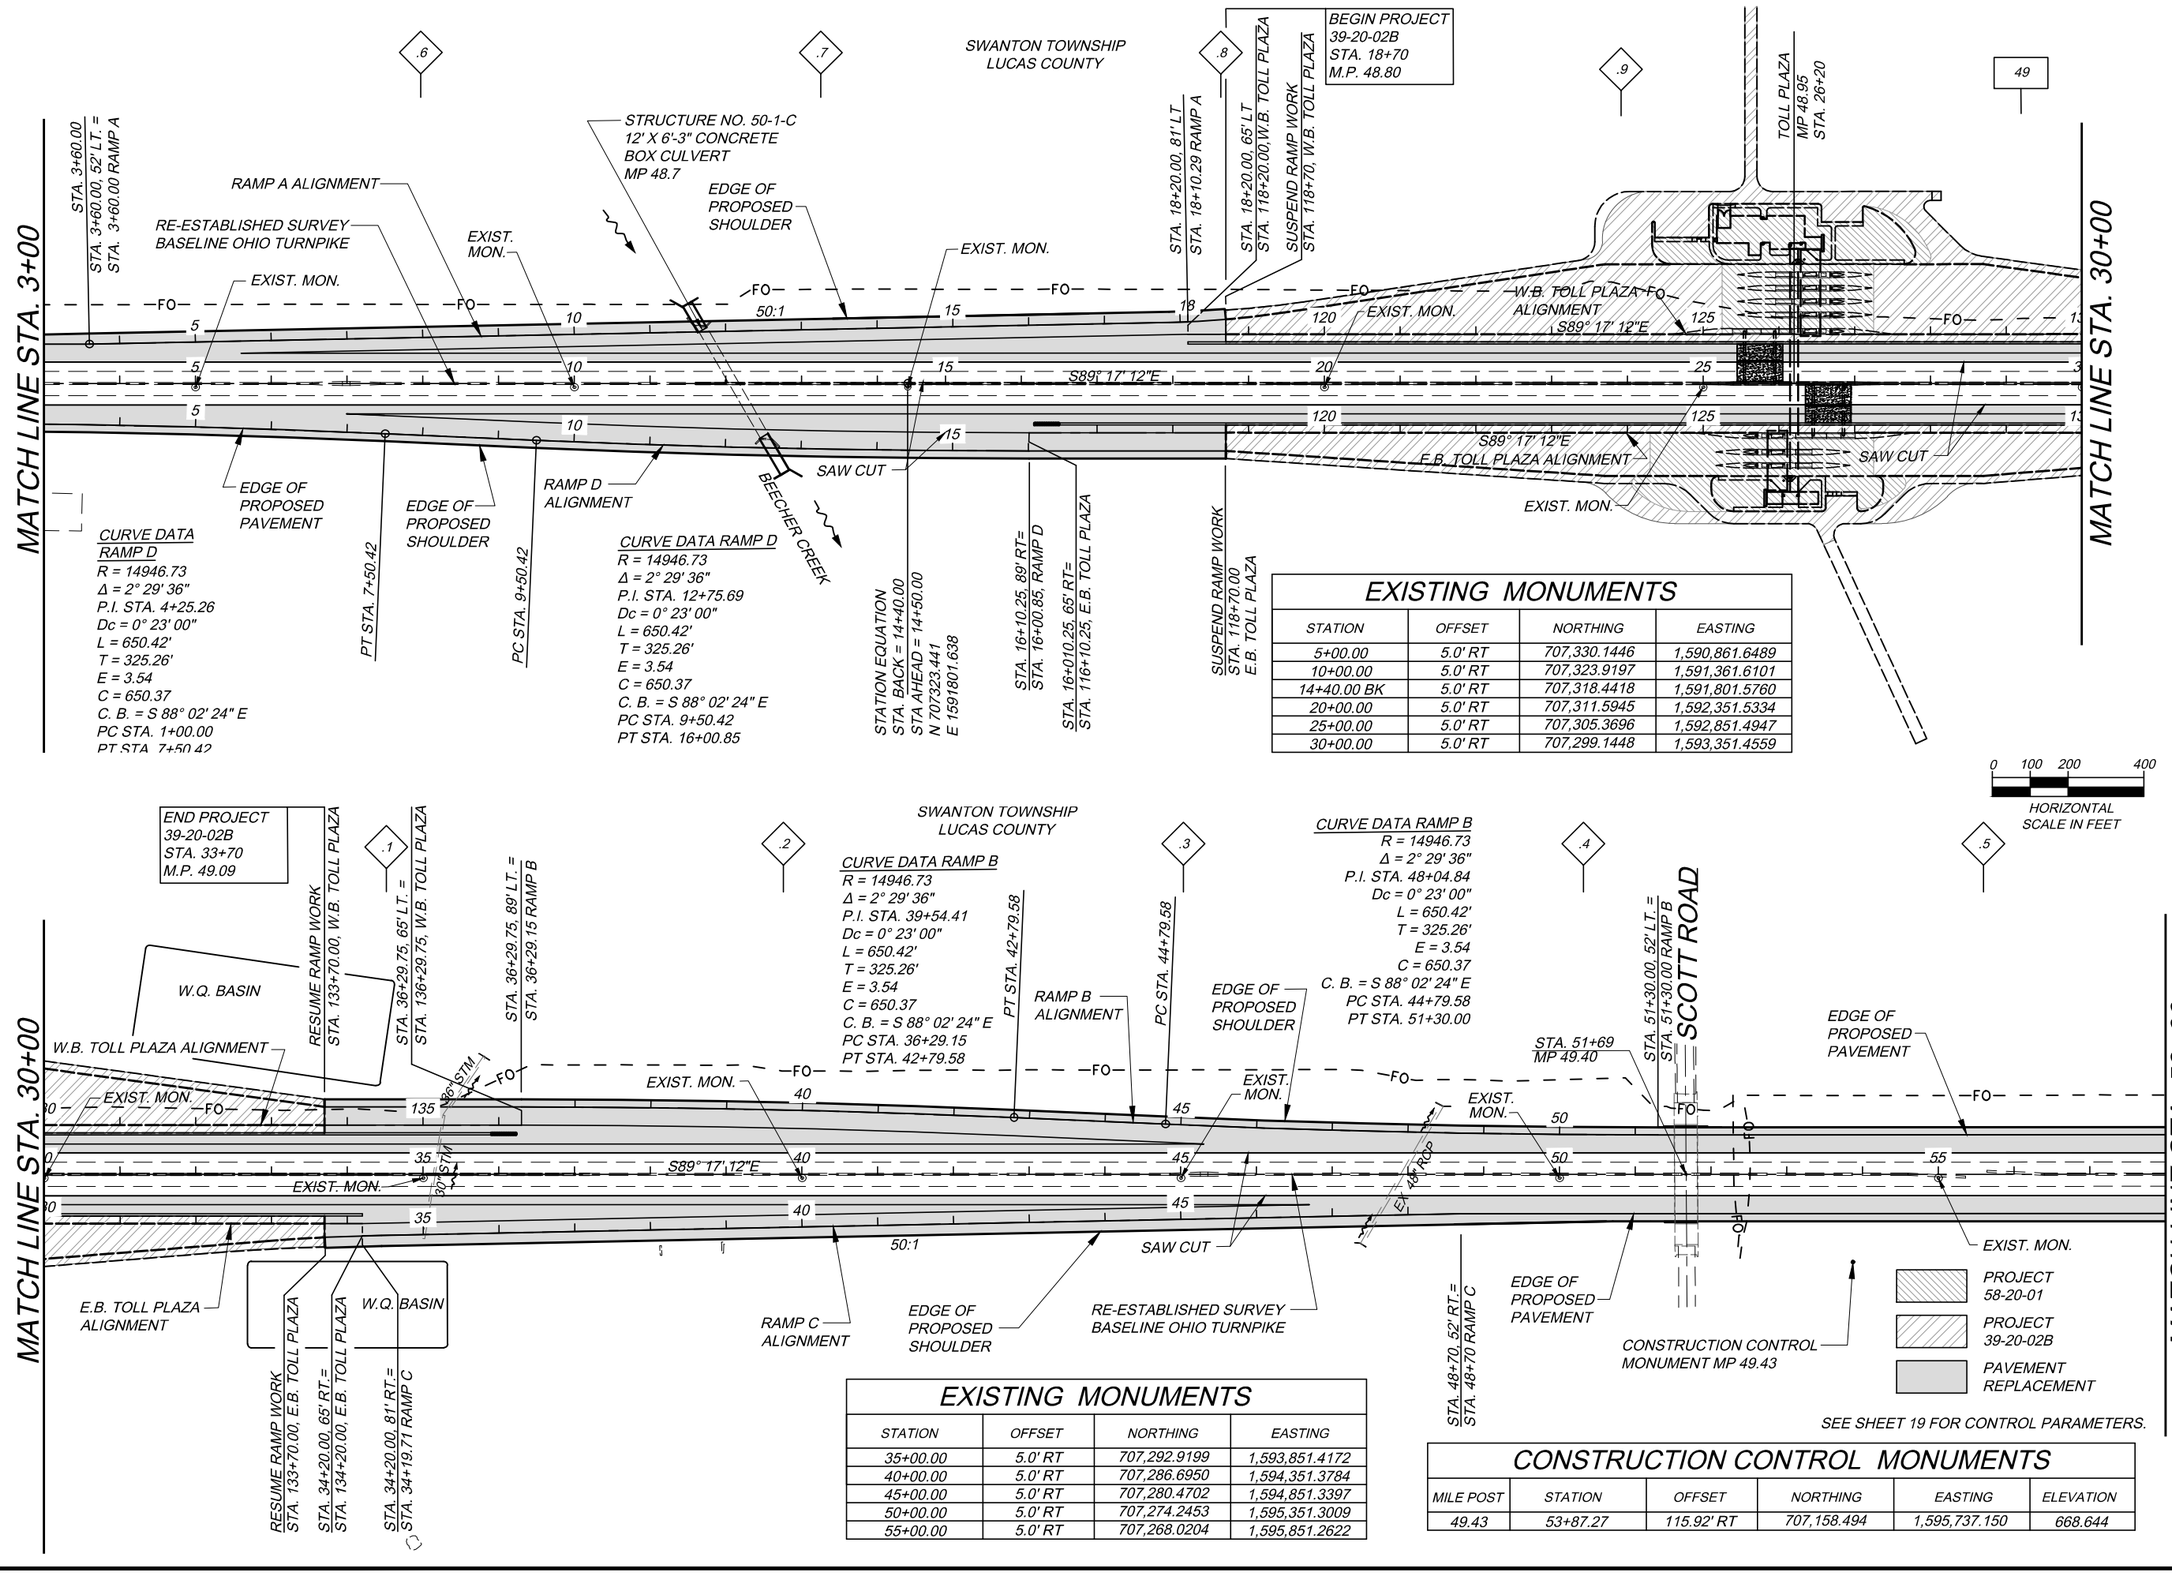

EXISTING MONUMENTS

STATION	OFFSET	NORTHING	EASTING
5+00.00	5.0' RT	707,330.1446	1,590,861.6489
10+00.00	5.0' RT	707,323.9197	1,591,361.6101
14+40.00 BK	5.0' RT	707,318.4418	1,591,801.5760
20+00.00	5.0' RT	707,311.5945	1,592,351.5334
25+00.00	5.0' RT	707,305.3696	1,592,851.4947
30+00.00	5.0' RT	707,299.1448	1,593,351.4559

EXISTING MONUMENTS

STATION	OFFSET	NORTHING	EASTING
35+00.00	5.0' RT	707,292.9199	1,593,851.4172
40+00.00	5.0' RT	707,286.6950	1,594,351.3784
45+00.00	5.0' RT	707,280.4702	1,594,851.3397
50+00.00	5.0' RT	707,274.2453	1,595,351.3009
55+00.00	5.0' RT	707,268.0204	1,595,851.2622

CONSTRUCTION CONTROL MONUMENTS

MILE POST	STATION	OFFSET	NORTHING	EASTING	ELEVATION
49.43	53+87.27	115.92' RT	707,158.494	1,595,737.150	668.644

DESIGNED J.M.P.
DRAWN P.S.L.
CHECKED W.D.B.
IN CHARGE W.D.B.

NO.	REVISIONS	BY	DATE
	RECORD DRAWING	JDC	3/1/2023

DESIGN AGENCY

SCHEMATIC PLAN
STA. 3+00 TO STA. 58+00

PROJECT 39-20-02A
DATE: 12/3/19

4 / 6

5 / 505

OHIO TURNPIKE AND INFRASTRUCTURE COMMISSION

H:\2018\180192\DWG\SHEETS-5 MILES\39-20-02A AS-BUILTS\DRAWING FILES - BOUND\S92002A-005.DWG - 005 - 1/7/2023 1:05:37 PM - JIM COBB

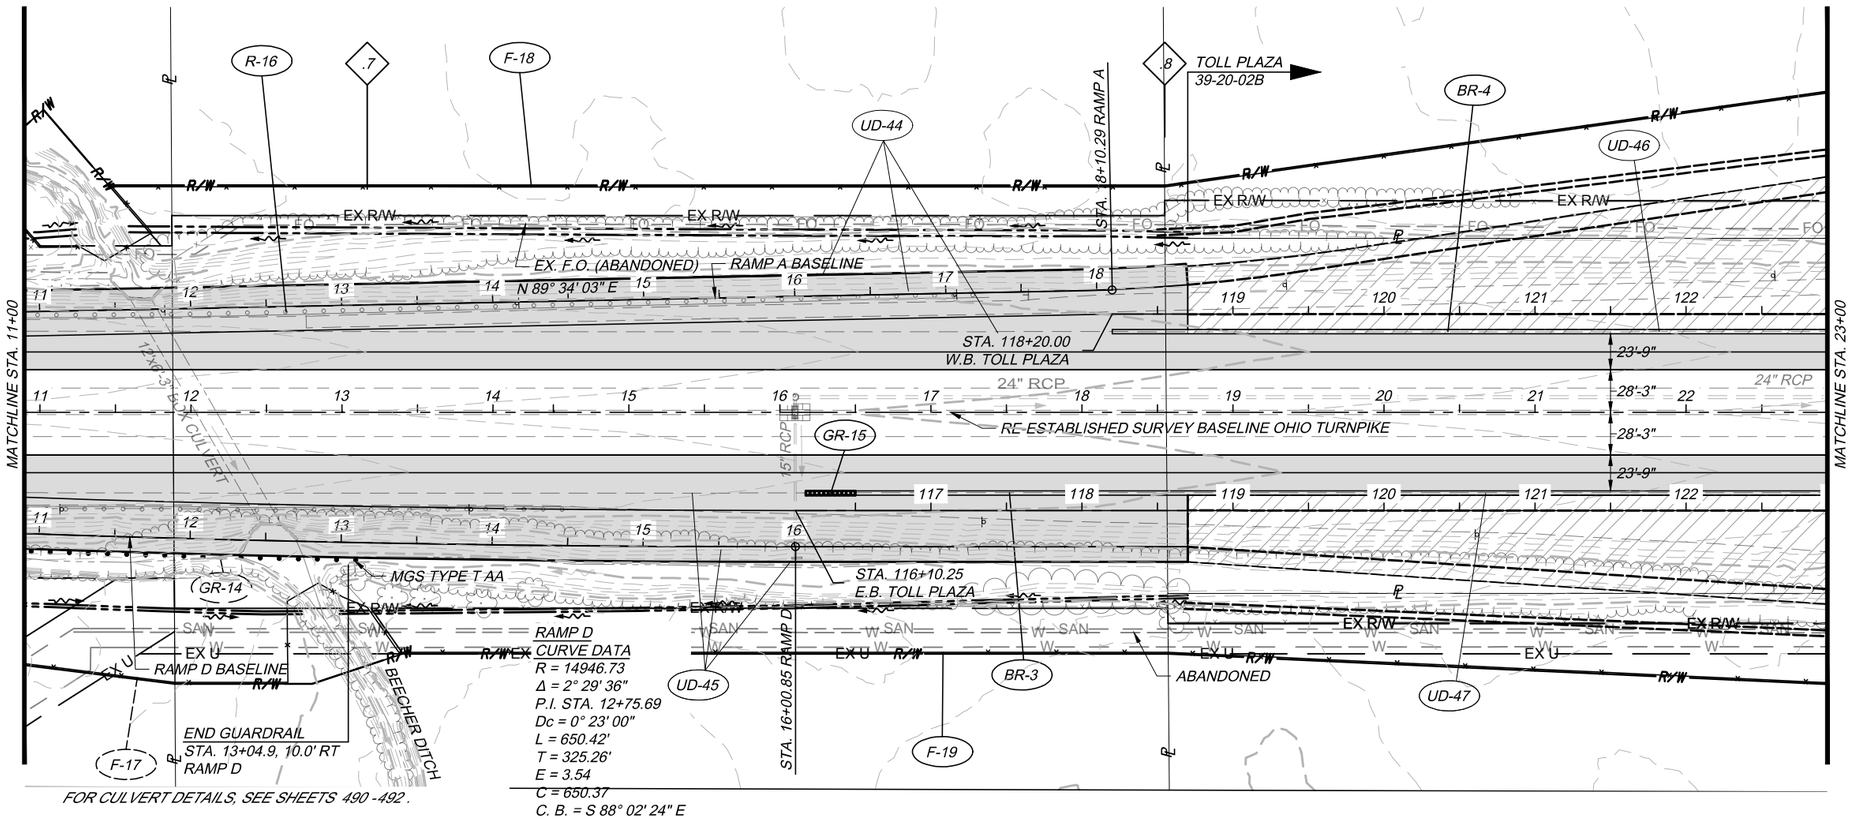

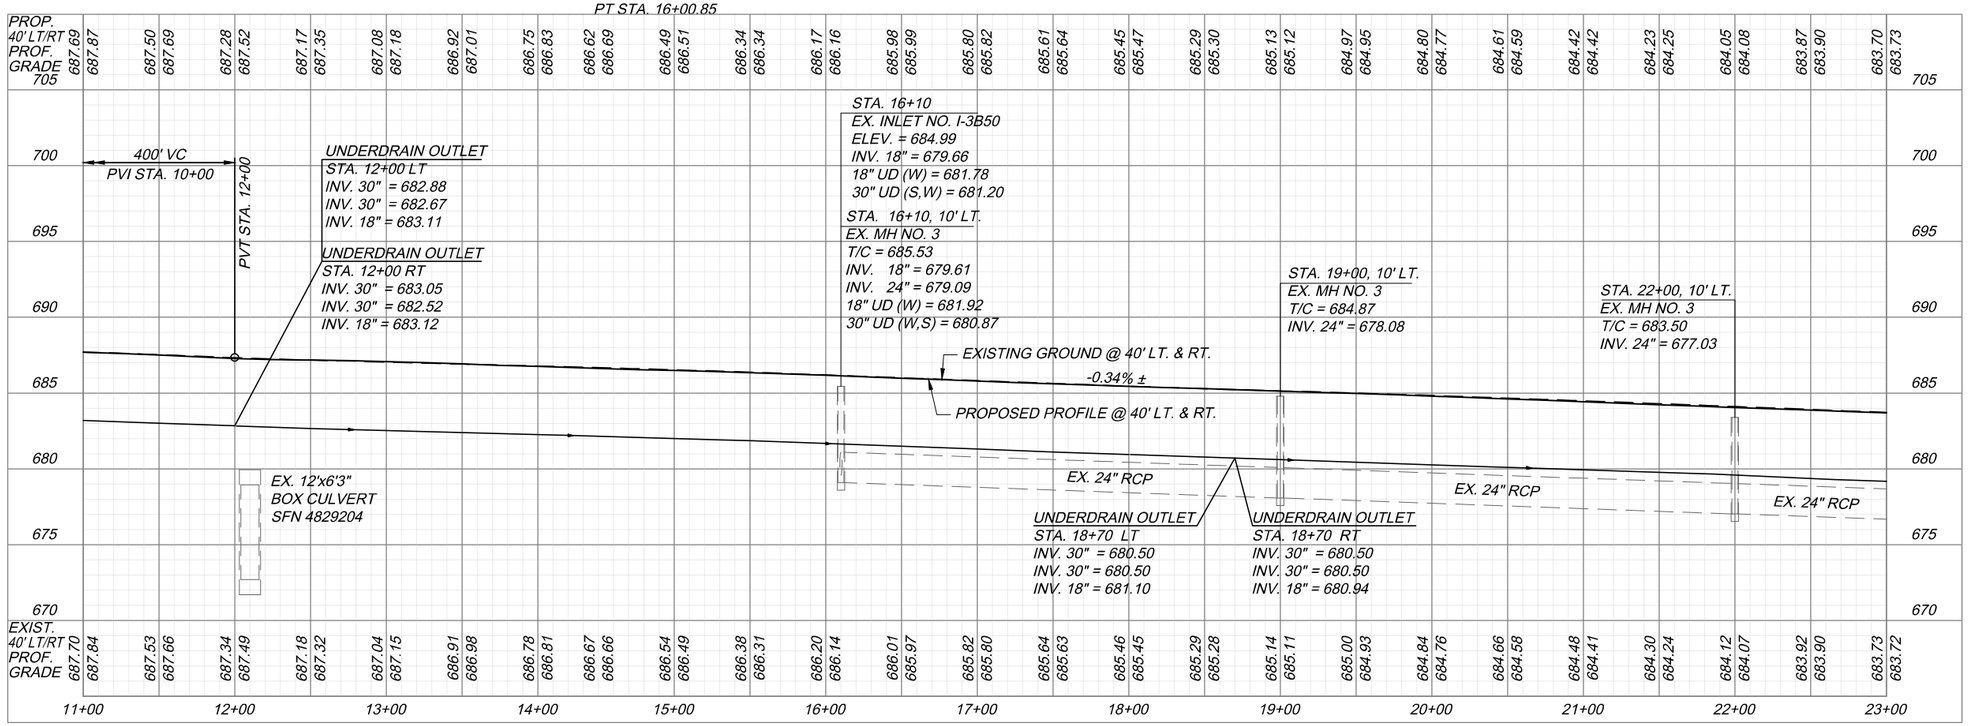

DESIGN AGENCY: Consultants

NO.	REVISIONS	BY	DATE
	RECORD DRAWING	JDC	3/1/2023

DESIGNED J.M.P. | DRAWN K.P.A. | CHECKED W.D.B. | IN CHARGE W.D.B.

OHIO TURNPIKE AND INFRASTRUCTURE COMMISSION

PLAN AND PROFILE
STA. 11+00 TO STA. 23+00

PROJECT 39-20-02A
DATE: 12/3/19

12 / 22

206 / 505

OHIO TURNPIKE

H:\2018\180192\DWG\SHEETS-5 MILES\39-20-02A AS-BUILTS\DRAWING FILES - BOUND\392002A-206.DWG - 206 - 2/2/2023 12:30:00 PM - JIM COBB

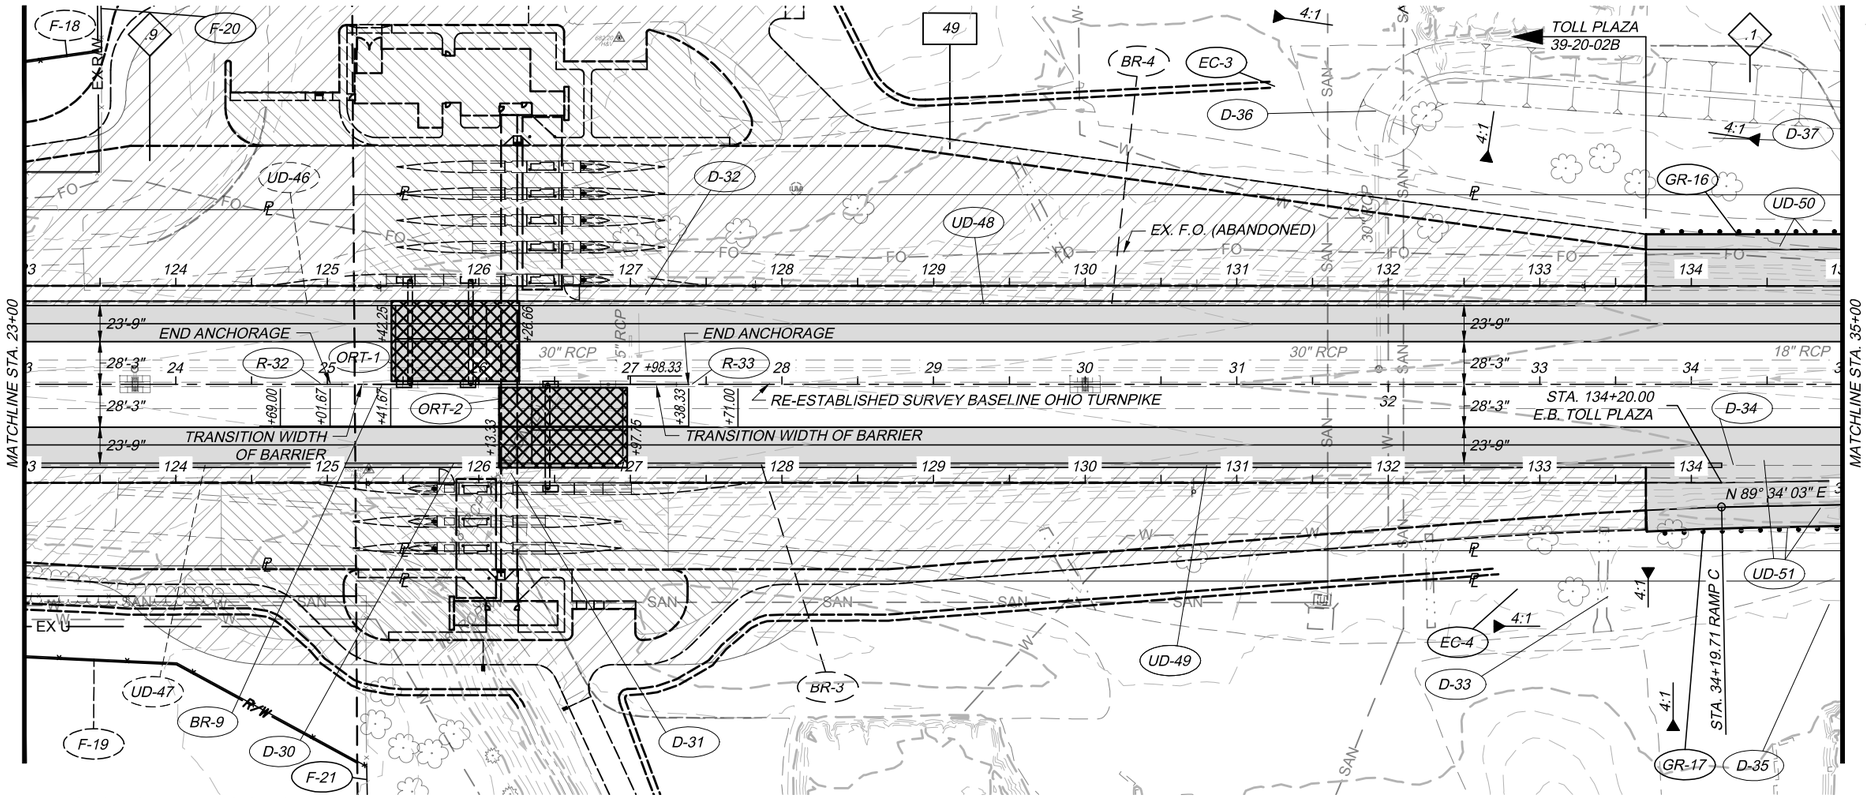

FOR ORT SLAB DETAILS, SEE SHEETS 395-396.

NOTE: THE BARRIER WIDTH SHALL REMAIN CONSTANT BETWEEN STA. 25+41.67 AND 26+98.33

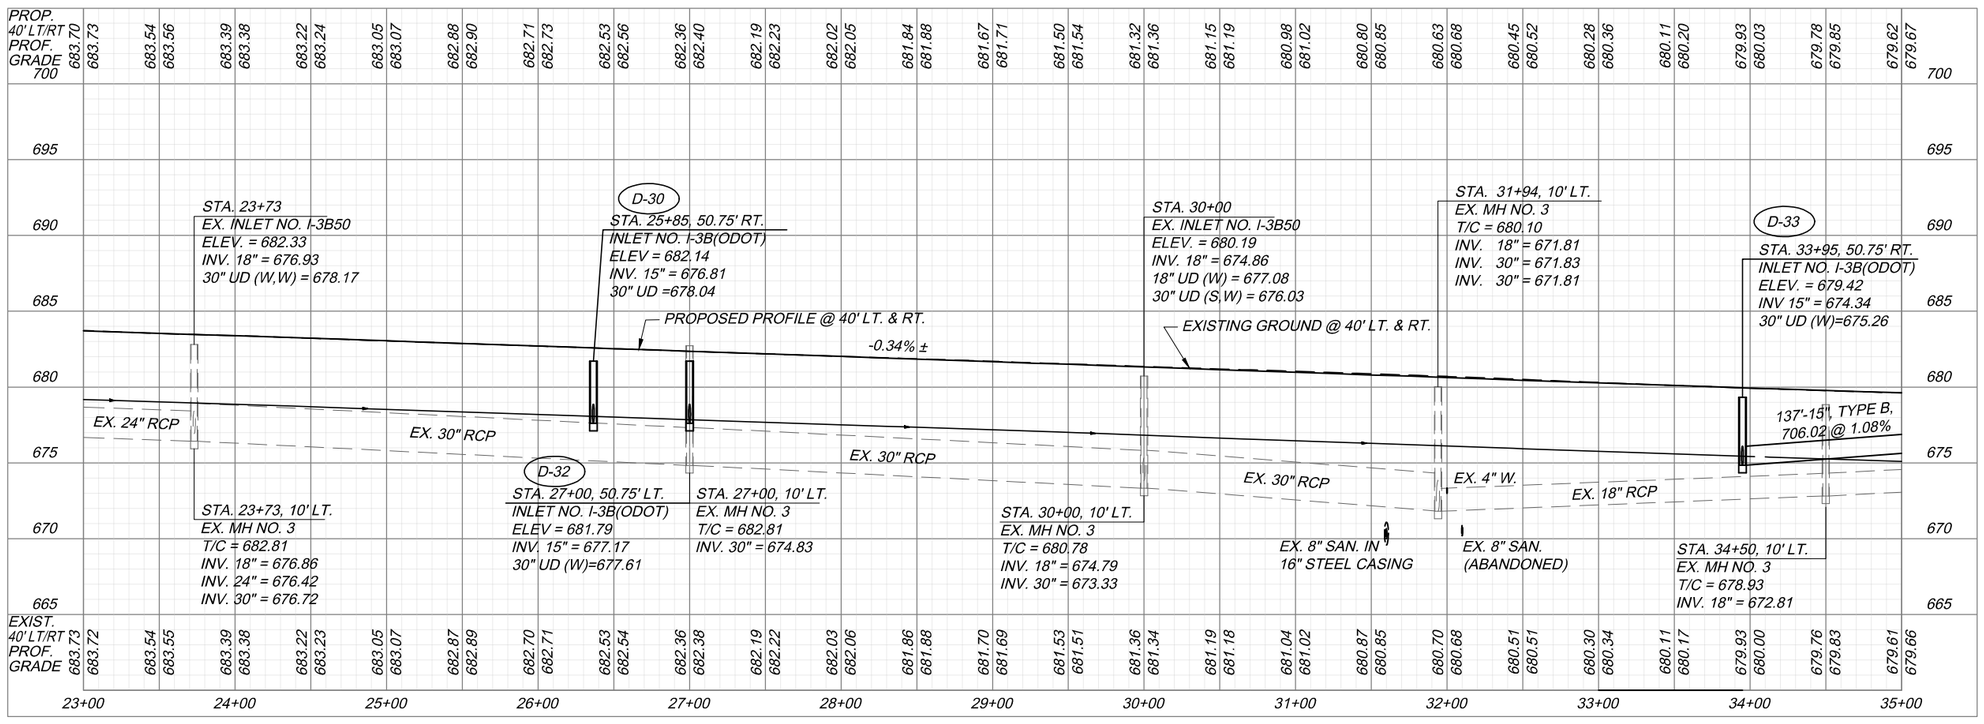

H:\2018\180192\DWG\SHEETS-5 MILES\39-20-02A AS-BUILTS\DRAWING FILES - BOUND\392002A-207.DWG - 207 - 2/2/2023 12:56:20 PM - JIM COBB

DESIGN AGENCY: T Transportation Consultants

NO.	REVISIONS	BY	DATE
	RECORD DRAWING	JDC	3/1/2023

DESIGNED J.M.P. | DRAWN K.P.A. | CHECKED W.D.B. | IN CHARGE W.D.B.

PROJECT 39-20-02A
DATE: 12/3/19

PLAN AND PROFILE
STA. 23+00 TO STA. 35+00

OHIO TURNPIKE AND INFRASTRUCTURE COMMISSION

13 / 22

207 / 505